
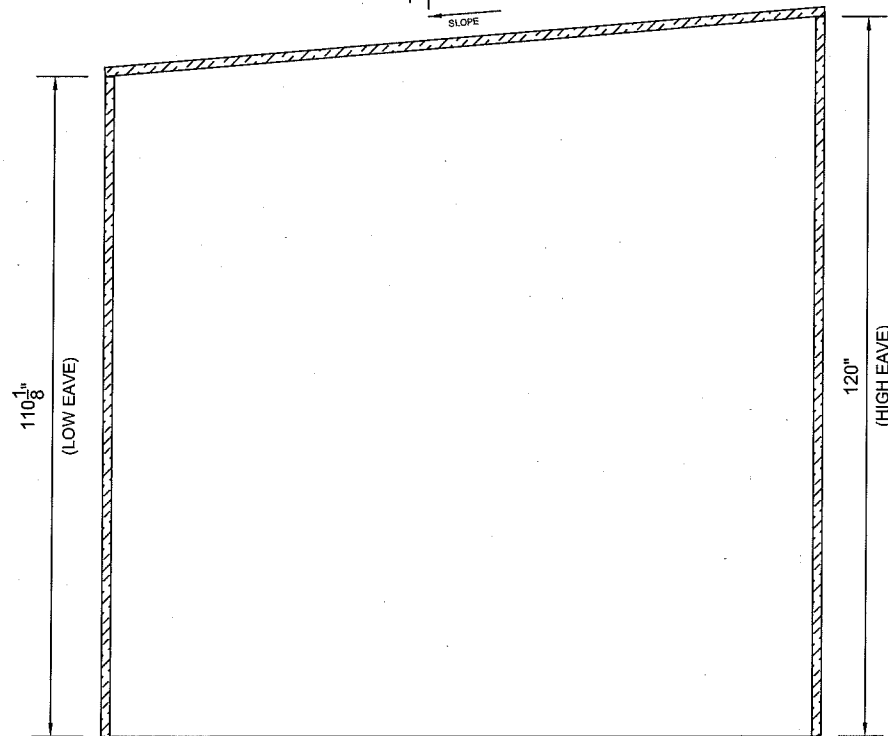


PLAN

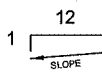

ELEVATION

| | |
|--|---|
| SLOPE | |
| <input checked="" type="checkbox"/> SHED (1/12) | <input type="checkbox"/> GABLE (4/12) <input type="checkbox"/> OTHER: . <input type="checkbox"/> NONE |
| TYPE | |
| <input type="checkbox"/> SELF-FRAMING | <input checked="" type="checkbox"/> THERMAL PANEL <input type="checkbox"/> ENCLOSURE <input type="checkbox"/> NONE |
| COLORS | |
| WALLS: TAN (QC-315) TRIM: METRO BROWN (QC-228) | ROOF: TAN (QC-315) LINER: WHITE |
| INSULATION | |
| WALLS | ROOF |
| <input checked="" type="checkbox"/> R12 <input type="checkbox"/> R20 <input type="checkbox"/> . | <input checked="" type="checkbox"/> R12 <input type="checkbox"/> R20 <input type="checkbox"/> . |
| VAPOUR BARRIER | |
| <input type="checkbox"/> 4 MILS <input type="checkbox"/> 6 MILS <input type="checkbox"/> OTHER: . <input checked="" type="checkbox"/> NONE | |
| DOORS | |
| 3' x 7' | 6' x 7' |
| <input checked="" type="checkbox"/> QUANTITY: 2 | <input checked="" type="checkbox"/> DOGGY DOOR <input type="checkbox"/> QUANTITY: . |
| <input checked="" type="checkbox"/> LOCKSET | <input type="checkbox"/> DOOR CLOSURE <input type="checkbox"/> LOCKSET <input type="checkbox"/> DOOR CLOSURE |
| <input checked="" type="checkbox"/> CHECK-CHAIN | <input type="checkbox"/> CANOPY <input type="checkbox"/> CHECK-CHAIN <input type="checkbox"/> CANOPY |
| <input checked="" type="checkbox"/> IWG WINDOW | <input type="checkbox"/> R10 INSULATION <input type="checkbox"/> WIRE GLASS WINDOW (BOTH DOORS) |
| <input checked="" type="checkbox"/> PANIC HARDWARE | <input type="checkbox"/> PANIC HARDWARE |
| <input checked="" type="checkbox"/> WEATHER-STRIPPING | <input type="checkbox"/> WEATHER-STRIPPING |
| WINDOWS | |
| 30" x 24" | 36" x 36" 36" x 48" |
| <input type="checkbox"/> QUANTITY: . | <input checked="" type="checkbox"/> QUANTITY: 2 <input type="checkbox"/> QUANTITY: . |
| TRANSLUCENT PANELS | |
| WALLS | ROOF |
| <input type="checkbox"/> QUANTITY: . | <input type="checkbox"/> QUANTITY: . |
| <input type="checkbox"/> GREEN <input type="checkbox"/> WHITE <input type="checkbox"/> CLEAR | <input type="checkbox"/> GREEN <input type="checkbox"/> WHITE <input type="checkbox"/> CLEAR |
| LOUVRES | |
| 8" x 8" | 12" x 12" 24" x 24" |
| <input type="checkbox"/> QUANTITY: . | <input checked="" type="checkbox"/> QUANTITY: 4 <input type="checkbox"/> QUANTITY: . |
| <input type="checkbox"/> SLIDE GATE | <input checked="" type="checkbox"/> SLIDE GATE <input type="checkbox"/> SLIDE GATE |
| <input type="checkbox"/> WEATHER HOOD | <input type="checkbox"/> WEATHER HOOD <input type="checkbox"/> WEATHER HOOD |
| BUILDING FAN | |
| <input checked="" type="checkbox"/> QUANTITY: 1 | SIZE: 12 ACPH, 120VAC, 1PH, 60Hz, 1/4 HP, XP |
| MISCELLANEOUS | |
| <input type="checkbox"/> EAVESTROUGHS | <input type="checkbox"/> DOWNSPOUTS <input type="checkbox"/> ICE RAKES |
| <input type="checkbox"/> RIDGE VENT | <input type="checkbox"/> P.ENG STAMPED DRAWINGS |
| <input type="checkbox"/> RIDGE VENTILATORS: QUANTITY: . | SIZE: . |
| <input type="checkbox"/> FRAMED OPENING: QUANTITY: . | SIZE: . |
| <input checked="" type="checkbox"/> OTHER: ONE (1) KNOWLEDGE BOX & ONE (1) DOOR CANOPY | |
| | |
| CUSTOMER: PennWest Exploration | TITLE / PROJECT: 3" INLET (10 WELLS) / 4" HEADER 24"OD X 60" S/S X 720 PSI AB SOUR TEST SEPARATOR PKG |
| DRAWING NAME: BUILDING | QUANTITY: 1 PACKAGE SERIAL NO. (S): 12-052-01 |
| JOB NO.: 12-052 | DRAWN BY: D. BRYAN DATE: 09/14/12 |
| REV. NO.: 1 | REV. DATE: 09/14/12 SCALE: 3/8"=1'-0" DRAWING NO.: 12-052-BUILDING |

| REV. | DATE | DESCRIPTION | BY | CHK'D | APP'D |
|------|----------|-------------------------|----|-------|-------|
| 1 | 03/15/13 | AS BUILT | DB | | |
| 0 | 09/27/12 | ISSUED FOR CONSTRUCTION | DB | LW | PC |