


ELEVATION VIEW
SCALE: 16:1

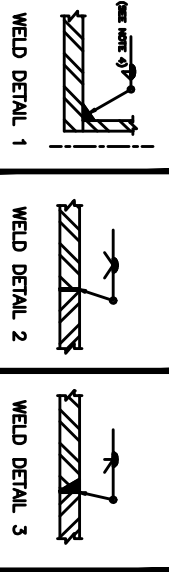

REV	REVISIONS	DATE	BY	CHK'D	APP'D	OWNER APP'D
2	AS BUILT	10-01-18	JS			
1	REVISED AS PER CUSTOMER	08-11-18	JS			
0	ISSUED FOR CONSTRUCTION	08-08-10	DF			
C	REVISED VESSEL	08-08-04	JS			
B	REVISED VESSEL	08-07-28	JS			
A	ISSUED FOR APPROVAL	08-07-23	JS			

Paintearth
ENERGY SERVICES

THIS DRAWING IS THE PROPERTY OF PAINTEARTH ENERGY SERVICES. ANY UNAUTHORIZED USE OR REPRODUCTION OF THIS DESIGN OR DRAWING WITHOUT WRITTEN AUTHORIZATION IS STRICTLY PROHIBITED.

DESIGNED	DESIGNER	DATE
PES	PES	-

CHECKED	CHECKER	DATE

OWNER APP.	OWNER APP.	DATE

APACHE
CO CODE: APPROVER ID#:
LSD:

60"ID x 18'-0 3/4" SOUR HORIZ. DESAND PACKAGE
DESIGN PRESSURE: 1000 PSIG @ 500°F

PROJECT NO. 10449 QA ELEV	FILE NAME 10449 QA ELEV	REFERENCE NO.
SHEET NO. 3 OF 4	SCALE AS SHOWN	DRG. NO. PES-10449 QA ELEV