


CUSTOMER CONNECTIONS		
TAG	DESCRIPTION	SIZE
601	SUCTION INLET	2"-150CL RF
623	FINAL DISCHARGE	2"-600CL RF
643	SCRUBBER DRAIN	2"-150CL RF
649	HP FLARE HEADER	3"-150CL RF
644	LP FLARE KO DRUM	2"-150CL RF
636	LP FLARE / LIQUID STORAGE TANKS	3"-150CL RF
624	MAKE-UP GAS	2"-600CL RF
711	SEALPOT DRAIN	1"-3000CL NPT
810	SWEET GAS PURGE	2"-150CL RF
811	INTRUMENT AIR	2"-150CL RF
901	HEATER WATER INLET	2"-150CL RF
902	HEATER WATER OUTLET	2"-150CL RF

ESTIMATED WEIGHTS			
DESCRIPTION	SHIPPING ARRANGEMENT	WEIGHT (LBS)	
COMPRESSOR	MOUNTED	2370	
MOTOR	MOUNTED	630	
COOLER	MOUNTED	2200	
SKID	MOUNTED	9100	
VESSELS	MOUNTED	1000	
MISC.	MOUNTED	21500	
BUILDING	SHOP ERECTED	10000	
TOTAL SHIPPING WEIGHT (APPROX.)		46800	
TOTAL WEIGHT OF ALL EQUIPMENT (APPROX.)		46800	
OVERALL DIMENSIONS			
DESCRIPTION	LENGTH (FT-IN)	WIDTH (FT-IN)	HEIGHT (FT-IN)
SHIPPING	26' - 11"	15' - 00"	13' - 00"
OVERALL	26' - 11"	15' - 00"	13' - 00"

GENERAL NOTES

- ALL DIMENSIONS ARE IN INCHES, UNLESS OTHERWISE NOTED.
- GOUGE CHECKER PLATE & WELD THE FOLLOWING TO THE MAIN BEAMS:
 - V-101 (STAGE 1 SCRUBBER)
 - V-201 (STAGE 2 SCRUBBER)
 - V-301 (STAGE 3 SCRUBBER)
 - INBOARD CYLINDER SUPPORTS

NO.	DATE	REVISION	BY
A	06/02/10	ISSUED FOR INFORMATION	MER
B	04/16/10	ISSUED FOR APPROVAL	MER
0	06/03/10	ISSUED FOR FABRICATION	MER
1	08/27/10	REVISED SKID EDGE CONNECTIONS	MER
2	11/18/10	AS-BUILT	ATE



**5120 6th STREET N.E.
CALGARY, ALBERTA
T2K 4W5**

TEL: 403. 274.6106
FAX: 403. 730.1644
www.ngc-ltd.com

DRAWN BY: MER DATE: 05/31/10

CHECKED BY: AH DATE: -


JOB NO.: 16960-NC EQUIP. NO.: -

TITLE: GENERAL ARRANGEMENT

END USER: ENCAN CORPORATION
SATURN PHASE 11 - 09-27-79-17 W6M


SCALE: NTS DWG. NO.: 16960-500 SHEET 1 OF 4 REV: 2

THIS DRAWING IS THE EXCLUSIVE PROPERTY OF NGC COMPRESSION SOLUTIONS LTD., AND CANNOT BE REPRODUCED OR DISTRIBUTED WITHOUT THE PERMISSION OF NGC COMPRESSION SOLUTIONS LTD.

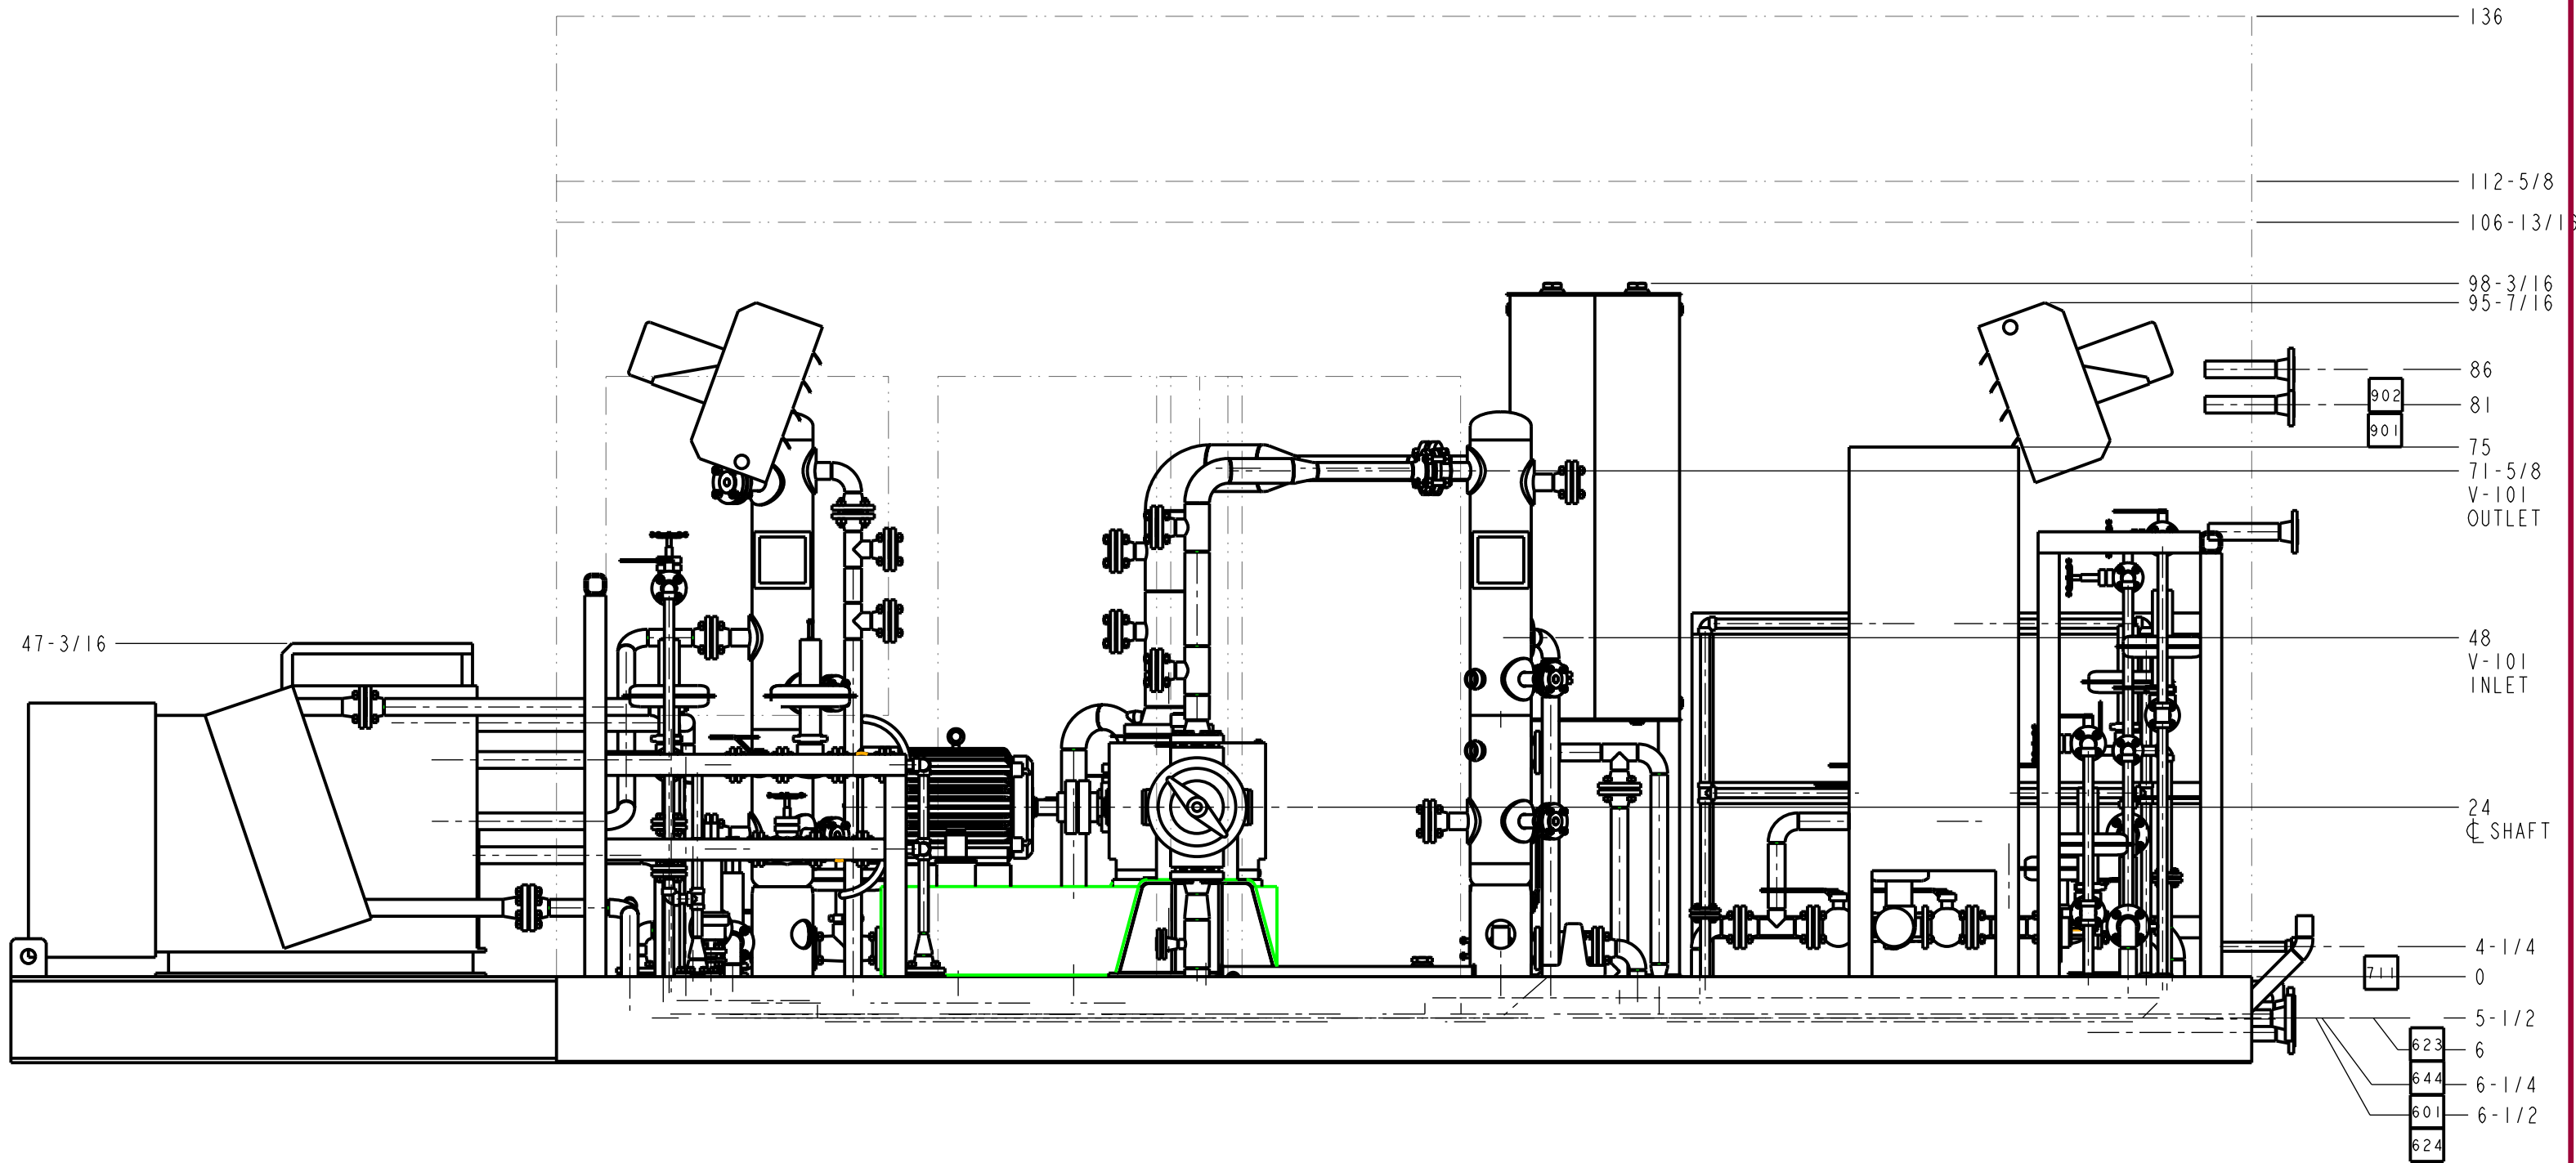


NO.	DATE	REVISION	BY
A	06/02/10	ISSUED FOR INFORMATION	MER
B	04/16/10	ISSUED FOR APPROVAL	MER
0	05/21/10	ISSUED FOR FABRICATION	MER
1	08/27/10	REVISED SKID EDGE CONNECTIONS	MER
2	11/18/10	AS-BUILT	ATE


<p>5120 6th STREET N.E. CALGARY, ALBERTA T2K 4W5</p> <p>TEL: 403. 274.6106 FAX: 403. 730.1644 www.ngc-ltd.com</p>	DRAWN BY:	MER	DATE:	05/31/10
	APPROVED BY:	AH	DATE:	-
	WO NO.:	16960-NC	PART NO.:	-
	TITLE:	GENERAL ARRANGEMENT		
<p>THIS DRAWING IS THE EXCLUSIVE PROPERTY OF NGC COMPRESSION SOLUTIONS LTD., AND CANNOT BE REPRODUCED OR DISTRIBUTED WITHOUT THE PERMISSION OF NGC COMPRESSION SOLUTIONS LTD.</p>				
END USER:		ENCANA CORPORATION		
SCALE:		NTS		
DWG. NO.:		16960-500		
SHEET 2 OF 4:		REV 2		

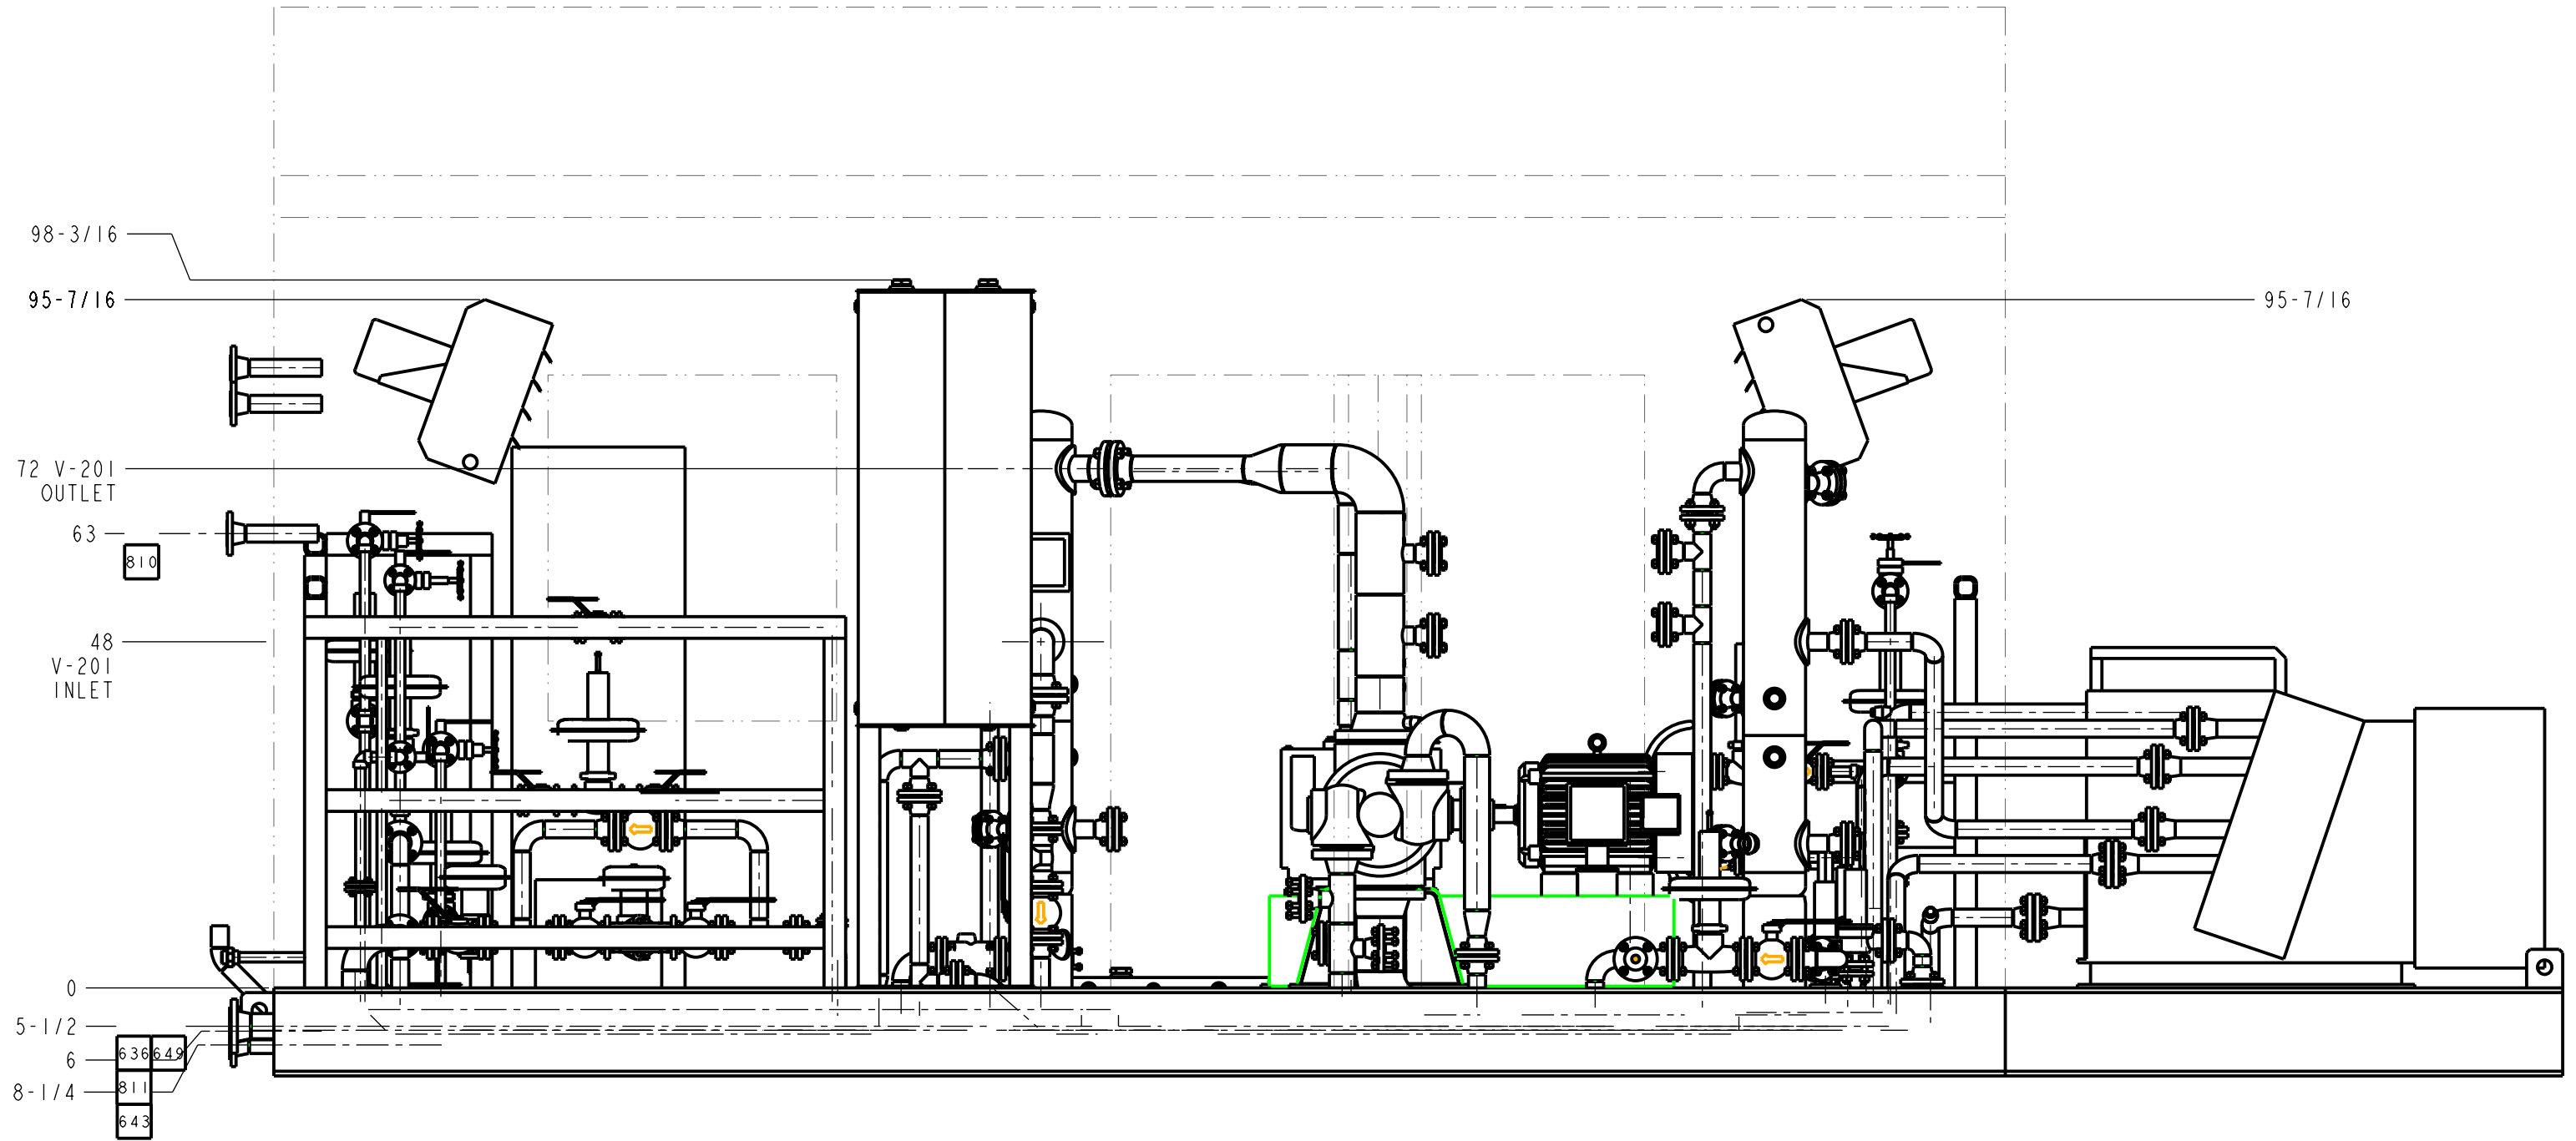

NO.	DATE	REVISION	BY
A	06/02/10	ISSUED FOR INFORMATION	MER
B	04/16/10	ISSUED FOR APPROVAL	MER
0	06/03/10	ISSUED FOR FABRICATION	MER
1	08/27/10	REVISED SKID EDGE CONNECTIONS	MER
2	11/18/10	AS-BUILT	ATE

 5120 6th STREET N.E. CALGARY, ALBERTA T2K 4W5 TEL: 403. 274.6106 FAX: 403. 730.1644 www.ngc-ltd.com	DRAWN BY: MER	DATE: 05/31/10
	APPROVED BY: AH	DATE: -
	WO NO.: 16960-NC	PART NO.: -
	TITLE: GENERAL ARRANGEMENT	
END USER: ENCAN CORPORATION SATURN PHASE 11 - 09-27-79-17 W6M		
SCALE: NTS	DWG. NO.: 16960-500	SHEET 3 OF 4 REV 2

THIS DRAWING IS THE EXCLUSIVE PROPERTY OF NGC COMPRESSION SOLUTIONS LTD., AND CANNOT BE REPRODUCED OR DISTRIBUTED WITHOUT THE PERMISSION OF NGC COMPRESSION SOLUTIONS LTD.

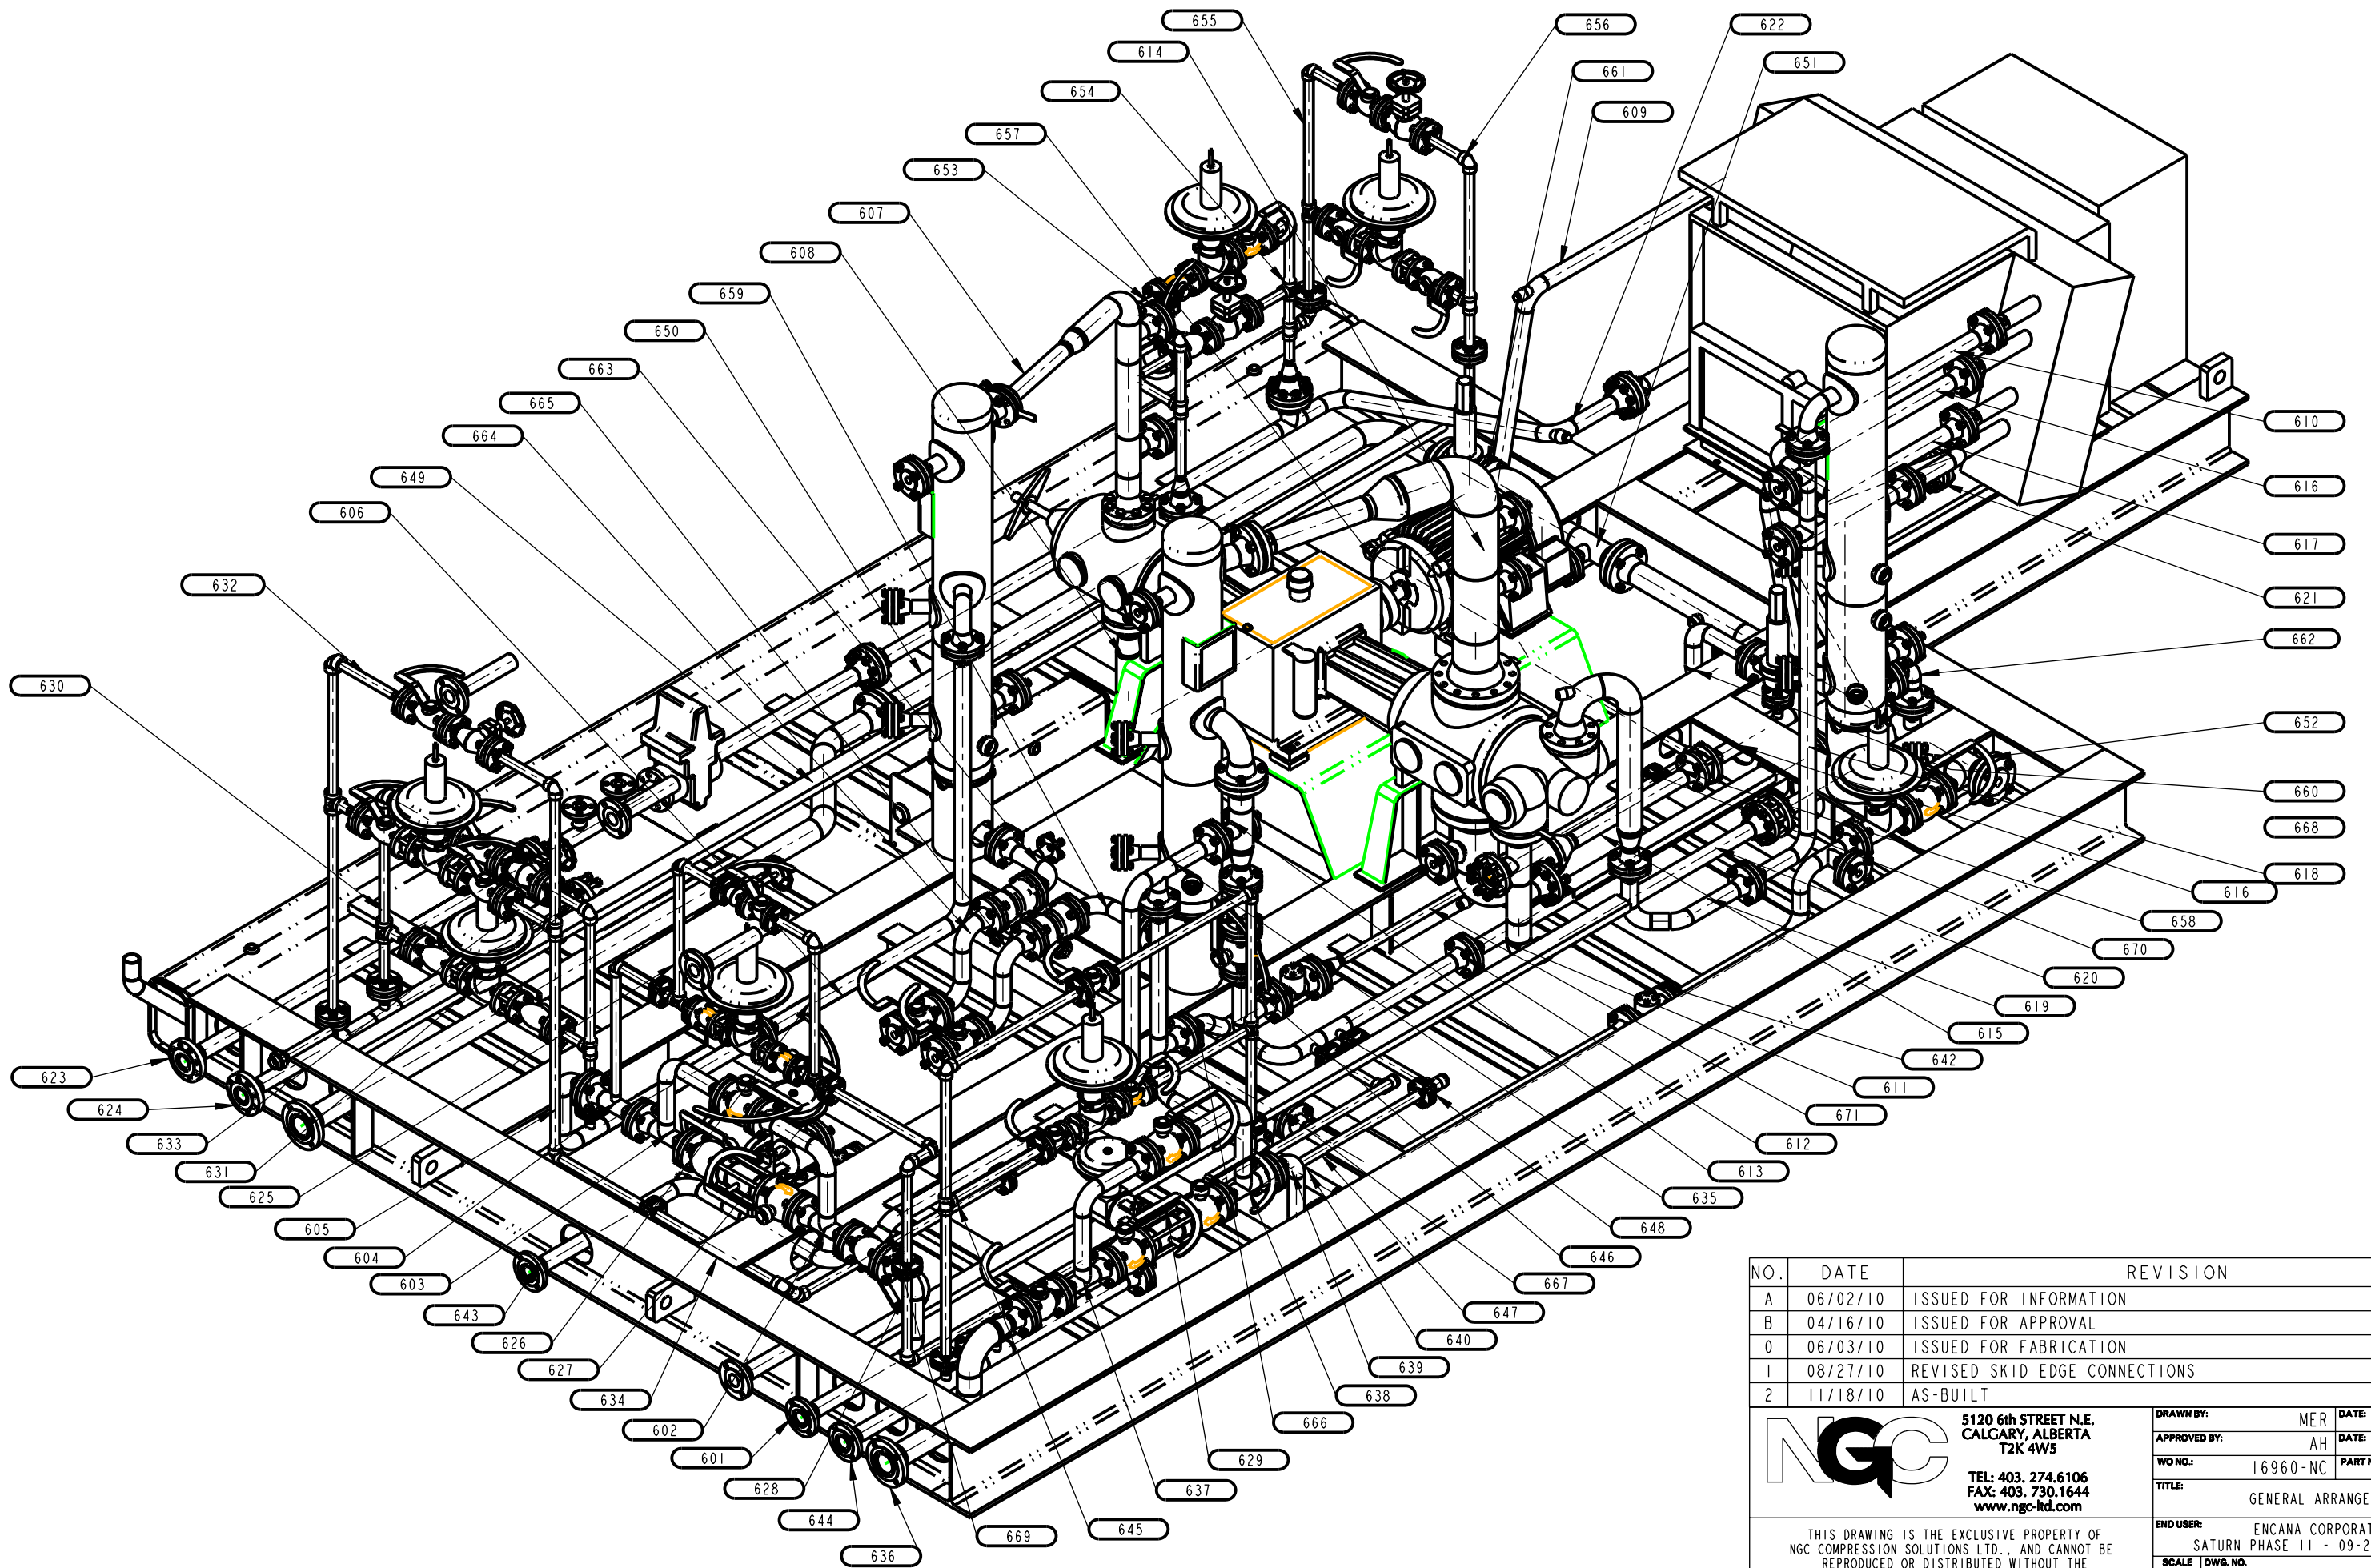

NO.	DATE	REVISION	BY
A	06/02/10	ISSUED FOR INFORMATION	MER
B	04/16/10	ISSUED FOR APPROVAL	MER
0	06/03/10	ISSUED FOR FABRICATION	MER
1	08/27/10	REVISED SKID EDGE CONNECTIONS	MER
2	11/18/10	AS-BUILT	ATE

	5120 6th STREET N.E. CALGARY, ALBERTA T2K 4W5		DRAWN BY: MER DATE: 05/31/10
	TEL: 403.274.6106 FAX: 403.730.1644 www.ngc-ltd.com		APPROVED BY: AH DATE: -
			WO NO.: 16960-NC PART NO.: -
TITLE: GENERAL ARRANGEMENT			END USER: ENCANA CORPORATION SATURN PHASE 11 - 09-27-79-17 W6M
SCALE: NTS DWG. NO.: 16960-500	SHEET 4 OF 4		REV: 2

THIS DRAWING IS THE EXCLUSIVE PROPERTY OF NGC COMPRESSION SOLUTIONS LTD., AND CANNOT BE REPRODUCED OR DISTRIBUTED WITHOUT THE PERMISSION OF NGC COMPRESSION SOLUTIONS LTD.