


BILL OF MATERIALS			
MK	QTY	PART NUMBER	DESCRIPTION
56	1	BWF-HODL	FLANGE, HUB, 2"-150# x 1"-NPT, SA350LF2
100	1	PI-1002	IND. PRESS. 0-300PSI, 4-1/2"DIAL, 1/2"NPT, BTM, SS MFG: WKA MODEL: 233.34
241	1	FLT-704	FILTER, COALESCING, 1" NPT, AL BODY, 70C ELEMENT MODEL: BEP-38-152-70C
414	1	BVS-0025	VALVE, BALL, 1"-NPT, CL1500, FP, 3PCS, FL, NACE MFG: JAG MODEL: T3-F10T15N
530	1	NVS-1004	VALVE, NEEDLE, 3/4"M X 1/2"F, NPT, 6000#, SWT MFG: CENTURY MODEL: CM23M64TBV

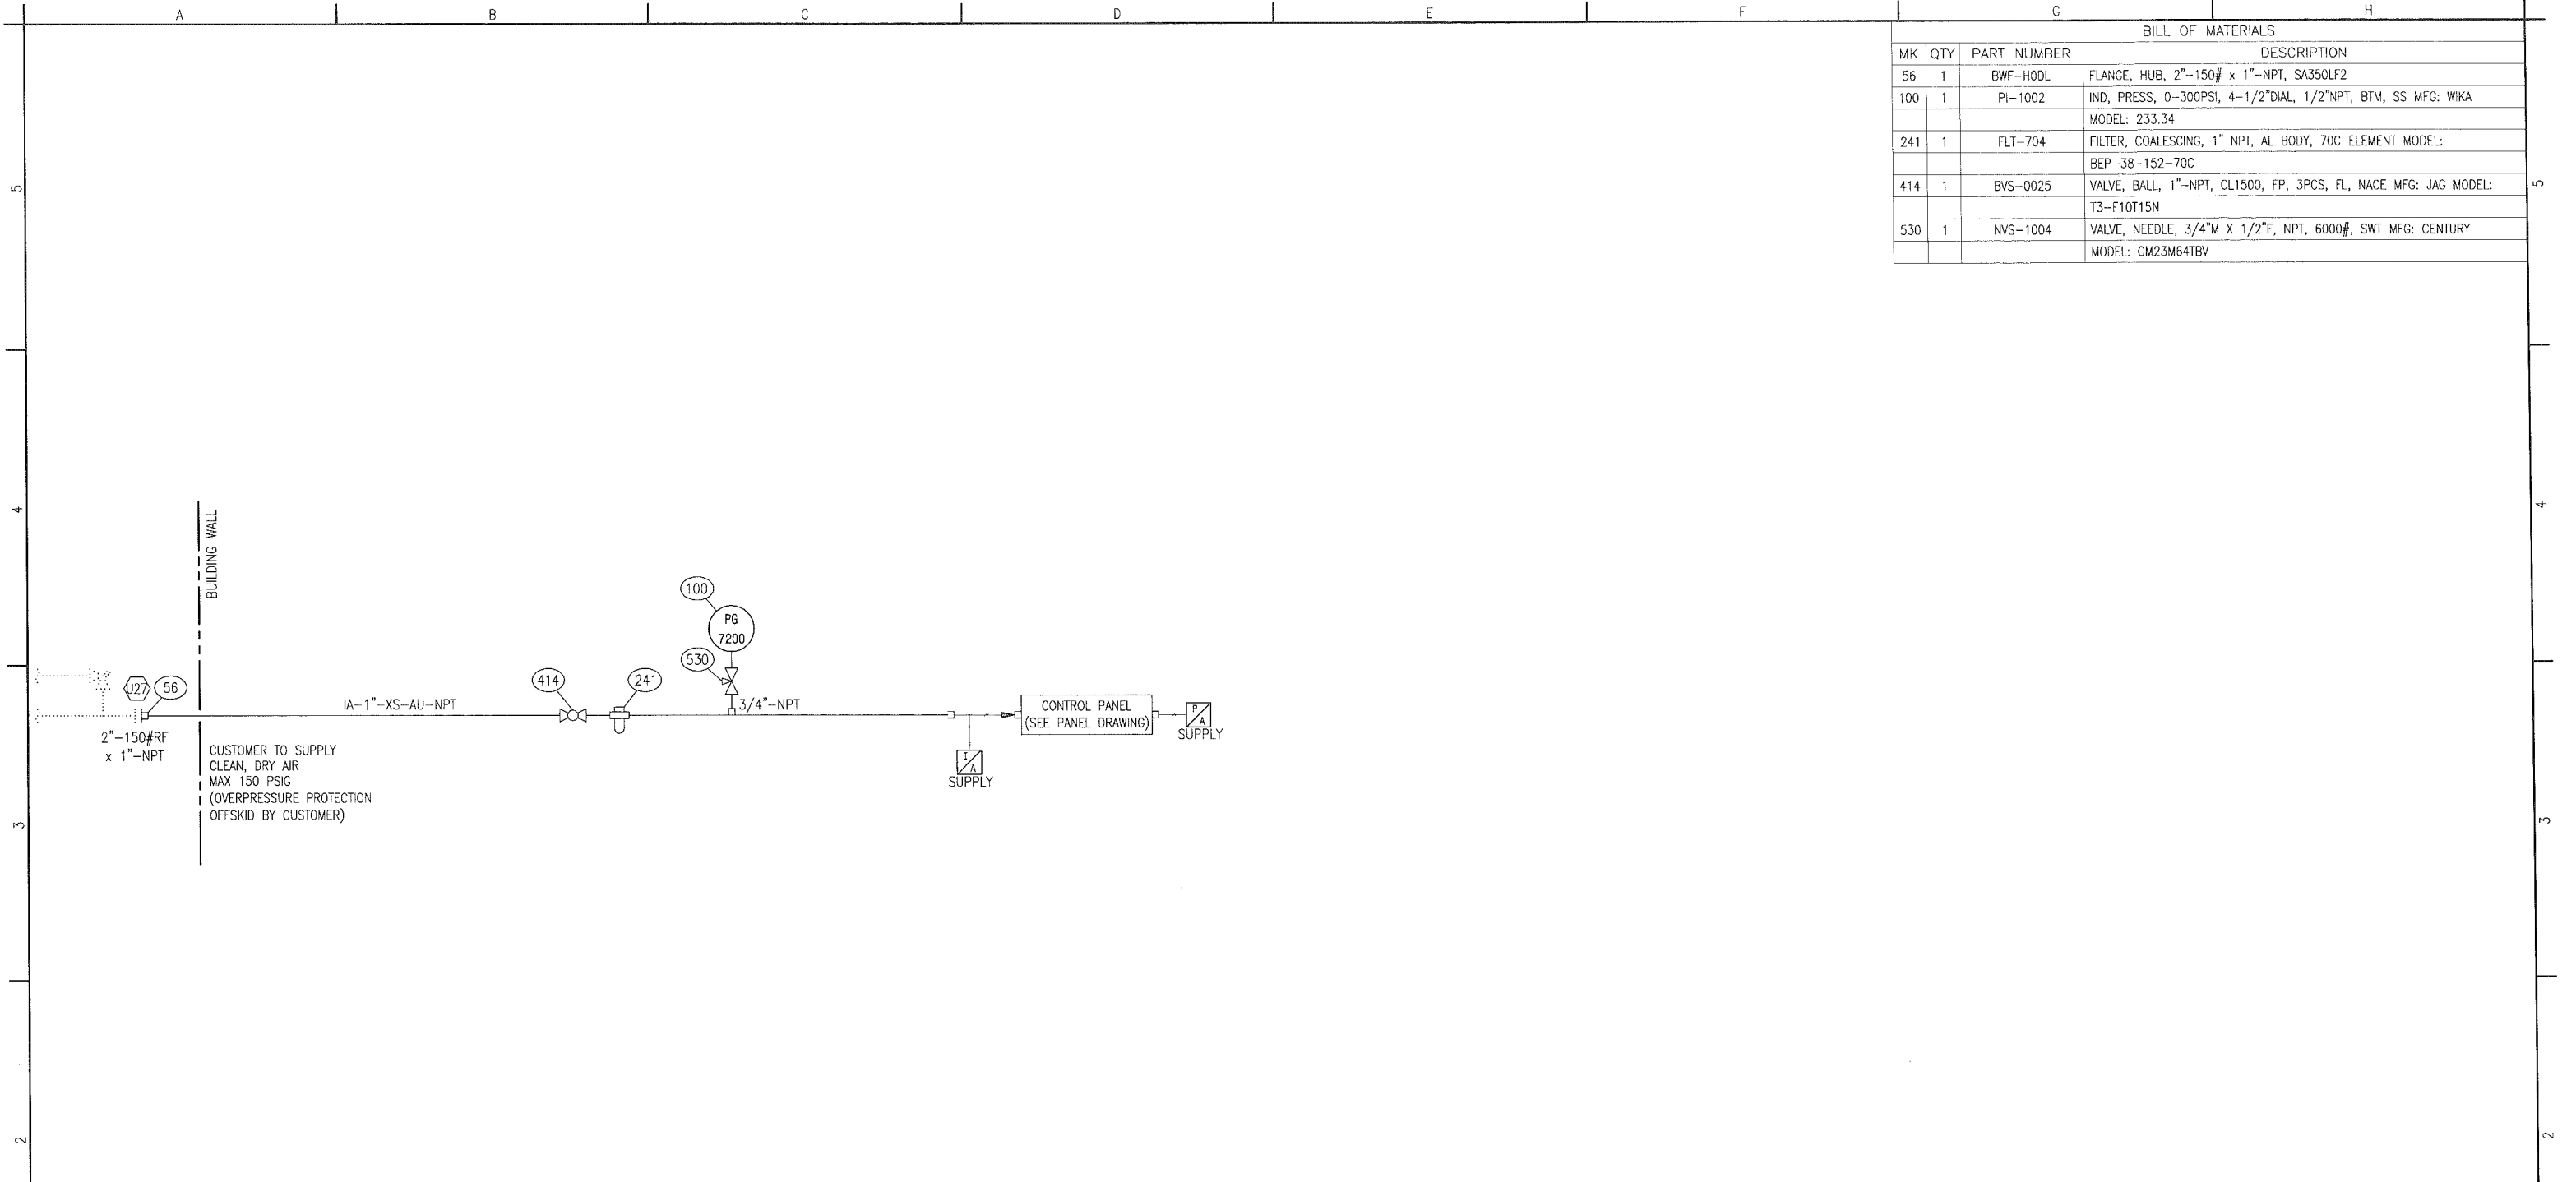

CUSTOMER TO SUPPLY
CLEAN, DRY AIR
MAX 150 PSIG
(OVERPRESSURE PROTECTION
OFFSKID BY CUSTOMER)

STANDARD TUBING SIZES	LINETYPE LEGEND	PNEUMATIC TERMINATIONS	INSTRUMENTATION TAGGING LEGEND
*1/4" - 0.049" *3/8" - 0.049" 1/2" - 0.049" 3/4" - 0.065" 1" - 0.083" *PER CLIENT SPEC	PROCESS PIPING ————— UTILITY PIPING ————— SEAMLESS TUBING ————— ELECTRICAL WIRING - - - - - INTERNAL LOGIC - - - - - OEM SUPPLIED - - - - - ASSEMBLY BOUNDARY - - - - - BUILDING WALL - - - - - DRIVETRAIN - - - - - CUSTOMER SUPPLIED ······	INSTRUMENT AIR PANEL AIR	LOCAL MOUNTED DEVICE PANEL MOUNTED DEVICE OFF-SKID MOUNTED DEVICE SIGNAL TO PANEL SIGNAL TO OFF-SKID PANEL LOGIC
ALL TUBING TO BE 316SS			

THIS DRAWING IS SOLE PROPERTY OF BIDE LL EQUIPMENT AND SHALL NOT BE REPRODUCED, COPIED, LENT, ALTERED NOR USED FOR ANY PURPOSE OTHER THAN WHICH IT IS FURNISHED EXCEPT WITH THE WRITTEN PERMISSION OF BIDE LL EQUIPMENT

AS BUILT
AS BUILT
2015/10/14

REV	DATE	CREATED	REVIEWED	APPROVED	DESCRIPTION
0	15-10-14	GW	TT	GM	AS BUILT

REVISIONS

MAIN SHOP / OFFICE
6900 - 112th AVENUE S.E.
CALGARY, AB T2C 4Z1
PHONE: (403) 235-5877
FAX: (403) 272-7749

BIDELL™
GAS COMPRESSION

APEGA PERMIT NUMBER
P08318

INSTRUMENT SUPPLY FLOWSHEET
WEG 350HP ELECTRIC/ARIEL JGR/2/AIR-X-LIMITED 96AEF
CUSTOMER: ENCANA c/o EQUINOX ENGINEERING
LOCATION: KAYBOB GAS PLANT PHASE 3 (DE-ETHANIZER)
LSD: 15-31-062-21 W5M

PAPER SIZE 11"x17" SCALE NTS DWG# 14-927-720 REV 0