


FRONT ELEVATION
3/4"=1'-0"

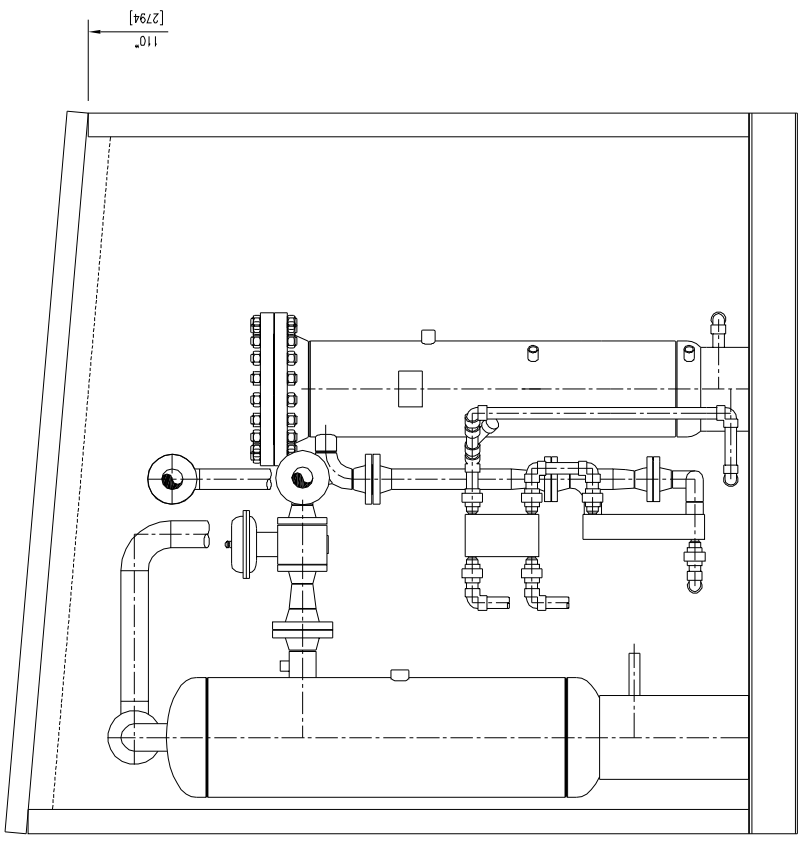

END VIEW
3/4"=1'-0"

GENERAL NOTES

1. ALL DIMENSIONS OUTSIDE OF BRACKETS ARE IN INCHES.
2. ALL DIMENSIONS WITHIN [] ARE IN MM.
3. ALL TAIL DIMENSIONS ARE FROM DATUM.
4. ALL WELDED PIPING TO BE HYDROTESTED TO B31.3
5. ALL PIPING TO BE SUBJECT TO 100% RADIOGRAPHY.
6. WELDING PROCEDURES TO BE PERFORMED TO MEET A 221-HRC HARDNESS TEST.
7. SEE CHART FOR PIPING/FITTING FOR MATERIAL/RATING REQ.

NOTES

11. SURFACE PREP.: - SELF PRIMING PAINT, SEE BELOW
PRIMER: 1 s/c GENERAL PAINT 16010, SELF PRIMING, GLOSS URETHANE ENAMEL, CONCEPT TAN
PAINT: 1 s/c GENERAL PAINT 16010, SELF PRIMING, GLOSS URETHANE ENAMEL, CONCEPT TAN
12. SHIPPING WEIGHT IS APPROX.: 19,000 LBS (8618 KGS)
13. ROOF VENTS REMOVED FOR SHIPPING

REV.

REV.	DESCRIPTION	DATE	BY	APPR.
1	AS-BUILT	JAN 25/06	T.K.	
0	ISSUED FOR CONSTRUCTION	DEC 19/05	B.R.	

ELEVATION VIEWS
GENERAL ARRANGEMENT

DATE	DATE	DATE	DATE
CC:135 UNIT	NGC JOB# 16370	DATE OCT 05/05	DATE
E. PETERS			

CONCEPT
COMPRESSION CORP.

FOR
DEVON CANADA
TALBOT LAKE COMPRESSOR
LSD: 13-21-97-10-W5

DATE 1005-45
REV. 1