




5

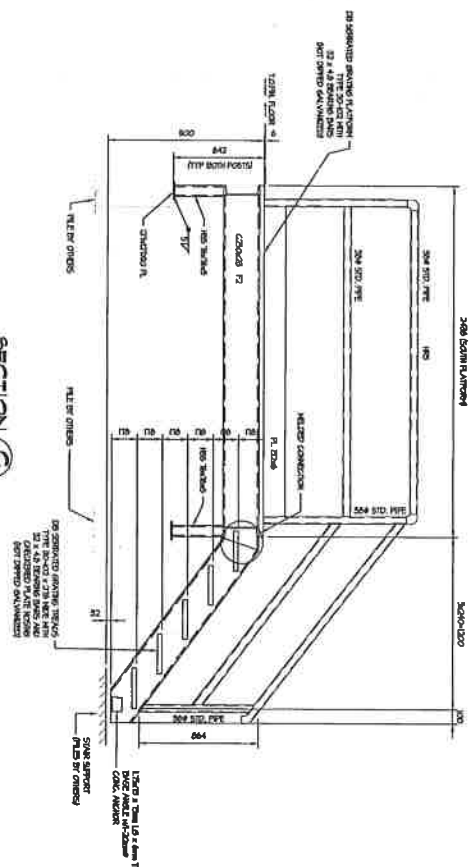

SECTION C  
ELEVATION

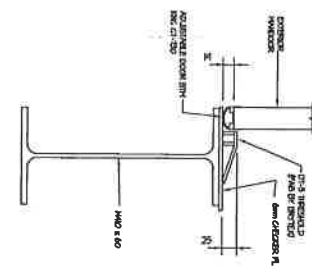

THRESHOLD DETAIL

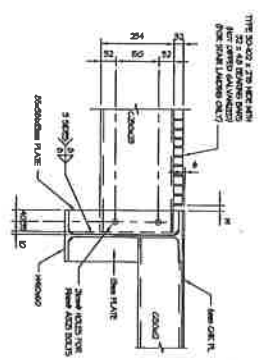

DETAIL A-2

NOTES  
FOR ARCHITECTURAL - SEE DWG A-1  
FOR SDO & DETAILS - SEE DWG A-2  
NOTE: ALL STAIRS, PLATFORMS & CANOPIES  
TO BE SHIPPED LOOSE

PROJECT STAIRS  
(SKID DESIGN BY OTHERS)  
SEE CLIENT DWG 2320-02-01-206

NO.	REVISION	DATE	BY
1	ISSUED FOR CLIENT APPROVAL & APPROVAL, USED FOR FABRICATION		
2			
3			
4			
5			
6			
7			
8			
9			
10			

PROJECT  
TRANS-CANADA PIPELINE  
WOODEN HOUSE COMPRESSOR STN  
DETAILS  
A.P.U. GENERATOR BUILDING

  
 BRITEK  
 CERTIFIED AS BUILT  
 DATE : 05.13.2020  
 JOB NO. : 18700  
 BY : [Signature]