


AS-BUILT
 DEC 28 2008
DeVitz

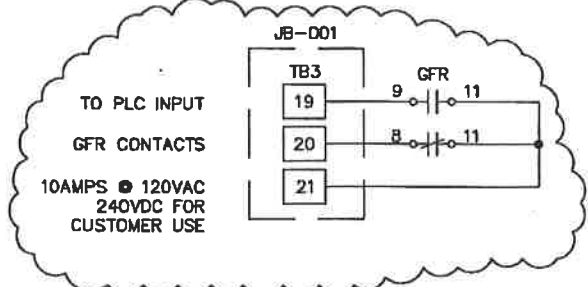

REV	DATE	BY	DESCRIPTION
0	2008-10-29	CM	AS-BUILT
1	2008-11-18	KMP	SHOP AS-BUILT

ALL DIMENSIONS IN MILLIMETRES
 UNLESS OTHERWISE NOTED
 WHOLE NUMBERS ±1mm ONE DECIMAL PLACE ±0.5mm

IMPORTANT
 THE INFORMATION CONTAINED HEREON WHICH IS THE PROPERTY OF FINNING (CANADA) MUST BE MAINTAINED IN CONFIDENCE, AND NO PORTION OF THIS DRAWING MAY BE REPRODUCED OR USED, WITHOUT THE EXPRESS PERMISSION OF THE COMPANY.

SCALE: N.T.S. EJOB: ID: K0844
 DRAWN: 08-11-18 KMP APPR'D:
 CHECKED: DESIGNED: 2008-10-29

REF:

Finning (Canada)
 Power Systems
 120 - 15100 River Road, Richmond, B.C., Canada V6V 1L6
 Tel: (604) 281-3900 Fax: (604) 281-5910 Internet: www.finning.ca

TRANSCANADA PIPELINES LIMITED

JB-001
 CUSTOMER CONNECTIONS

DRAWING NO. K0844B6010 SHEET 1 OF 1
 REV. 1