


THIS DRAWING IS THE PROPERTY OF EQUINOX ENGINEERING LTD. AND IS NOT TO BE REPRODUCED, COPIED, EITHER WHOLLY OR IN PART, OR TRANSMITTED IN ANY FORM OR BY ANY MEANS, ELECTRONIC OR MECHANICAL, INCLUDING PHOTOCOPYING, RECORDING, OR BY ANY INFORMATION STORAGE AND RETRIEVAL SYSTEM, WITHOUT THE WRITTEN PERMISSION OF EQUINOX ENGINEERING LTD.

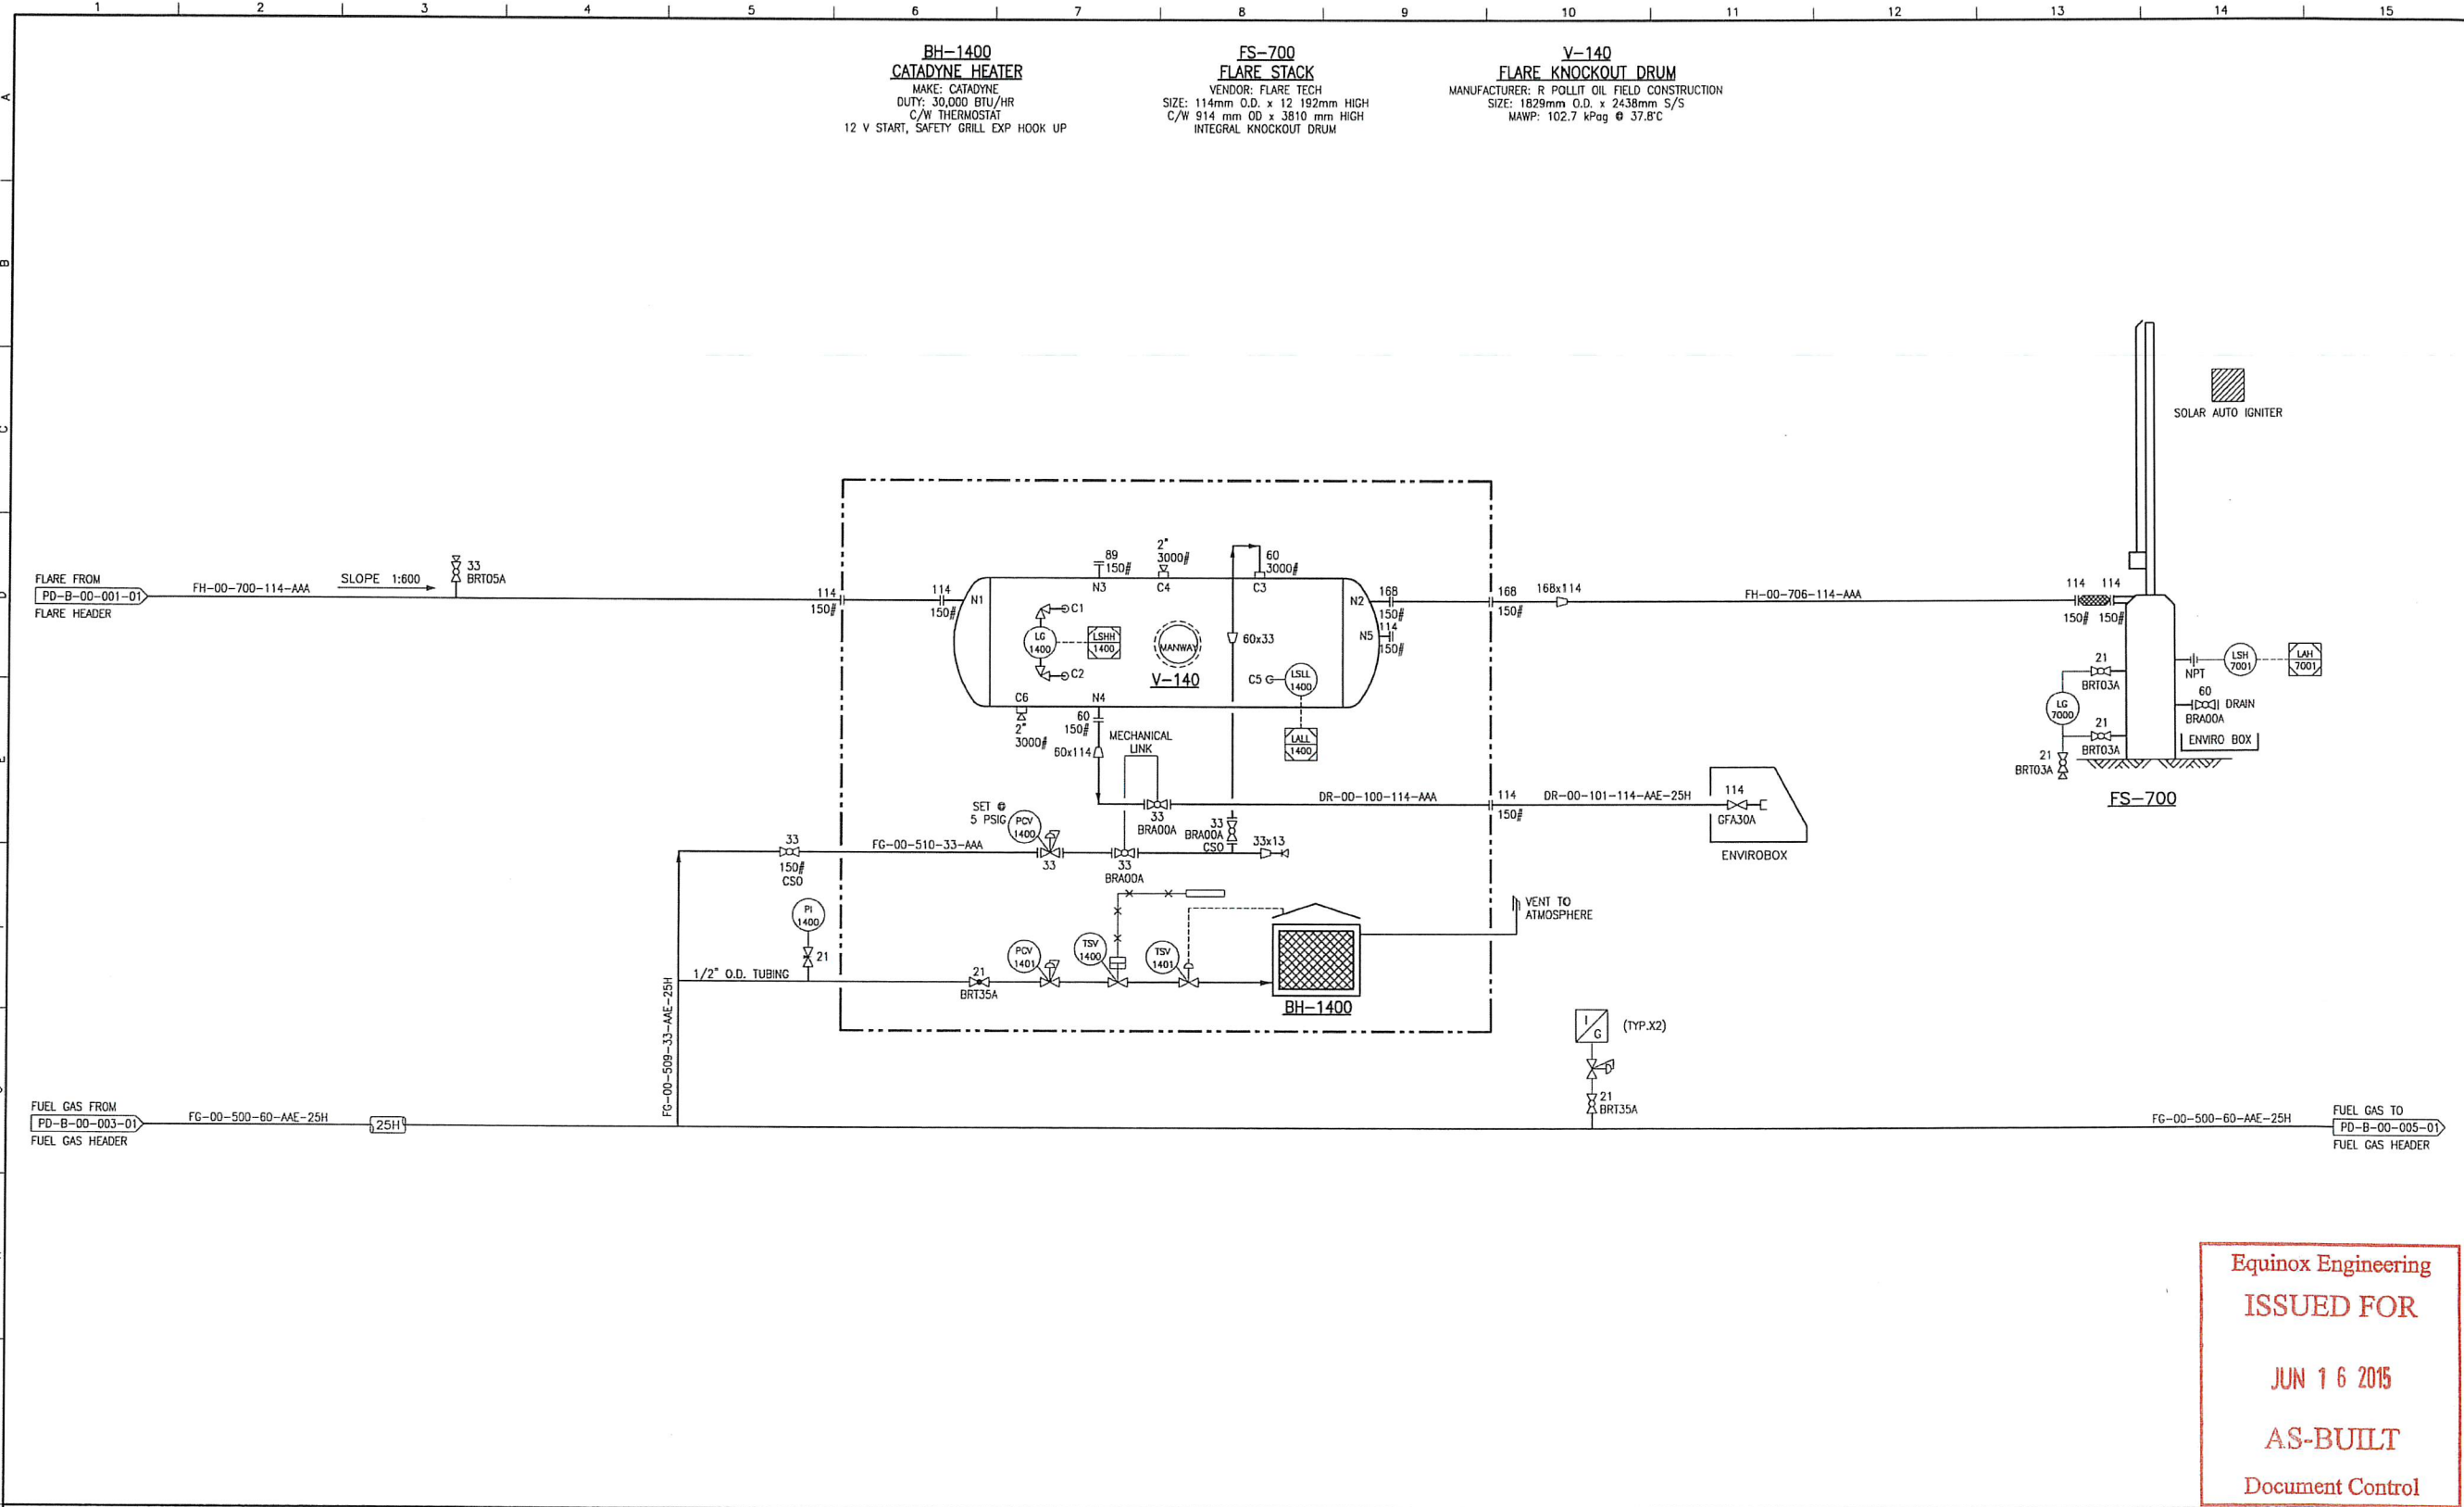

**BH-1400**  
**CATADYNE HEATER**  
 MAKE: CATADYNE  
 DUTY: 30,000 BTU/HR  
 C/W THERMOSTAT  
 12 V START, SAFETY GRILL EXP HOOK UP

**FS-700**  
**FLARE STACK**  
 VENDOR: FLARE TECH  
 SIZE: 114mm O.D. x 12 192mm HIGH  
 C/W 914 mm OD x 3810 mm HIGH  
 INTEGRAL KNOCKOUT DRUM

**V-140**  
**FLARE KNOCKOUT DRUM**  
 MANUFACTURER: R POLLIT OIL FIELD CONSTRUCTION  
 SIZE: 1829mm O.D. x 2438mm S/S  
 MAWP: 102.7 kPag @ 37.8°C

Equinox Engineering  
 ISSUED FOR  
 JUN 16 2015  
 AS-BUILT  
 Document Control

REFERENCE DRAWINGS		REVISIONS							SEAL	PERMIT						
DRAWING NO.	DRAWING DESCRIPTION	REV	DATE	BY	CHK'D DFTG	CHK'D ENG	APP'D PM	REVISION DESCRIPTION				PROJECT	REGION	PROJECT	DRAWING NO.	REV
		0	2014/10/08	IV				ISSUED FOR CONSTRUCTION				PD-B-00-009-01	1			
		1	2015/05/25	BSP				AS BUILT PER FIELD MARKUPS								

SCALE	DRAWN BY	DATE	CLIENT	REGION	PROJECT	DRAWING NO.	REV
N.T.S.	I. VILLABROZA	2014/10/08	195	02	00	PD-B-00-009-01	1