
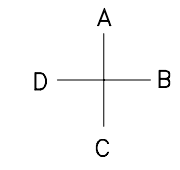


P:\Drafting\Archives\Jobs\1-424 S-05030 S-144 AB\B-GA-S05030-144 AB.dwg, Plan View, 7/25/2006 9:45:44 AM, scoflpc. This drawing is the Property of PC Compression Inc. It may not be duplicated or transmitted

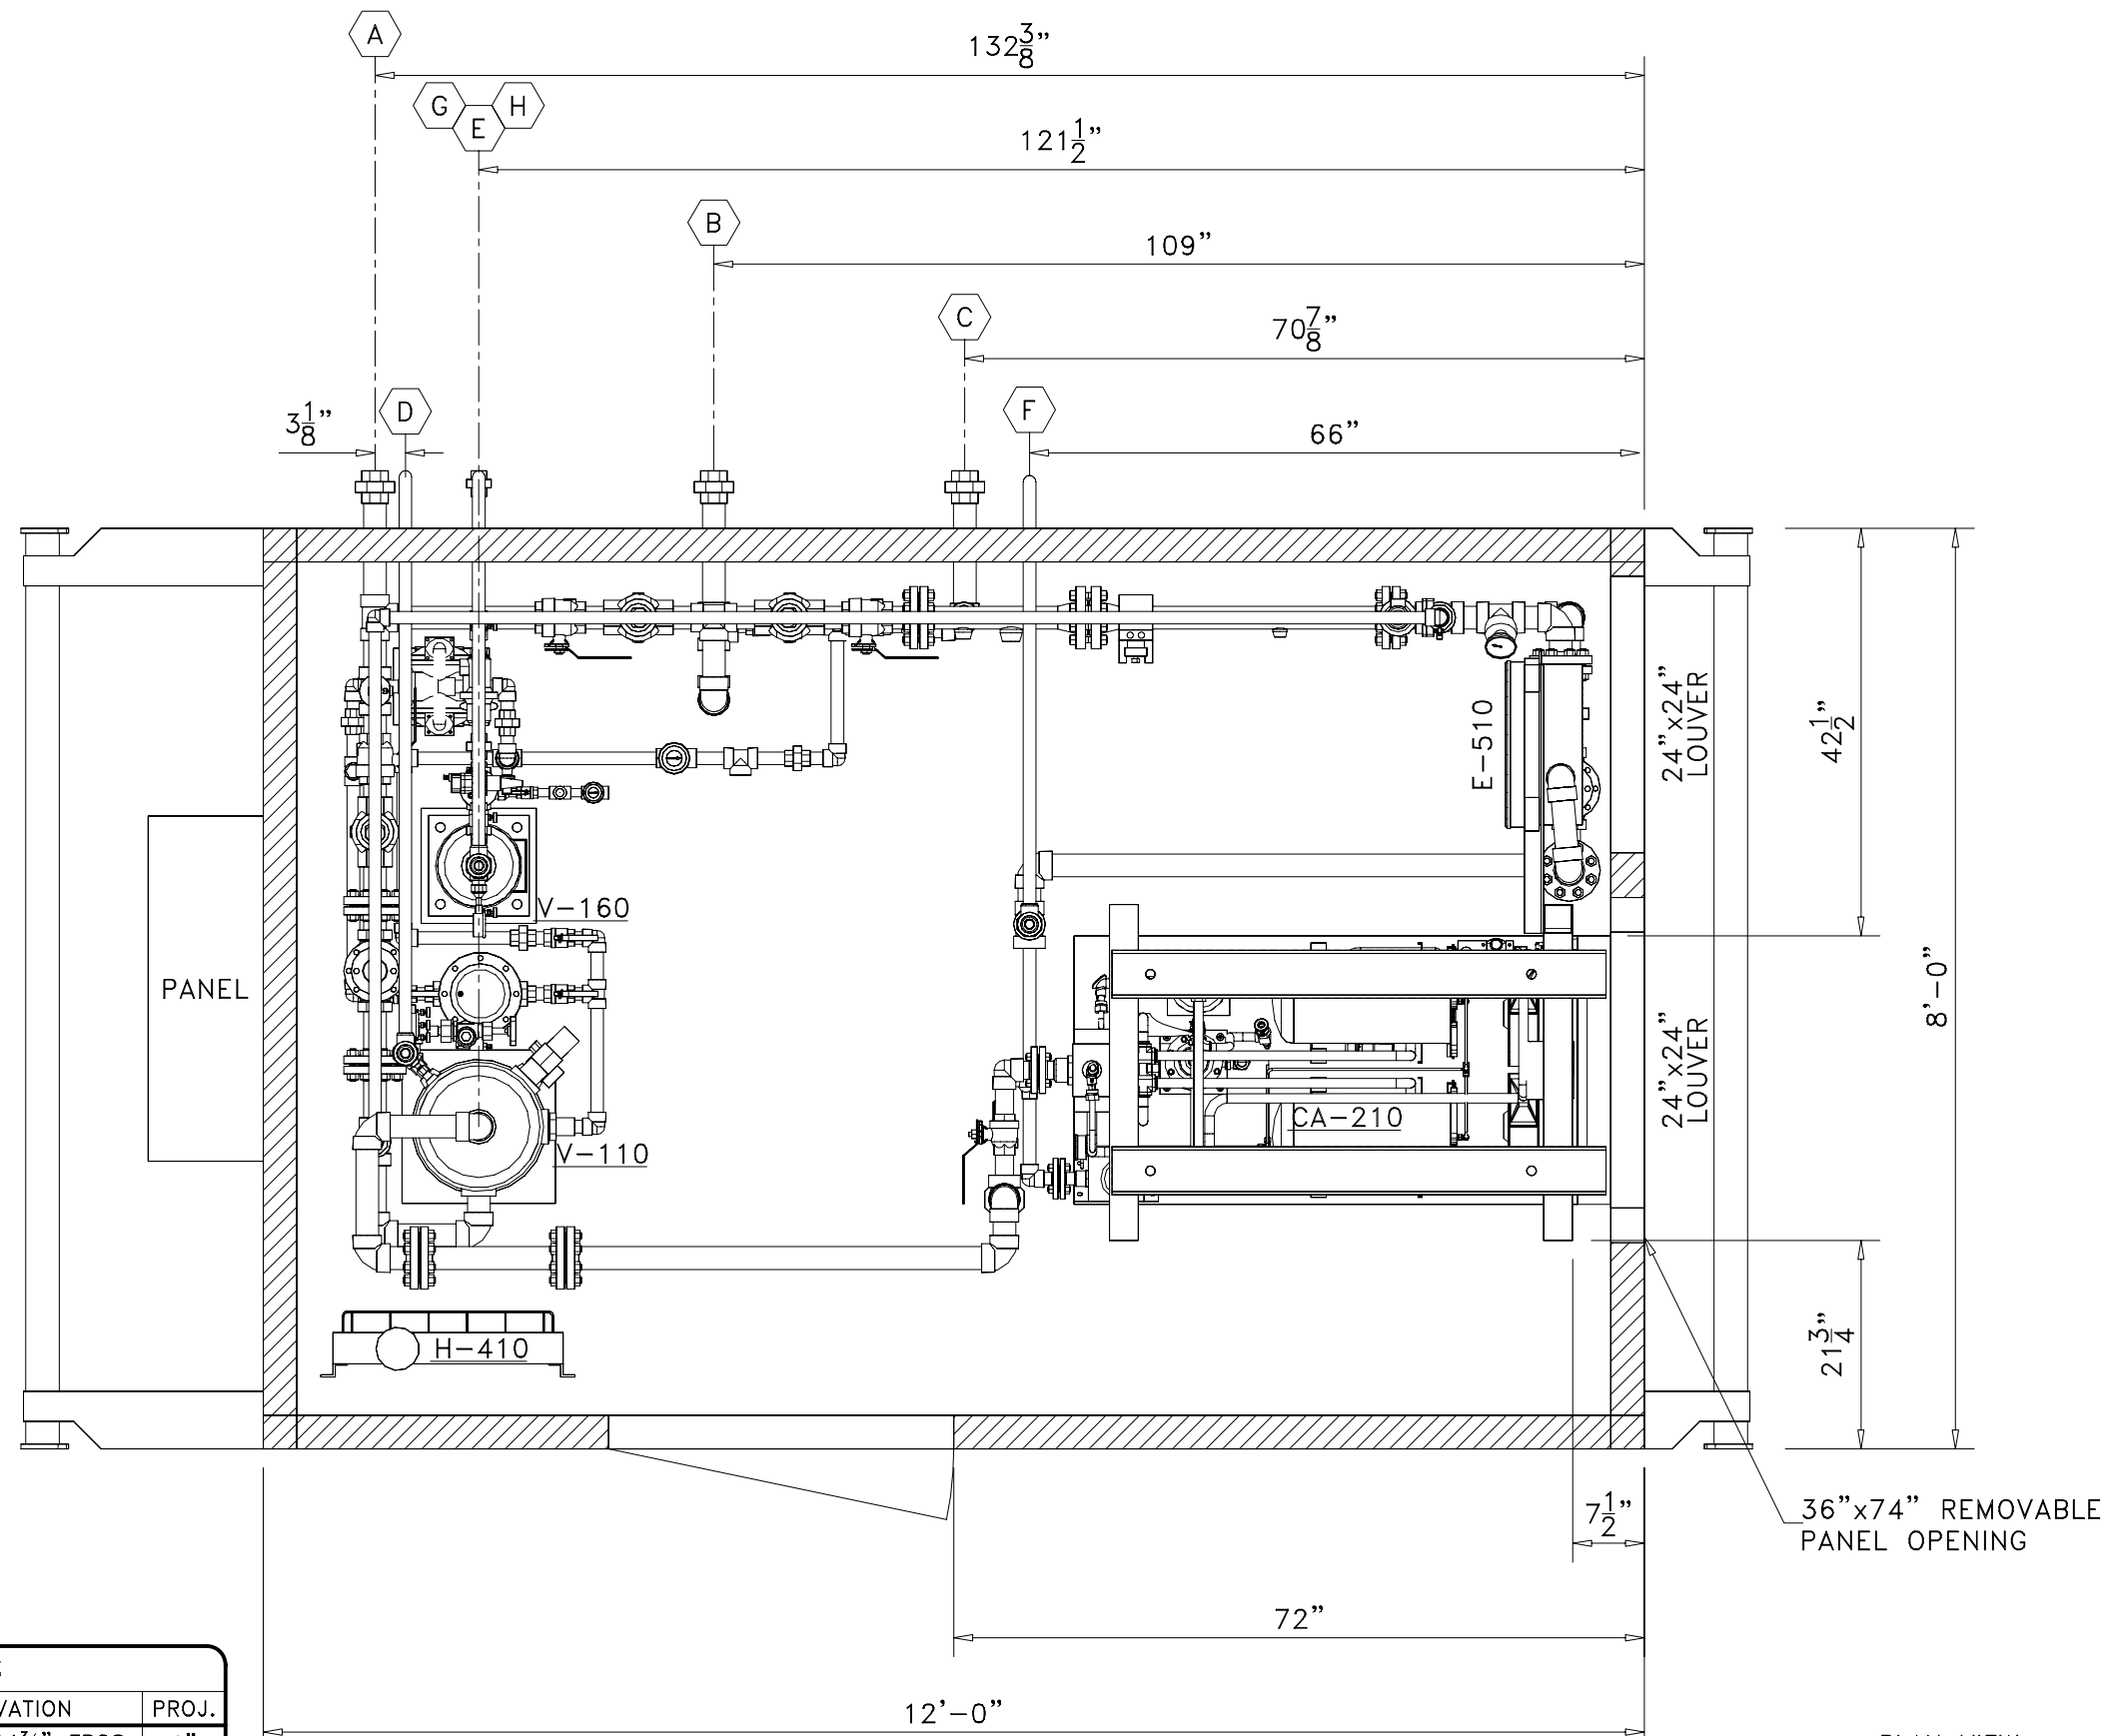


PLAN VIEW
SCALE 1:20


CUSTOMER CONNECTIONS				
ITEM	DESCRIPTION	SIZE	ELEVATION	PROJ.
A	GAS INLET	2" 3000# NPT	3'-11 ³ / ₈ " FBOS	6"
B	GAS OUTLET	2" 3000# NPT	3'-3 ¹ / ₂ " FBOS	6"
C	V-110 DRAIN	1" 3000# NPT	1'-1 ³ / ₈ " FBOS	6"
D	PSV-1101 VENT	1" 3000# NPT	7'-0 ¹ / ₄ " FBOS	6"
E	PSV-1601 VENT	1" 3000# NPT	7'-6 ¹ / ₄ " FBOS	6"
F	PSV-2101 VENT	1" 3000# NPT	7'-6 ¹ / ₄ " FBOS	6"
G	BLOWDOWN	1" 3000# NPT	5'-10 ⁷ / ₈ " FBOS	6"
H	FUEL GAS SUPPLY	1" 3000# NPT	0'-0" FBOS	6"

		Drawn by: M.E.W. Date: 07-28-04 Checked by:		S-144 SCROLL SERIES SZ044C1A w/ 12" x 48" VESSEL LSD: 10-36-37-20 W4M			
2308-8th St. Nisku Alberta T9E 7Z2		Office: 780.955.4292 Fax: 780.955.4294 Toll Free: 866.955.4292		Approved by:		Company: SIGNALTA	
1 AS BUILT 0 ISSUED FOR CONSTRUCTION		DTL 12-05-05 DTL 10-17-05		Scale: 1:20		Quote/Ref. NO.: Job NO.: 1-424 Unit NO.: S-05030 Drawing NO.: GA-S05030-B-01 Rev.: 1	
REV. DESCRIPTION		BY DATE CHKD APPD					


P:\Drafting\Archives\Jobs\1-400 to 499\1-424 S-05030 S-144 AB\B-GA-S05030-144 AB.dwg, 'C' Elevation, 7/25/2006 9:46:52 AM, scottpc. This drawing is the Property of PC Compression Inc. It may not be duplicated or transmitted


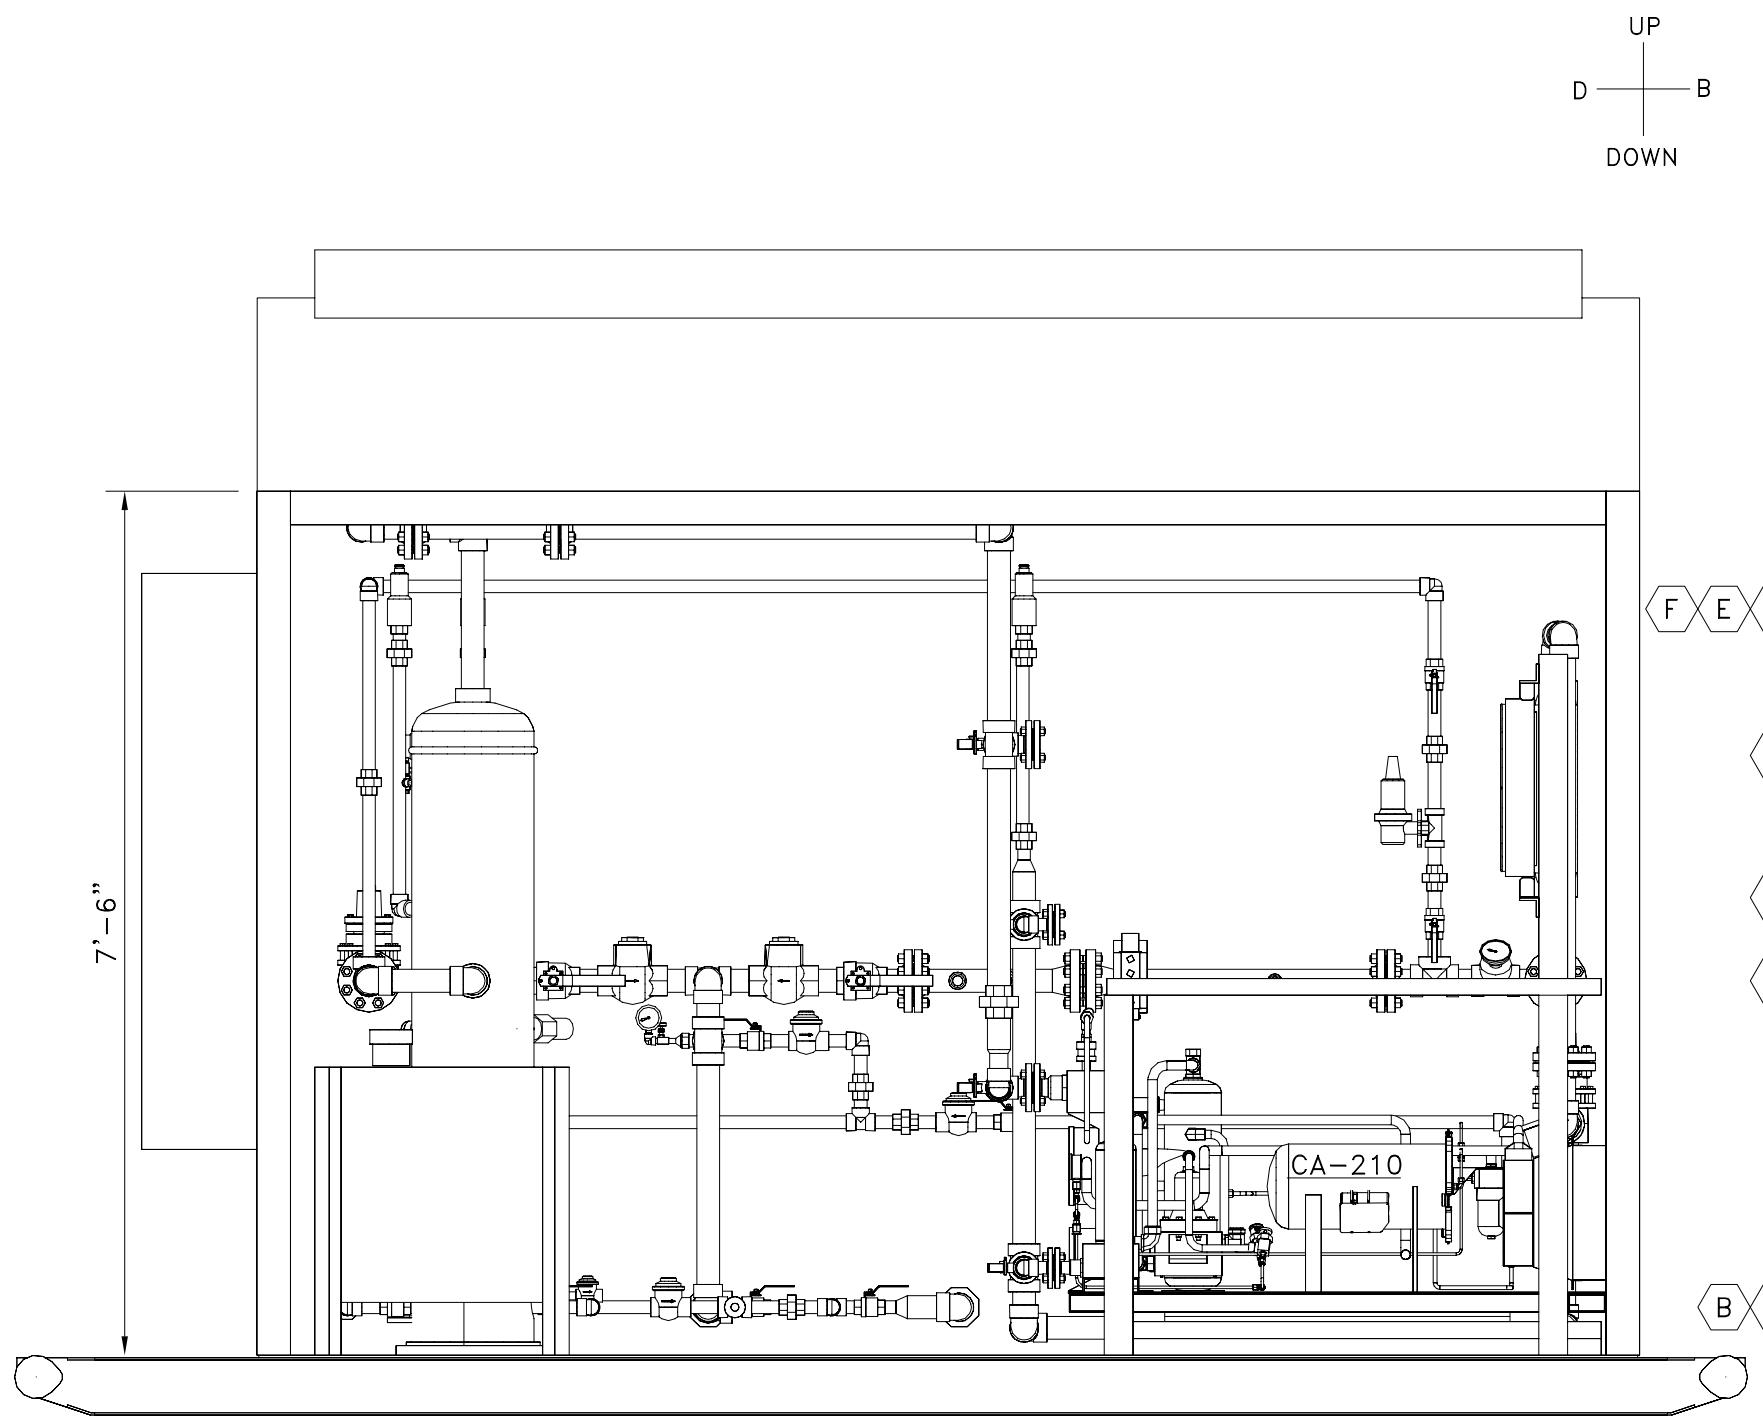


'C' ELEVATION VIEW
SCALE 1:20

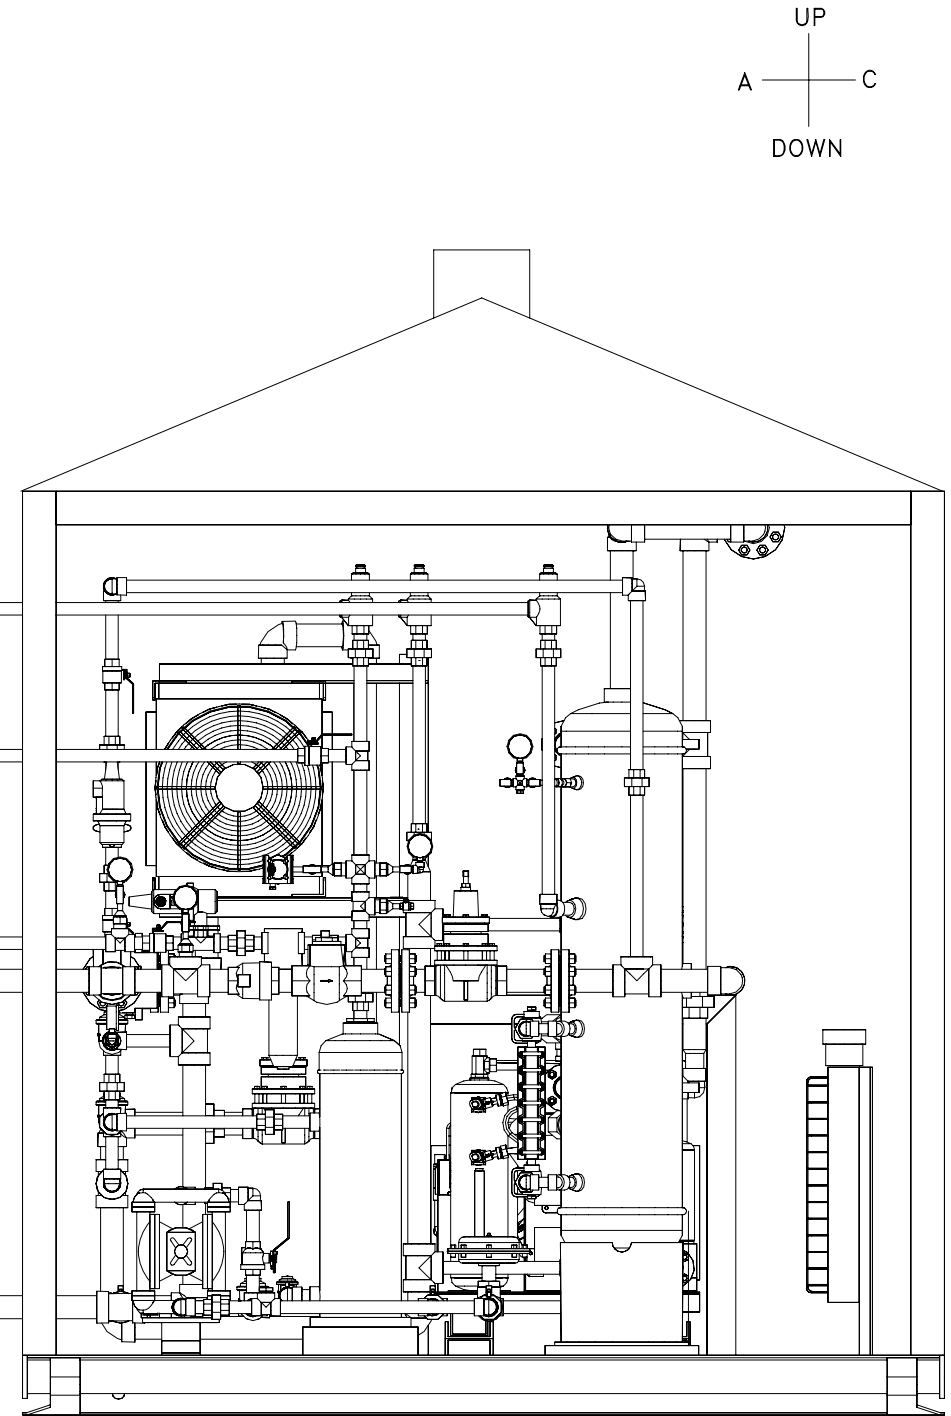


'D' ELEVATION VIEW
SCALE 1:20



						Drawn by: M.E.W. Date: 07-28-04 Checked by:		S-144 SCROLL SERIES SZ044C1A w/ 12" x 48" VESSEL LSD: 10-36-37-20 W4M Approved by: Company: SIGNALTA			
						2308-8th St. Office: 780.955.4292 Nisku Alberta Fax: 780.955.4294 T9E 7Z2 Toll Free: 866.955.4292					
1	AS BUILT	DTL	12-05-05								
0	ISSUED FOR CONSTRUCTION	DTL	10-17-05								
REV.	DESCRIPTION	BY	DATE	CHKD	APPD						

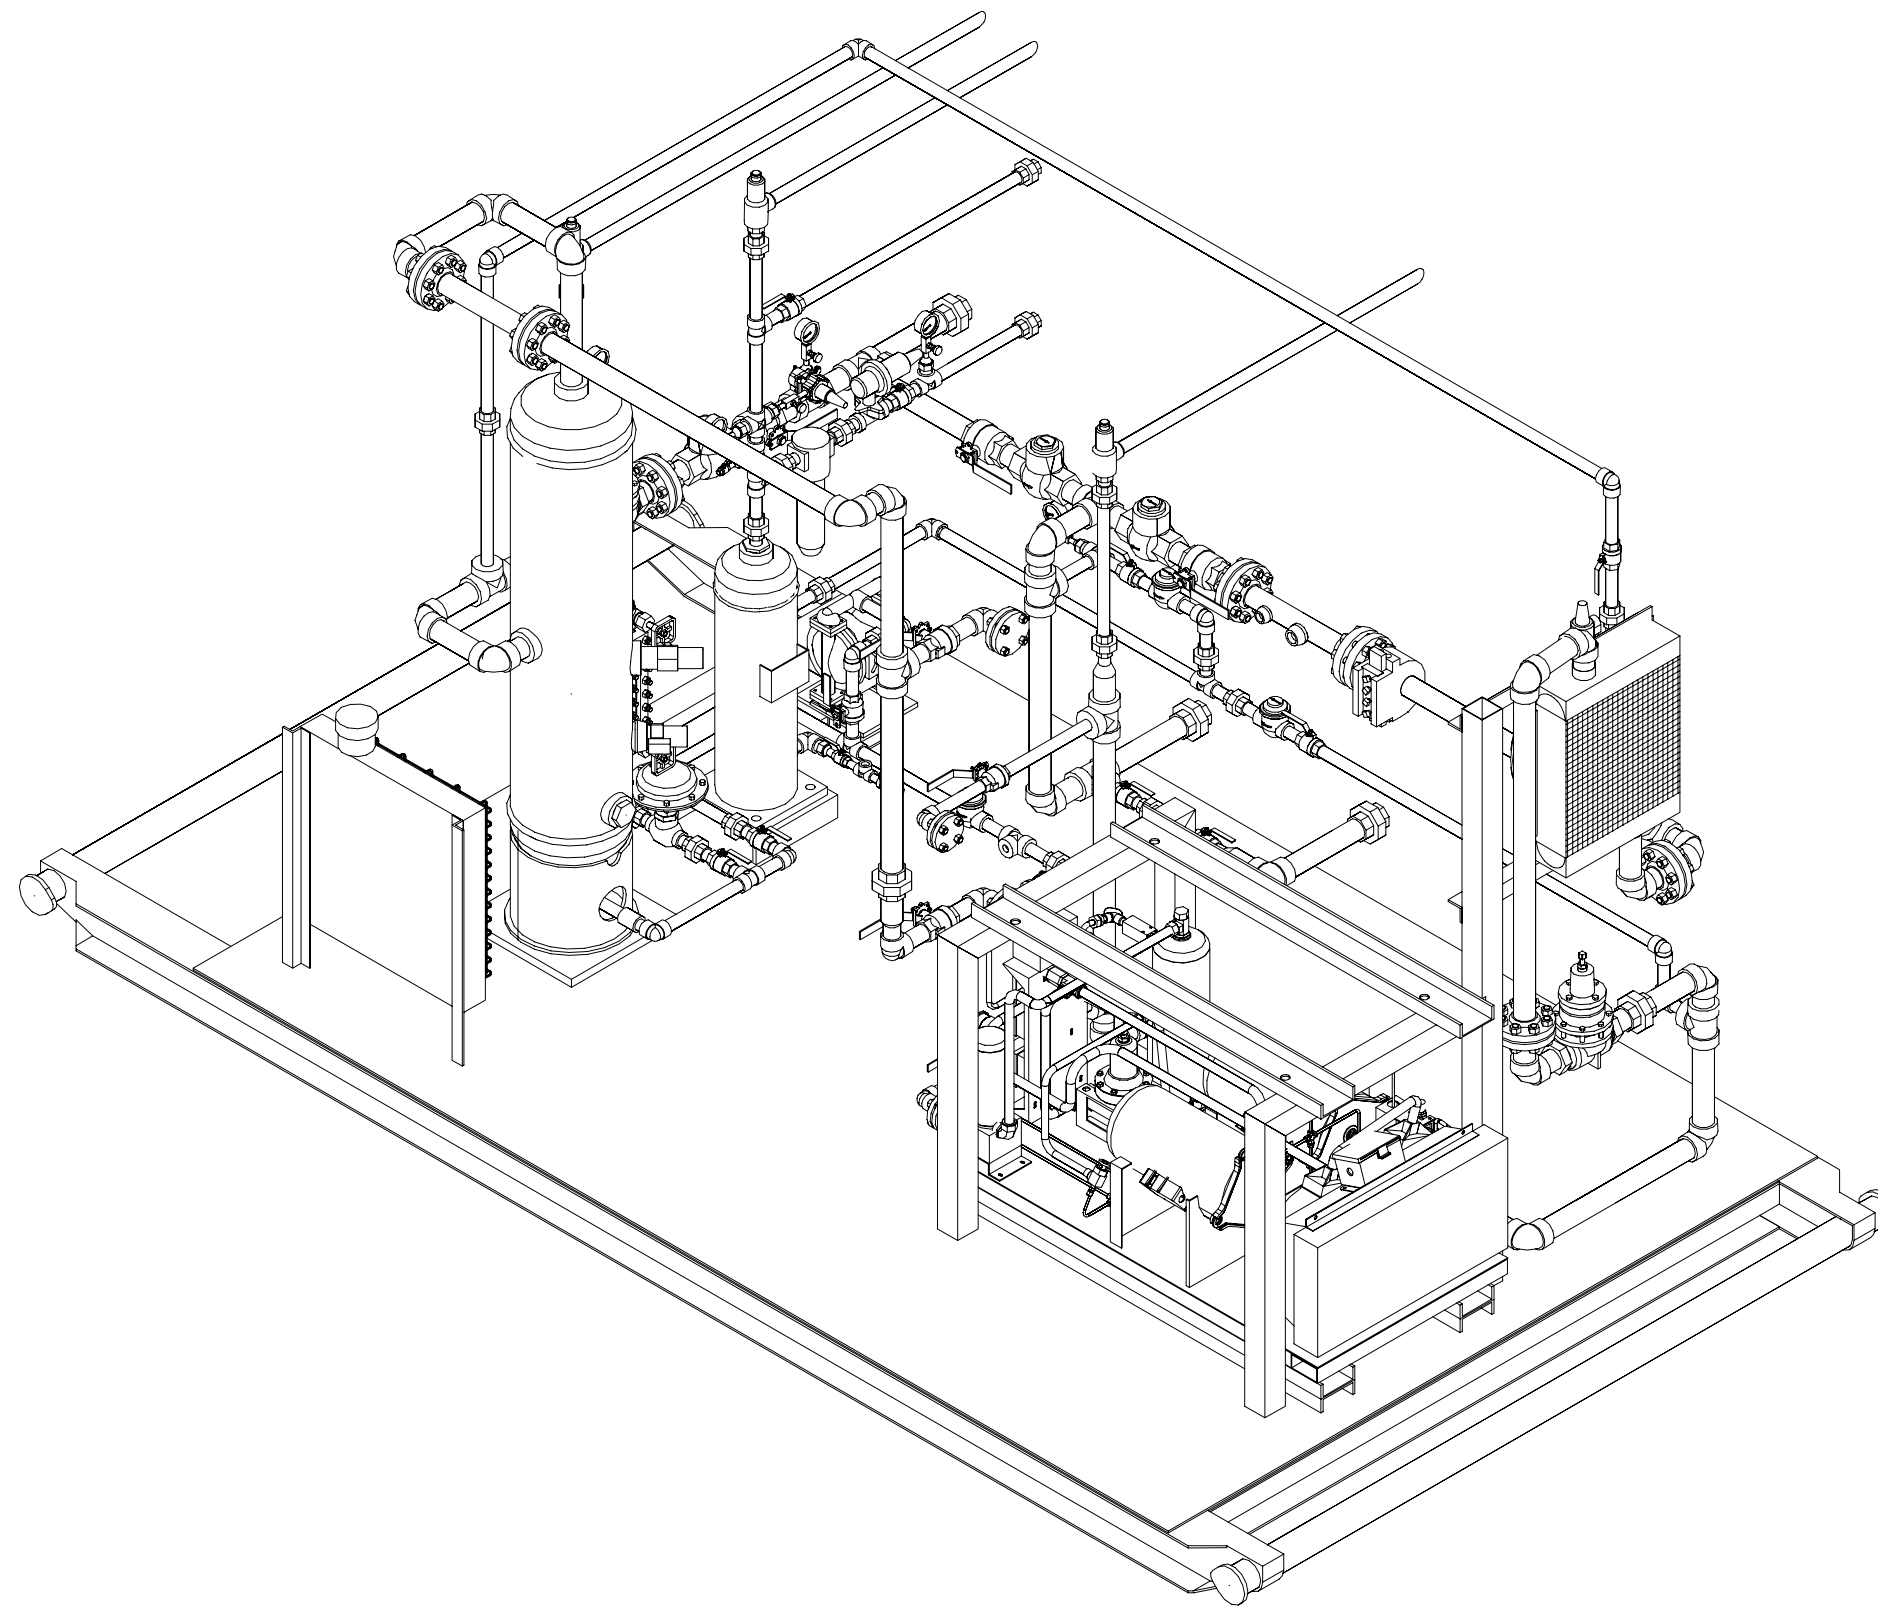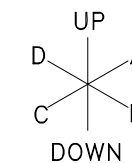


'SE' ISOMETRIC VIEW
SCALE 1:20

1		AS BUILT	DTL	12-05-05			Drawn by: M.E.W. Date: 07-28-04 Checked by:		S-144 SCROLL SERIES SZ044C1A w/ 12" x 48" VESSEL LSD: 10-36-37-20 W4M			
0		ISSUED FOR CONSTRUCTION	DTL	10-17-05			2308-8th St. Office: 780.955.4292 Nisku Alberta Fax: 780.955.4294 T9E 7Z2 Toll Free: 866.955.4292		Approved by: Company:		SIGNALTA	
REV.		DESCRIPTION	BY	DATE	CHKD	APPD	Scale:	Quote/Ref. NO.:	JOB NO.:	Unit NO.:	Drawing NO.:	Rev.:
							1:20	-	1-424	S-05030	GA-S05030-B-03	1

P:\Drafting\Archives\Jobs\1-400 to 499\1-424 S-05030 S-144 AB\B-GA-S05030-144 AB.dwg, S.E. Isometric View, 7/25/2006 9:47:34 AM, scoflopc. This drawing is the Property of PC Compression Inc. It may not be duplicated or tr

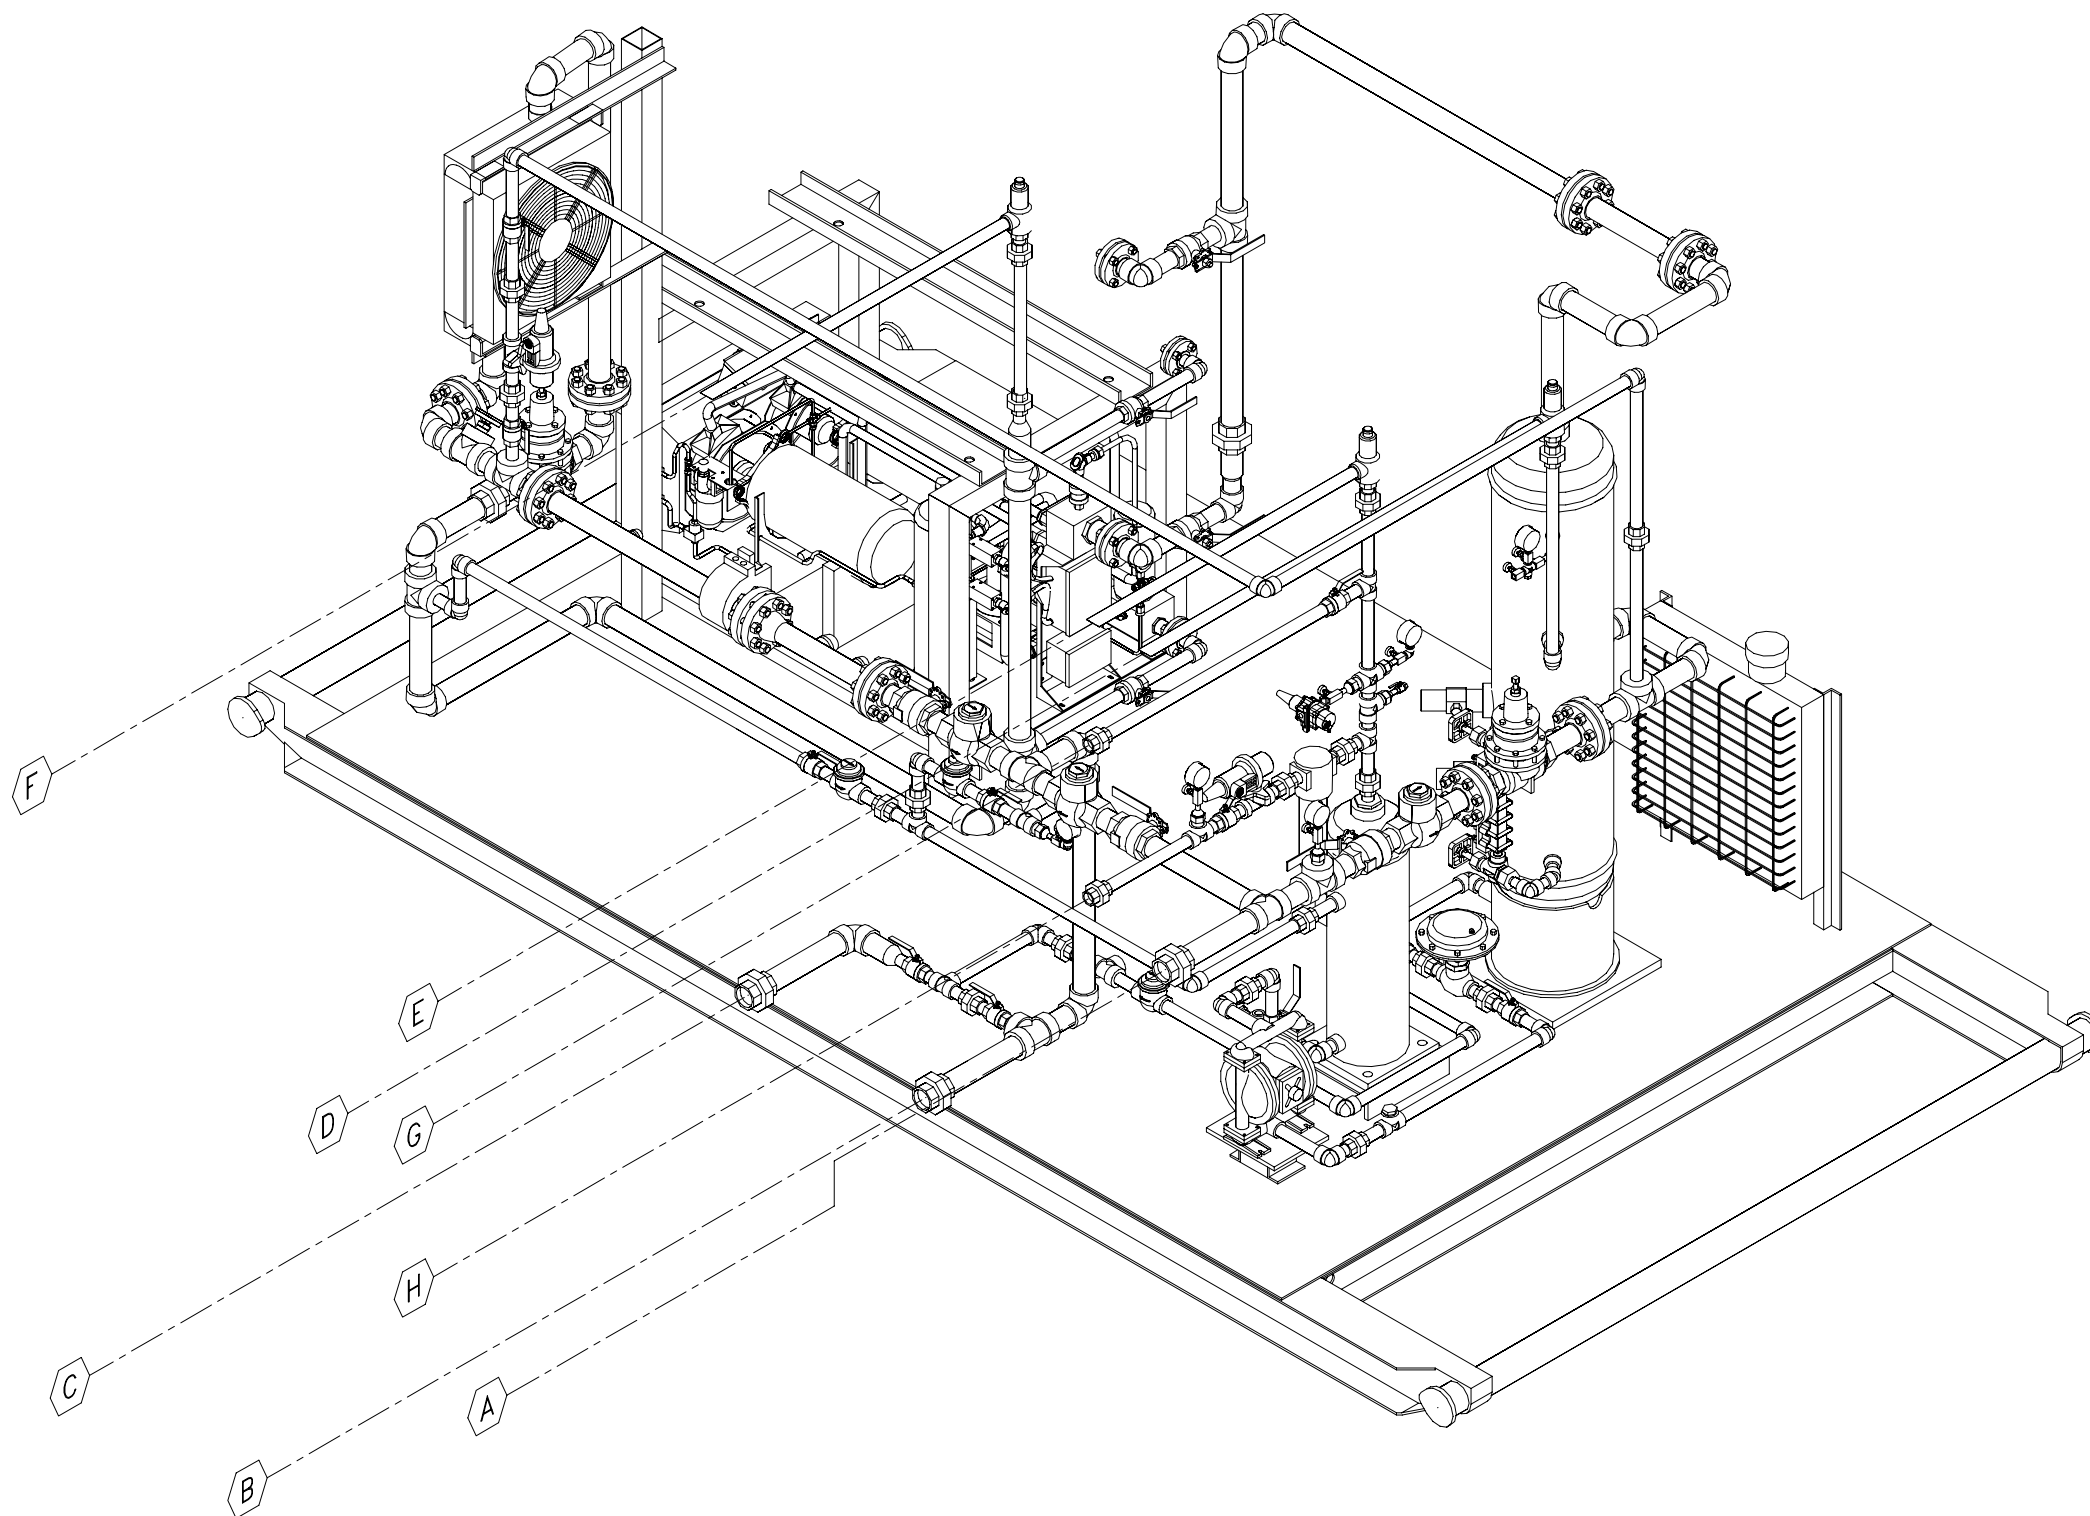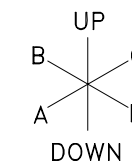

'NW' ISOMETRIC VIEW
SCALE 1:20

1		AS BUILT	DTL	12-05-05		Drawn by: M.E.W.	S-144 SCROLL SERIES			
0		ISSUED FOR CONSTRUCTION	DTL	10-17-05		2308-8th St. Nisku Alberta T9E 7Z2	Date: 07-28-04	SZ044C1A w/ 12" x 48" VESSEL		
REV.	DESCRIPTION	BY	DATE	CHKD/APPD	Office: 780.955.4292 Fax: 780.955.4294 Toll Free: 866.955.4292	Checked by:	LSD: 10-36-37-20 W4M			
					Approved by:	Company:	SIGNALTA			
					Scale:	Quote/Ref. NO.:	JOB NO.:	Unit NO.:	Drawing NO.:	Rev.:
					1:20	-	1-424	S-05030	GA-S05030-B-04	1

P:\Drafting\Archives\Jobs\1-400 to 499\1-424 S-05030 S-144 AB\B-GA-S05030-144 AB.dwg, N.W. Isometric View, 7/25/2006 9:48:53 AM, scoflepc, This drawing is the Property of PC Compression Inc. It may not be duplicated or tr