

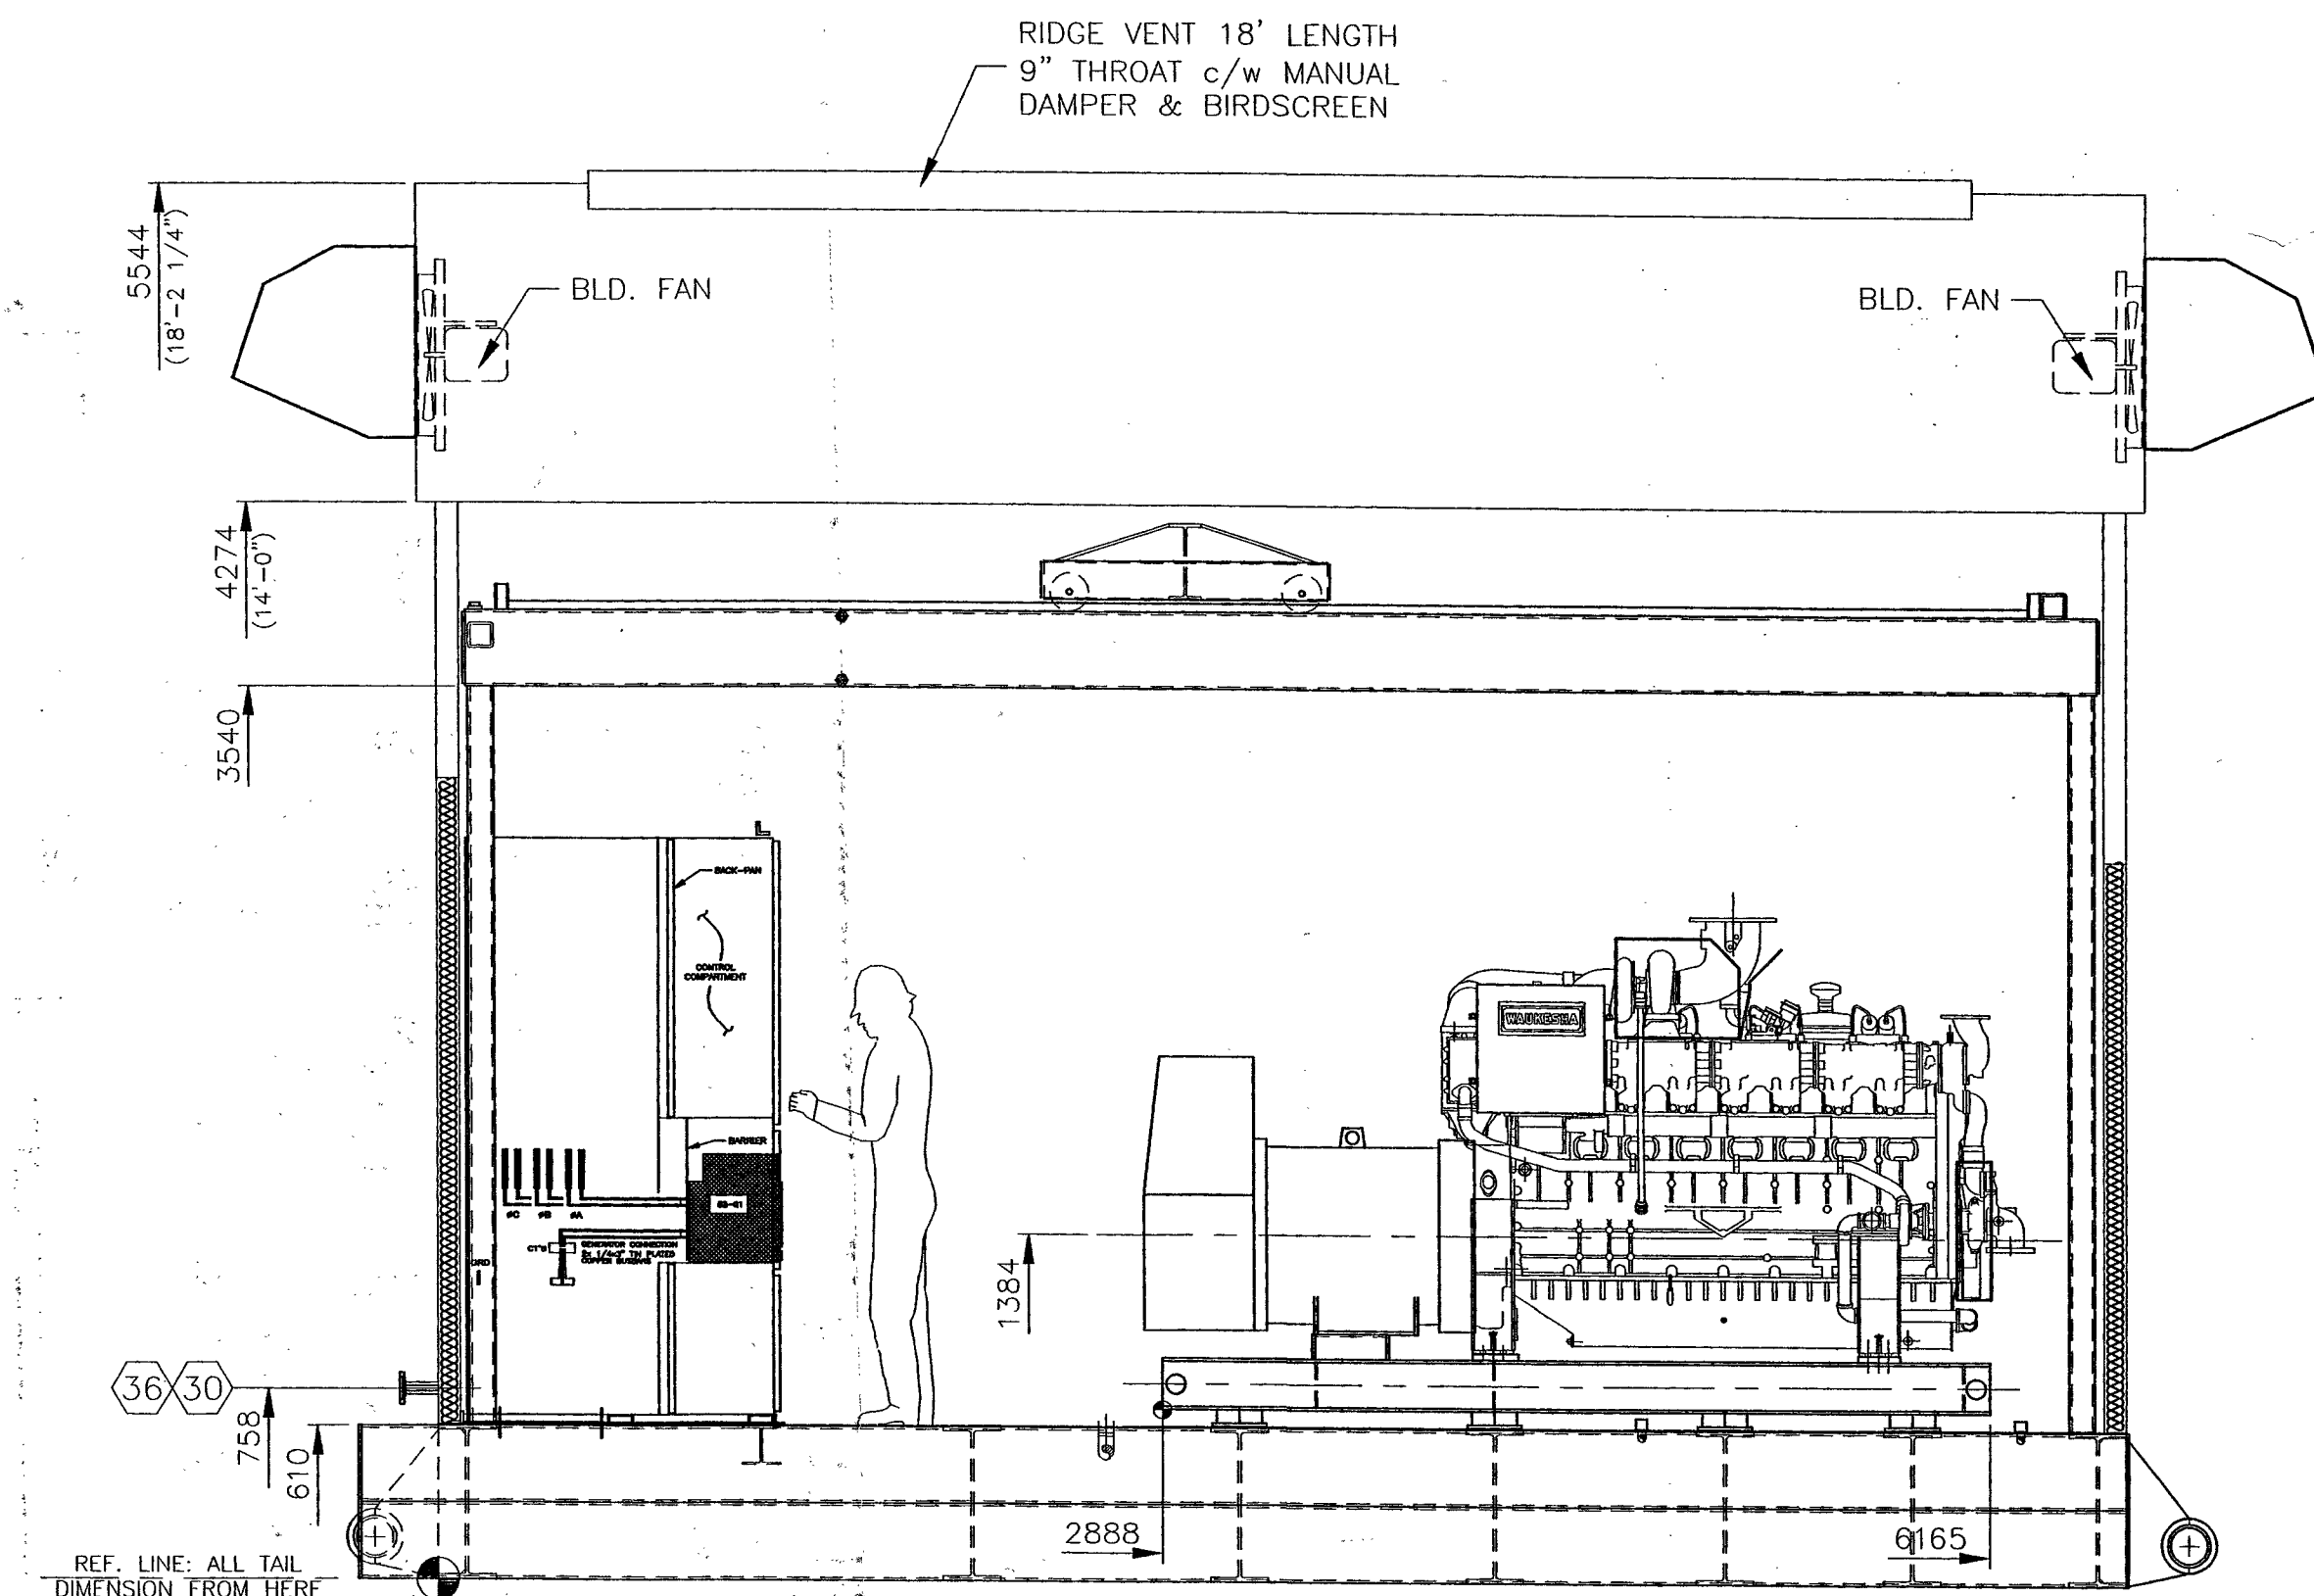


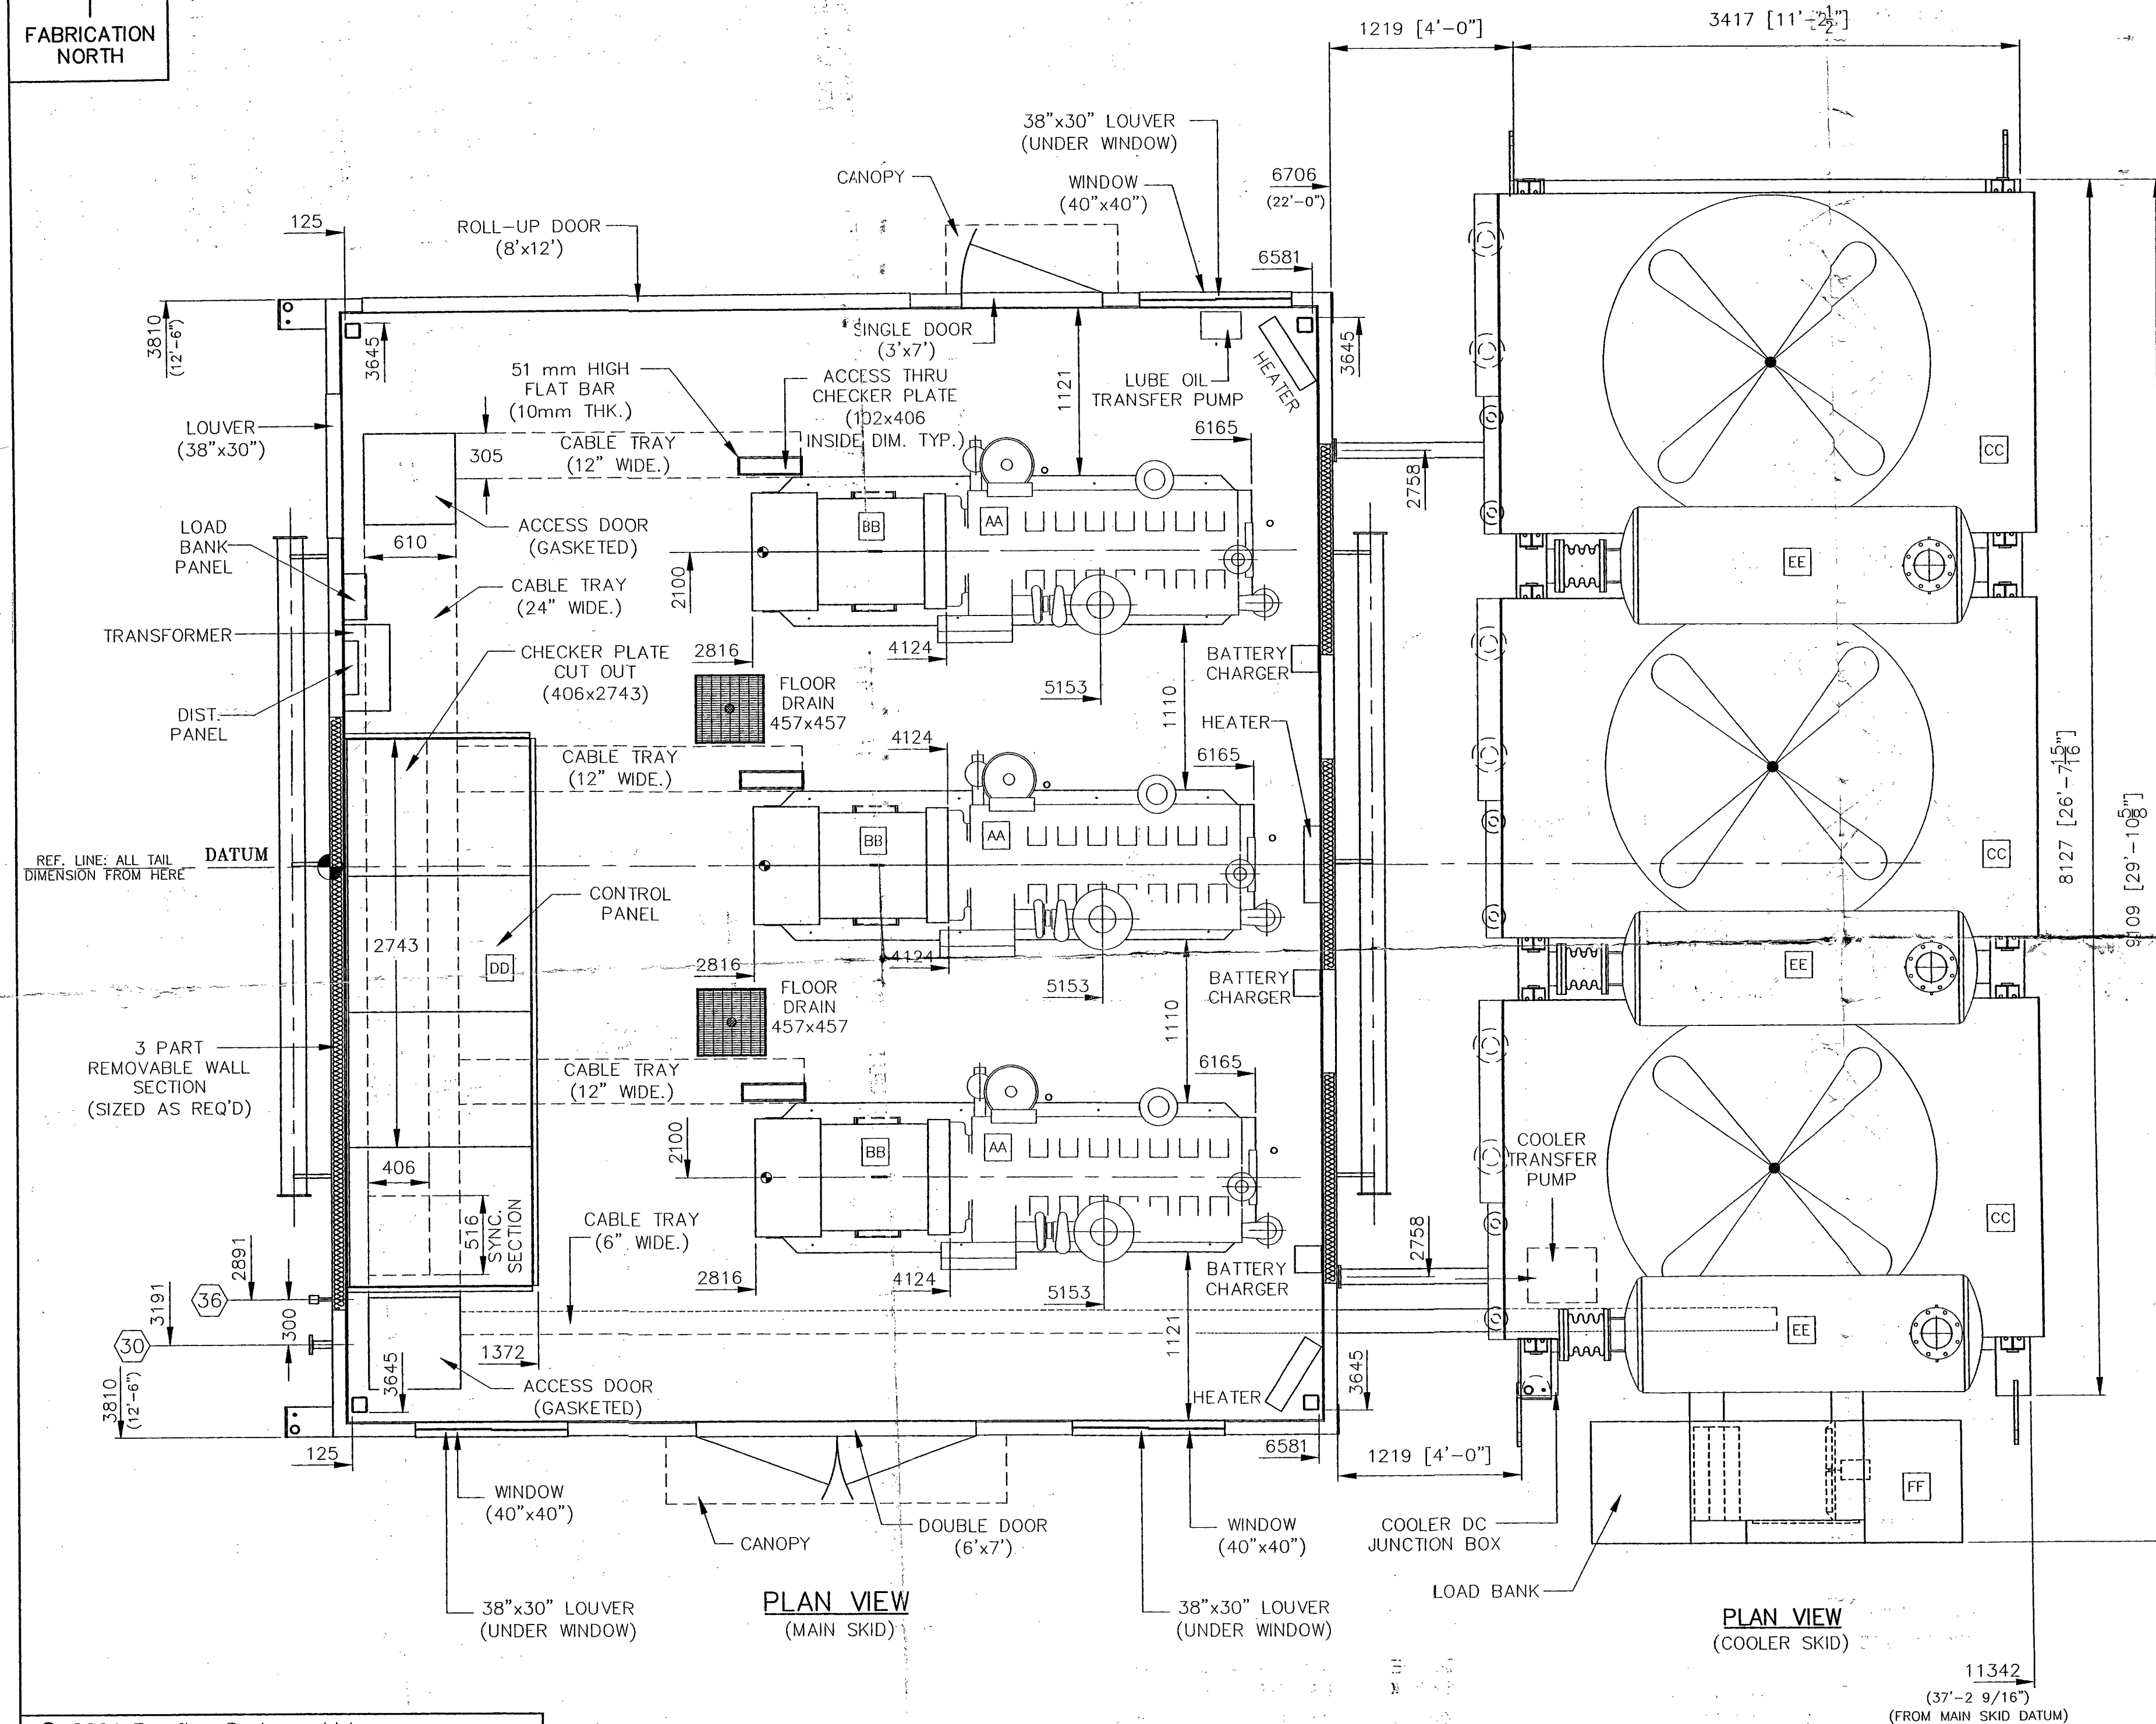

ELEVATION VIEW
(MAIN SKID)

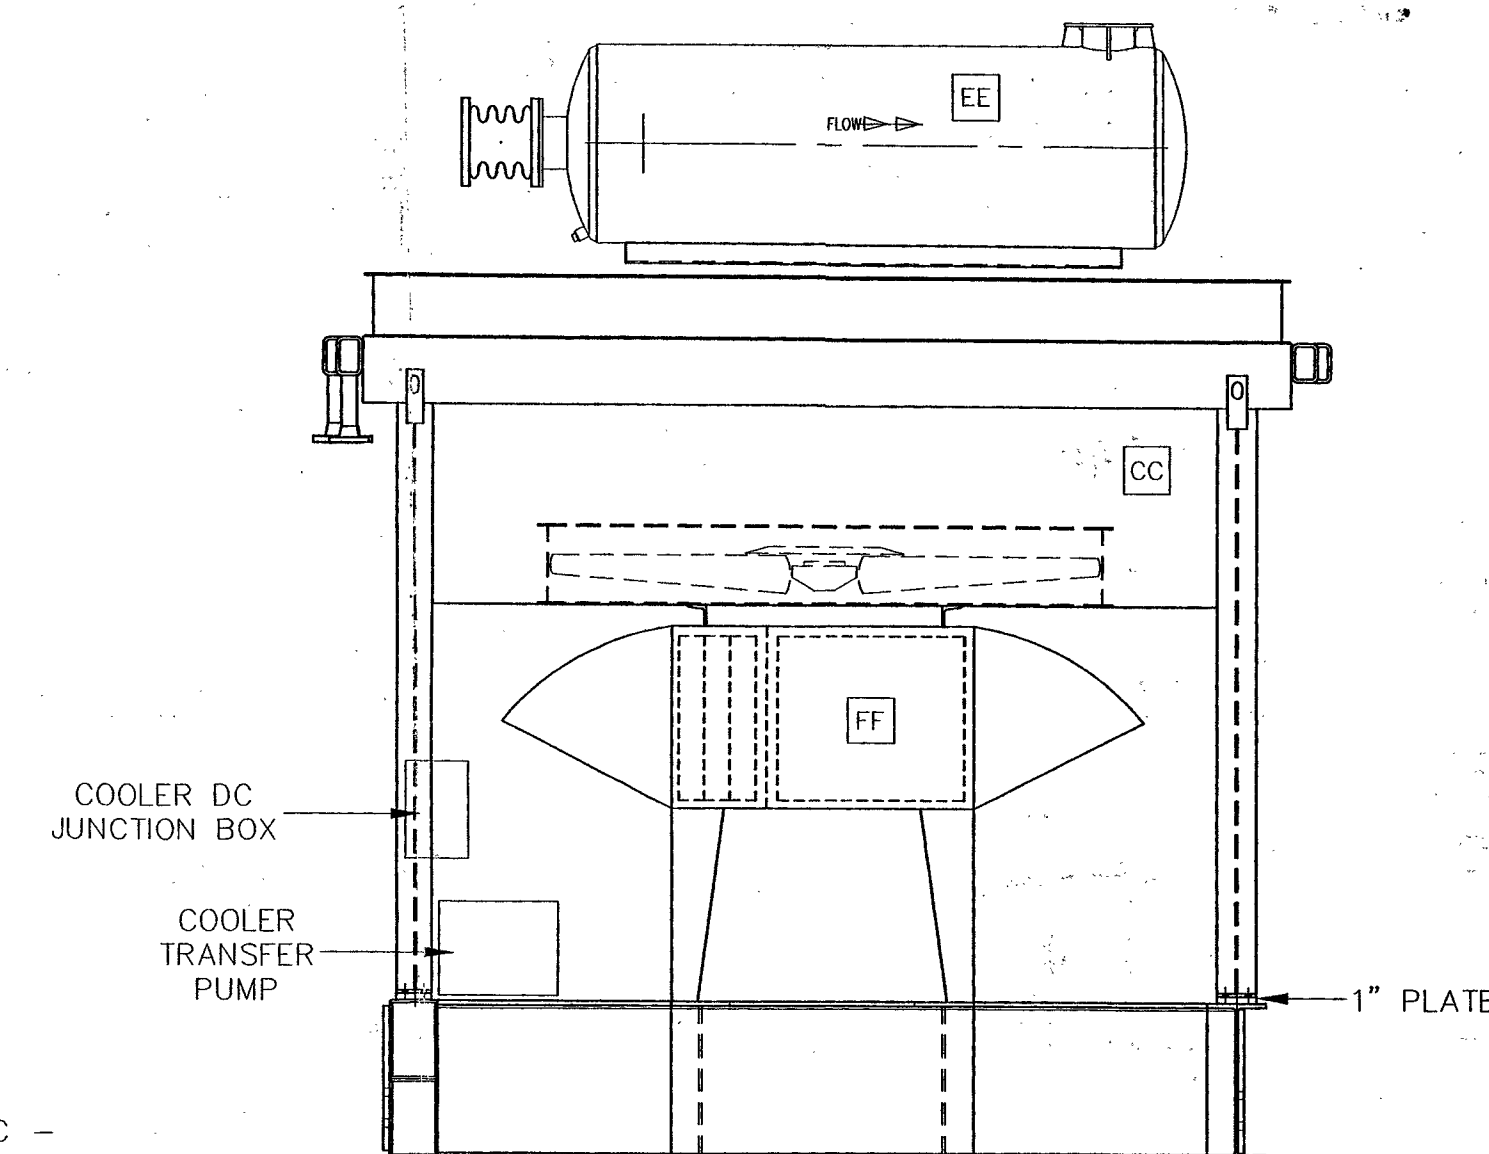

ELEVATION VIEW
(COOLER SKID)

NOTE: INIT PAINT SCHEME:

EQUIPMENT, PIPING, SKID FLOOR, ETC -
SILVER KEY (RUSTOLEUM 906)
SKID AND STRUCTURAL - FOREST GREEN
(RUSTOLUM 1282)

© 2001 Enerflex Systems Ltd.
REPRODUCTION OF ANY PORTION OF THESE MATERIALS WITHOUT THE EXPRESS
WRITTEN CONSENT OF ENERFLEX SYSTEMS LTD. IS STRICTLY PROHIBITED.
THESE MATERIALS SHALL NOT BE USED FOR ANY PURPOSE OTHER THAN THE
REPAIR AND MAINTENANCE OF THE PRODUCTS TO WHICH THEY RELATE.

CUSTOMER CONNECTIONS			MAJOR COMPONENTS & SHIPPING WEIGHTS					
NO.	DESCRIPTION	SIZE		KG. 3270	LBS. 7200		KG. 500	LBS. 1102
30	FUEL GAS SUPPLY	1-1/2"-150#RF	AA ENGINE			SUB SKID		
36	INSTRUMENT AIR SUPPLY	1"-3000# NPT	(3) WAUKESHA, H24GL			(3) REQUIRED	13300	29295
			BB GENERATOR	1240	2730	MAIN SKID		
			(3) MARATHON, 572RSL4024			COOLER SKID	4000	8818
			CC COOLER	3175	7000	MISC. & LIQUIDS	2000	4409
			(3) GEA RAINEY, H84-1260			BUILDING	7400	16320
			DD CONTROL PANEL	1588	3500	CRANE	2400	5290
			(1) THOMSON, GCS 2200					
			EE EXHAUST	315	694			
			(3) SILEX, JDDT-8					
			FF LOAD BANK	218	480	TOTAL MAIN SKID SHIPPING WT.	41718	91890
			(1) POWER SYSTEM PLUS, SLBA-200C			TOTAL COOLER SKID SHIPPING WT.	14688	32351
						TOTAL UNIT WEIGHT	56406	12424

GENERAL NOTES

1. THIS DRAWING IS NOT TO BE USED FOR CONSTRUCTION UNLESS STAMPED "RELEASED FOR MANUFACTURE".
2. DO NOT SCALE THIS DRAWING.
3. ALL DIMENSIONS ARE IN MILLIMETERS.
4. ALL PIPING MUST BE SELF SUPPORTING BEYOND UNIT CONNECTIONS.
5. LOCATIONS OF CUSTOMER CONNECTIONS ARE NOT GUARANTEED AS THESE DIMENSIONS MAY BE SUBJECT TO AN ACCUMULATION OF TOLERANCES ON SEVERAL COMPONENTS. MINOR CHANGES MAY ALSO BE MADE ON SCREWED SERVICE PIPING IN ORDER TO FACILITATE INSTALLATION AND MAINTENANCE. ON COMPLETION A FINAL DRAWING WILL BE ISSUED WITH FIELD CONNECTIONS CORRECTED TO 5 mm.
6. IT IS ES&S' RECOMMENDATION THAT ANY PRE-SPOOLING TO THIS GENERATOR PACKAGE CONTAIN FIELD WELDS AT ALL CUSTOMER CONNECTIONS.
7. DIMENSIONS INDICATED (*) SHALL BE CONFIRMED AND CERTIFIED CORRECT (*) ON A FINAL REVISION.
8. THE FOLLOWING ITEMS WILL BE SHIPPED LOOSE FOR FIELD INSTALLATION BY OTHERS:

UNIT DIMENSIONS		LENGTH		WIDTH		HEIGHT	
		mm	ft/in	mm	ft/in	mm	ft/in
MAIN SKID w/ ALL-EQUIP. MOUNTED		7426	24'-4"	7620	25'-0"	5544	18'-2 1/4"
COOLER SKID w/ ALL-EQUIP. MOUNTED		9438	31'-0"	3775	12'-5"	4877 (APPROX.)	16'-0" (APPROX.)
		-	-	-	-	-	-
2	AS BUILT					PTT	JTS
1	RELIED FOR MANUFACTURE				01/06/21	PTT	JJM
0	FOR APPROVAL				01/05/17	PTT	JJM
REV	DESCRIPTION				DATE	DRAWN BY	CHECKED BY

EPX
ENERFLEX SYSTEMS LTD.

D. CALGARY
EDMONTON
MEDICINE HAT
RED DEER
FORT McMURRAY
GRANDE PRAIRIE

SURREY, B.C.
FORT ST. JOHN, B.C.
SCARBOROUGH, ONTARIO
LLOYDMINSTER, SASKATCHEWAN
PERTH, ALBERTA
SYDNEY, AUSTRALIA

AS-BUILT

TITLE:		GENERAL ARRANGEMENT (3 X 400 KW NATURAL GAS PACKAGE) GENERATOR PACKAGE		DATE: SEP 13 2001	
FOR:		ANDERSON EXPLORATION LTD (RYCROFT GAS PLANT)			
CONSULTANT: KILOWATTS DESIGN COMPANY INC.		LSD: 7-2-77-4-W6M		JOB No.: E02577	
P.O.:					
DRWN BY: PTT	DESIGN BY: PTT	DATE: 01/05/08	DWG. No.	OPER'N #	
DATE: 01/05/08	CHKD BY:	DATE:	GA2577	50	
SCALE: 1:30	APPVD BY:	DATE:			