




SKID PLAN VIEW

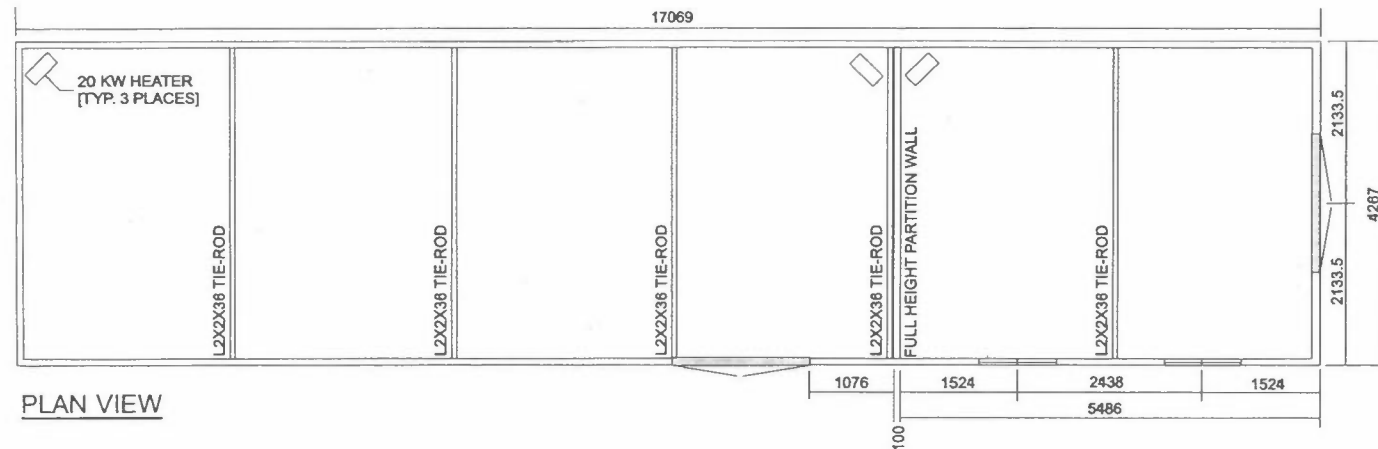


PLAN VIEW

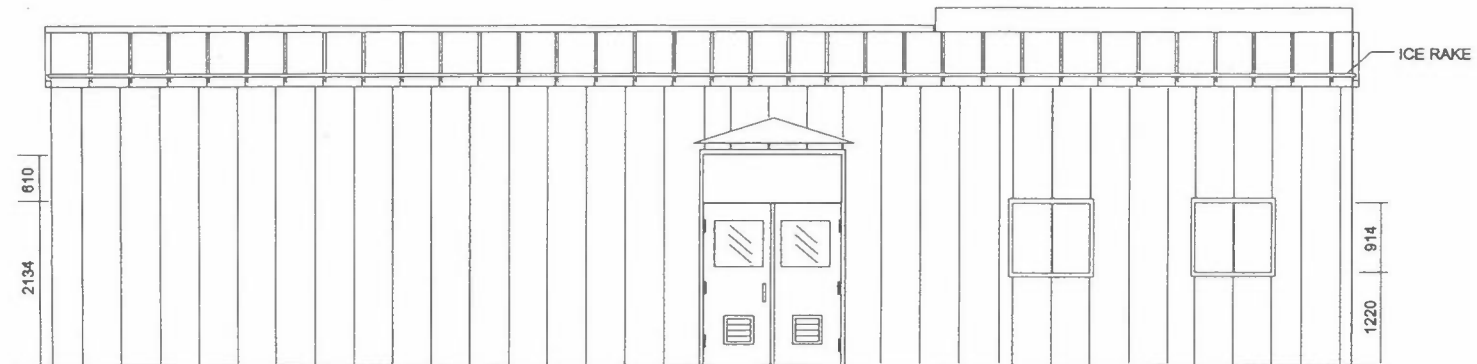


NORTH ELEVATION

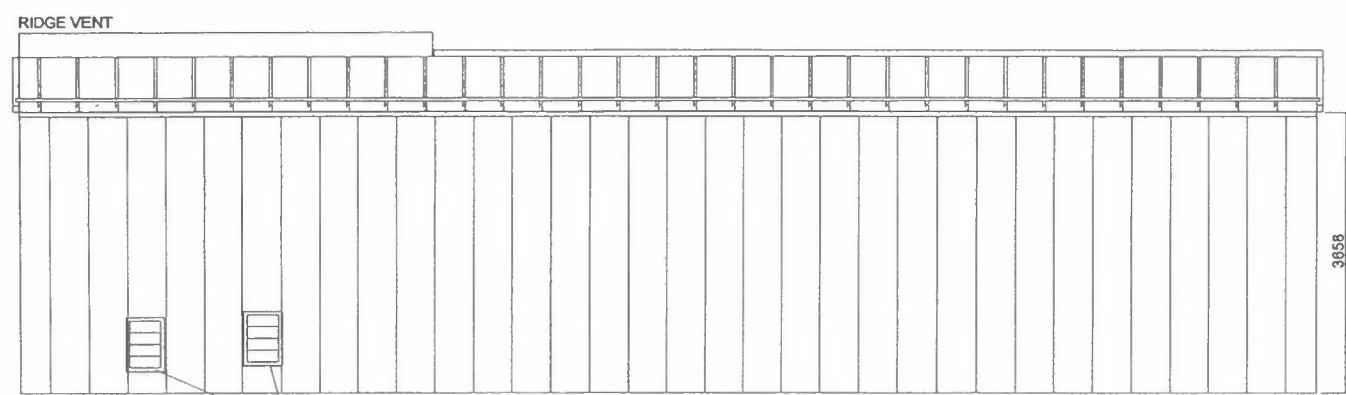



SOUTH ELEVATION

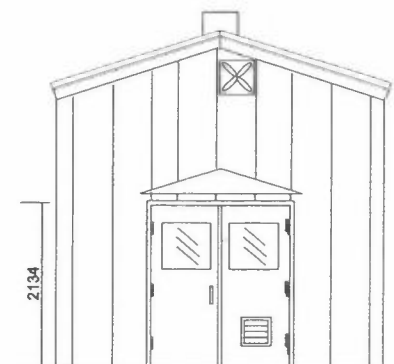

WEST ELEVATION

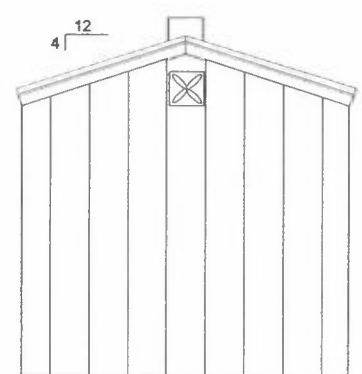

EAST ELEVATION

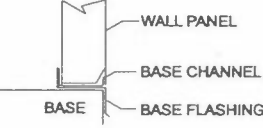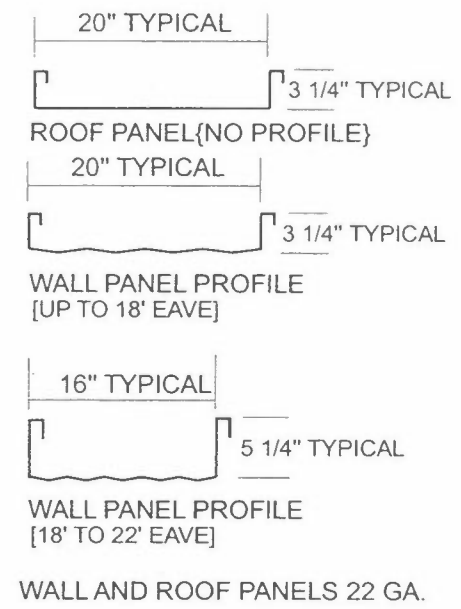

BASE DETAIL (TYPICAL)

BUILDINGS SPECIFICATIONS GENERAL NOTES

NOTES WHICH ARE APPLICABLE TO THIS JOB WHEN SHADED
 ■ SUBNOTES WHICH ARE APPLICABLE WHEN SHADED

- 1 TYPE OF BUILDING
 SELF FRAMING - SHED SELF FRAMING-GABLE RIGID FRAME GABLE
 LOCATION 07 - 02 - 77 - 04 W6M
- 2 MATERIAL - WALL AND ROOF PANELS
 GALVANIZED - 22 GAUGE ALUMINUM - 18 GAUGE
 PRE-PAINTED GALVANIZED - 22 GAUGE GALVALUME - 22 GAUGE
 COLOR: WALLS TAN ROOF TAN
 DOORS METRO BROWN TRIM METRO BROWN
- 3 ROOF SLOPE
 1:12 2:12 3:12 4:12
- 4 INSULATION - FIBREGLAS
 WALLS R-12 R-20 OTHER _____
 ROOF R-12 R-20 R-32 OTHER _____
- 5 LINING
 24 GA. FLUTED ALUMINUM I/A ROOM AND MCC ROOM CEILING
 3/4" G1S PLYWOOD TO WALLS IN MCC ROOM PAINTED GREY
- 6 POLYETHYLENE VAPOR BARRIER
 2 MIL 4 MIL 6 MIL
- 7 DOORS
 914 X 2134 WS GW PH LS DC CC CP TH SW TS
 1829 X 2134 WS GW PH LS DC CC CP TH SW TS
 WS - WEATHERSTRIPPING DC - DOOR CLOSURE PH - PANIC HARDWARE
 LS - LOCKSET CC - CHECK CHAIN GW - WIREGLAZED WINDOW
 TH - THRESHOLD SW - DOOR SWEEP CP - CANOPY
 TS - REMOVABLE TRANSOM PANEL
- 8 WINDOWS - DOUBLE GLAZED HORIZONTAL SLIDING C/W BUG SCREEN
 NO. 2 SIZE 38" X 36"
- 9 WALL LOUVERS
 3 12" X 12" STAMPED LOUVER C/W SLIDE CLOSURE AND BUG SCREEN
 2 16" X 24" ADJUSTABLE LOUVERS
- 10 RIDGE VENTILATOR C/W CHAIN OPERATED CONTROLS AND BIRD SCREEN
 THROAT204 LENGTH 3048
- 11 ROLL-UP DOORS / SECTIONAL O/H DOORS / SLIDING
 STEEL ROLL-UP MANUAL
 STEEL SECTIONAL O/H CHAIN OPERATED
 SLIDING INSULATED
- 12 FANS - ROOF / WALL
 ROOF AIR CHANGES / HOUR GENERAL PURPOSE
 2 WALL 12 AIR CHANGES / HOUR EXPLOSION PROOF
- 13 EAVESTROUGH, DOWNSPOUT AND ICE RAKE
 DOWNSPOUT ICE RAKE DORMER

AS BUILT



DESIGN LOADS - UNFACTORED
 SNOW - 1.78 KPa
 WIND - 0.55 KPa

K & T METAL INDUSTRIES LTD. 8802-95 STREET MORINVILLE AB T8R 1K6 PH. [780] 939-4486 FAX. [780] 939-2687			
PROJECT			
RYCROFT GAS PLANT			
MCC/IA BUILDING			
CLIENT			
ANDERSON EXPLORATION LTD.			
DATE	SCALE	DRAWING NUMBER	REV
07/09/01	1:50		
DWN BY	CKD BY		
RF	CH	477-1R	1