

PLAN

**AS-BUILT**  
DATE FEB 28 2006

P:\Projects\Ver-Engineered\05-1009\05-1009-10.dwg Feb 28, 2006 - 10:27am

PROCESS/SERVICE CONNECTIONS								OPTIONS		GENERAL NOTES	UNIT DIMENSIONS		LENGTH		WIDTH		HEIGHT		CUSTOMER: ENERFLEX LEASING		CONSULTANT: -		PROJECT LOCATION: RAINBOW LAKE	
ITEM	CONNECTION	SIZE/RATING	DISTANCE FROM DATUM						OPT#	DESCRIPTION	4. THIS DRAWING IS NOT TO BE USED FOR CONSTRUCTION UNLESS STAMPED "RELEASED FOR MANUFACTURE".	MAIN SKID w/ ALL EQUIP. MOUNTED	8848	29' 0-3/8"	4115	13'-3"	5489	18'-0"	JOB No.: 051009	PO#: -	LSD: 10-24-110-04 W6M	BTB Compressors		
			X	Y	Z	mm.	in.	mm.																in.
1	PROCESS SUCTION	4"-300#RF	-91	-3 5/8	-292	-11 1/2	+445	+17 1/2		5. ALL PIPING MUST BE SELF SUPPORTING BEYOND UNIT CONNECTIONS.	SHIPPING DIMENSIONS	8848	29' 0-3/8"	4115	13'-3"	3809	12'-6"							
8	BLOWDOWN	1" NPT	-91	-3 5/8	-927	-36 1/2	+205	+8 1/8		6. LOCATIONS OF CUSTOMER CONNECTIONS ARE NOT GUARANTEED AS THESE DIMENSIONS MAY BE SUBJECT TO AN ACCUMULATION OF TOLERANCES ON SEVERAL COMPONENTS. MINOR CHANGES MAY ALSO BE MADE ON SCREWED SERVICE PIPING IN ORDER TO FACILITATE INSTALLATION AND MAINTENANCE. ON COMPLETION A FINAL DRAWING WILL BE ISSUED WITH FIELD CONNECTIONS CORRECTED TO 5 mm.	COOLER	2559	8' 4-3/4"	2759	9' 0-5/8"	2135	7' 7-1/8"							
9	PROCESS DISCHARGE	2"-600#RF	-91	-3 5/8	-3811	-150	+445	+17 1/2		7. IT IS ESL'S RECOMMENDATION THAT ANY PRE-SPOOLING TO THIS COMPRESSOR PACKAGE CONTAIN FIELD WELDS AT ALL CUSTOMER CONNECTIONS.														
16	COALESCE DRAIN	1-1/2" NPT	-164	-6 1/2	-1797	-70 3/4	+205	+8 1/8		8. DIMENSIONS INDICATED (*) SHALL BE CONFIRMED AND CERTIFIED CORRECT (**) ON A FINAL REVISION.														
35	FUEL GAS	1-1/2" NPT	-91	-3 5/8	-3610	-142 1/8	+458	+18		9. THE FOLLOWING ITEMS WILL BE SHIPPED LOOSE FOR FIELD INSTALLATION BY OTHERS:														
44	WASTE OIL DRAIN	1-1/2" NPT	+153	+6	+84	+3 5/16	+50	+2																
45	WASTE OIL TANK VENT	3" NPT	+100	+4	-1122	-44 1/4	+368	+14 1/2																


GENERAL ARRANGEMENT (SHEET. 1/2)  
ARIEL JGA/2, CATERPILLAR G3306TA, AXC 72AVI  
9200  
2 STAGE COMPRESSOR PACKAGE

DESIGNED BY: IC  
APPROVED BY: KJB  
DATE: 05/01/17

DWG UNITS: METRIC  
SCALE: 1:15

DWG. No.: GA-051009

REV. 4

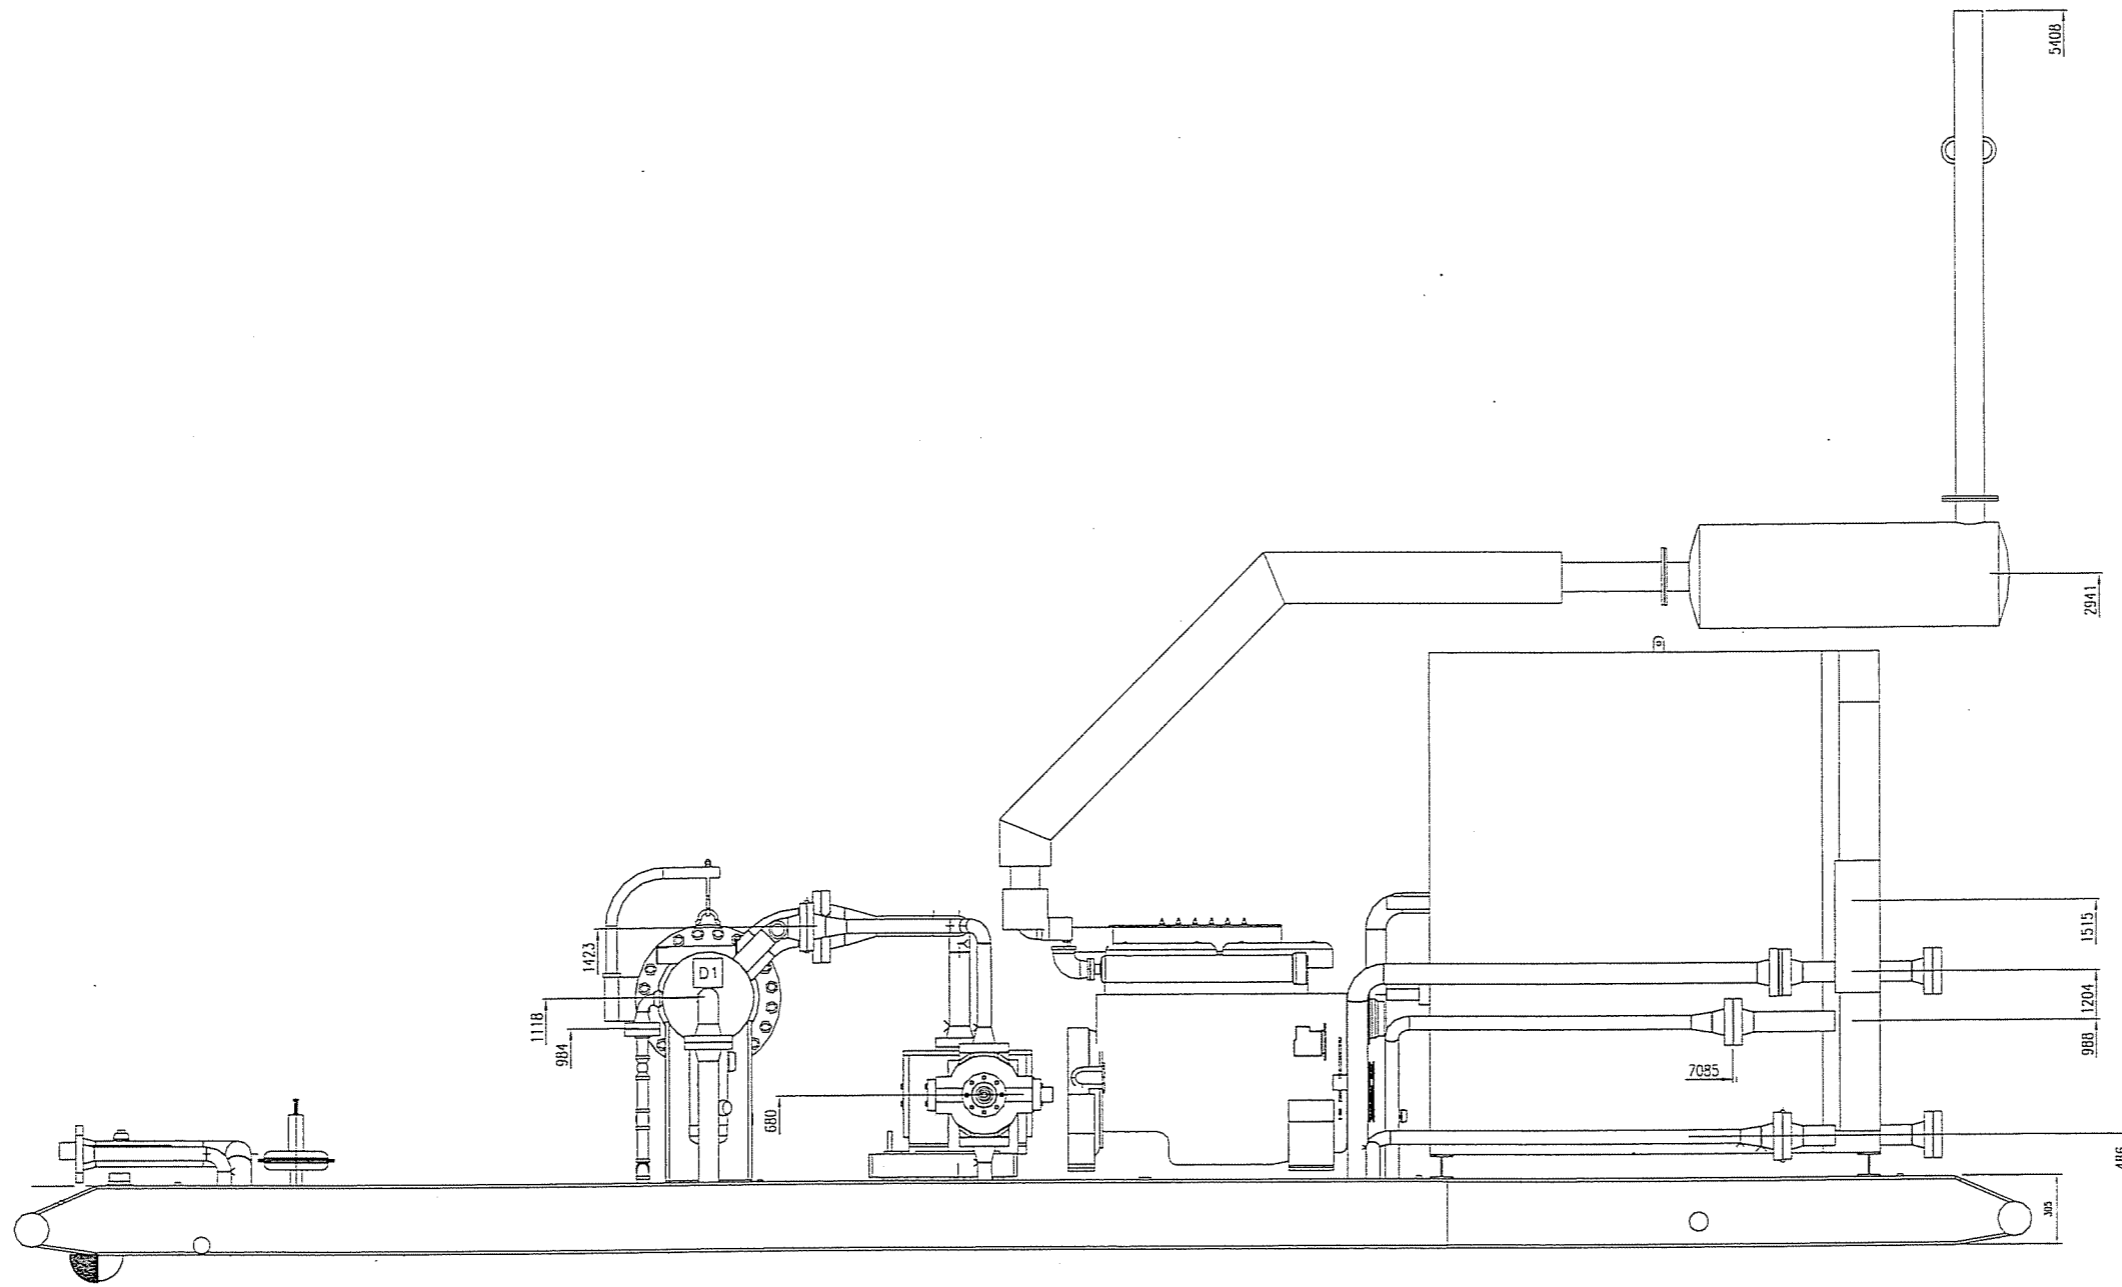

NORTH ELEVATION VIEW

**AS-BUILT**  
DATE FEB 28 2006

- GENERAL NOTES**
1. THIS DRAWING IS NOT TO BE USED FOR CONSTRUCTION UNLESS STAMPED "RELEASED FOR MANUFACTURE".
  2. DO NOT SCALE THIS DRAWING.
  3. ALL DIMENSIONS ARE IN MILLIMETERS.
  4. FOR DESIGN PARAMETERS AND PAINT SPECIFICATION REFER TO PROJECT SCOPE SUMMARY DRAWING NO. \_\_\_\_\_
  5. ALL PIPING MUST BE SELF SUPPORTING BEYOND UNIT CONNECTIONS.
  6. LOCATIONS OF CUSTOMER CONNECTIONS ARE NOT GUARANTEED AS THESE DIMENSIONS MAY BE SUBJECT TO AN ACCUMULATION OF TOLERANCES ON SEVERAL COMPONENTS. MINOR CHANGES MAY ALSO BE MADE ON SCREWED SERVICE PIPING IN ORDER TO FACILITATE INSTALLATION AND MAINTENANCE. ON COMPLETION A FINAL DRAWING WILL BE ISSUED WITH FIELD CONNECTIONS CORRECTED TO 5 mm.
  7. IT IS EFL'S RECOMMENDATION THAT ANY PRE-SPOOLING TO THIS COMPRESSOR PACKAGE CONTAIN FIELD WELDS AT ALL CUSTOMER CONNECTIONS.
  8. DIMENSIONS INDICATED (\*) SHALL BE CONFIRMED AND CERTIFIED CORRECT (\*\*) ON A FINAL REVISION.
  9. THE FOLLOWING ITEMS WILL BE SHIPPED LOOSE FOR FIELD INSTALLATION BY OTHERS:

REV	DESCRIPTION	YY/MM/DD	DRAWN BY	CHECKED BY
4	REMOVED BUILDING, AS BUILT	05/02/15	IC	KJB
3	REVISED AUTO BYPASS	05/01/31	IC	KJB
2	ADDED AUTO BYPASS, DELETED BUILDING & HEATERS.	06/01/30	IC	KJB
1	UPDATED DIMENSIONS FOR COMPRESSORS			
1	ISSUE FOR CONSTRUCTION (COMPLETION)	05/01/16	IC	KJB
0	RELEASED FOR MANUFACTURE (STOCK)	05/09/20	HJZ	KJB

CUSTOMER: ENERFLEX LEASING	CONSULTANT: -	PROJECT LOCATION: RAINBOW LAKE
JOB No.: 051009	PO#: -	LSB: 10-24-110-04 WSM
<b>BTB Compressors</b>		
<small>4700 47 ST. SE. CALGARY AB. CANADA T2B 3P1 TEL: 1 (403) 236-6800 FAX: 1 (403) 279-0387 www.enerflex.com</small>		
<b>GENERAL ARRANGEMENT (SHEET. 2/2)</b> ARIEL JGA/2, CATERPILLAR G3306TA, AXC 72AVI B200 2 STAGE COMPRESSOR PACKAGE		
DESIGNED BY: IC	DWG UNITS: METRIC	DWG. No.
APPROVED BY: KJB	DATE: 06/01/17	SCALE: 1:16
		GA-051009
		REV. 4

I:\Projects\Pre-Engineering\051009\051009-051009-10.dwg Feb 17, 2006 - 9:31am