


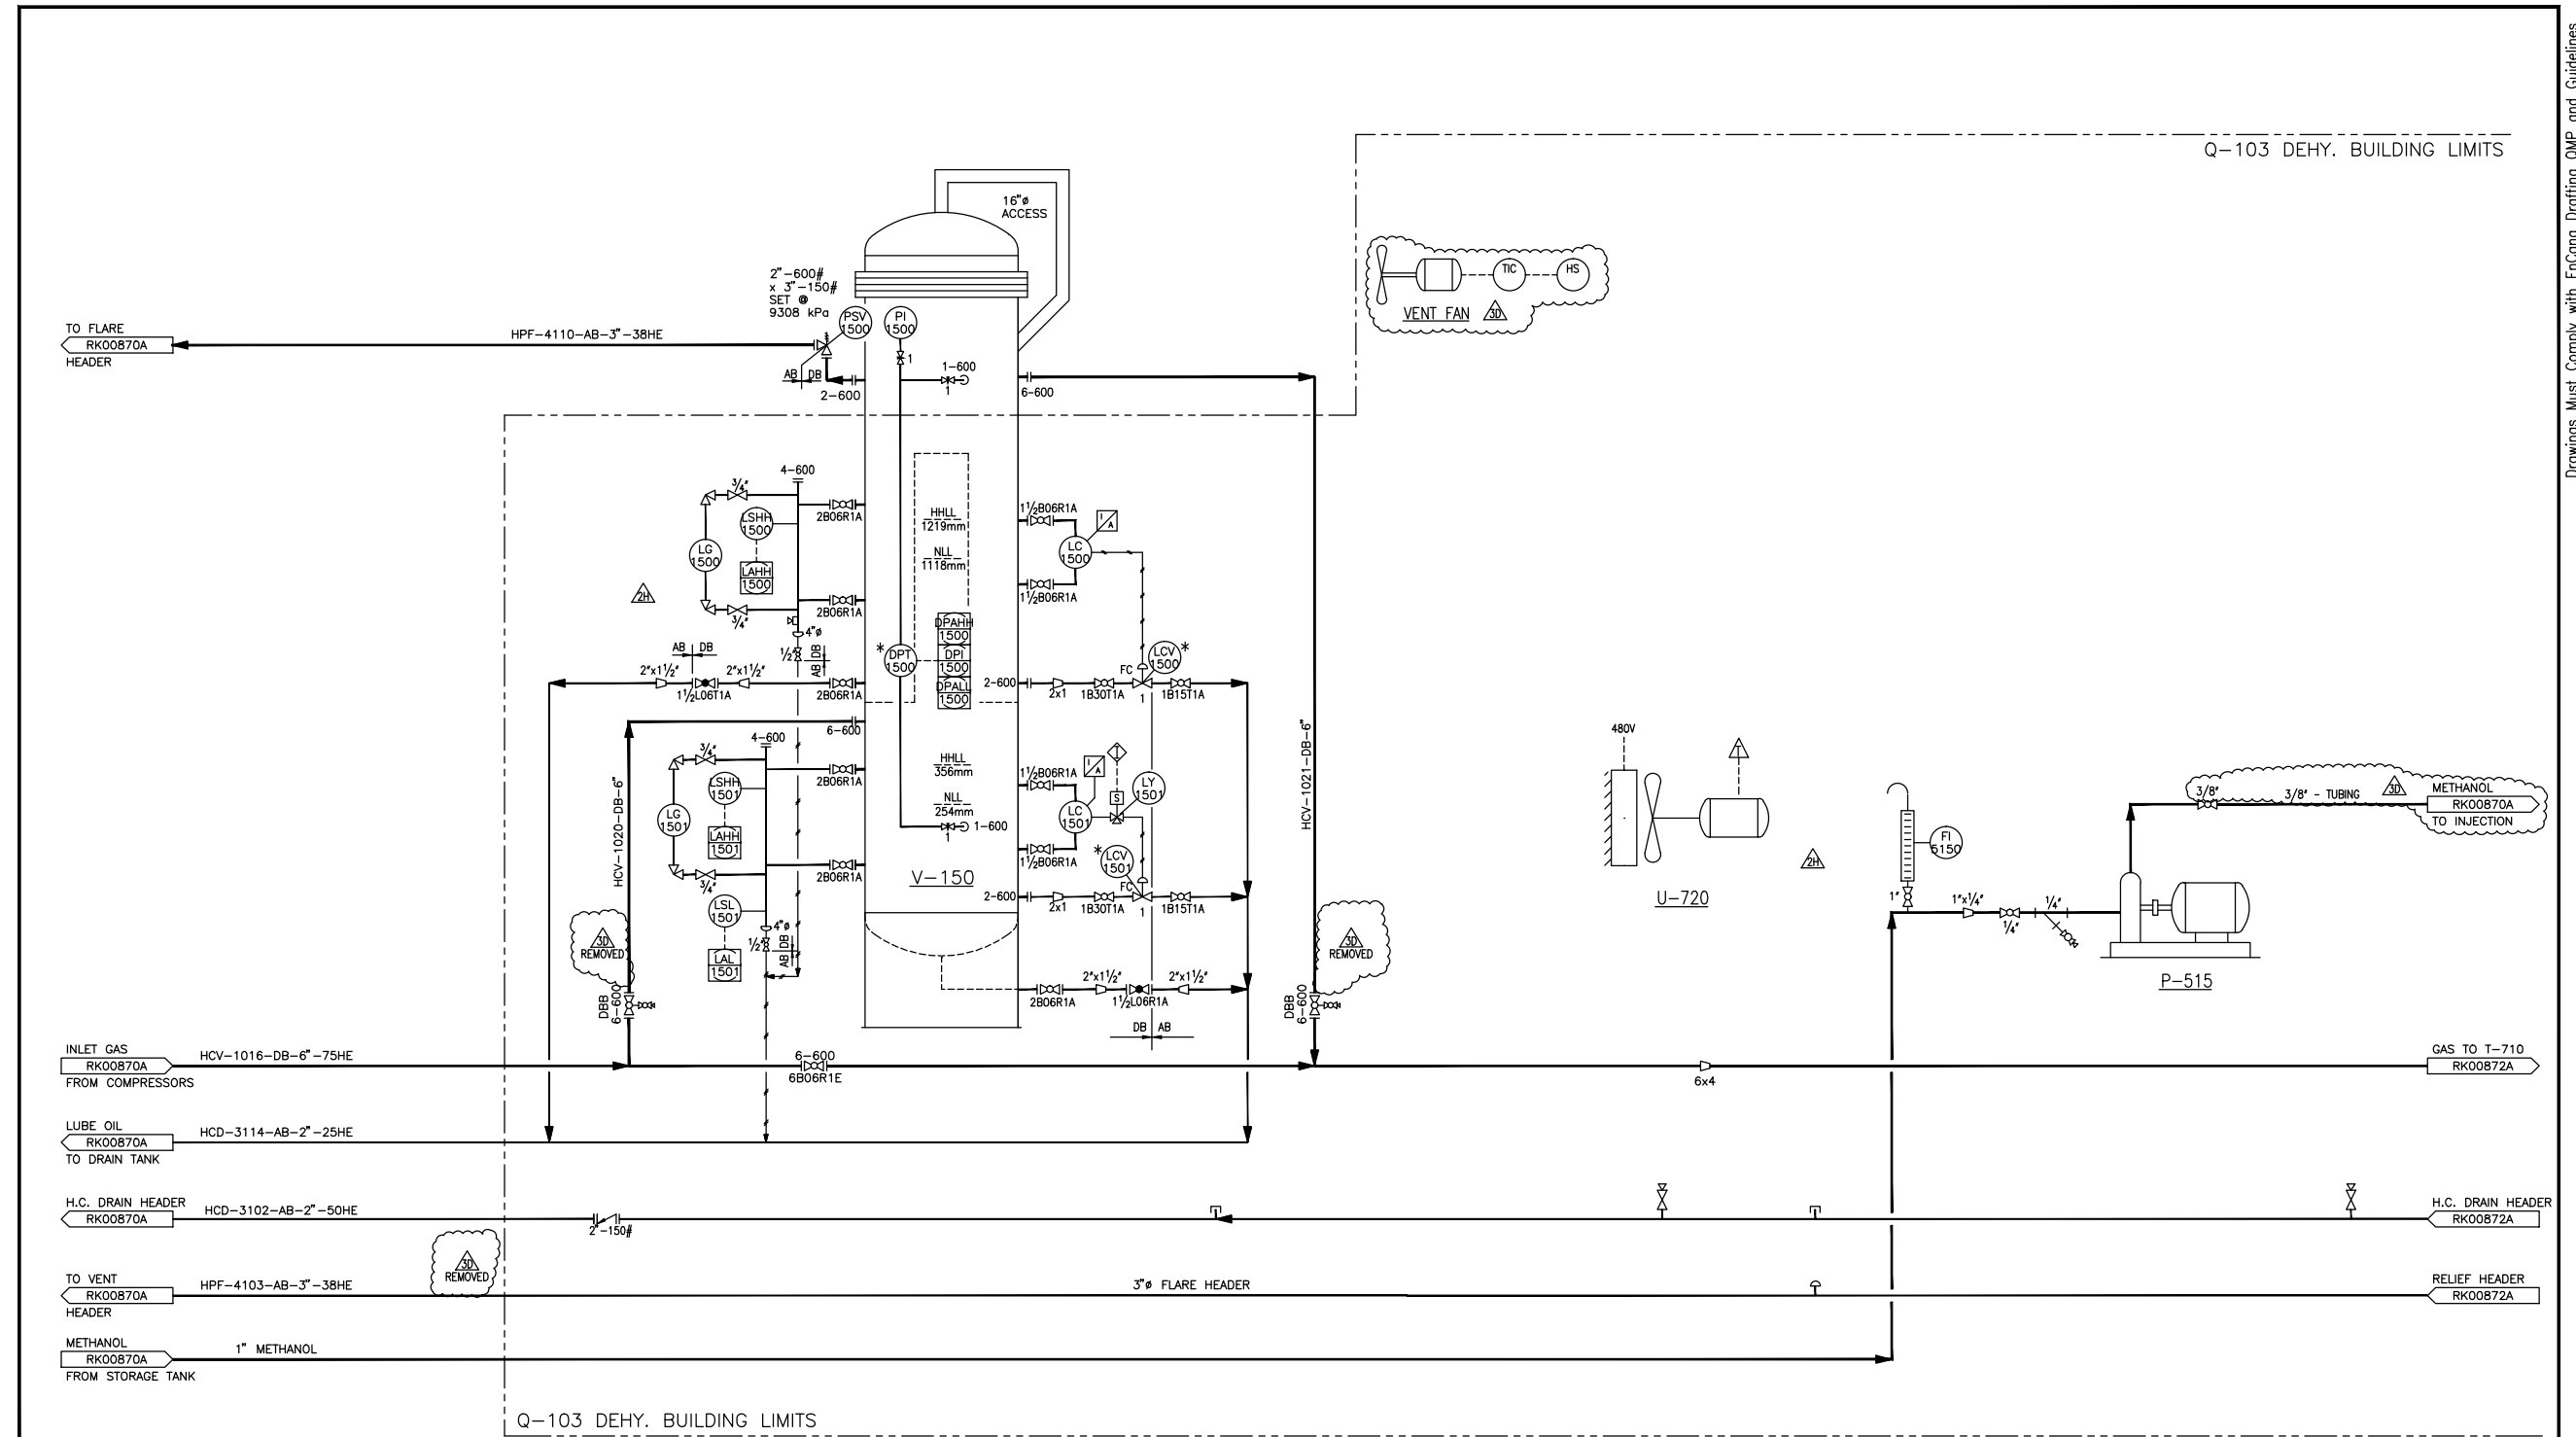

NOTES

\* DENOTES EQUIPMENT PROVIDED BY ENCANA

V-150  
LUBE OIL SEPARATOR  
SIZE: 406mm O.D. x 3048mm S/S  
D.P.: 9756 kPag @ 65°C  
M.D.M.T.: -46°C  
C.A.: 1.6mm  
S.N.: 6661-03  
VENDOR: FCI DANVIC INC.

U-720  
BUILDING HEATER  
POWER: 10 kW/480V/3Ø  
MODEL: 4332 EX3BD  
C/W EXTERNAL THERMOSTAT  
MAKE: RUFFNECK

P-515  
METHANOL PUMP  
MAKE: ARROW  
MODEL: 4332 EX3BD  
MOTOR DUTY: 0.25 kW  
POWER: 60 Hz/460V/3Ø

| REFERENCE DRAWINGS | DWG. NO. | NO. | DATE     | PROJECT DESCRIPTION             | PROJ.   | AFE     | EPCM Co. | EPCM No. | APPD. | ISSUE STAGE | DATE     | BY  | CHKD. | APPD. | PERMIT STAMP | ENGINEER'S STAMP |
|--------------------|----------|-----|----------|---------------------------------|---------|---------|----------|----------|-------|-------------|----------|-----|-------|-------|--------------|------------------|
| -                  | -        | 1   | 03.05.28 | 14-09 COMPRESSOR/DEHY. ADDITION | -       | -       | TARTAN   | 285400   | -     | PRELIM      | -        | -   | -     | -     | -            | -                |
| -                  | -        | 2   | 03.09.16 | NGC COMPRESSOR ADDITION         | WHEDC03 | 0318355 | TARTAN   | 295000   | -     | BID         | -        | -   | -     | -     | -            | -                |
| -                  | -        | 3   | 06.12.01 | METHANOL TIE-IN                 | -       | -       | CRIMTECH | 1A98400  | -     | IFC         | -        | -   | -     | -     | -            | -                |
| -                  | -        | -   | -        | -                               | -       | -       | -        | -        | -     | AS-BUILT    | 06.12.01 | JTC | ADR   | -     | -            | -                |
| -                  | -        | -   | -        | -                               | -       | -       | -        | -        | -     | AS-IS       | -        | -   | -     | -     | -            | -                |
| -                  | -        | -   | -        | -                               | -       | -       | -        | -        | -     | -           | -        | -   | -     | -     | -            | -                |
| -                  | -        | -   | -        | -                               | -       | -       | -        | -        | -     | -           | -        | -   | -     | -     | -            | -                |
CAUTION - READ BEFORE EXCAVATION  
NOT WITHSTANDING INFORMATION PROVIDED BY ENCANA IN ANY FORM, THE CONTRACTOR SHALL UTILIZE ELECTRIC LOCATING EQUIPMENT TO LOCATE UNDERGROUND PIPING AND ELECTRICAL WIRING ETC., PRIOR TO HAND EXCAVATION.  
ONCE ALL UNDERGROUND FACILITIES HAVE BEEN HAND EXCAVATED THE CONTRACTOR SHALL RECHECK, WITH ELECTRONIC LOCATING EQUIPMENT, THE ENTIRE WORK AREA TO BE MECHANICALLY EXCAVATED TO ENSURE THAT NO FACILITIES HAVE BEEN MISSED.

MAIN FAC: GAS SAT. 14-09  
MAIN ISO: 14-09-025-23 W4M  
FAC TYPE: SATELLITE  
SITE ISO: 14-09-025-23 W4M  
SCALE: NTS (A1 Size)  
EPCM No.: 1A98400

CRIMTECH SERVICES LTD

PIPELINE AND INSTRUMENTATION DIAGRAM  
DEHYDRATOR BLD'G. Q-103 - SEPARATOR SECTION

AREA: ROCKYFORD  
CLASS: A  
FILE NO.: RK00871A

Drawings Must Comply with EnCana Drafting QMP and Guidelines