



1 GENERATOR SET PLAN VIEW
DO NOT SCALE

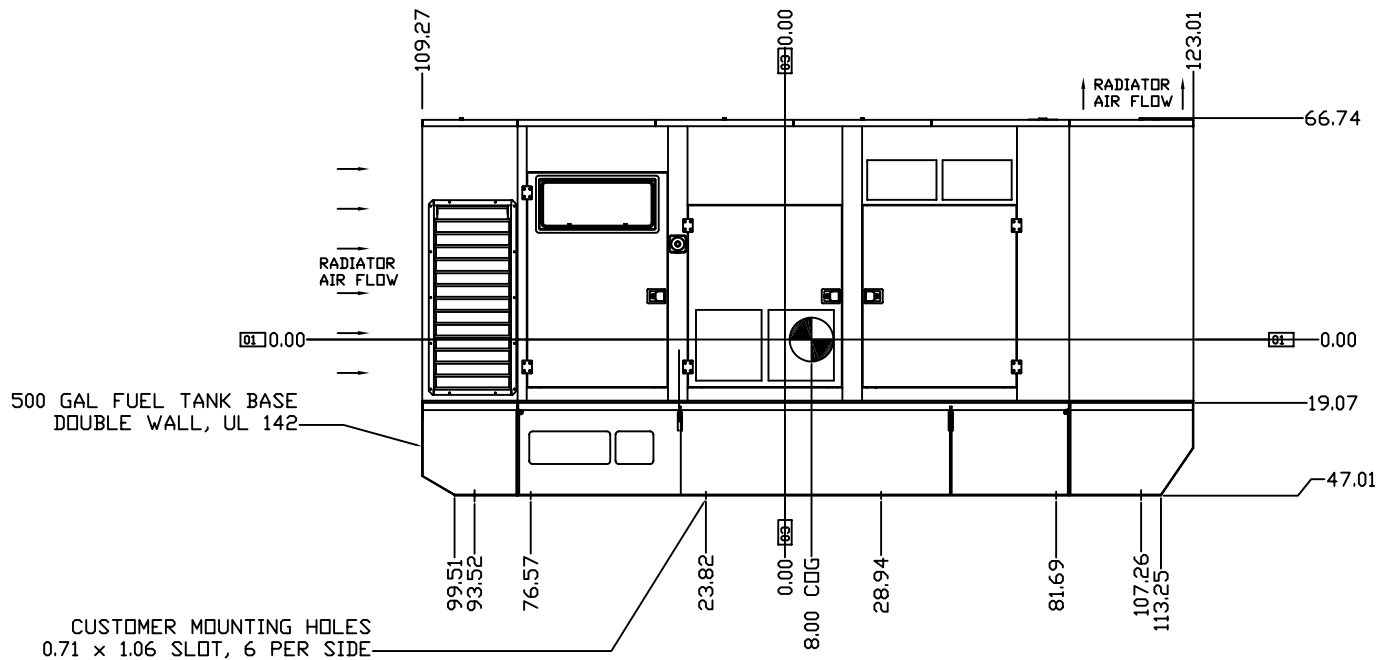

2 GENERATOR SET RIGHT SIDE VIEW
DO NOT SCALE

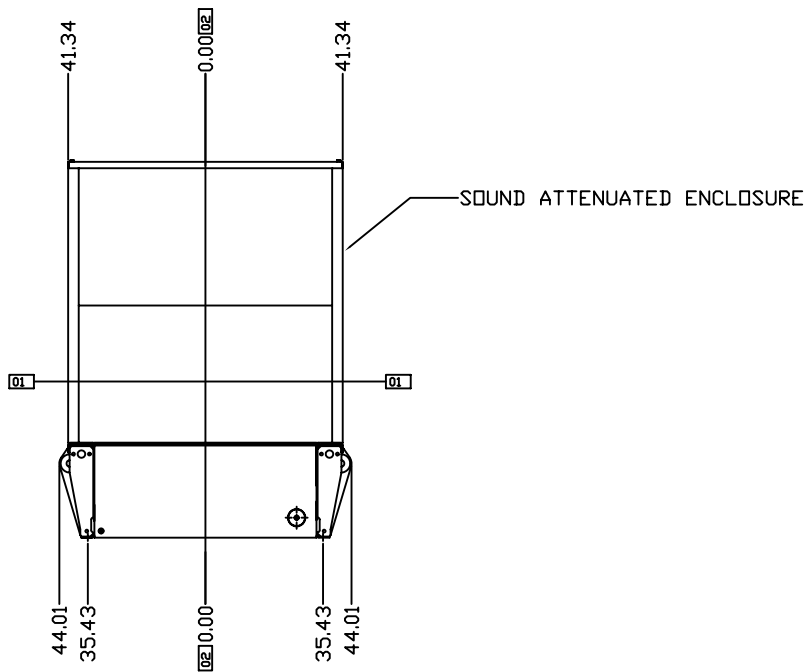

3 GENERATOR SET FRONT VIEW
DO NOT SCALE

A	AS-BUILT	9/23/03
REV	DESCRIPTION	DATE
	REVISIONS	


REFERENCE DRAWINGS
ENCLOSURE CA1923 - 1908426
FUEL TANK CA2061 - 1908458
EXTENSIONS 1883855 - 1944216
ALL OVERALL DIMENSIONS ARE NOMINAL WITH ± 1" TOLERANCE SEE DRAWING FOR ALL DETAILED COMPONENT DIMENSIONS CONSULT FACTORY FOR QUESTIONS AND/OR DISCREPANCIES FOUND

PETERSON
POWER SYSTEMS

2828 TEAGARDEN STREET
SAN LEANDRO, CALIFORNIA 94577

CAT
GAS TRUCK
MARINE
FUEL CELL
INDUSTRIAL
POWER GENERATION

DRAWING STATUS
AS-BUILT
PURCHASING ENTITY APPROVAL
DATED:
ENGINEERING CONSULTING APPROVAL
DATED:

PREPARED FOR: COMCAST - GILROY		
3412 - 700KW STANDBY GENSET WITH 500 GAL INTEGRAL FUEL TANK AND SOUND ATTENUATED ENCLOSURE		
FILE #: 03-122	FILENAME: 03122-1	
LOC: \ENGINEERING\CAT PROJECTS\2003\03122\DRAWINGS		
DRAWN BY: BG	CHECKED: SC	APPROVED: SC
DATE: 6/13/03	SCALE: NONE	WET WEIGHT: 26,200 LBS
CENTER OF GRAVITY 	DIMENSIONS INCH	OVERALL LENGTH: 233" OVERALL WIDTH: 90" OVERALL HEIGHT: 114"