


THIS DRAWING APPLIES TO UNITS 9451 AND LATER.

COMPRESSOR  
S/N: F-9749

ENGINE  
S/N: C-11161/1

COOLER  
S/N: 944418

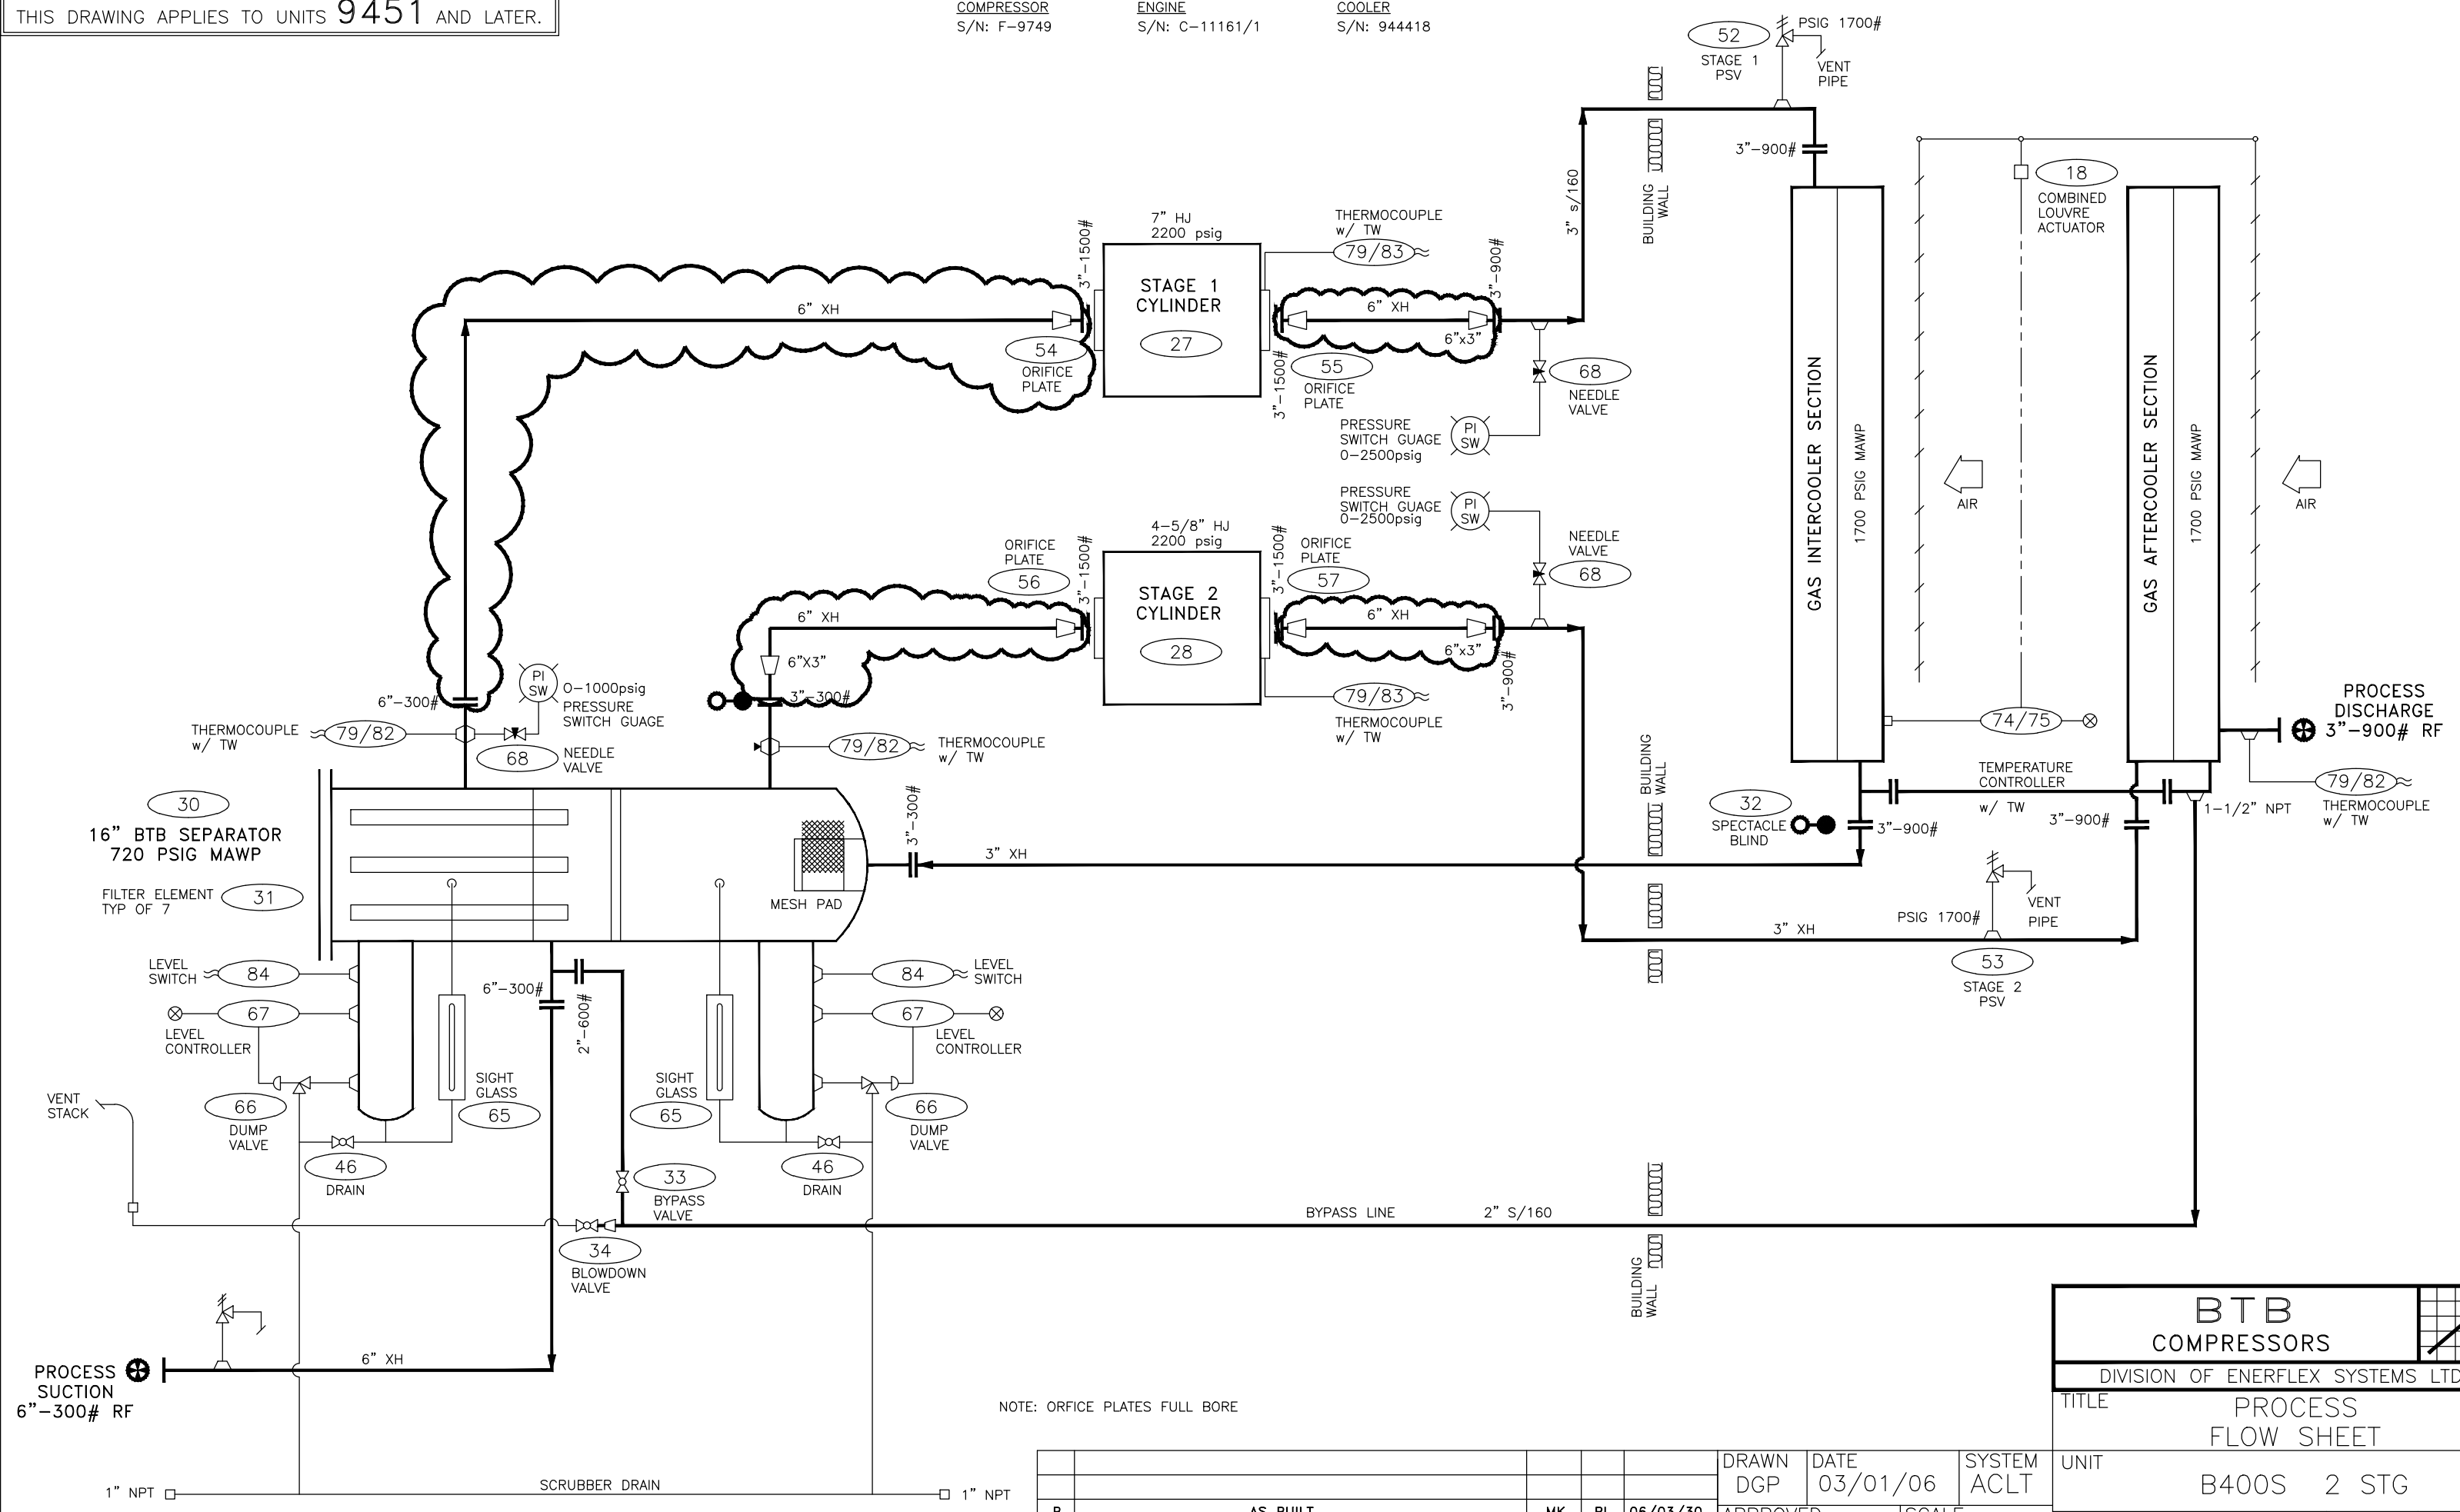

NOTE: ORFICE PLATES FULL BORE

**BTB**  
COMPRESSORS

DIVISION OF ENERFLEX SYSTEMS LTD.  
TITLE PROCESS FLOW SHEET

UNIT B400S 2 STG

DWG. NO. PF055954 SHEET 1 ISS. 01/06

REV.	DESCRIPTION	BY	APP.	DATE
B	AS BUILT	MK	RL	06/03/30
A	ISSUED FOR APPROVAL	MK	PK	06/01/03

DRAWN DGP	DATE 03/01/06	SYSTEM ACLT
APPROVED		SCALE NTS
FILE: PF055954		

OLD JOB# BTB 9452