


S-800
FRESH WATER TANK
VOLUME: 160m³ (1000 BBL)
SIZE: 18'-5" DIA. x 32'-0" HIGH
DP: 12 oz PRESS. / 0.4 oz VAC.

H-800
IMMERSION TANK HEATER
MAKE:
MODEL:
CAPACITY: 20 KW
480/3/60

S-900
DIESEL STORAGE TANK
VOLUME: 63.5m³ (400 BBL)
SIZE: 12'-0" DIA. x 20'-0" HIGH
DP: 12 oz PRESS. / 0.4 oz VAC.

P-900
DIESEL TRANSFER PUMP
MODEL/MAKE: CHIEFLO 5, 4.76" IMPELLER
CAPACITY: 16m³/hr (63 USGPH) @ 15m (45.5ft) TON
MOTOR: 3HP @ 3500 RPM, 480/3/60 XP
HORIZONTAL DIRECT DRIVEN

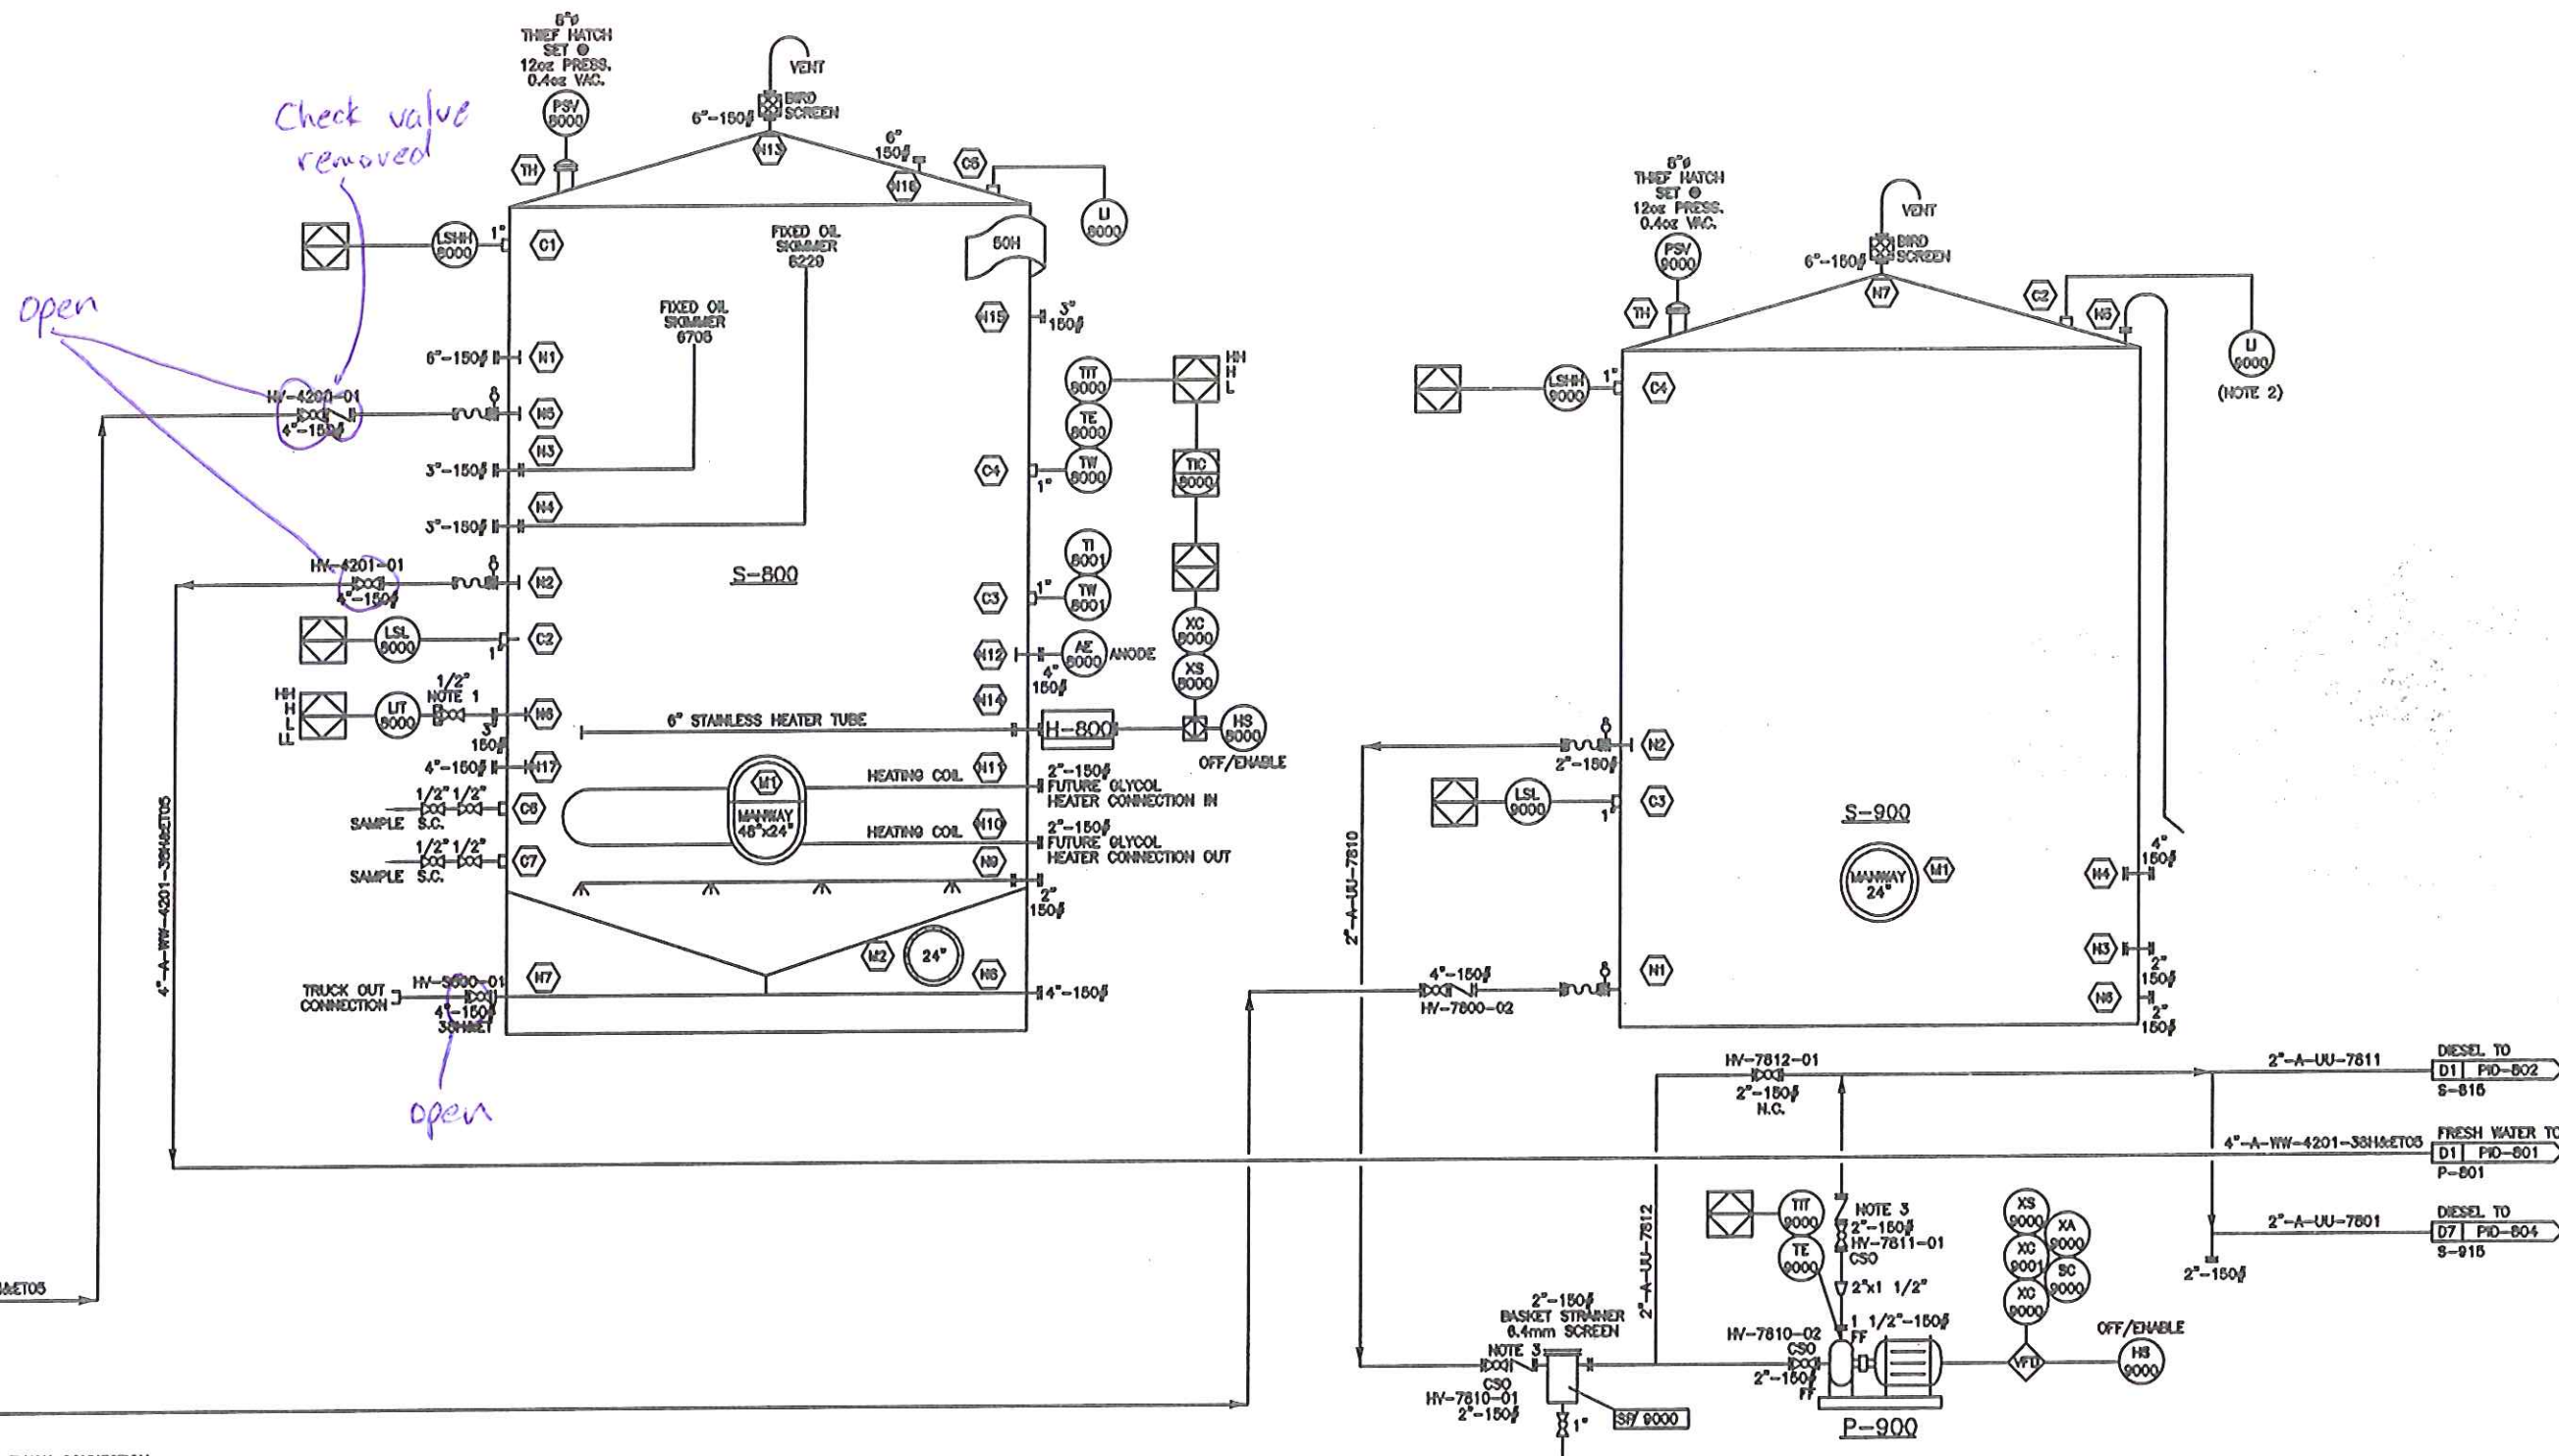

- NOTES:**
1. DIAPHRAGM SEAL WITH FLUSH CONNECTION.
 2. LOCAL INDICATION TO BE READABLE AT TRUCK-IN LOCATION.
 3. FLAPPER REMOVED FROM CHECK VALVES.

AS-BUILT DRAWING

TRIDYNE PROJECTS CORPORATION WAS NOT RETAINED TO PROVIDE FULL TIME FIELD REVIEW OF THE CONSTRUCTION. AS SUCH, THIS AS-BUILT DRAWING HAS BEEN PREPARED IN PART ON THE BASIS OF INFORMATION COMPILED AND FURNISHED BY OTHERS. TRIDYNE PROJECTS CORPORATION CANNOT BE RESPONSIBLE FOR ANY ERRORS OR OMISSIONS WHICH HAVE BEEN INCORPORATED INTO THIS DRAWING.

2011048	1	AS BUILT	2012.10.11	DZ		
2011048	0	IPC - FIELD DRAWING PACKAGE	2011.11.14	DZ	PM	RY

TRIDYNE PROJ. No.
2011008
DATE
2011.03.11
DRAWN BY
MVG
CHECKED:
APPROVED:



TRIDYNE PROJECTS
CORPORATION

MAXHAMISH

a-98-H, 94-O-11

PRODUCED WATER RECEIPT AND DISPOSAL FACILITY
(S-800) FRESH WATER & (S-900) DIESEL TANKS
PIPING & INSTRUMENTATION DIAGRAM

SCALE: NONE
DWG. No.: CCS-MAX-a-98-H-PID-800
REV. 1