



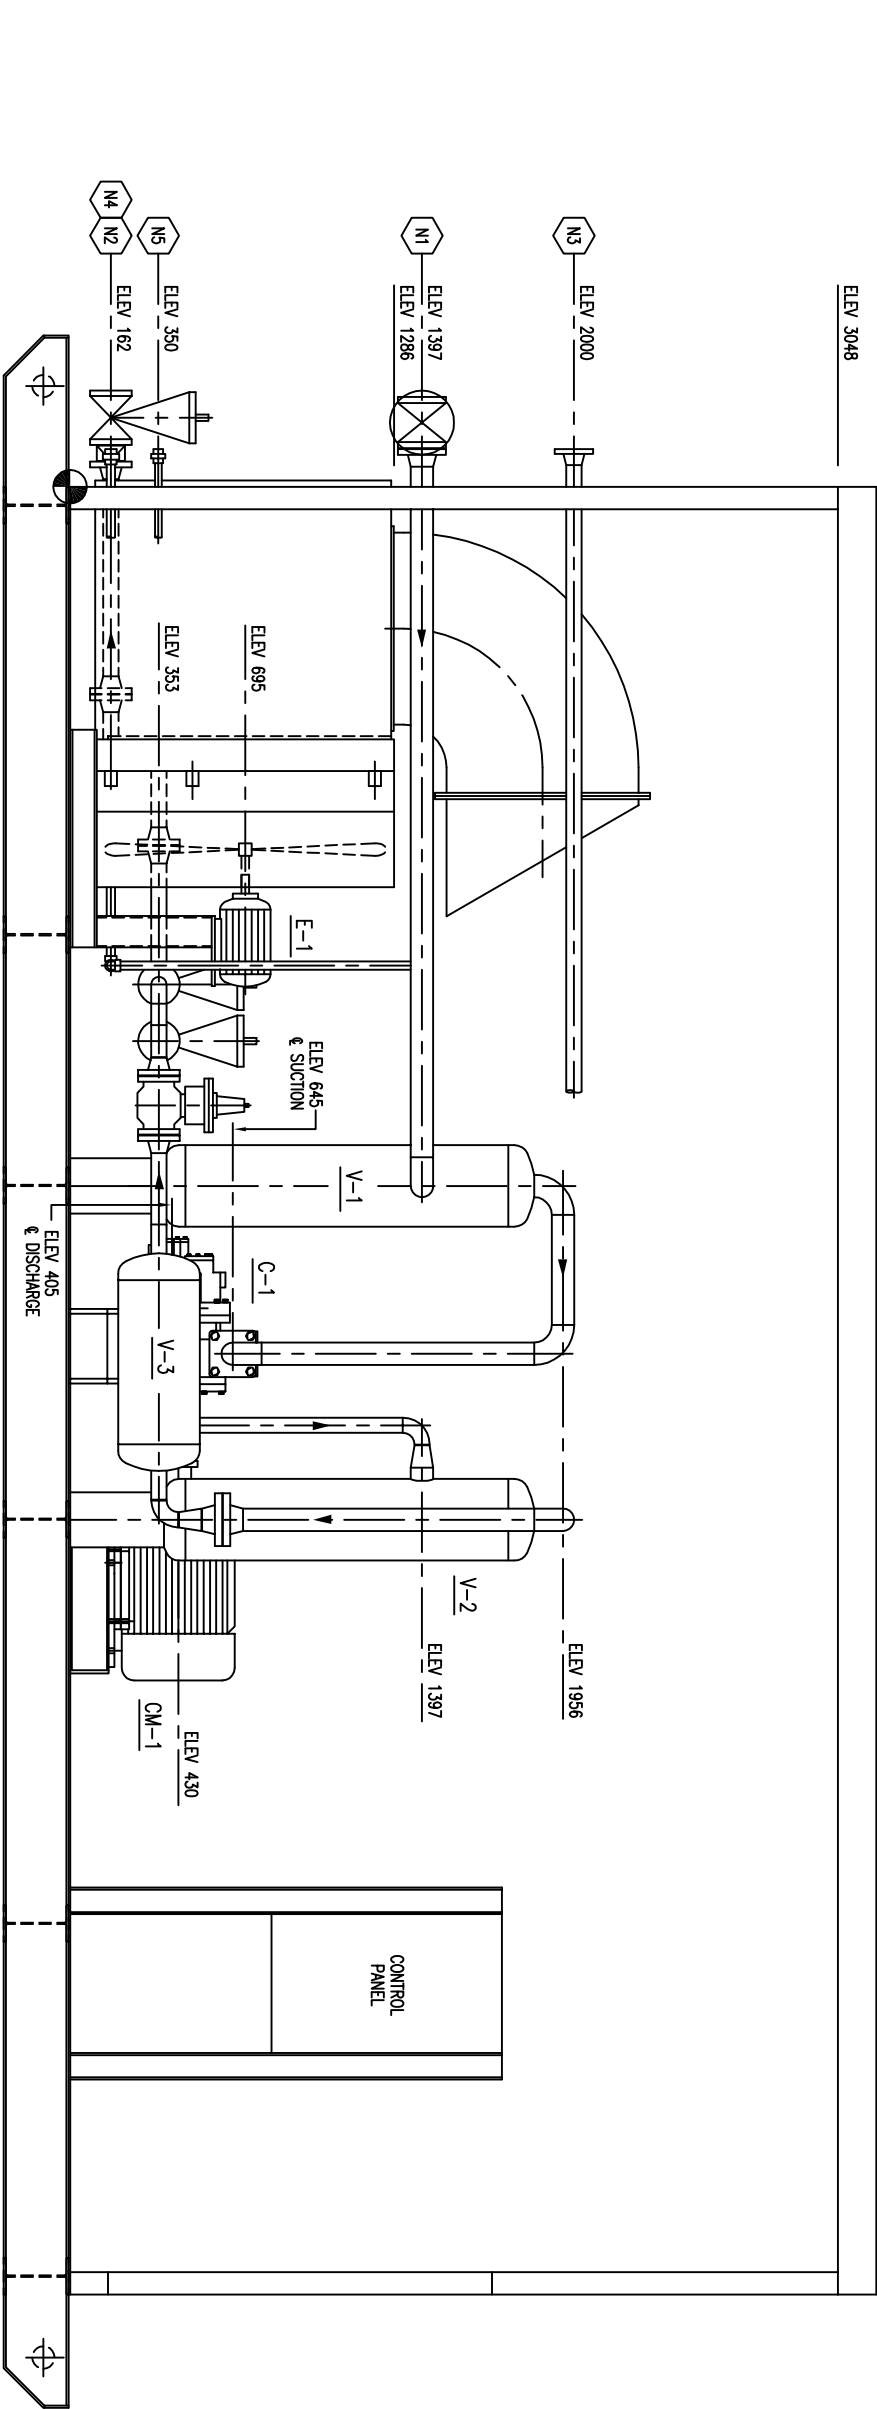

ELEVATION VIEW

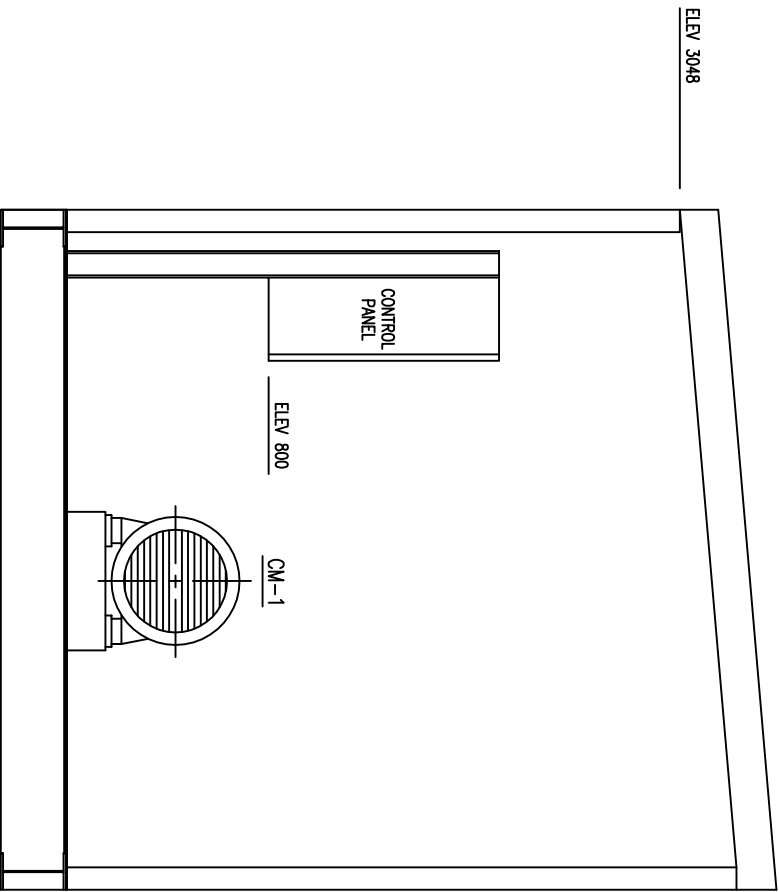

SECTION A'-A'

REV.	DESCRIPTION	DATE	BY	APPR.	PERMIT TO PRACTICE STAMP	ENGINEER STAMP
3	AS BUILT	MAR 13/98 G.S.				
2	CLIENT REVISION	FEB 02/98 G.S.	D.J.			
1	ISSUED FOR CONSTRUCTION	JAN 22/98 G.S.	D.J.			
A	ISSUED FOR APPROVAL	JAN 14/98 G.S.	D.J.			

TOROMONT		TOROMONT PROCESS SYSTEMS		TITLE: GENERAL ARRANGEMENT	
DRAWN BY: G. STANGNESS		DATE: DEC 19, 1997		FOR: ROZSA PETROLEUM LTD	
CHKD. BY: D. JAMES		SCALE: 1 : 15		ROZSA ENCHANT BATTERY	
APPR. BY: D. JAMES		W.D. No: 10308201		60 HP BOOSTER UNIT	
CUST. PO No:		DWG. No: 10308-201		LSD: 16-9-12-60-W4M	
		SHEET No: 2 OF 2		REV: 3	