
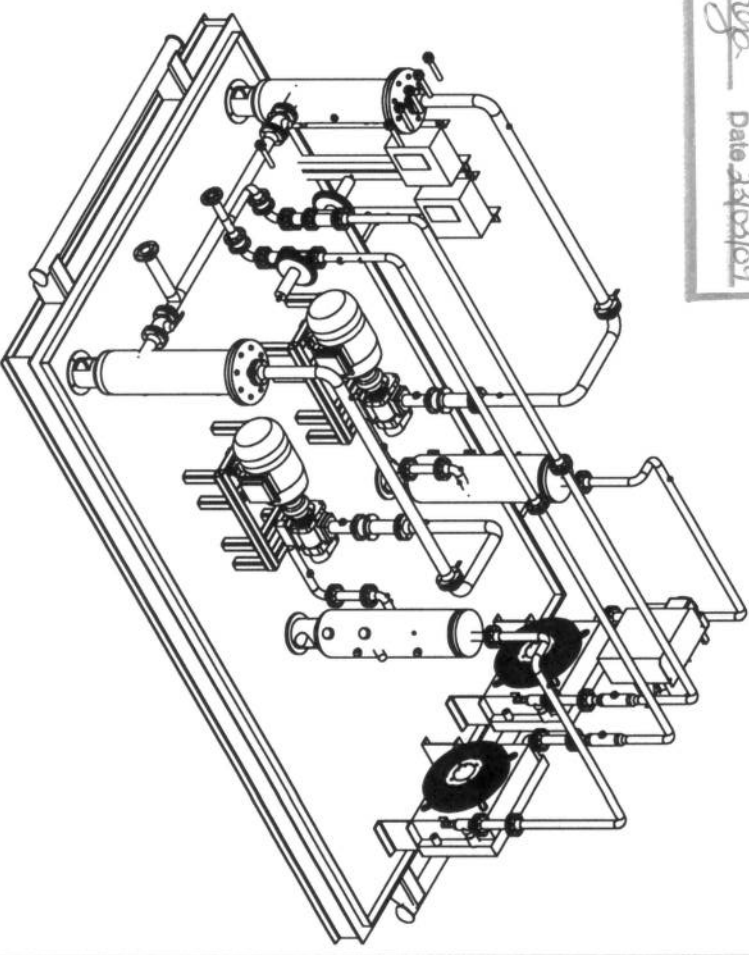
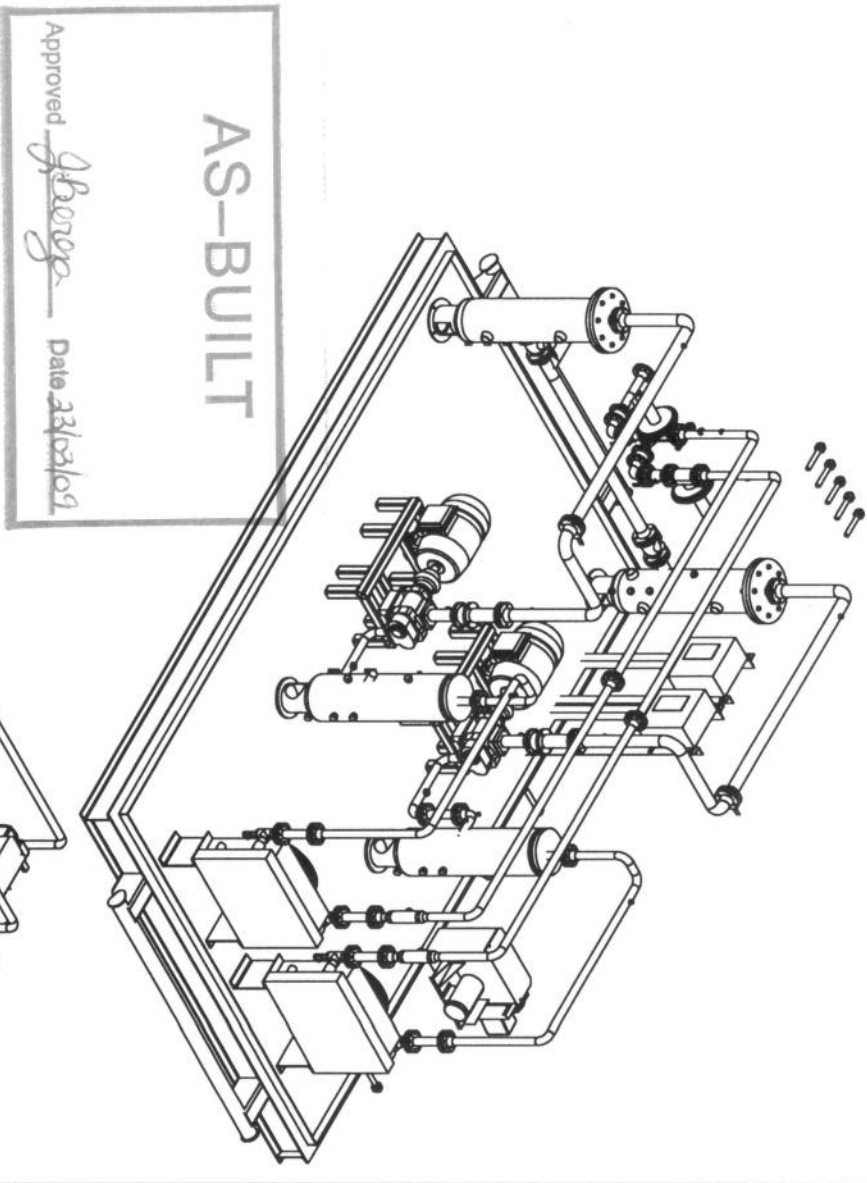
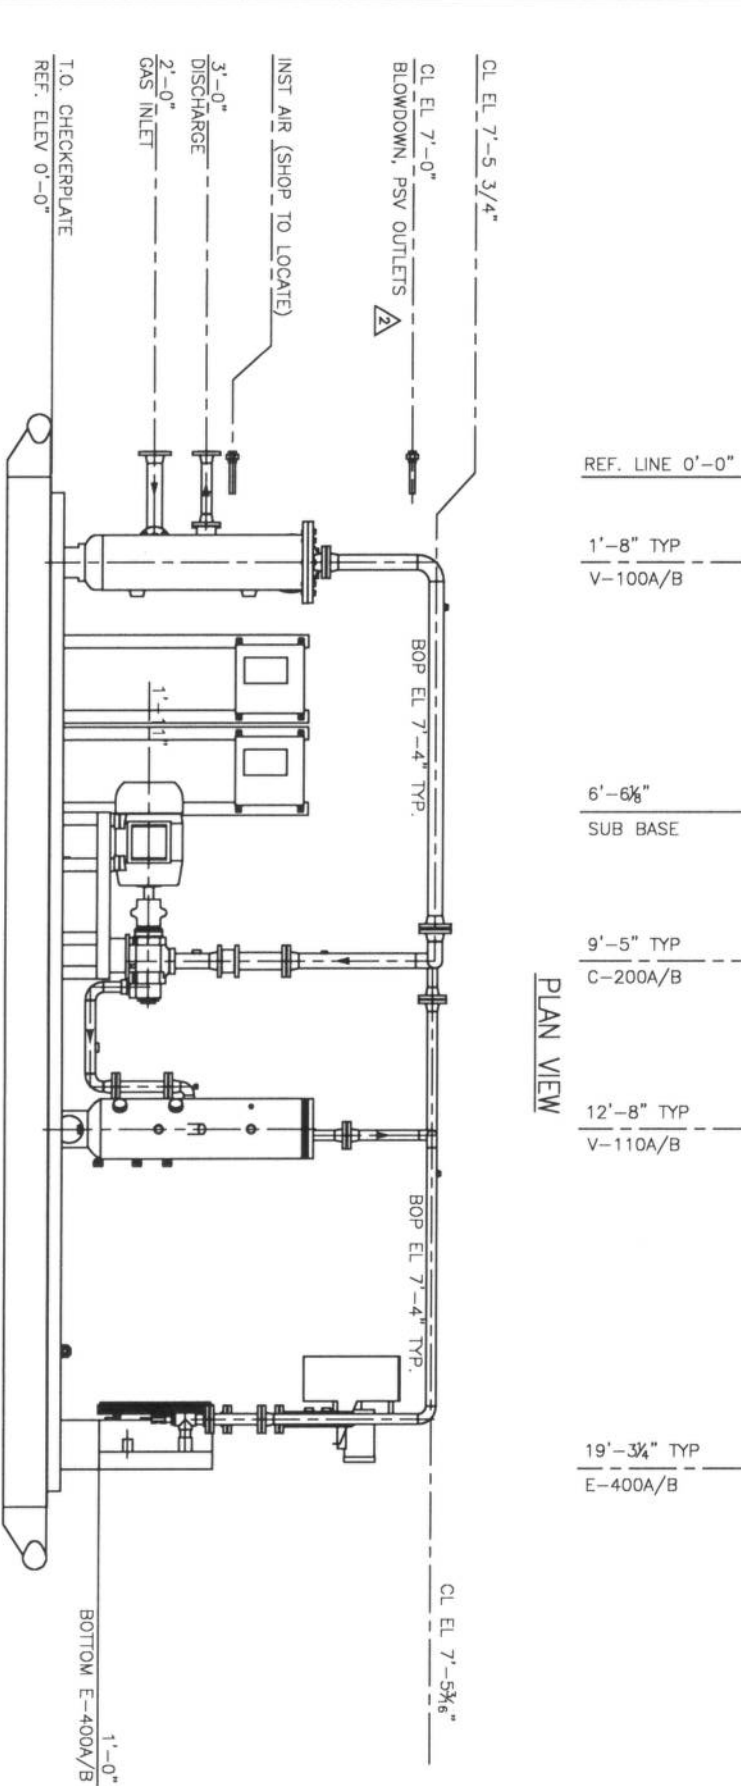


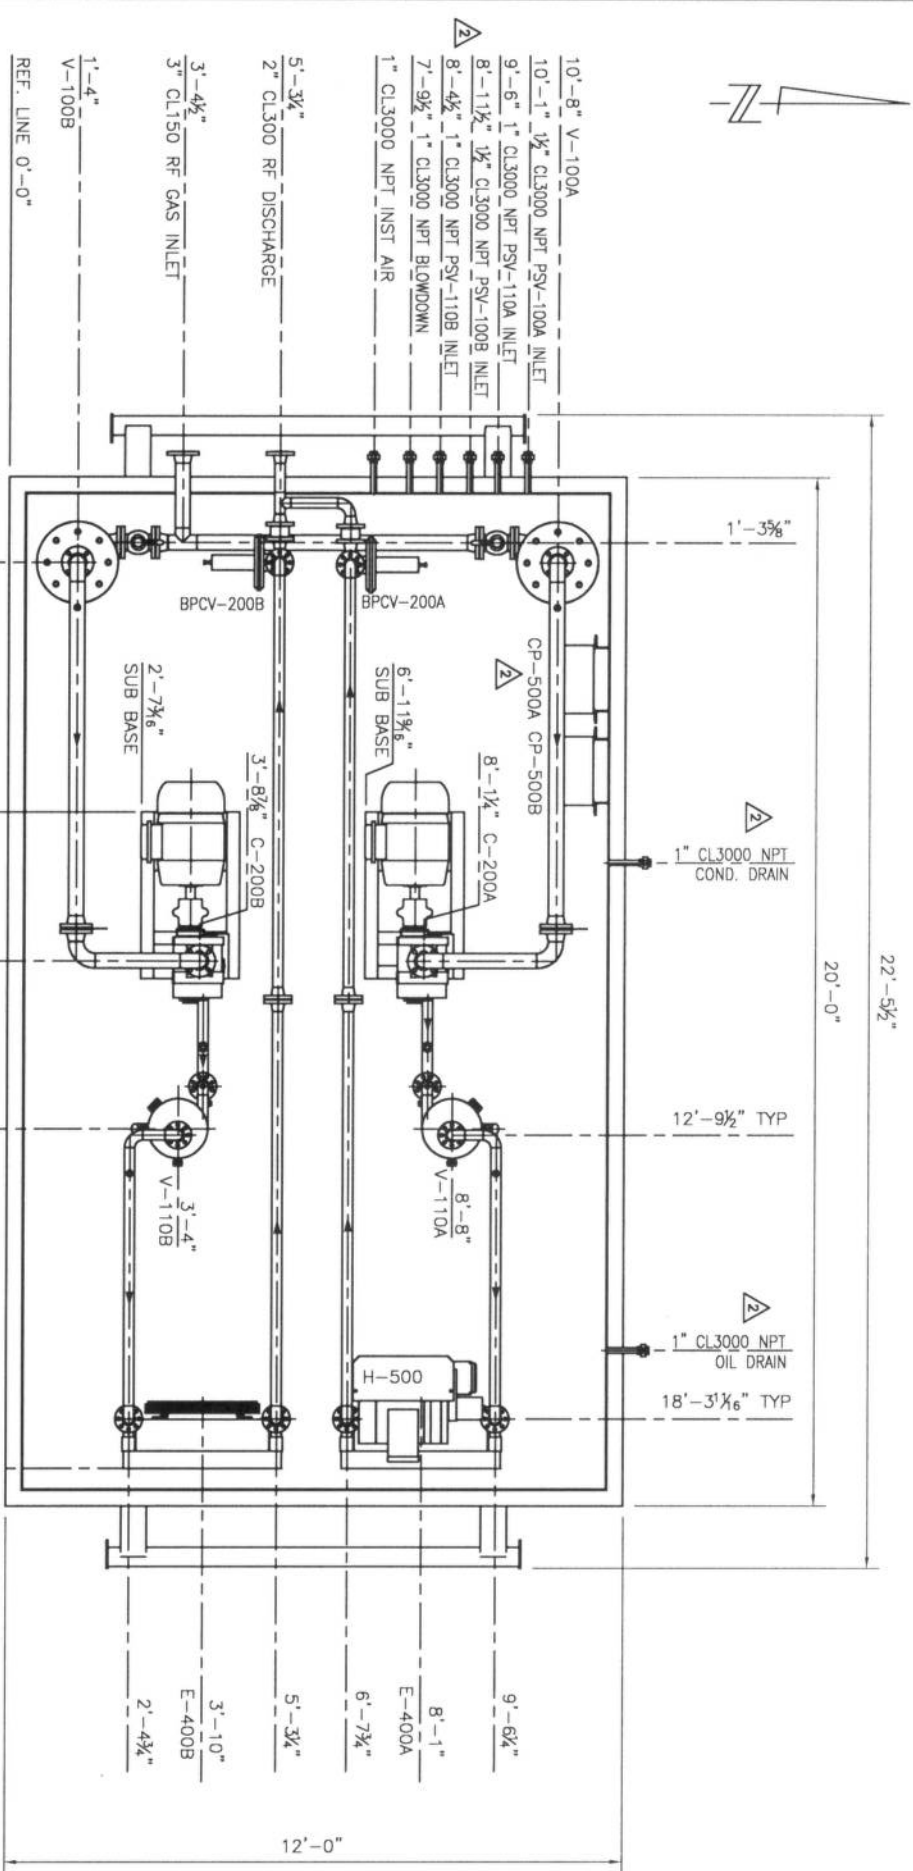

AS-BUILT

Approved gpcg Date 23/03/09

PROJECT NAME: C5+ TRANSLADING TERMINAL
PROJECT NO. 2007-115
P.O. NO.: 4500093383
LOCATION: BRUDERHEIM, AB

REV	DESCRIPTION	DATE	APP'D
2	AS BUILT	MAR.20/09	JB
1	REVISED AS NOTED	FEB.17/09	JB
0	ISSUED FOR CONSTRUCTION	FEB.9/09	JB
A	ISSUED FOR APPROVAL	JAN.30/09	JB



BRITANNIA INDUSTRIES INC.
2313 - 8TH STREET
NISKU, ALBERTA
T9E 7Z3
PH: (780) 955-7524
FAX: (780) 955-7468

GENERAL ARRANGEMENT DRAWING
DUAL 40HP GARDNER DENVER
ENDURO E25 SCREW PACKAGE

DRWN	DATE
JB	JAN.26/09
APPROVED	DATE
JB	

SCALE	DATE
NTS	APP'D

JOB No.	DATE
20416	20416-200

CUSTOMER	DATE
CANEXUS CHEMICALS CANADA LTD.	20416-200
c/o RANGLAND ENGINEERING LTD.	2