


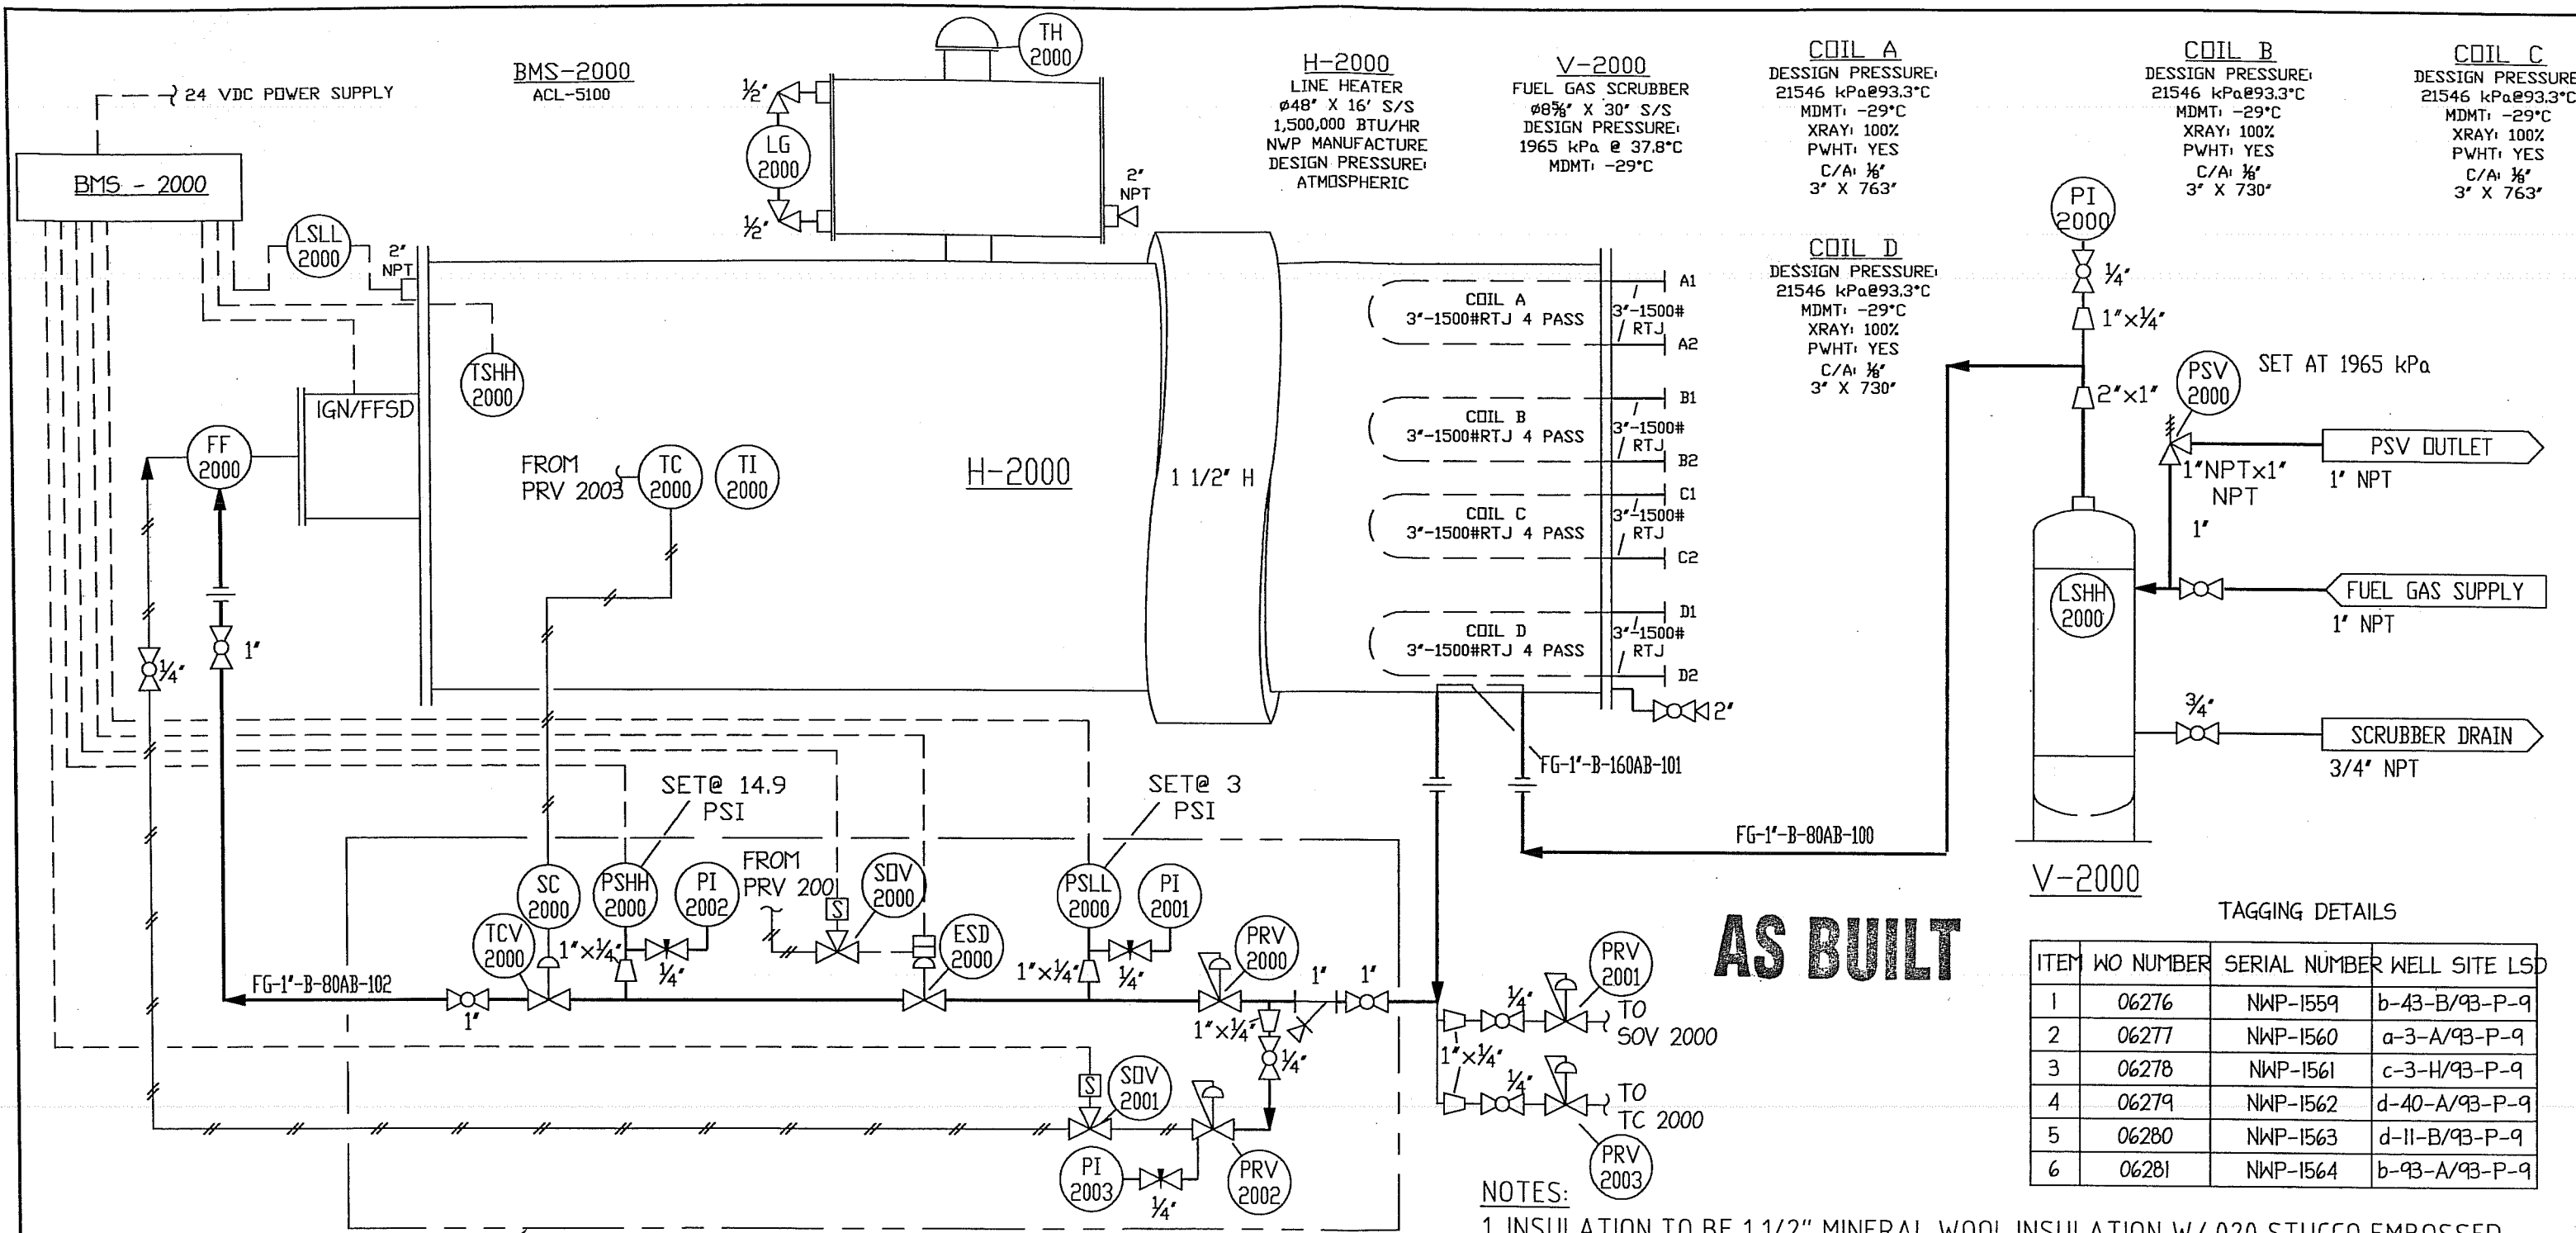

TAGGING DETAILS

ITEM	WO NUMBER	SERIAL NUMBER	WELL SITE LSP
1	06276	NWP-1559	b-43-B/93-P-9
2	06277	NWP-1560	a-3-A/93-P-9
3	06278	NWP-1561	c-3-H/93-P-9
4	06279	NWP-1562	d-40-A/93-P-9
5	06280	NWP-1563	d-11-B/93-P-9
6	06281	NWP-1564	b-93-A/93-P-9

NWP-1559-41	PREHEAT LINE						
NWP-1559-4	LINE HEATER						
NWP-1559-3	SKID						
NWP-1559-2	COIL						
NWP-1559	GENERAL ARRANGEMENT	1	2008.11.13	KD			ISSUED FOR CONSTRUCTION (ADDED TAGGING DETAILS)
BNWP-1559-1	BILL OF MATERIALS	0	2008.10.21	PNC	ETB	GH	ISSUED FOR CONSTRUCTION
DOCUMENT NO.	DESCRIPTION	REV	DATE	BY	CHK	APP	
REFERENCE DRAWINGS		DRAWING REVISIONS					



NWP INDUSTRIES INC.
Total oilfield supply.
P.O. BOX 6280, INNISFAIR, AB T4G 1S9
PH (403) 227-4100 FAX (403) 227-4102
www.nwp.ca

P&ID
ø48" x 16' LINE HEATER
1,500,000 BTU/HR ; W/18" FIRETUBE
Tupper Field Gathering System

THIS DRAWING IS PROPERTY OF NWP INDUSTRIES INC. AND MAY NOT BE REPRODUCED WITHOUT PERMISSION. THIS DRAWING MUST BE RETURNED UPON REQUEST.

SCALE	NTS	DWG	NWP-1559-1	REV 1
SHEET	1/1			