
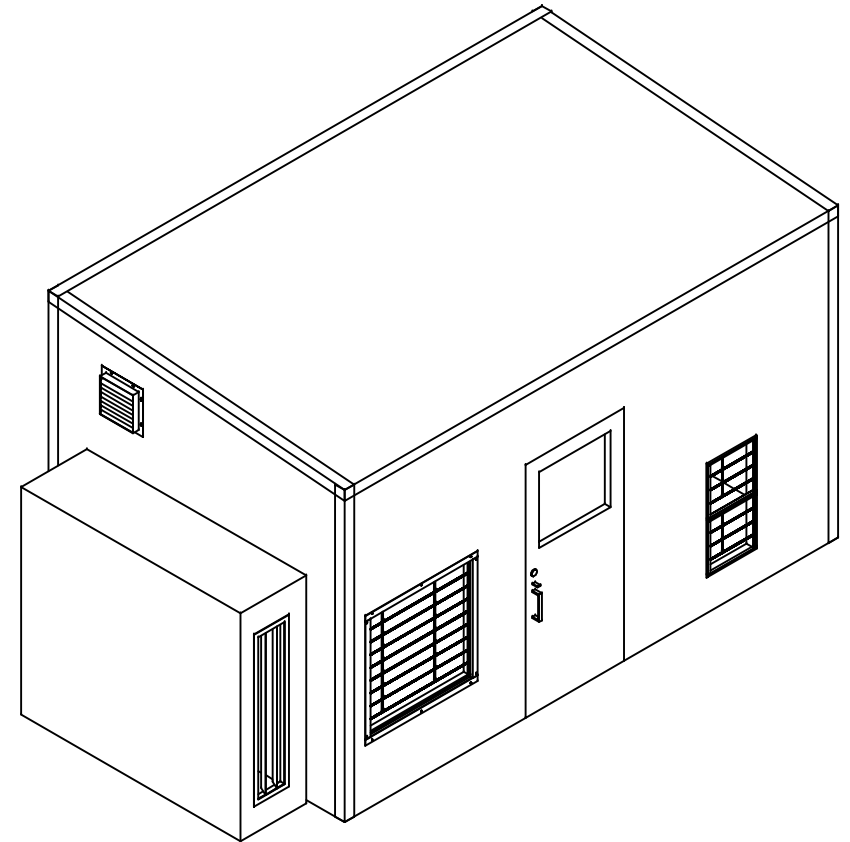


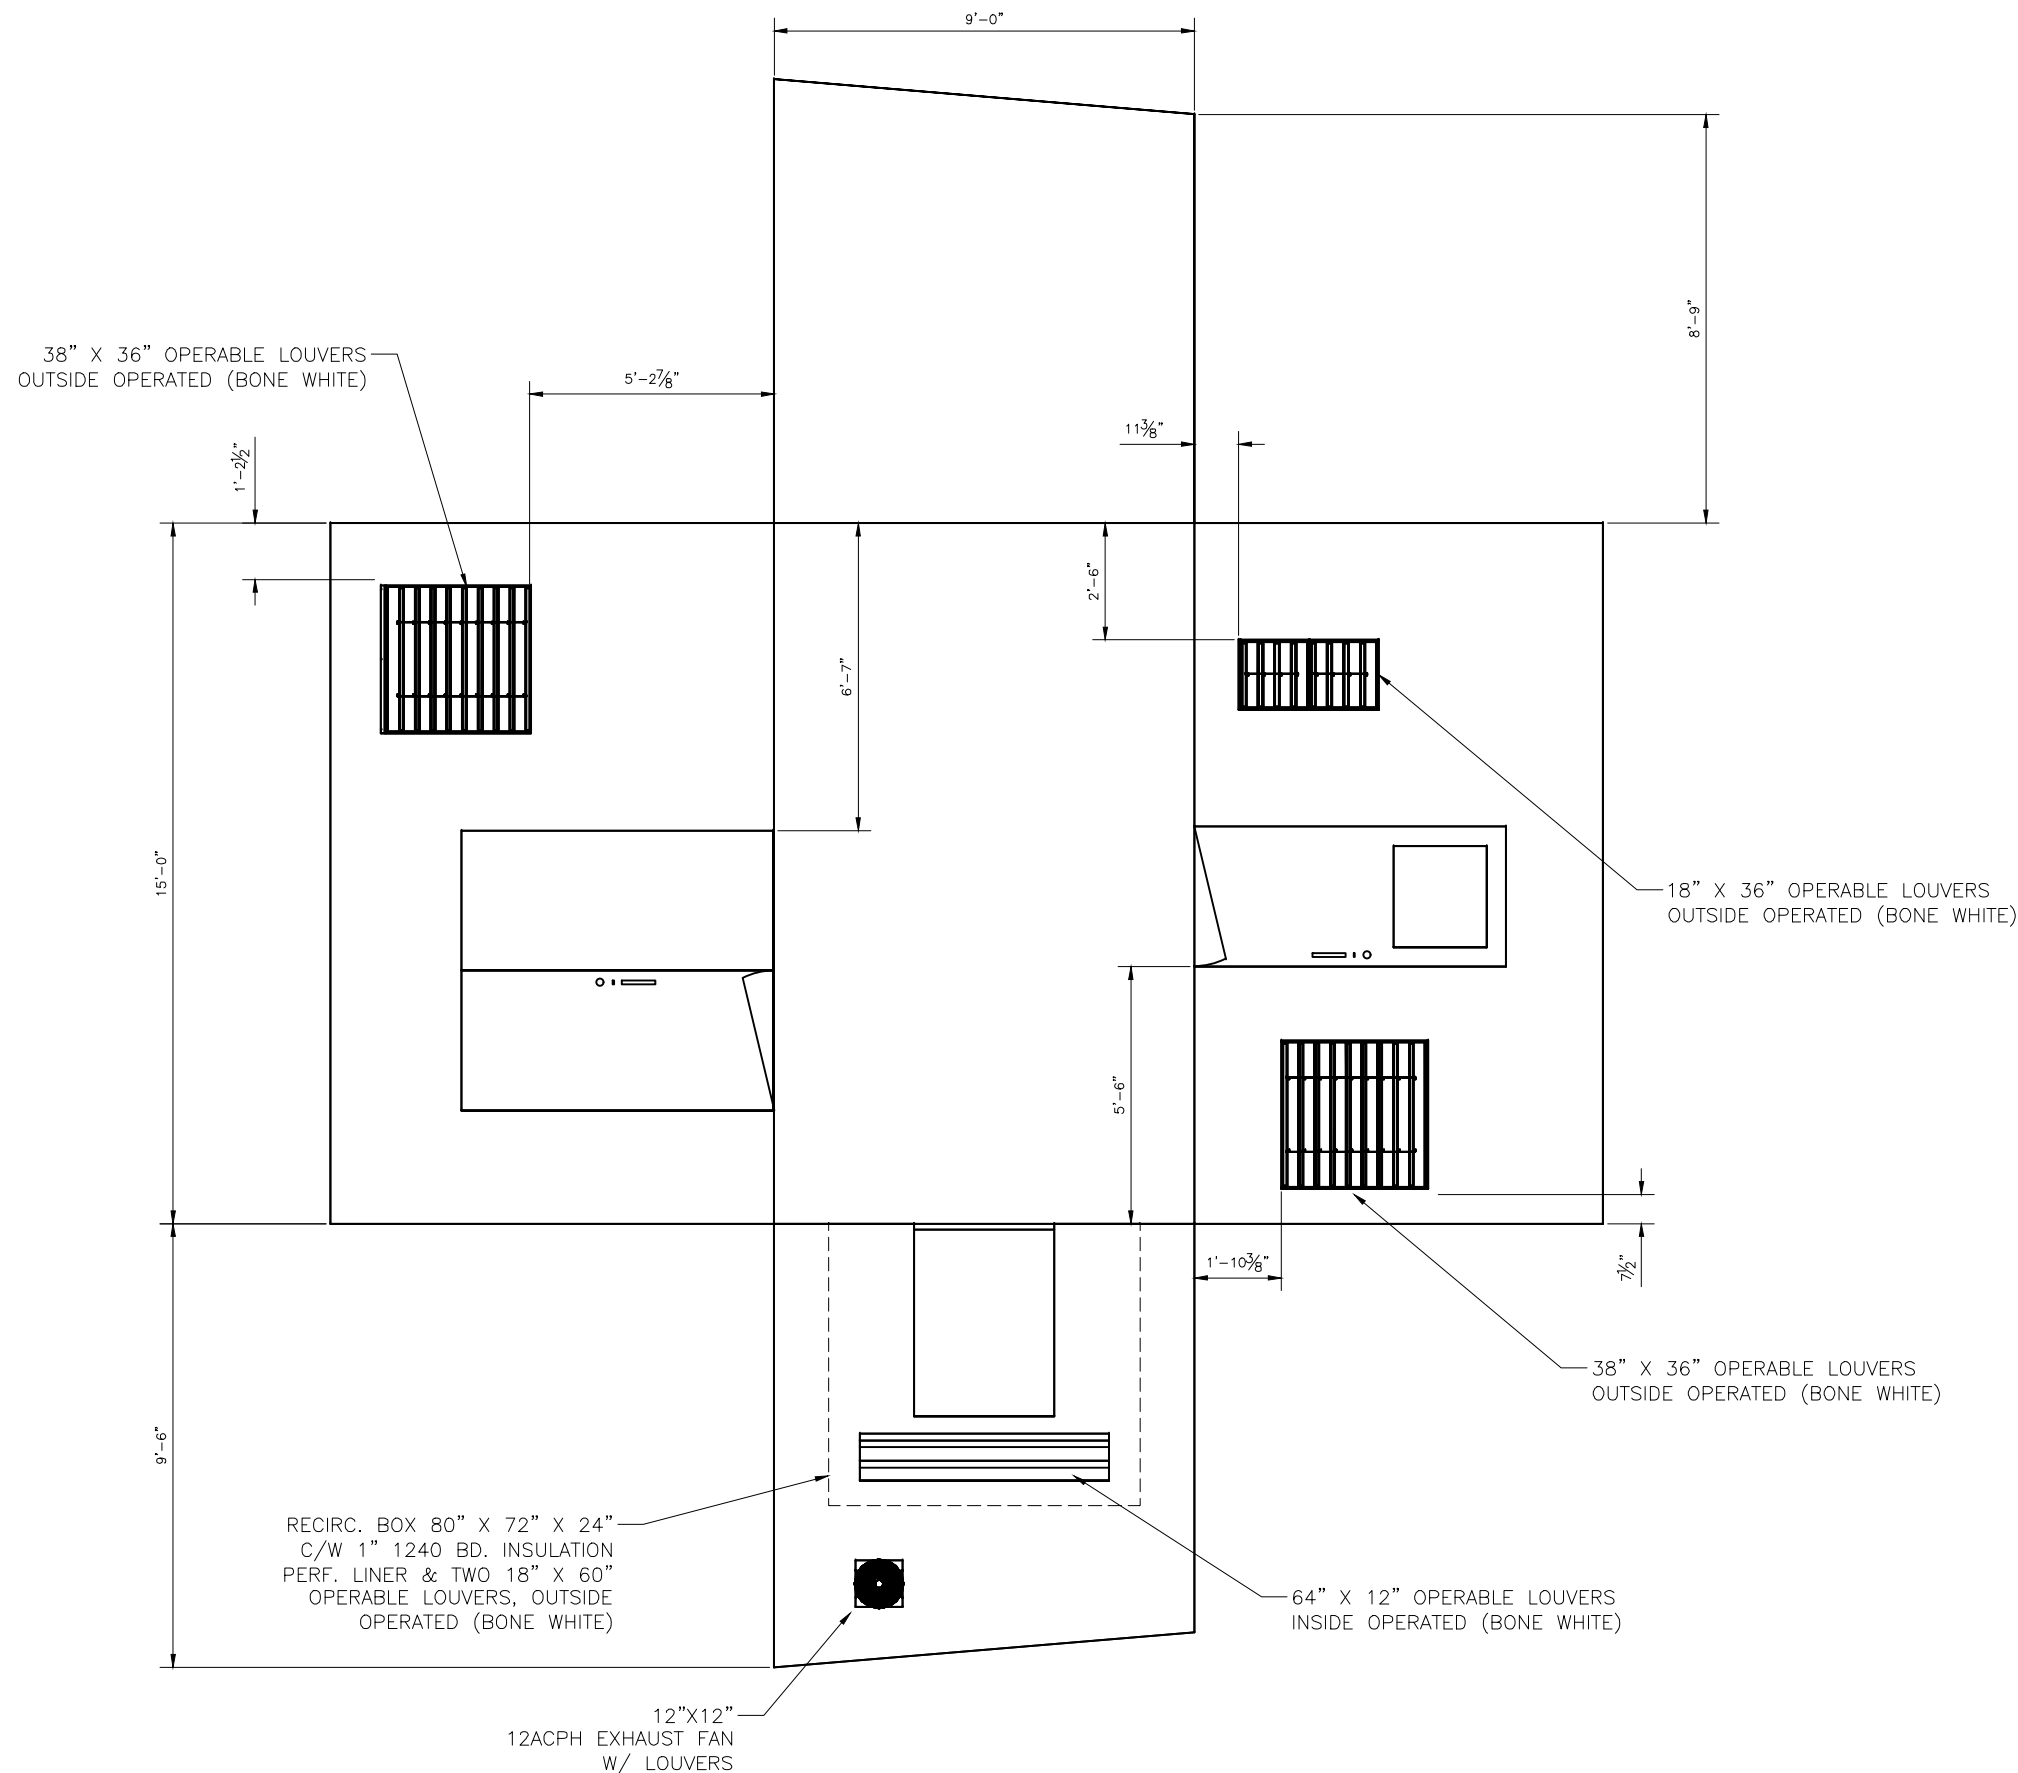

BUILDING SPECIFICATIONS:

EXT WALL: 22GA GALVANIZE BONE WHITE – QC 273
EXT ROOF: 22GA GALVANIZE BONE WHITE – QC 273
EXT TRIM: 22GA GALVANIZE BONE WHITE – QC 273
INT LINER: 20GA ALUMINUM FLUTED – WHITE
WALL INSUL: 3” R12 W/ 4 MILL VAPOUR BARRIER
ROOF INSUL: 3” R12 W/ 4 MILL VAPOUR BARRIER

ONE 3’ X 7’ MAN DOOR, RH, IWG
ONE 6’ X 7’ MAN DOOR, RH ACTIVE

0	AS BUILT	24/04/23	MRB
REV	DESCRIPTION	DATE	BY
REVISION HISTORY			
		BRITTANIA INDUSTRIES 2009 INC. 6227-41ST STREET LEDUC, AB T9E 0V7 PH. 780-986-5955 FAX: 780-986-7113 TOLL FREE: 866-955-7524	
DRAWN	DATE	BUILDING DETAIL DRAWING GARDNER DENVER TAMROTOR E25DG 75HP ELECTRIC VRU PACKAGE (RETROFIT TO BRAHMA UNIT S02246)	
JB	06/10/22		
APPROVED	DATE		
.	.		
CLIENT P.O. NO.			
JOB No.	CUSTOMER	DWG NO.	REV.
20960 (S02246)	TAMARACK VALLEY c/o FUELLED	20960-201	0