

TK-100


PRE-CONTACT
SEPARATION CHAMBER
48 CU.FT

TK-101

CHEMICAL CONTACT
CHAMBER
96 CU.FT

TK-102

POST-CONTACT
SEPARATION CHAMBER
48 CU.FT

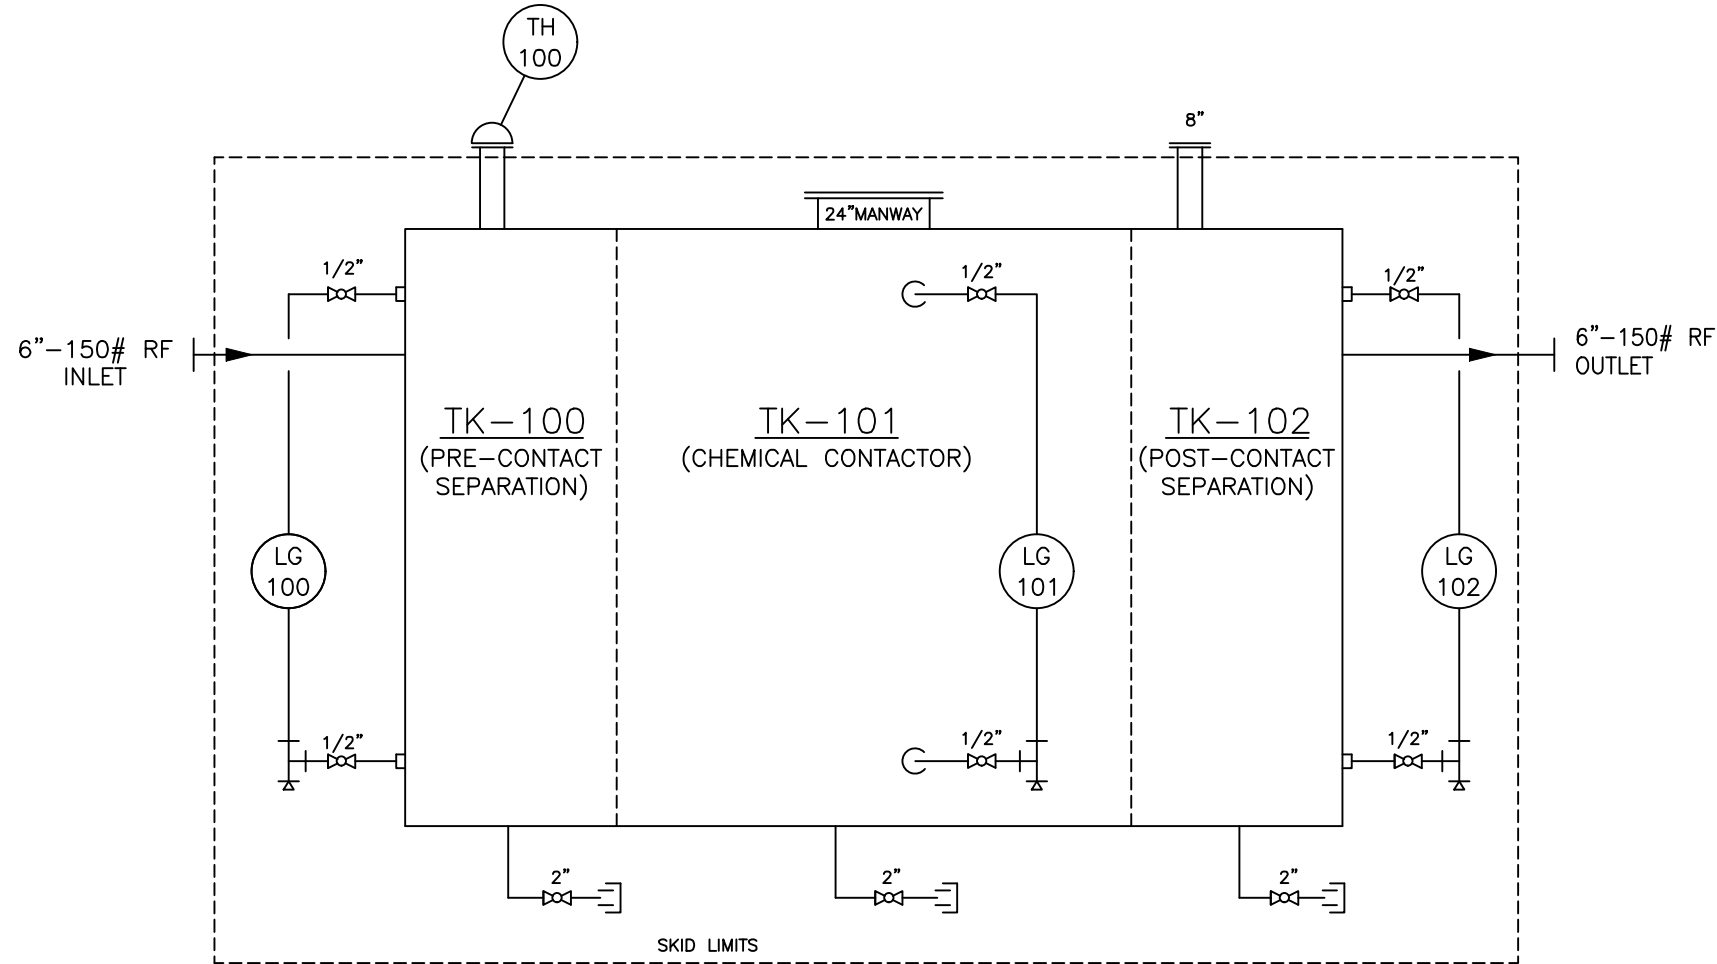

BILL OF MATERIALS - INSTRUMENTS

ITEM	QTY	DESCRIPTION	MODEL NO.	MANUFACT.	PARTS NO.
TH-100	1	THIEF HATCH-8", SET @ 32 oz. PRESSURE/ 0.4 oz. VAC, SOUR.	TVTH-200-32-S	HAWKEY INDUSTRIES	TK-1031
LG-100/101/102	3	60" ATMOSPHERIC PRESSURE LIQUID LEVEL GAUGE c/w EXTRUDED ALUMINUM CAGE	SG60BC	LOUVRE & GAUGES	GG-1076

BILL OF MATERIALS - VALVES & CAMLOCKS

QTY	SIZE	RATING	PARTS NO.	DESCRIPTION	MODEL NO.	MANUFACT.
3	2"	2000#	VA-1643	BALL VALVE NPT RP. LEVER OPERATED	-	MAS
6	1/2"	2000#	VA-1731	BALL VALVE NPT RP, LEVER OPERATED	-	MAS
3	2"	-	PN-1272	CAMLOCK - MALE THREAD X MALE CONNECTION	-	-
3	2"	-	PN-114B	CAMLOCK DUST CAP	-	-

GENERAL NOTES:

REV.	DATE	DESCRIPTION	DRAWN	CHECK	DESIGN	APPR.
1	13-MAY-21	AS BUILT	SH		GD	
0	12-APR-21	ISSUED FOR CONSTRUCTION	DZ		GD	GD

CLIENT:

H2OIL ENERGY INC.



TITLE:

VENT GAS SCRUBBER VGS-44

SCALE:

NTS

DRAWING NO.:

PD219-102

FILE: M:\Projects\Projects 2021\219-100\219-102 H2Oil Energy\Drawings