
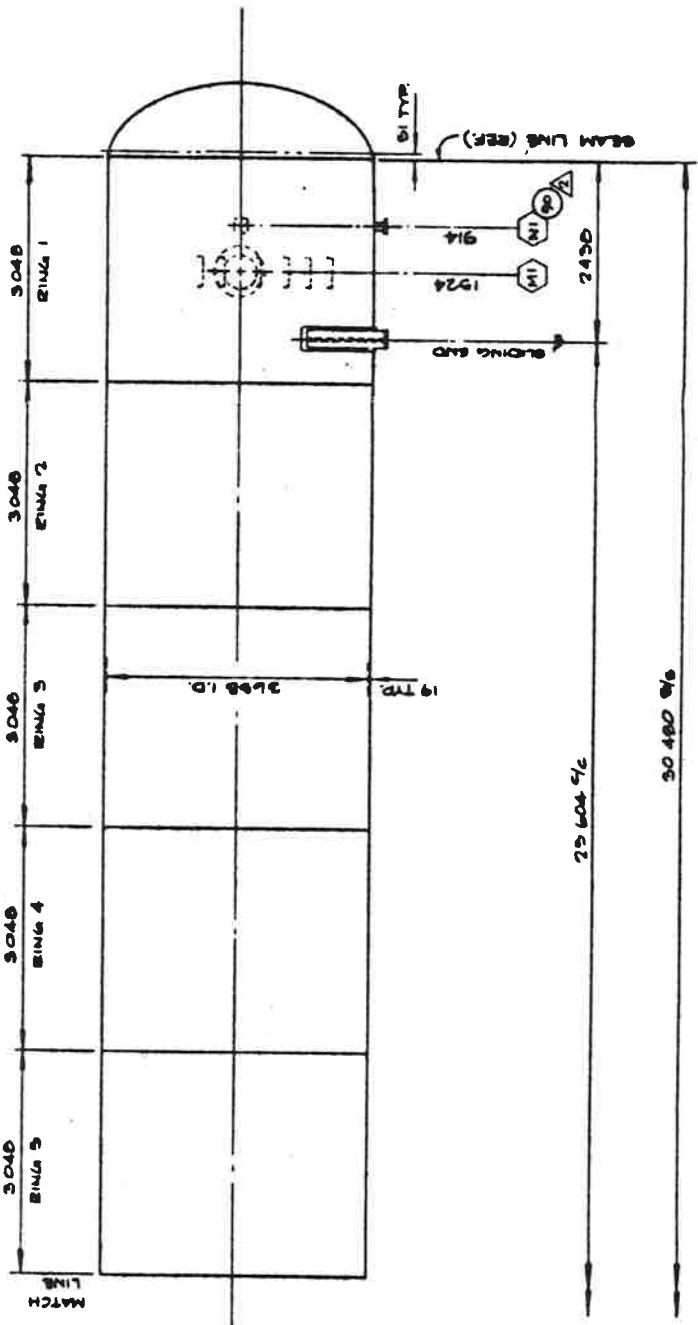


BILL OF MATERIALS

ITEM	QTY	DESCRIPTION	MATERIAL	REMARKS	%
51	2	3/4" ID x 18 3/4" MIN 2-USE ASME HD 1/2" DIA	SA-216-70 HEADS		
52	10	3/4" ID x 18 3/4" MIN 2-USE ASME HD 1/2" DIA	SA-216-70 SHELL		
56	1	DAVIT FOR 20" 150# BF FLG	C.B.		
57	1	20" 150# ANSI BF BLIND FLG	SA-105		
58	1	GASKET FOR 20" 150# BF FLG	STAINLESS		
59	1	20" 150# ANSI BFWN FLG 1/2" BORE	SA-105		
60	20	1/2" x 3/4" LG STUD 1/2" HEX NUTS EA	SA-105		
61	1	20" SCH XH SMLS PIPE x 145 LG. (NECK)	SA-105-B		
62	1	900 STD x 19 1/2" DIA ID. (REPAD)	SA-216-70		
63	1	6" 150# ANSI BF BLIND FLG	SA-105		
64	1	GASKET FOR 6" 150# BF FLG	STAINLESS		
65	3	6" 150# ANSI BFWN FLG 1/2" BORE	SA-105		
66	3	6" 150# ANSI BFWN FLG 1/2" BORE	SA-105		
67	3	6" SCH XH SMLS PIPE x 135 LG. (NECK)	SA-105-B		
68	3	275 STD x 19 1/2" MILD. (REPAD)	SA-216-70		
69	3	5" 150# ANSI BFWN FLG 1/2" BORE	SA-105		
70	3	3" SCH XH SMLS PIPE x 103 LG. (NECK)	SA-105-B		
71	3	191 STD x 16 1/2" 921 D. (REPAD)	SA-216-70		
72	1	2" 150# ANSI BFWN FLG 1/2" BORE	SA-105		
73	1	2" SCH 160 SMLS PIPE x 118 LG. (NECK)	SA-105-B		
82	3	1" 6000# NPT CPLG	SA-105		
83	1	SEE DWG. D-3125-1A FOR DTL.	CIA/CB		
90	1	5.5-M.I. STD. NAME PLATE 1/2" BRACKET 1/2" x 3" DIA			

NOTE: BILL OF MATERIALS IS FOR ONE (1) VESSEL, THREE VESSELS REQUIRED.
REFER TO DWG. D-3125-1A FOR ORIENTATION.

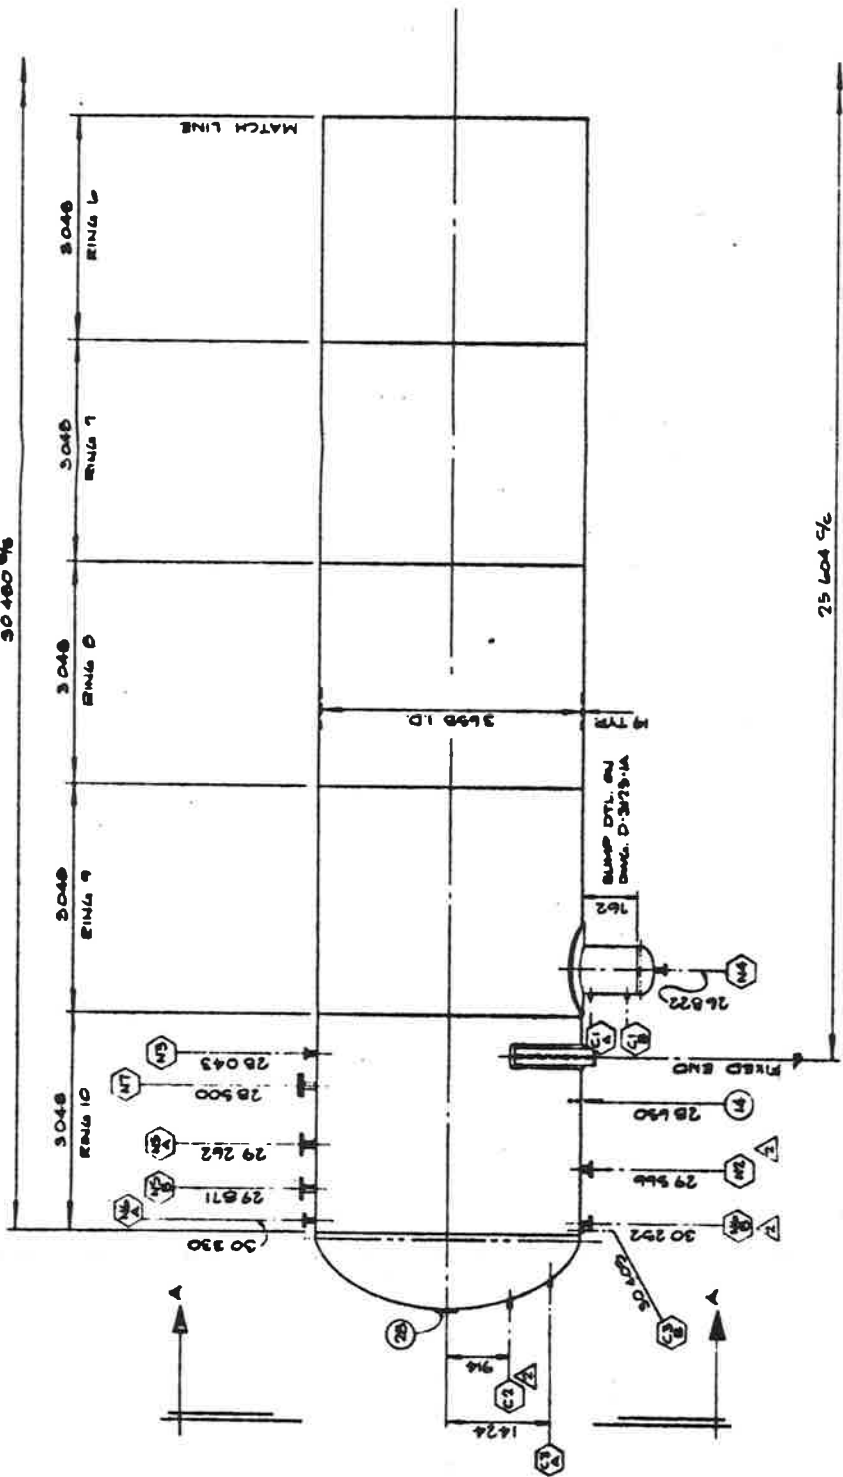

CERTIFIED AS BUILT

Jhk

APPROVED
NO RESPONSIBILITY ASSUMED FOR
ACCURACY OF SHOP DIMENSIONS
FISH INTERNATIONAL

FISH INTERNATIONAL
SERIAL NO. 8301-412-7-4
ITEM NO. V-820ABC

STRATHCONA STEEL MFG. INC.

9303-51 AVENUE EDMONTON, ALBERTA (403) 434-6637
CUSTOMER FISH INTERNATIONAL
CUSTOMER P.O. 8301-412 TAG NO. V-820-A.B.C

3656 ID LPG STORAGE BULLETS

ELEVATION

REV	DESCRIPTION	BY	DATE	CHKD	DATE	APP	DATE	JOB NO	DWG NO	REV
1	REV'D PER CUST MARK UP ELD 8/7/8	JHK	JULY 1983					83-725	83-725	D-3125-1B
2	REV'D PER CUST MARK UP ELD 8/8/8	JHK	AUG 1983							
3	ITEM # 75 WAS 17 1/2"	JHK	SEPT 1983							