
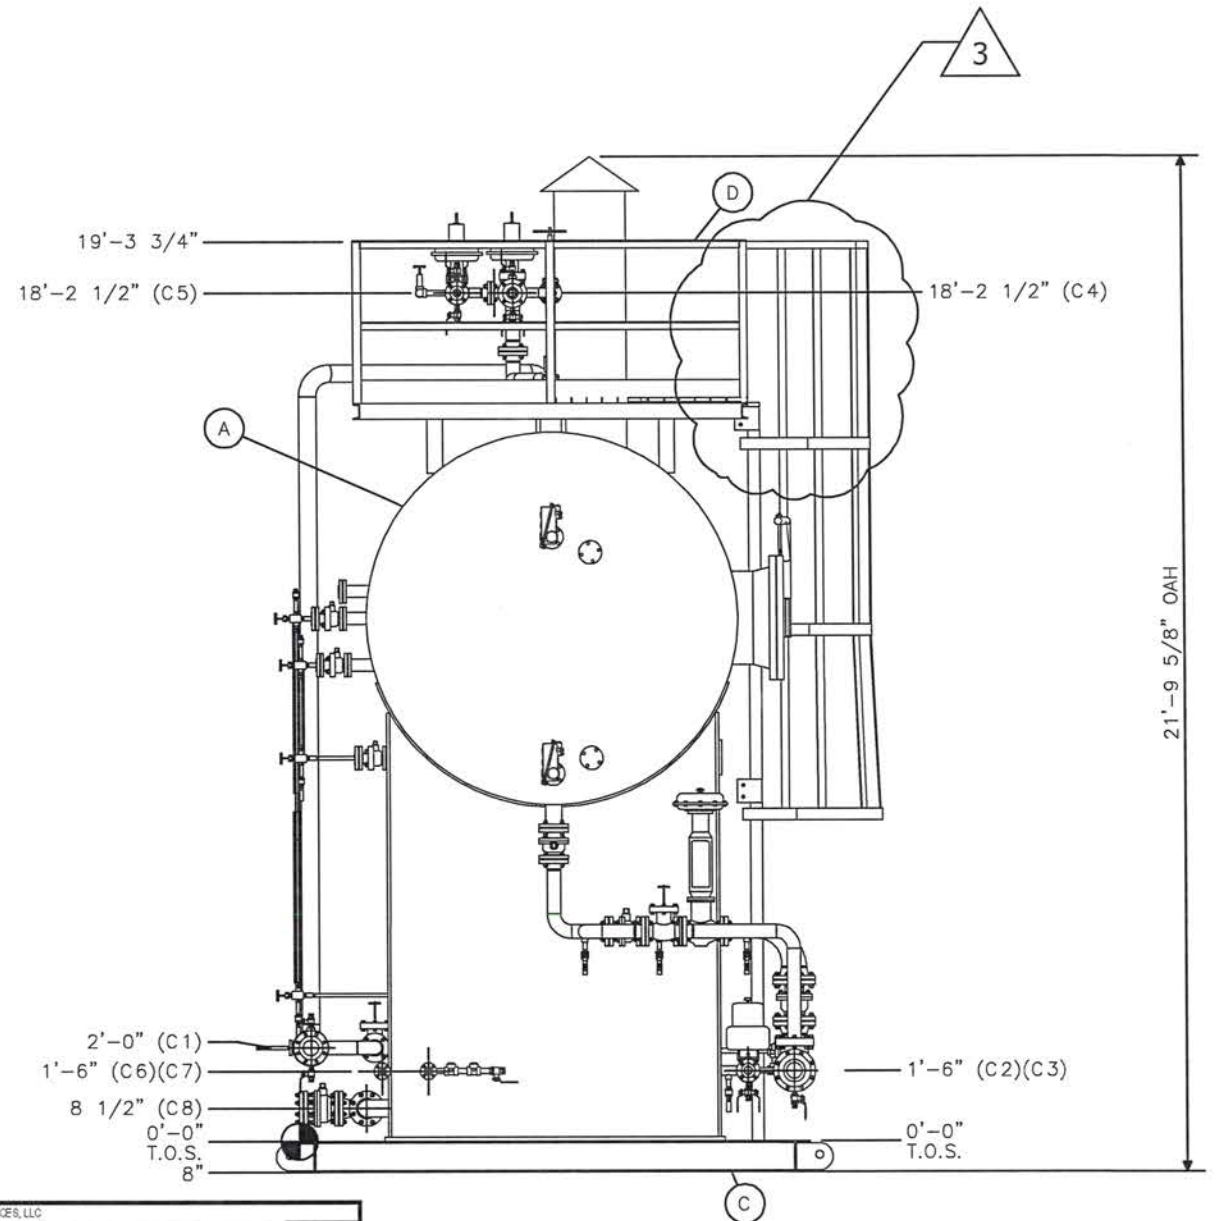


TAG SERIES	SWO # LOG	REV
V-2015	SWO#1 574xx004--0001 (QTY 1)	REV 0
V-2014	SWO#2 574xx004--0002 (QTY 1)	REV 0
V-2013	SWO#3 574xx004--0003 (QTY 1)	REV 0
	SWO#4	REV
	SWO#5	REV

LEGEND					
ITEM	TAG#	QTY	ERP NUMBER	DESCRIPTION	VENDOR
A	V-201x	1	N/A	HEATER TREATER: 96" OD x 32'-0" S/S 125 PSIG	ASME
B	BU-201x	1	PRO_000022	BMS: PF2100 w/KIT & VLVS, SEE OVERVIEW	
C		1	N/A	STRUCTURAL SKID STEEL: 8'-0" W x 24'-0" L w/ W8x24 MEMBERS	PS
D		1	N/A	STRUCTURAL PLATFORM STEEL: 5'-6" W x 20'-0" L w/ W6x15 MEMBERS	PS
					STOCK NUMBER
					96-32-HHS-125
					PDC-VES-STL-1
					PDC-VES-STL-2-PLATFORM

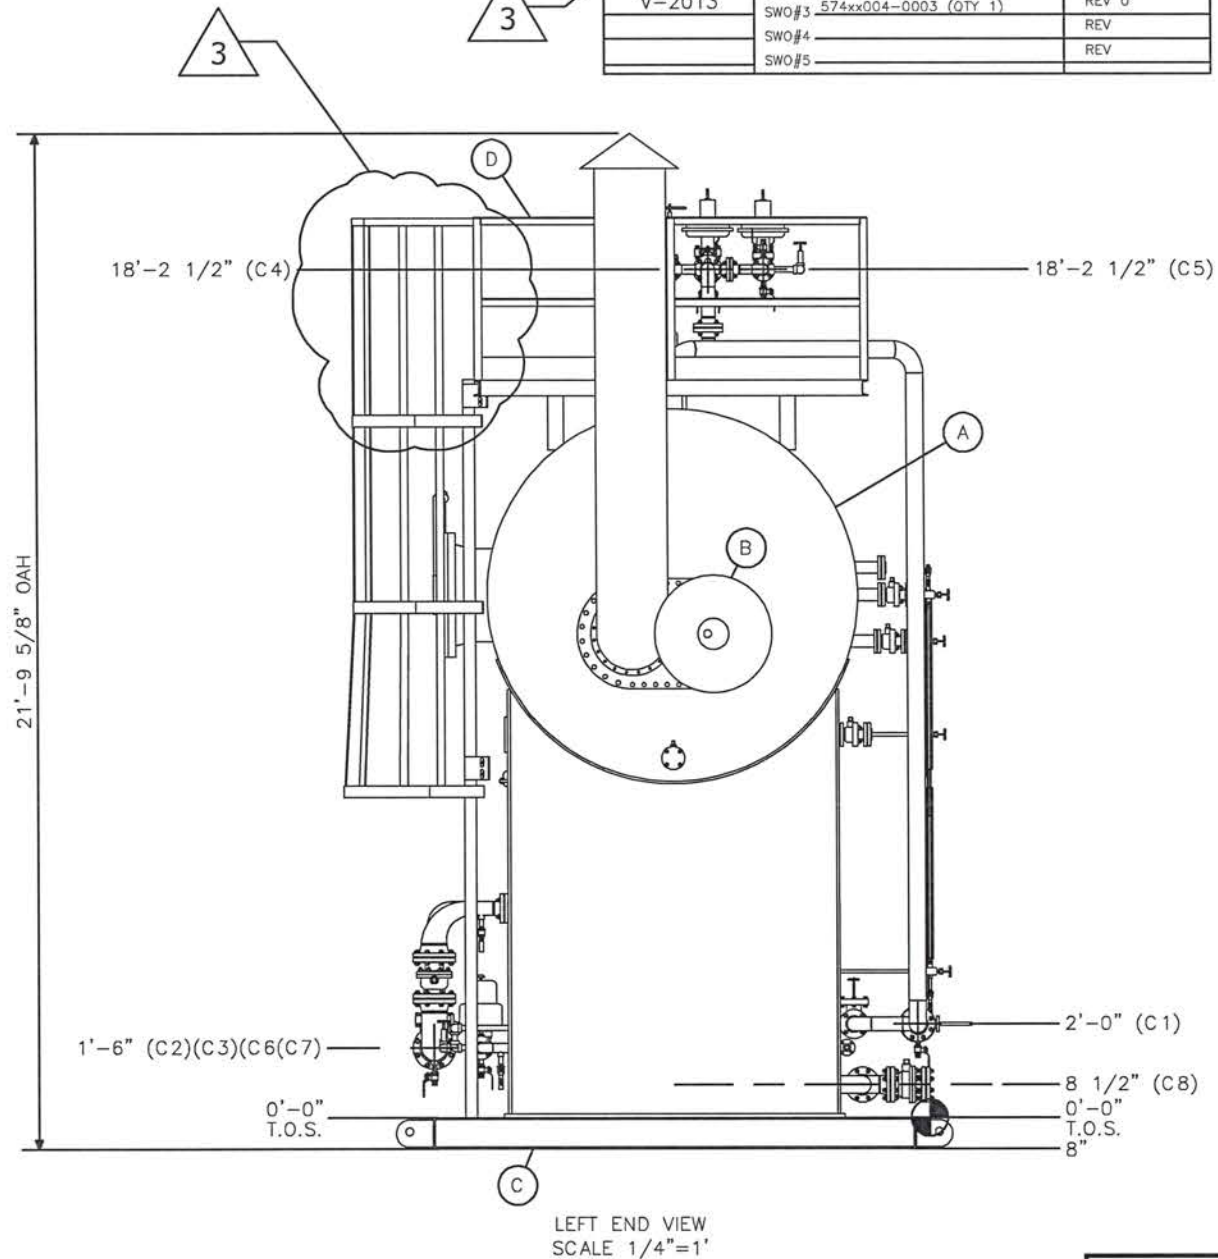

CONNECTION SCHEDULE

(C1)	4" 150# RF, OIL INLET
(C2)	6" 150# RF, OIL OUTLET
(C3)	2" 150# RF, WATER OUTLET
(C4)	3" 150# RF, GAS OUTLET
(C5)	2" 150# RF, FUEL GAS INLET
(C6)	1" 150# RF, I.A. INLET
(C7)	1" 150# RF, FUEL GAS INLET
(C8)	4" 150# RF, DRAIN OUTLET
(C9)	
(C10)	

GENERAL NOTES

- TOTAL PACKAGE WEIGHT APPROX. ~ 65,000 LBS.
- INTERIOR BUILDING COLOR: N/A
- EXTERIOR SKID AND BUILDING COLOR: CARLSBAD CANYON TAN
- INSULATION TO BE: N/A

REVISED

PREPARED BY: RK
DATE: 1/23/2019
REVISION # 3
APPROVED BY: JP
SWO # SEE LOG

REDX ENGINEERING SERVICES, LLC	
PROJECT NO. CO 840 40 010	P.O. NO. DE20180571
SIGNATURE: [Signature]	TAG NO. V-2013 V-2014 V-2015
Task No. 1103	

REVISION HISTORY

REV	DATE	DESIGN	DESCRIPTION	CHECK	APPROV
3	1/23/2019	RK	UPDATED TAGS & LADDER/ADDED TAG SERIES	CLC	JP
2	1/4/2019	RK	UPDATED LBS./COLOR/COG/SPLS	CLC	JP
1	12/27/2018	DS	ADDED C.O.G.	CLC	JP
0	10/8/2018	RK	FOR CONSTRUCTION	CLC	JW
D	10/3/2018	RK	UPDATED PER CUSTOMER MARKUPS	CLC	JW
C	9/25/2018	RK	UPDATED FOR FINAL APPROVAL	CLC	JW
B	9/17/2018	RK	UPDATED PER CUSTOMER MARKUPS	CLC	JW
A	9/14/2018	RK	FOR APPROVAL	CLC	JW

NOTICE: This drawing has not been published but rather has been prepared for PDC ENERGY by Power Service solely in respect of the construction, operation, and maintenance of the facility named in the title block and shall not be used for any other purpose or furnished to any other party, without the express written consent of Power Service.

DWG NO.	TITLE
96-32-HHS-125	VESSEL DETAIL
PDC-VES-PID-1	PROCESS DIAGRAM
	REFERENCE DRAWINGS

OWN BY	CHK'D BY
AP'D BY	ENGINEER
DATE DWN	SCALE
9/13/2018	1/4" = 1'

THIS DRAWING IS THE PROPERTY OF POWER SERVICE, A DISTRIBUTION NOW COMPANY, CASPER, WYOMING, USA.	
CUSTOMER	
PDC ENERGY	
GENERAL ARRANGEMENT	
HEATER TREATER BOREAS	
OTF, REEVES COUNTY, TEXAS	
12'-0" OAWx42'-11 1/4" OALx21'-9 5/8" OAH	
SHEET: 6 of 6	PROJECT NO. PDC-VES-L0-1
DWG. NO. PDC-VES-L0-1	REV. 3