



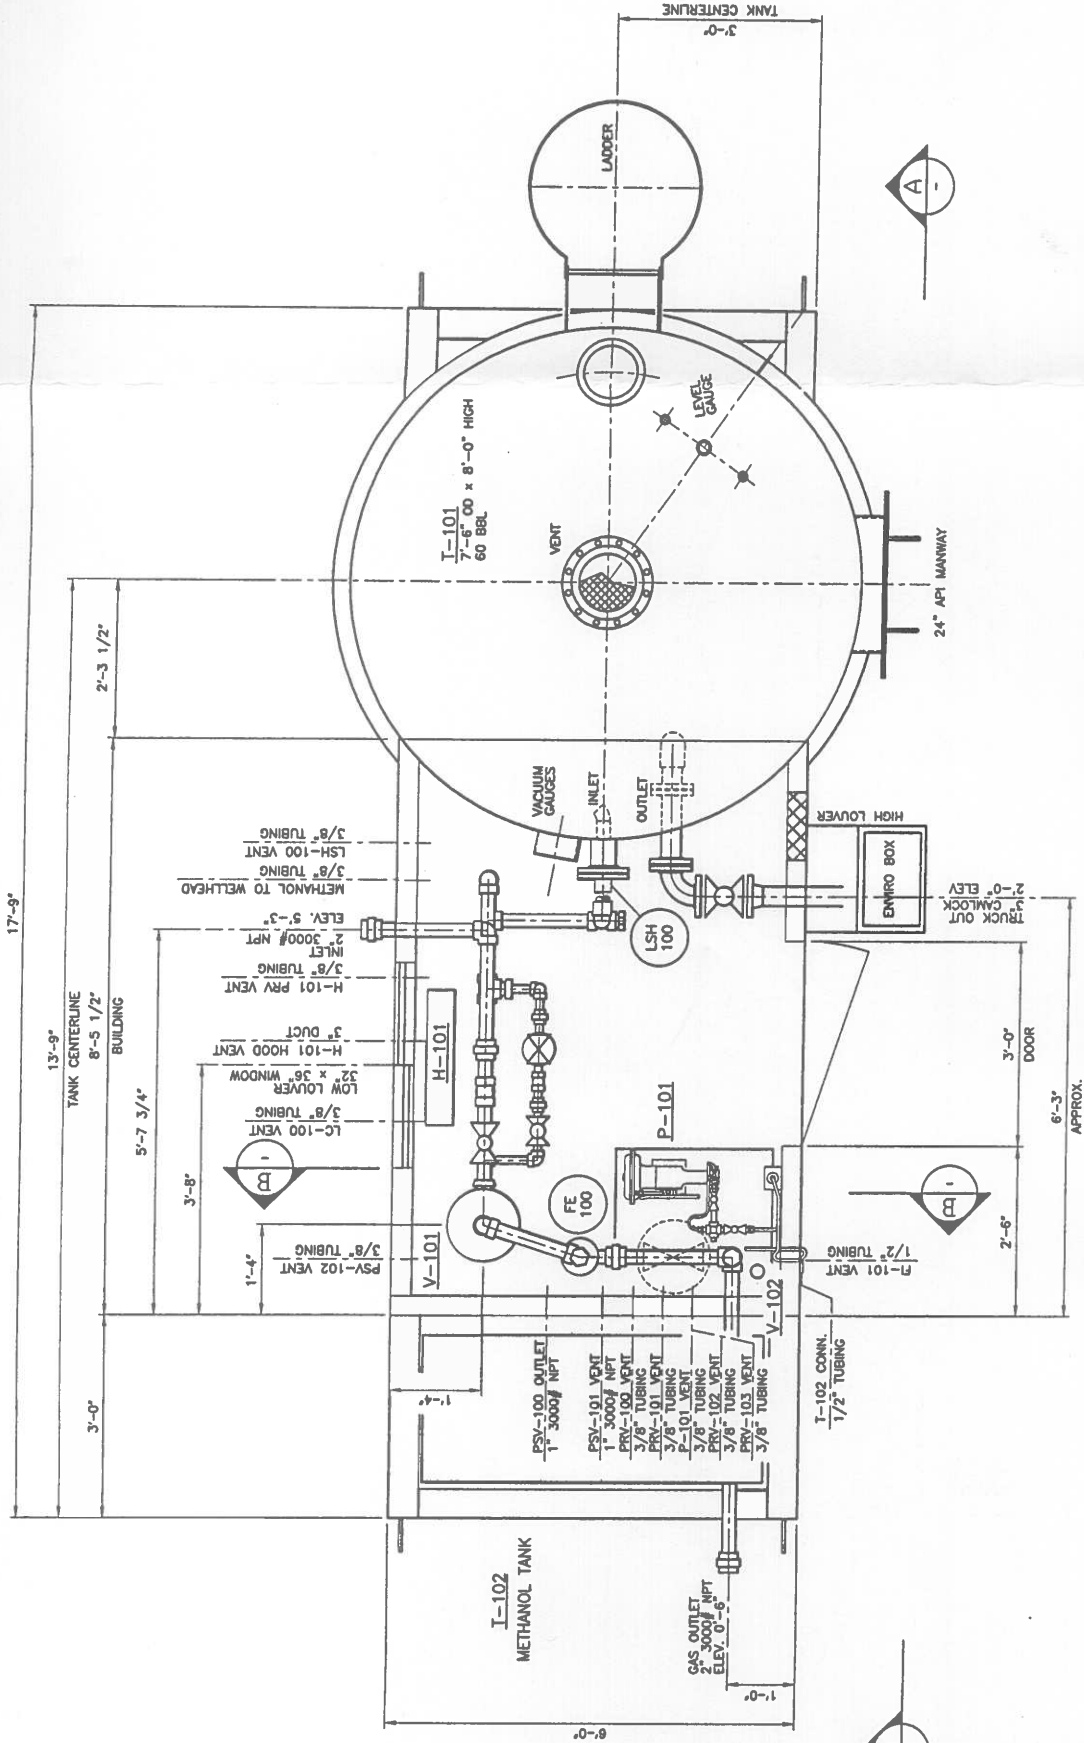

GENERAL NOTES:


- 1) REFERENCE ELEVATION TOP OF CHECKER PLATE.
- 2) TOTAL DEPTH OF SKID INCLUDING 1/16" CHECKER PLATE: 8 5/16"
- 3) LOW VENT TO BE LOCATED DIRECTLY UNDER 10'-200 AND TO BE 6" OFF THE FLOOR.
- 4) SHOP TO PROVIDE DRIP PAN AROUND PUMP (P-101).
- 5) SHOP TO APPLY 2 1/2" THK FIRE RETARDANT URETHANE FOAM INSULATION TO UNDERSIDE OF CHECKERPLATE.

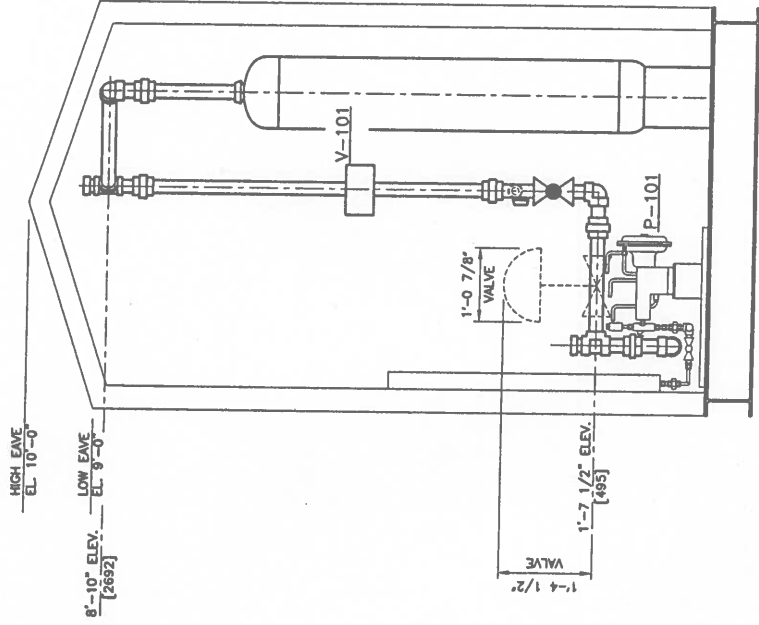

AS BUILT
APR 22 2011

(45) REQUIRED

TOTAL APPROX. SHIPPING WEIGHT: 9000 LBS
TOTAL APPROX. SHIPPING DIMENSIONS: 19'-0" LG x 8'-6" WIDE x 10'-10" HIGH.

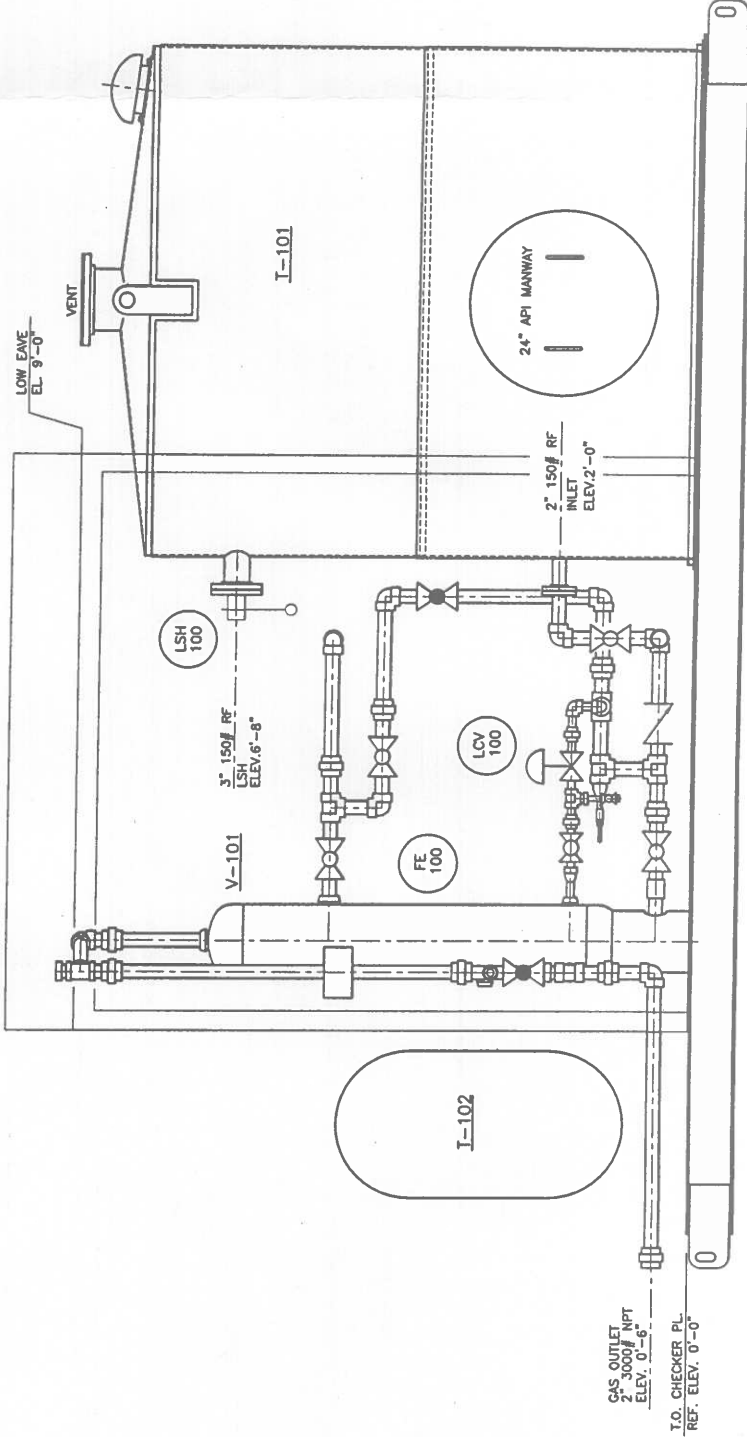

GAS OUTLET
2" 3000# NPT
ELEV. 0'-6"

I.O. CHECKER PL.
REF. ELEV. 0'-0"

--	--	