

M-310
NATURAL GAS ENGINE


Manufacturer: CATERPILLAR
 Model: 3306NA
 145hp / 125hp USABLE
 Naturally Aspirated 6 Cylinder

C-520
ENGINE WATER JACKET

Manufacturer: GLOBAL HEAT TRANSFER
 Model: GLB 7400

T-710
ENGINE OIL DAY TANK

Manufacturer: ENERFLEX-STETTLER
 Size: 20 gal.
 Part: OS-57

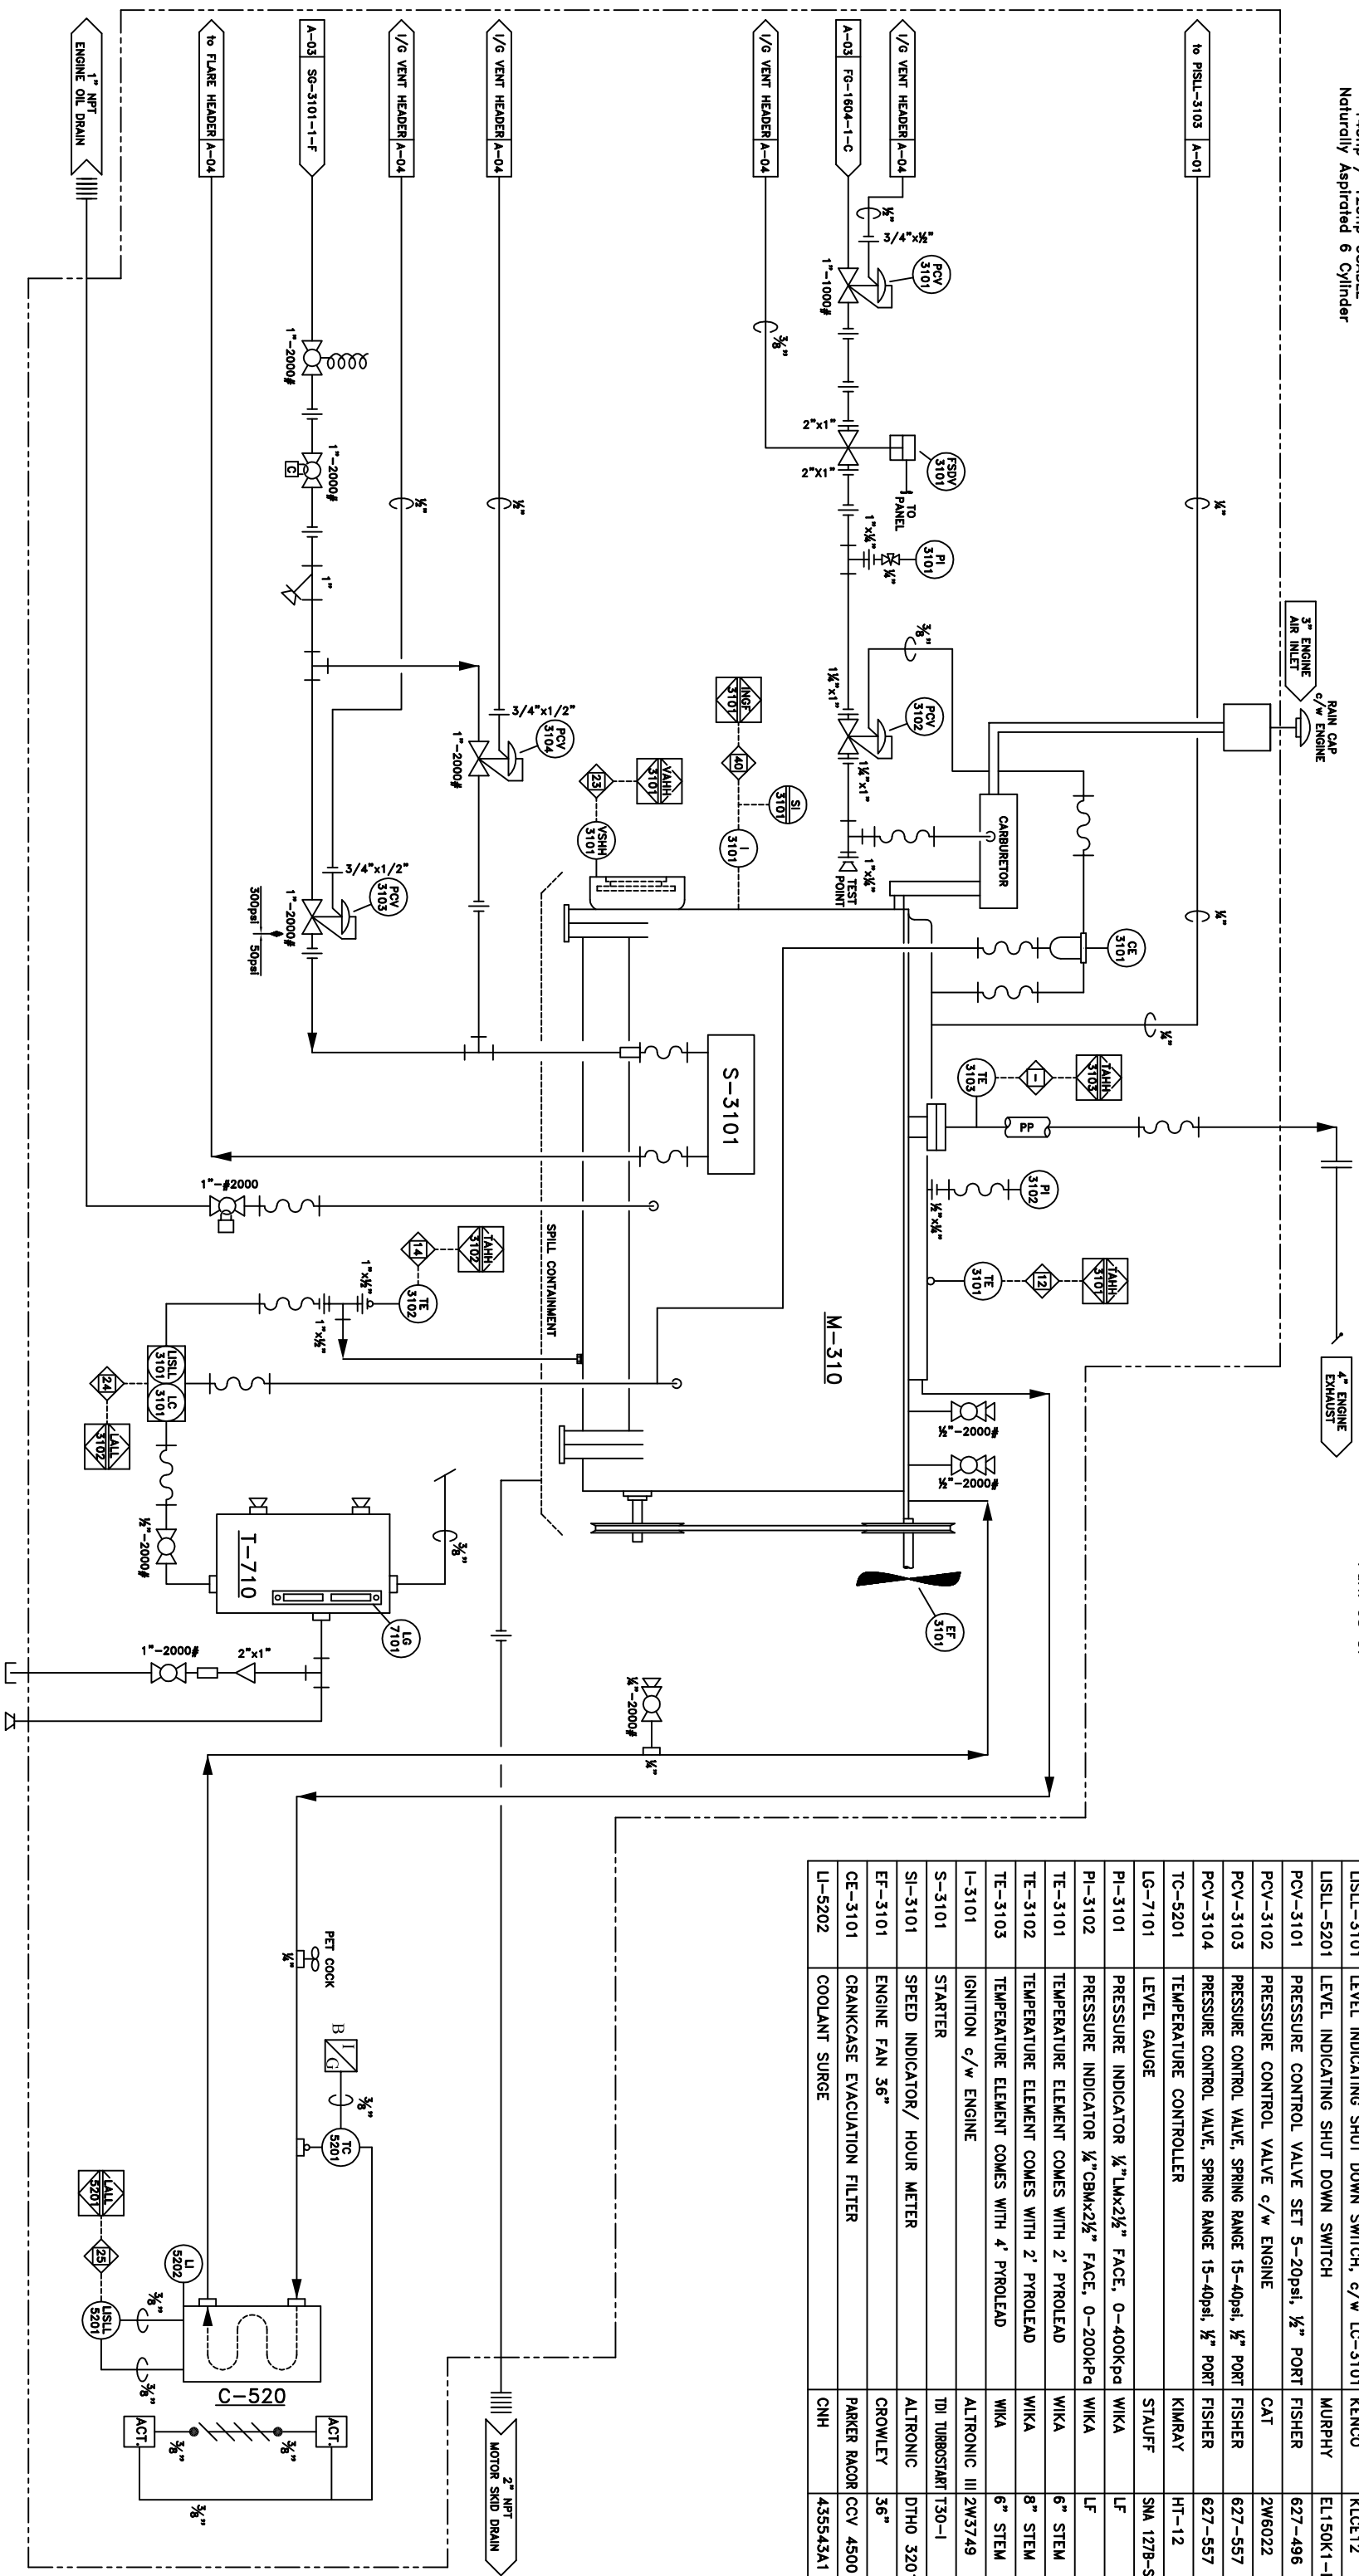

MATERIAL LIST

ITEM	DESCRIPTION	MAKE	MODEL
FSDV-3101	FUEL SHUT DOWN VALVE	MURPHY	M5081-C
VSHH-3101	VIBRATION SWITCH HIGH	MURPHY	VS-2E
LSLL-3101	LEVEL INDICATING SHUT DOWN SWITCH, c/w LC-3101	KENCO	KLCE12
LSLL-5201	LEVEL INDICATING SHUT DOWN SWITCH	MURPHY	EL150K1-E
PCV-3101	PRESSURE CONTROL VALVE SET 5-20psi, 1/2" PORT	FISHER	627-496
PCV-3102	PRESSURE CONTROL VALVE c/w ENGINE	CAT	2W6022
PCV-3103	PRESSURE CONTROL VALVE, SPRING RANGE 15-40psi, 1/2" PORT	FISHER	627-557
PCV-3104	PRESSURE CONTROL VALVE, SPRING RANGE 15-40psi, 1/2" PORT	FISHER	627-557
TC-5201	TEMPERATURE CONTROLLER	KIMRAY	HT-12
LG-7101	LEVEL GAUGE	STAUFF	SMA 127B-ST-12
PI-3101	PRESSURE INDICATOR 1/2" LMx2 1/2" FACE, 0-400KPa	WIKA	LF
PI-3102	PRESSURE INDICATOR 1/2" CBMx2 1/2" FACE, 0-200KPa	WIKA	LF
TE-3101	TEMPERATURE ELEMENT COMES WITH 2' PYROLEAD	WIKA	6" STEM
TE-3102	TEMPERATURE ELEMENT COMES WITH 2' PYROLEAD	WIKA	8" STEM
TE-3103	TEMPERATURE ELEMENT COMES WITH 4' PYROLEAD	WIKA	6" STEM
I-3101	IGNITION c/w ENGINE	ALTRONIC III	2W3749
S-3101	STARTER	TDI TURBOSTART	T30-1
SI-3101	SPEED INDICATOR/ HOUR METER	ALTRONIC	DTHO 3201
EF-3101	ENGINE FAN 36"	CROWLEY	36"
CE-3101	CRANKCASE EVACUATION FILTER	PARKER RACOR	CCV 4500
LI-5202	COOLANT SURGE	CNH	435543A1

LINE TYPE LEGEND

	PROCESS TUBING/ INSTRUMENT SUPPLY
	MAIN PROCESS GAS
	SECONDARY PROCESS
	UTILITY PROCESS
	PNEUMATIC SIGNAL
	HYDRAULIC SIGNAL
	ELECTRIC SIGNAL

REV.	DESCRIPTION	DATE	BY	CHKD	APPD
1	AS BUILT	06-06-12	CAJ	ENG	
0	ISSUED FOR CONSTRUCTION	06-02-07	WST	SE	

ENERFLEX

5221-46th St. Stirling, Alberta
 Box 1450, T0C 2L2
 Phone: 403.742.5538
 Fax: 403.742.5539

7400 SERIES COMPRESSOR
 G.D. SSM w/ 3306 NA ENGINE
 TRAILER MOUNTED, SOUR SERVICE

COMPANY: PETRO CANADA
 JOB NO.: 74162

Drawn by: ASR
 Checked by:
 Approved by:
 DATE: 06-02-07
 SCALE: N.T.S.
 DRAWING NO.: CDL-74162-A-05
 REV.: 1