


NOTE:
ANY ITEMS SHOWN IN RED ARE TO BE ADDED AS A RETRO-FIT

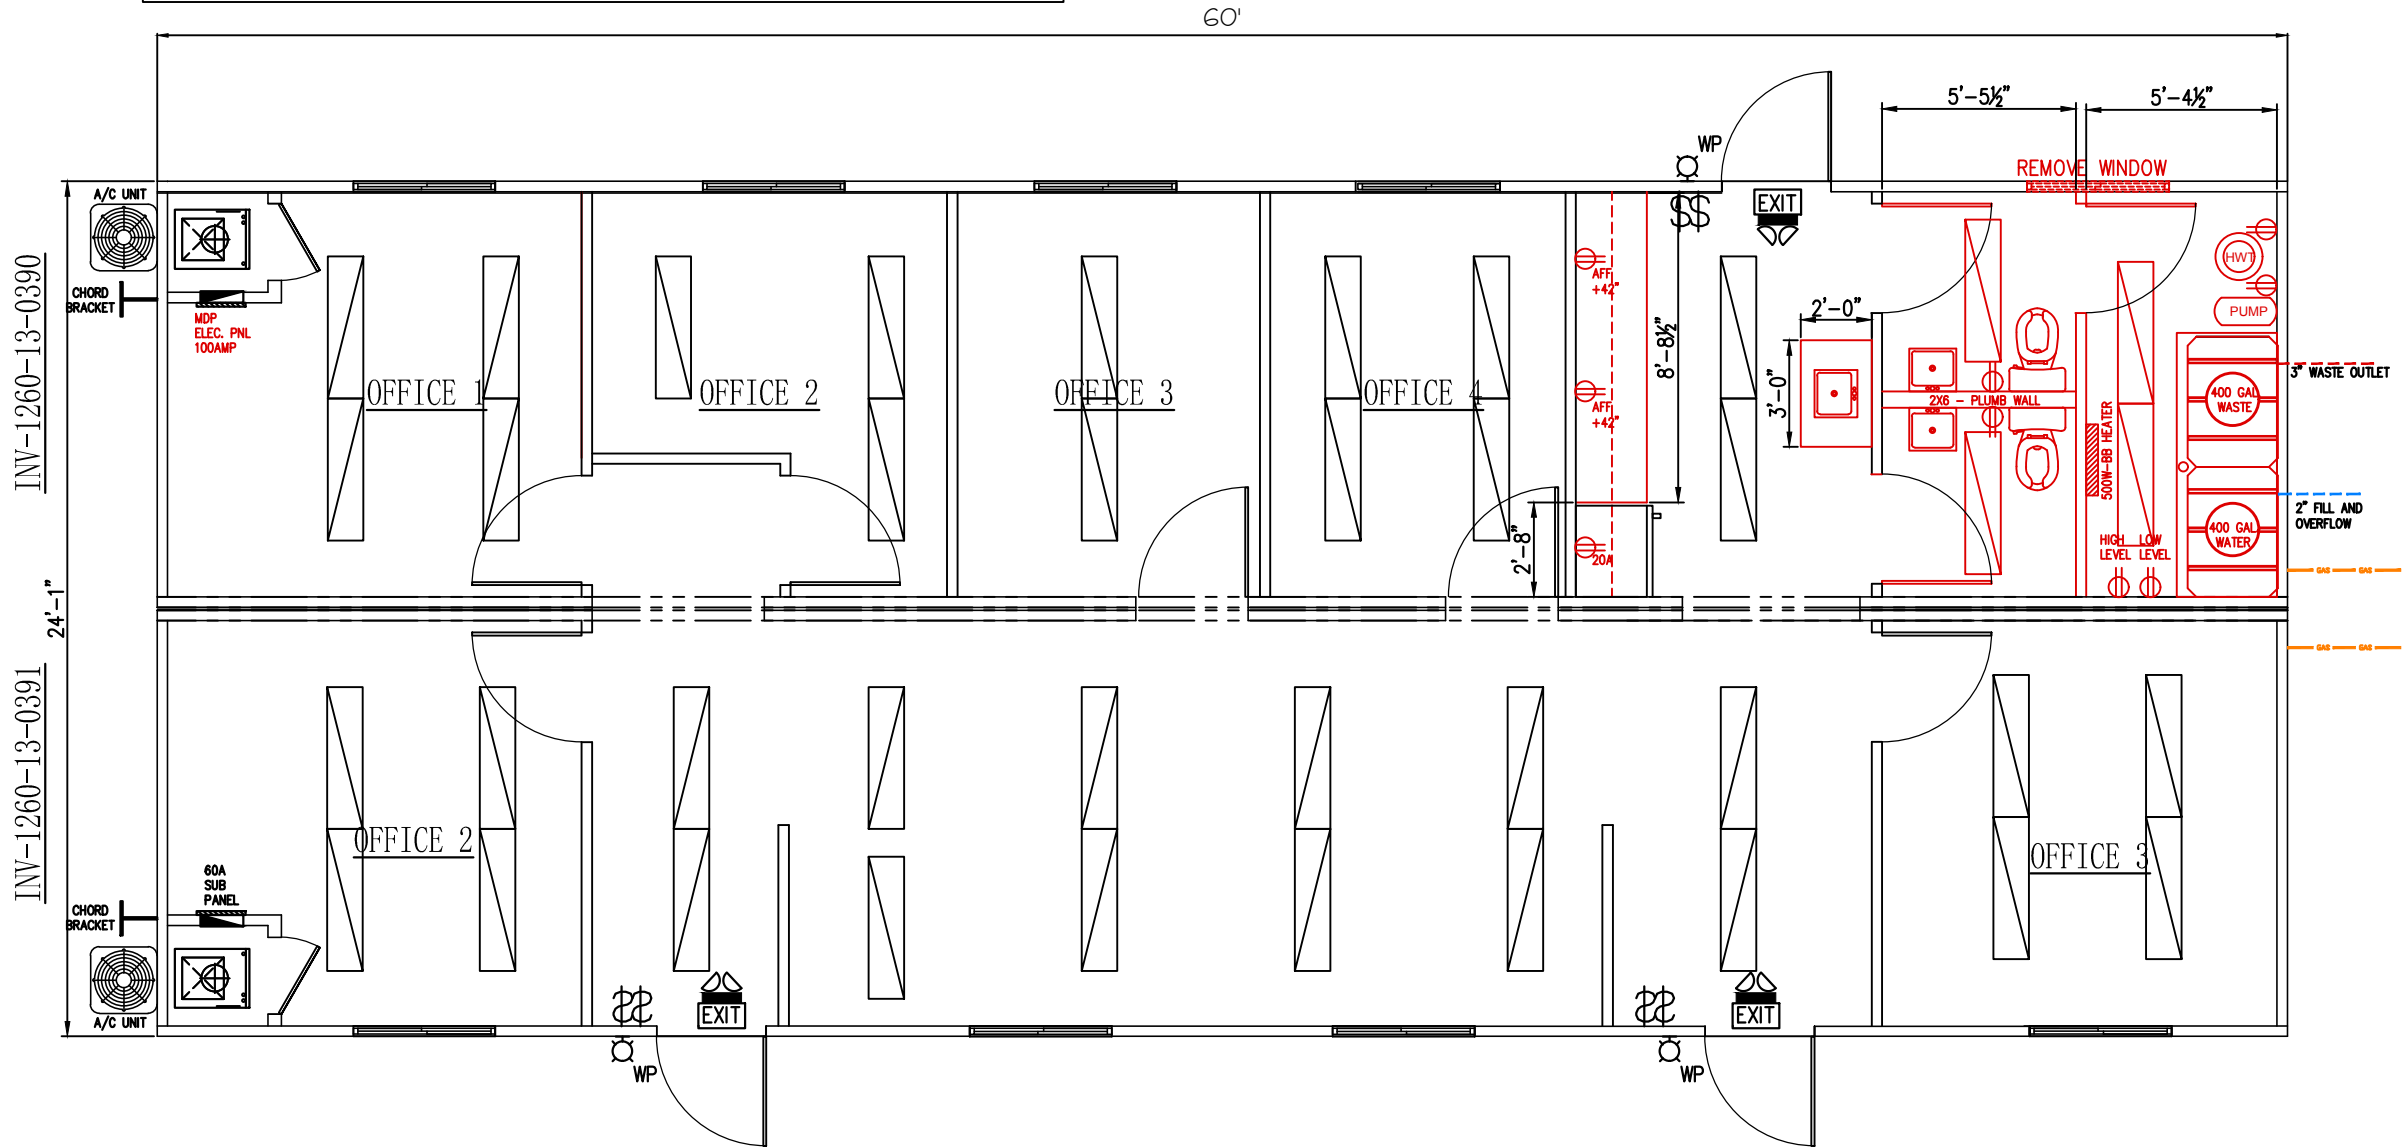

COPYRIGHT RESERVED
This drawing, design and related documents are the exclusive property of SENTAG Reproduction by any means, in whole or in part, for any purpose, is not permitted without the prior written consent of SENTAG TRAILER MANUFACTURING INC.
Electronic copies of this design and related drawings are the sole property of SENTAG TRAILER MANUFACTURING INC. and shall not be used or modified in any way without the prior written consent of SENTAG TRAILER MANUFACTURING INC.
This drawing is not intended to be used for construction until issued for that purpose by the Owner. Prior to commencement of the Work, the Contractor shall verify all dimensions, datums and levels to identify any errors or omissions; ascertain any discrepancies between this drawing and the full Contract Documents; and, bring these items to the attention of the Owner for clarification.
Drawings are not to be scaled.

APPROVAL STAMPS

REVISIONS

SERIAL #:
PROJECT TITLE:
SUBLATUS
24 X 60 – EXISTING UNIT
OFFICE COMPLEX
RETRO-FIT

TITLE: FLOOR PLAN
DRAWN BY: SS
CHKD BY: X
DWG #: A101
DATE: DEC-5-2018
SCALE:
REV