




PEMBINA - MIPA 8
2-13-48-8 W5M
2-13 POLYMER INJECTION SKID
MECHANICAL DRAWINGS
PROJECT # 2136

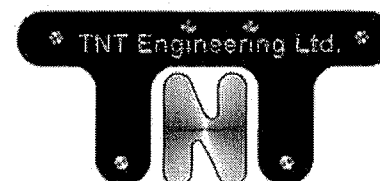

TNT ENGINEERING LTD.
SUITE 600, 639 - 5TH AVE SW
CALGARY, AB, T2P 0M9
PHONE (403) 387-2500
FAX (403) 387-2535



DRAWING INDEX

STRIKE AREA	SURFACE LOCATION	BOTTOM HOLE LOCATION	DRAWING	DRAWING TYPE	COMMENTS	REV.
PEMBINA - MIPA 8	02-13-048-08 W5M	-	-	COVER PAGE	2-13 POLYMER INJECTION SKID	-
PEMBINA - MIPA 8	02-13-048-08 W5M	-	1723D-1000	PLOT PLAN	2-13 SATELLITE (DEMOLITION DRAWING)	A
PEMBINA - MIPA 8	02-13-048-08 W5M	-	1723-1000	PLOT PLAN	2-13 SATELLITE	6
-	-	-	-	ARC RESOURCES LTD. PIPING SPECIFICATION NOTES	ASME PIPING SPECIFICATIONS NOTES	01
-	-	-	-	ARC RESOURCES LTD. PIPING SPECIFICATION	ASME PIPING CLASS D	01
PEMBINA - MIPA 8	02-13-048-08 W5M	-	0213048085.1500/01	LINE LIST	ARC 2-13 POLYMER INJECTION SKID	A
-	-	-	-	TNT ENGINEERING LTD. SYMBOL SHEET	TYPICAL FLOW SHEET SYMBOLS AND STANDARDS	D
PEMBINA - MIPA 8	02-13-048-08 W5M	-	0213048085.2100/01	PIPING AND INSTRUMENTATION DIAGRAM	2-13 POLYMER INJECTION SOUTH HEADER	A
PEMBINA - MIPA 8	02-13-048-08 W5M	-	0213048085.2101D/01	PIPING AND INSTRUMENTATION DIAGRAM	2-13 POLYMER INJECTION NORTH HEADER (DEMOLITION DRAWING)	A
PEMBINA - MIPA 8	02-13-048-08 W5M	-	0213048085.2101/01	PIPING AND INSTRUMENTATION DIAGRAM	2-13 POLYMER INJECTION NORTH HEADER	0
PEMBINA - MIPA 8	02-13-048-08 W5M	-	0213048085.2102/01	PIPING AND INSTRUMENTATION DIAGRAM	2-13 CDG POLYMER SKID	0
-	-	-	TYP.PEMBINA.2010/02	TYPICAL WELLHEAD DRAWING	CDG WATER INJECTION WELLHEAD AREA	0
PEMBINA - MIPA 8	02-13-048-08 W5M	-	14103-200	VENDOR - FABTECH	ARC EOR FACILITIES	D
PEMBINA - MIPA 8	02-13-048-08 W5M	-	14103-201	VENDOR - FABTECH	ARC EOR FACILITIES	D
PEMBINA - MIPA 8	02-13-048-08 W5M	-	14103-202	VENDOR - FABTECH	ARC EOR FACILITIES	D
PEMBINA - MIPA 8	02-13-048-08 W5M	-	14103-203	VENDOR - FABTECH	ARC EOR FACILITIES	D
PEMBINA - MIPA 8	02-13-048-08 W5M	-	14103-204	VENDOR - FABTECH	ARC EOR FACILITIES	D
PEMBINA - MIPA 8	02-13-048-08 W5M	-	14103-100 SHEET 1 OF 8	VENDOR - FABTECH	POLYMER PILOT INJECTION PLANT - BUILDINGS & SKID ASSEMBLY	C
PEMBINA - MIPA 8	02-13-048-08 W5M	-	14103-100 SHEET 2 OF 8	VENDOR - FABTECH	POLYMER PILOT INJECTION PLANT - BUILDINGS & SKID ASSEMBLY	C
PEMBINA - MIPA 8	02-13-048-08 W5M	-	14103-100 SHEET 3 OF 8	VENDOR - FABTECH	POLYMER PILOT INJECTION PLANT - BUILDINGS & SKID ASSEMBLY	C
PEMBINA - MIPA 8	02-13-048-08 W5M	-	14103-600 SHEET 1 OF 3	VENDOR - FABTECH	POLYMER PILOT INJECTION PLANT - SKID	2
PEMBINA - MIPA 8	02-13-048-08 W5M	-	14103-600 SHEET 2 OF 3	VENDOR - FABTECH	POLYMER PILOT INJECTION PLANT - SKID	2
PEMBINA - MIPA 8	02-13-048-08 W5M	-	14103-600 SHEET 3 OF 3	VENDOR - FABTECH	POLYMER PILOT INJECTION PLANT - SKID	2
PEMBINA - MIPA 8	02-13-048-08 W5M	-	STR-001	VENDOR - BLACK BOX ENGINEERED SOLUTIONS	PEMBINA POLYMER BUILDING - PILE LOCATION PLAN	0
PEMBINA - MIPA 8	02-13-048-08 W5M	-	STR-002	VENDOR - BLACK BOX ENGINEERED SOLUTIONS	PEMBINA POLYMER BUILDING - PILING NOTES AND DETAILS	0

DRAWING SHEET SIZE: 11" x 17"



- ① TEST/GROUP SEPARATOR BUILDING
- ② WATER INJECTION BUILDING
- ③ STORAGE TANK
- ④ MCC BUILDING
- ⑤ NEW TEST/GROUP SEPARATOR BUILDING
- ⑥ NEW FLARE KNOCK OUT TANK
- ⑦ NEW FLARE STACK
- ⑧ POLYMER HYDRATION SKID


IAC	 OIL	ARC RESOURCES	IAC	 OIL	ARC RESOURCES
OWNER		ARC RESOURCES	OWNER		ARC RESOURCES
SIZE		80 9mm	SIZE		80 9mm
WT		5.8mm	WT		5.8mm
SPEC		CSA 2662	SPEC		CSA 2662
MIRL		FRP 2000	MIRL		FRP 2000
M @ P		4560 MPaG	M @ P		4560 MPaG
FROM		13-12-048-08 WSM	FROM		13-12-048-08 WSM
TO		02-13-048-08 WSM	TO		02-13-048-08 WSM
LICENSE		TBA	LICENSE		TBA
LINE NO		TBA	LINE NO		TBA
HYDRO		6250 MPa	HYDRO		6250 MPa
X-RAY		NO	X-RAY		NO
INT. CTC		---	INT. CTC		---
EXT. CTC		---	EXT. CTC		---
MIN. CVR		1500mm (NOTE 1)	MIN. CVR		1500mm (NOTE 1)

A		B	
TAG	GR	TAG	GR
QWKSZ?	ARC	OWNER	ARC
SIZE	80 9mm	SIZE	80 9mm
W.T.	4.0mm	W.T.	4.0 mm
SPEC	CSA 2662	SPEC	CSA 2662
MTRL	2245.1 GR. 290 CAT. 1	MTRL	2245.1 GR. 290 CAT
M.O.P	6900 kPog	M.O.P	6900 kPog
FROM	01-13-048-08 WSM	FROM	05-13-048-08 WSM
TO	02-13-048-08 WSM	TO	02-12-048-08 WSM
LICENSE	TBA	LICENSE	TBA
LINE NO	TBA	LINE NO	TBA
HYDRS	7750 kPog	HYDRS	7750 kPog
X-RAY	15%	X-RAY	15%
INT. CTC		INT. CTC	
EXT. CTC	Y41	EXT. CTC	Y41
MEN. CEN	1500mm	MEN. CVR	1500mm

"AS-BUILT" REVISION NUMBER 4 IS BASED ON MARK-UPS PROVIDED BY OTHERS. VERIFICATION THAT CONSTRUCTION IS IN ACCORDANCE WITH THE DRAWINGS HAS NOT BEEN DONE.



TNT IS RESPONSIBLE FOR LATEST
REVISION AND CLOUDED AREAS ONL

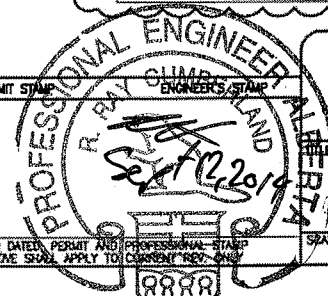

PEMBINA
LSD: 02-13-048-08 W5M
02-13 SATELLITE
PLOT PLAN

SCALE: 1:600 (A1 Size)

FILE NO. 1723D-1000 REV.

[illegible]


NOTES :

1. 1800mm MIN. COVER UNDER LEASE AREA,
1500mm MIN COVER UNDER P/L ROW
EXCEPT WHEN P/L CROSSES UNDER LEASE
ACCESS ROAD, THEN 2000mm MIN. COVER
IS REQUIRED

[illegible]

PERMIT STAMP

IF SIGNED & DATED PERMIT AND PROFESSIONAL-SEAL
AFFIXED ABOVE SHALL APPLY TO CURRENT REV. ONLY

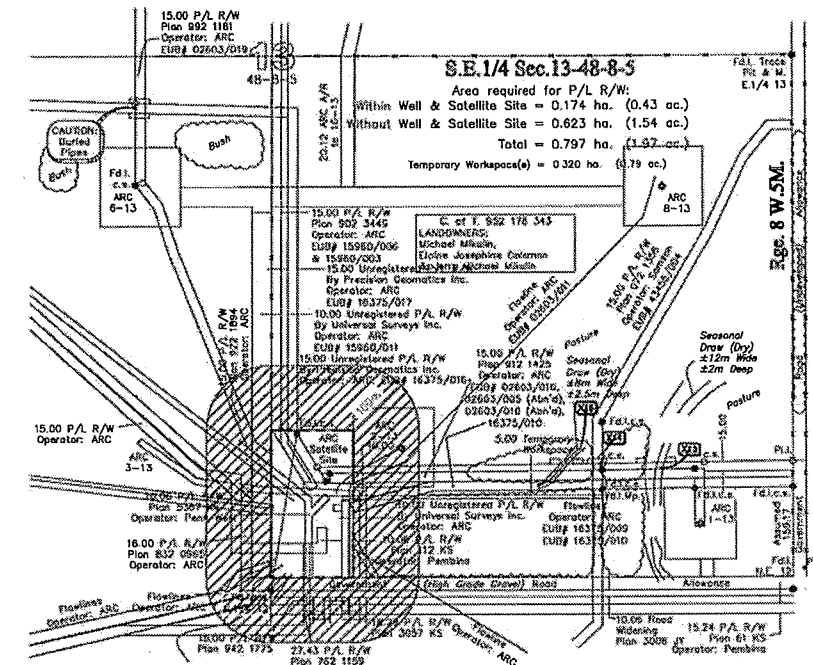


SITE PLAN
SCALE: 1:5000

- ① TEST/GROUP SEPARATOR BUILDING
- ② WATER INJECTION BUILDING
- ③ STORAGE TANK
- ④ MCC BUILDING
- ⑤ NEW TEST/GROUP SEPARATOR BUILDING
- ⑥ NEW FLARE KNOCK OUT TANK
- ⑦ NEW FLARE STACK
- ⑧ POLYMER HYDRATION SKID

TAG		GIL	
A		B	
OWNER	ARC	OWNER	ARC
SIZE	88 9mm	SIZE	88 9mm
W T	4 6mm	W T	4 6mm
SPEC	CSA 2662	SPEC	CSA 2662
MIRL	2245 I CR 290 CAT 1	MIRL	2245 I CR 290 CAT 1
MOP	6900 kPaG	MOP	6900 kPaG
FROM	01-13-048-08 WSM	FROM	01-13-048-08 WSM
TO	02-13-048-08 WSM	TO	02-12-046-06 WSM
LICENSE	TBA	LICENSE	TBA
DATE NO	108	DATE NO	TBA
HYDRO	7750 kPaG	HYDRO	7750 kPaG
X-RAY	15%	X-RAY	15%
INT. CTG	-	INT. CTG	-
EXT. CTG	YJ1	EXT. CTG	YJ1
INS. OVER	15000mm	INS. OVER	15000mm

"AS-BUILT" REVISION NUMBER 4 IS BASED ON MARK-UPS PROVIDED BY OTHERS. VERIFICATION THAT CONSTRUCTION IS IN ACCORDANCE WITH THE DRAWINGS HAS NOT BEEN DONE

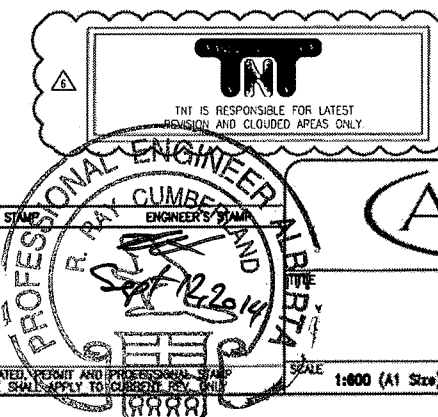

PEMBINA
LSD: 02-13-048-08 W5M
02-13 SATELLITE
PLOT PLAN

SCALE 1:600 (A1 Size) FILE NO. 1723-1000 REV. 6

SPEC N
REVISION 01
DATE July 18, 2007

ASME PIPING SPECIFICATIONS
NOTES

The following NOTES apply to all ASME Piping Specifications	
1	corrosion allowances for threaded connections are reduced if utilizing minimum of Sch 80. threaded connections not recommended in vibrating or sour service applications
2	short radius elbow and returns shall not be used unless they satisfy the specification of the pipe and pressure rating restrictions imposed by ASME B16.28, Paragraph 2 (derated to 80% max. allowable stress value)
3	forged steel fitting to ASME B16.11
4	buttwelding fitting to ASME B16.9
5	forged C.S. branch outlet fittings to MSS SP-97
6	swage(d) nipples and bull plugs to MSS SP-95
7	steel pipe unions to MSS SP-83
8	blanks to API Std. 590
9	all valves shall meet ASME B16.34 requirements
10	for > 1/2" all thickness pipe and fittings A 106 B / A 234 WPB require additional testing to meet ASME B31.3 requirements for MDMT. A 333 6 / A 420 WPL6 are acceptable alternatives (as applicable) to meet MDMT requirements
11	use PWHT for production welds if WPS was qualified with PWHT to control hardness. Evidence of hardness control consisting of third party inspections on sample welds shall be included in the contractor's quality control manual. In particular, all weld procedures for sour piping systems must demonstrate that the weld metal, heat affected zone and parent metal through-thickness hardness levels will not exceed 22 HRC or 200 HBW (at 500 kg) as defined in NACE MR0175. Welds that do not comply with the above requirements or that do not have evidence of hardness control must be post-weld heat treated
12	on calculated pipe wall thicknesses, fitting wall thickness to match calculated pipe value
13	trunnion mounted ball valve
14	in sour service CSA Z662 applications, materials shall conform to the applicable CSA specification - that is: CSA Z245.1, Section 16 for linepipe - CSA Z245.11, Section 13 for fittings - CSA Z245.12, Section 13 for flanges - CSA Z245.15, Section 13 for valves - NACE approved fittings, flanges and valves meet the corresponding CSA code - it is acceptable to utilize NACE approved pipe provided that the microhardness is confirmed at a maximum of 248 Vickers
15	Low Temperature refers to systems based on A333-6 pipe (L and SL series) and is restricted by the A352 LCB flanges on the valves .
16	SFRF= Slip-on Flange Raised Face, TFRF = Threaded Flange Raised Face To be used in "Sweet Service" 150 and 300 ANSI Only
17	Stud length must accommodate nut and at a minimum 2 exposed threads on each end
18	Consult Asset Integrity Group for correct material selection. Valves with specific corrosion resistant properties may be required
SPEC ANSI Rating A= 150 B= 300 C= 600 D= 900 E= 1500	



SPEC D ASME PIPING SPECIFICATIONS
REVISION 01
DATE July 18, 2007

SERVICE:	SWEET HYDROCARBONS		ANSI CLASS:	900 RTJ
DESIGN PRESSURE:	15,307 kPag (2,220 psig) @ 38 C (100 F)		CODE:	ASME B31.3
TEST PRESSURE:	22,960 kPag (3,330 psig)			
TEMPERATURE LIMITS:	-29 to 149 C (-20 to 300 F)	RATING:	ASME/ANSI B16.5	
CORROSION ALLOWANCE:	1.6 mm	PWHT:	if pipe wall thickness > 19 mm - see Note 11 also	
NDT:	Visual, 100% of all butt welds to be 100% radiographed			

GENERAL: see ASME PIPING SPECIFICATON 'N' for a description of relevant NOTES
PV&F Specs not to be used for amine, cryogenic, CO2, acid gas, caustic, HVP or LPG services.

	NPS	RATING	CONN	DESCRIPTION	NOTES
	1/2 to 1 1/2	Sch 160	SW / Scrd	ASTM A 106 B (SMLS) PE / TBE	
	2, 3	Sch 80	BW	ASTM A 106 B (SMLS) BE	
	4 to 12	Sch 120 min. (calc WT & MDMT)	BW	ASTM A 106 B (SMLS) BE	10

FITTINGS					
ITEM	NPS	RATING	CONN	DESCRIPTION	NOTES
CAP	1/2 to 1 1/2	Class 6000	Scrd	ASTM A 105	3
	2, 3	Sch 80	BW	ASTM A 234 WPB	4
	4 to 6	Sch 120 min.	BW	ASTM A 234 WPB	4, 10, 12
COUPLING	1/2 to 1 1/2	Class 6000	Scrd	ASTM A 105, full & half	3
CROSS	1/2 to 1 1/2	Class 6000	Scrd	ASTM A 105	3
ELBOW	1/2 to 1 1/2	Class 6000	Scrd	ASTM A 105, 45 & 90	3
	2, 3	Sch 80	LRBW	ASTM A 234 WPB, 45 & 90, straight & reducing	2, 4
	4 to 6	Sch 120 min.	LRBW	ASTM A 234 WPB, 45 & 90, straight & reducing	2, 4, 10, 12
ELBOLET	1/2 to 1 1/2	Class 6000	Scrd	ASTM A 105	5
FLANGE	2, 3	Class 900	RTJWN	ASTM A 105, bored to Sch 80 pipe	
	4 to 6	Class 900	RTJWN	ASTM A 105, bored to Sch 120 min. pipe	10, 12
NIPPLE	1/2 to 1 1/2	Sch 160	Scrd	ASTM A 106 B (SMLS), 100 mm long min, TBE	
REDUCER	2, 3	Sch 80	BW	ASTM A 234 WPB, concentric / eccentric	4
	4 to 3	Sch 120 min.	BW	ASTM A 234 WPB, concentric / eccentric	4, 10, 12
SOCKOLET	1/2 to 1 1/2	Class 6000	SW	ASTM A 105	5
SWAGE	1/2 to 1 1/2	Sch 160	Scrd or PE	ASTM A 105 or A 106 B (SMLS), match pipe & conn	6
TEE	1/2 to 1 1/2	Class 6000	Scrd	ASTM A 105	3
	2, 3	Sch 80	BW	ASTM A 234 WPB, straight & reducing	4
	4 to 6	Sch 120 min.	BW	ASTM A 234 WPB, straight & reducing	4, 10, 12
THREADOLET	1/2 to 1 1/2	Class 6000	Scrd	ASTM A 105	5
UNION	1/2 to 1 1/2	Class 6000	Scrd	ASTM A 105	7
WELDOLET	2, 3	Sch 80	BW	ASTM A 105	5
	4	Sch 120 min.	BW	ASTM A 105	5, 10, 12

VALVES					
ITEM	NPS	RATING	CONN	DESCRIPTION	NOTES
BALL	≤ 1 1/2	WOG 4000	Scrd	A 105 body, cr. plated trim, 4000 # to API 607	9
	2	Class 900	RTJ	WCB body, cr. plated trim to API 607, lever op	9
	3 to 6	Class 900	RTJ	WCB body, cr. plated trim to API 607, gear op ≥ 3"	9, 13
CHECK	≤ 1 1/2	Class 1500	Scrd	A 105 body, trim No. 8 to API 602	9
	2 to 6	Class 900	RTJ	WCB body, trim No. 8 to API 600	9
GATE	≤ 1 1/2	Class 1500	Scrd	A 105 body, trim No. 8 to API 602, handwheel	9
	2 to 6	Class 900	RTJ	WCB body, trim No. 8 to API 600, gear op ≥ 4"	9
GLOBE	≤ 1 1/2	Class 1500	Scrd	A 105 body, trim No. 8 to API 602, handwheel	9
	2 to 6	Class 900	RTJ	WCB body, trim No. 8 to API 600, gear op ≥ 4"	9
NEEDLE	1/2 to 3/4	Class 6000	Scrd	A 105 body & 316 SS trim	9

MISCELLANEOUS					
ITEM	NPS	RATING	CONN	DESCRIPTION	NOTES
BLIND	2 to 6	Class 900	RTJ	ASTM A 105	8
GASKET	2 to 6	Class 900	RTJ	soft iron oval ring, ANSI B16.20	
NUTS				ASTM A 194 2H, heavy hexagon	
STUD				ASTM A 193 B7, threaded full length	17
PLUG	1/2 to 1 1/2	Sch XXS	Scrd	Bull, ASTM A 105 or A 106 B (SMLS)	6
	1/2 to 1 1/2	Class 6000	Scrd	Hex Head, ASTM A 105	3

[illegible]

INSTRUMENTATION TABLE

FIRST LETTER	INITIATING OR MEASURED VARIABLE	CONTROLLERS			READOUT DEVICES			SWITCHES					ALARM DEVICES					TRANSMITTER			SOLENOID, RELAYS COMPUTING DEVICES	PRIMARY ELEMENT	TEST POINT	WELL OR PROBE	VIEW DEVICE. GLASS	SAFETY DEVICE	FINAL ELEMENT
		RECORDER	INDICATOR	BLIND	SELF ACTUATED CONTROL VALVE	RECORDER	INDICATOR	HIGH	HIGH HIGH (SHUTDOWN)	LOW	LOW LOW (SHUTDOWN)	COMBINATION	HIGH	HIGH HIGH (SHUTDOWN)	LOW	LOW LOW (SHUTDOWN)	COMBINATION	RECORDER	INDICATOR	BLIND							
A	ANALYSIS	ARC	AIC	AC		AR	AI	ASH	ASHH	ASL	ASLL	ASHL	AAH	AAHH	AAL	AALL	AAHL	ART	AIT	AT	AY	AE	AP	AW		AV	
B	BURNER	BRC	BIC	BC		BR	BI	BSH	BSHH	BSL	BSLL	BSHL	BAH	BAHH	BAL	BALL	BAHL	BRT	BIT	BT	BY	BE		BW	BG		
C	USERS CHOICE																										
D	USERS CHOICE																										
E	VOLTAGE	ERC	EIC	EC		ER	EI	ESH	ESHH	ESL	ESLL	ESHL	EAH	EAHH	EAL	EALL	EAHL	ERT	EIT	ET	EY	EE					
F	FLOW	FRC	FIC	FC	FCV,FCV	FR	FI	FSH	FSHH	FSL	FSL	FSLH	FAH	FAHH	FAL	FALL	FAHL	FRT	FIT	FT	FY	FE		FG			
FQ	FLOW QUANTITY	FQRC	FQIC	FQC		FQR	FQI	FQSH	FQSHH	FQSL	FQSL	FQSHL	FQAH	FQAHH	FQAL	FQALL	FQAHL	FQRT	FQIT	FQT	FQY	FQE			FQV		
FF	FLOW RATIO	FFRC	FFIC	FFC		FFR	FFI	FFSH	FFSHH	FFSL	FFSL	FFSHL	FFAH	FFAHH	FFAL	FFALL	FFAHL	FFRT	FFIT	FFT	FFY						
G	USERS CHOICE																										
H	HAND		HIC	HC								HS					HA										
I	CURRENT	IRC	IIC			IR	II	ISH	ISHH	ISL	ISLL	ISHL	IAH	IAHH	IAL	IALL	IAHL	IRT	IIT	IT	IY	IE					
J	POWER	JRC	JIC			JR	JI	JSH	JSHH	JSL	JSL	JSHL	JAH	JAHH	JAL	JALL	JAHL	JRT	JIT	JT	JY	JE					
K	TIME	KRC	KIC	KC	KCV	KR	KI	KSH	KSHH	KSL	KSL	KSHL	KAH	KAHH	KAL	KALL	KAHL	KRT	KIT	KT	KY	KE					
L	LEVEL	LRC	LIC	LC	LCV	LR	LI	LSH	LSHH	LSL	LSL	LSHL	LAH	LAHH	LAL	LALL	LAHL	LRT	LIT	LT	LY	LE		LG			
M	MOISTURE	MRC	MIC	MC		MR	MI	MSH	MSHH	MSL	MSL	MSHL	MAH	MAHH	MAL	MALL	MAHL	MRT	MIT	MT	MY	ME	MP				
N	USERS CHOICE																										
O	USERS CHOICE																										
P	PRESSURE, VACUUM	PRC	PIC	PC	PCV	PR	PI	PSH	PSHH	PSL	PSL	PSHL	PAH	PAHH	PAL	PALL	PAHL	PRT	PIT	PT	PY	PE	PP		PG	PSV,PSE	
PD	PRESSURE, DIFFERENTIAL	PDRC	PDIC	PDC	PDCV	PDR	PDI	PDSH	PDSHH	PDSL	PDSL	PDSHL	PDH	PDHH	PDAL	PDALL	PDHL	PDRT	PDIT	PDT	PDY						
Q	QUANTITY	QRC	QIC	QC		QR	QI	QSH	QSHH	QSL	QSL	QSHL	QAH	QAHH	QAL	QALL	QAHL	QRT	QIT	QT	QY						
R	RADIATION	RRC	RIC	RC		RR	RI	RSH	RSHH	RSL	RSL	RSHL	RAH	RAHH	RAL	RALL	RAHL	RRT	RIT	RT	RY		RW				
S	SPEED	SRC	SIC	SC		SR	SI	SSH	SSHH	SSL	SSL	SSLH	SAH	SAHH	SAL	SALL	SAHL	SRT	SIT	ST	SY	SE					
T	TEMPERATURE	TRC	TIC	TC	TCV	TR	TI	TSH	TSHH	TSL	TSL	TSHL	TAH	TAHH	TAL	TALL	TAHL	TRT	TIT	TT	TY	TE		TW	TG	TSE	
TD	TEMPERATURE, DIFFERENTIAL	TDRC	TDIC	TDC	TDV	TDR	TDI	TDSH	TDSHH	TDSL	TDSL	TDSHL	TDH	TDHH	TDAL	TDALL	TDHL	TDRT	TDIT	TDT	TDY	TDE		TDW			
U	MULTI-VARIABLE																			UY							
V	VIBRATION, MECH. ANALYSIS					VR	VI	VSH	VSHH	VSL	VSL	VSHL	VAH	VAHH	VAL	VALL	VAHL	VRT	VIT	VT	VY	VE					
W	WEIGHT FORCE	WRC	WIC	WC		WR	WI	WSH	WSHH	WSL	WSL	WSHL	WAH	WAHH	WAL	WALL	WAHL	WRT	WIT	WT	WY	WE					
WD	WEIGHT FORCE, DIFFERENTIAL	WDRC	WDIC	WDC		WDR	WDI	WDSH	WDSHH	WDSL	WDSL	WDSHL	WDAH	WDAHH	WDAL	WDALL	WDAHL	WDRT	WDIT	WDT	WDY	WDE					
X	UNCLASSIFIED																										
Y	EVENT STATE, PRESENCE		YIC	YC		YR	YI	YSH	YSHH	YSL	YSL		YAH	YAHH	YAL	YALL	YAHL			YT	YY	YE					
Z	POSITION	ZRC	ZIC	ZC		ZR	ZI	ZSH	ZSHH	ZSL	ZSL		ZAH	ZAHH	ZAL	ZALL	ZAHL	ZRT	ZIT	ZT	ZY	ZE					
ZD	GAUGING DEVIATION	ZDRC	ZDIC	ZDC		ZDR	ZDI	ZDSH	ZDSHH	ZDSL	ZDSL		ZDAH	ZDAHH	ZDAL	ZDALL	ZDAHL	ZDRT	ZDIT	ZDT	ZDY	ZDE					

INSTRUMENT SYMBOLS			
	DISCRETE INSTRUMENTS FIELD MOUNTED		INSTRUMENTS SHARING COMMON HOUSING
	DISCRETE INSTRUMENTS PRIMARY LOCATION	 }  }  }	INACCESSIBLE OR BEHIND THE PANEL DEVICES & FUNCTIONS USE THE SAME SYMBOL BUT WITH DASHED HORIZONTAL BARS
	DISCRETE INSTRUMENTS AUXILIARY LOCATION		PROGRAMMABLE LOGIC CONTROL (PLC) FIELD MOUNTED
	DISTRIBUTED CONTROL FIELD MOUNTED		PROGRAMMABLE LOGIC CONTROL (PLC) PRIMARY LOCATION
	DISTRIBUTED CONTROL PRIMARY LOCATION		PROGRAMMABLE LOGIC CONTROL (PLC) AUXILIARY LOCATION
	DISTRIBUTED CONTROL AUXILIARY LOCATION		
	COMPUTER FUNCTION FIELD MOUNTED		
	COMPUTER FUNCTION PRIMARY LOCATION		
	COMPUTER FUNCTION AUXILIARY LOCATION		
			PANEL MOUNTED PATCHBOARD POINT 12
			INTERLOCK
			PURGE
			RESET
			I.A. OR I.G. SUPPLY
			HORN
			CURRENT/ PNEUMATIC
			INDICATOR LIGHT
			BEACON

LINE NUMBERING	FACILITY EQUIPMENT NUMBERING
INSULATION THICKNESS AND DESIGNATION: 3-P-AS-001-38GT-IC NUMBER SPECIFICATION COMMODITY SIZE(IMPRIAL NPS) INTERNAL COATING H - HEAT CONSERVATION C - COLD CONSERVATION PP - PERSONAL PROTECTION ET - ELECTRICAL TRACE GT - GLYCOL TRACE HO - HOT OIL TRACE J - JACKETED ST - STEAM TRACE	EQUIPMENT NUMBERING STARTS WITH A LETTER CHOSEN FROM THE EQUIPMENT TAGS THAT BEST SUITS THE EQUIPMENT TO BE DESCRIBED. FOLLOWING THE EQUIPMENT TAG ARE THREE DIGIT CATEGORY NUMBER FROM THE EQUIPMENT NUMBERING LIST. EXAMPLE: E-315 EQUIPMENT (HEAT EXCHANGER) SERIAL NUMBERING (ASSIGNED TAG NUMBER)

EQUIPMENT TAGS	EQUIPMENT NUMBERING
A - AUXILIARY FACILITIES B - BLOWER OR FAN (PROCESS) BH - BUILDING HEATER C - CRUSHERS, MILLS & GRINDERS D - DRIVERS E - EXCHANGERS, AERIAL COOLERS, PLATE, SHELL & TUBE EXCH. F - FILTER SEPARATOR (PROCESS) FS - FLARE STACK G - GENERATOR, ELECTRIC, GAS OR TEG UNIT H - FIRED HEATER OR BOILER I - INCINERATOR J - CONVEYORS K - COMPRESSORS M - MIXERS & AGITATORS P - PUMPS R - REACTORS OR CONVERTER S - STORAGE T - TANKS V - VESSEL VS - VENT STACK Z - MISC. PACKAGES, METER SKIDS	100 SERIES VESSLS - SEPARATORS - PROPANE TANKS - F.G. SCRUBBERS - CHILLERS - CONTACTORS - SPHERES - BULLETS 200 SERIES PUMPS & COMPRESSORS - SCREW COMP. - RECIP. COMP. - I.A. COMP. - PUMPS 300 SERIES FIRED EQUIP. HEAT EXCHANGERS - LINE HEATERS - DEHY./AMINE REBOILERS - FIN COOLERS - SHELL & TUBE EXCHANGERS - PLATE EXCHANGERS - AERIAL COOLERS - BUILDING HEATERS 400 SERIES TANKS - WATER, OIL & DRAIN - METHANOL - CORROSION INHIBITOR - CHEMICAL 500 SERIES POWER SYSTEM/DRIVERS - TEG UNITS - SOLAR - GENERATORS - GAS/ELECTRIC MOTORS 600 SERIES MISCELLANEOUS - EXHAUST FANS - METER SKIDS 700 SERIES FLARE SYSTEM - FLARE STACK - FLARE KNOCK OUT DRUM - VENT STACK - INCINERATOR 800 SERIES FILTERS 900 SERIES USERS CHOICE


LINE NUMBERING BY COMMODITY	ABBREVIATIONS
LINES 100-299 MAIN PROCESS LINES PROCESS GAS LINES LINES 300-499 SECONDARY PROCESS LINES (OIL AND CONDENSATE) LINES 500-599 BLOWDOWNS, RELIEF AND DRAINS (BD, D, HF, LF, R) LINES 600-699 FUEL GAS (FG) INSTRUMENT GAS (IG, UA) LINES 700-899 UTILITIES BLANKET GAS (BG) CHEMICAL INJECTION (CH) HEAT MEDIUM (HM) INSTRUMENT AIR (IA) STEAM (S, SC) LINES 900-999 USERS CHOICE (EX, N, SU)	AC - AIR TO CLOSE AO - AIR TO OPEN CC - CORROSION COUPON CO - CLEAN OUT CP - CATHODIC PROTECTION CSC - CAR SEAL CLOSED CSO - CAR SEAL OPEN DBB - DOUBLE BLOCK & BLEED FC - FAIL CLOSED FL - FAIL LOCK FLP - FAIL LAST POSITION FO - FAIL OPEN FOB - FLAT ON BOTTOM FOT - FLAT ON TOP FP - FULL PORT HDPE - HIGH DENSITY POLYETHYLENE HOA - HAND OFF AUTO IK - INSULATING KIT LEL - LOWER EXPLOSIVE LIMIT MV - MANWAY MCC - MOTOR CONTROL CENTRE NC - NORMALLY CLOSED NO - NORMALLY OPEN SP - SAMPLE POINT S/S - SEAM TO SEAM T/T - TANGENT TO TANGENT TH - THIEF HATCH TSS - TEMPORARY SUCTION STRAINER WC - WAFER CHECK
OTHER POSSIBLE INSTRUMENTATION COMBINATIONS	
FO - RESTRICTION ORIFICE FRK - FLOW CONTROL STATION HIK - HAND CONTROL STATION FX - ACCESSORIES TJR - SCANNING RECORDER LLH - PILOT LIGHT PFR - RATIO KQI - RUNNING TIME INDICATOR QOI - INDICATING COUNTER WKIC - RATE OF WEIGHT LOSS CONTROLLER HMS - HAND MOMENTARY SWITCH ESDV - EMERGENCY SHUTDOWN VALVE	

ARC RESOURCES LTD. 0408081166.0000/01 SURFACE LSD/NTS	TNT Engineering Ltd. SUITE 600, 639 - 5TH AVE SW CALGARY, AB, T2P 0M9 (403) 387-2500 PHONE (403) 387-2535 FAX	DRAWING NUMBERING SHEET NO. DRAWING NO.	TYPICAL FLOW SHEET SYMBOLS AND STANDARDS REV. DATE 06/05/2013 DWG SYMBOL SHEET REV. D
---	---	---	---

PLOT BY: SKIM, 8/11/2014 5:05 PM

Z:\DRAFTING\JOBS\ARC RESOURCES LTD\PEMBINA\MIPA 8\02-13-48-08 W5M\PIPING\0213048085.2100 REV B.DWG

DRAWING SHEET SIZE: 11" x 17"

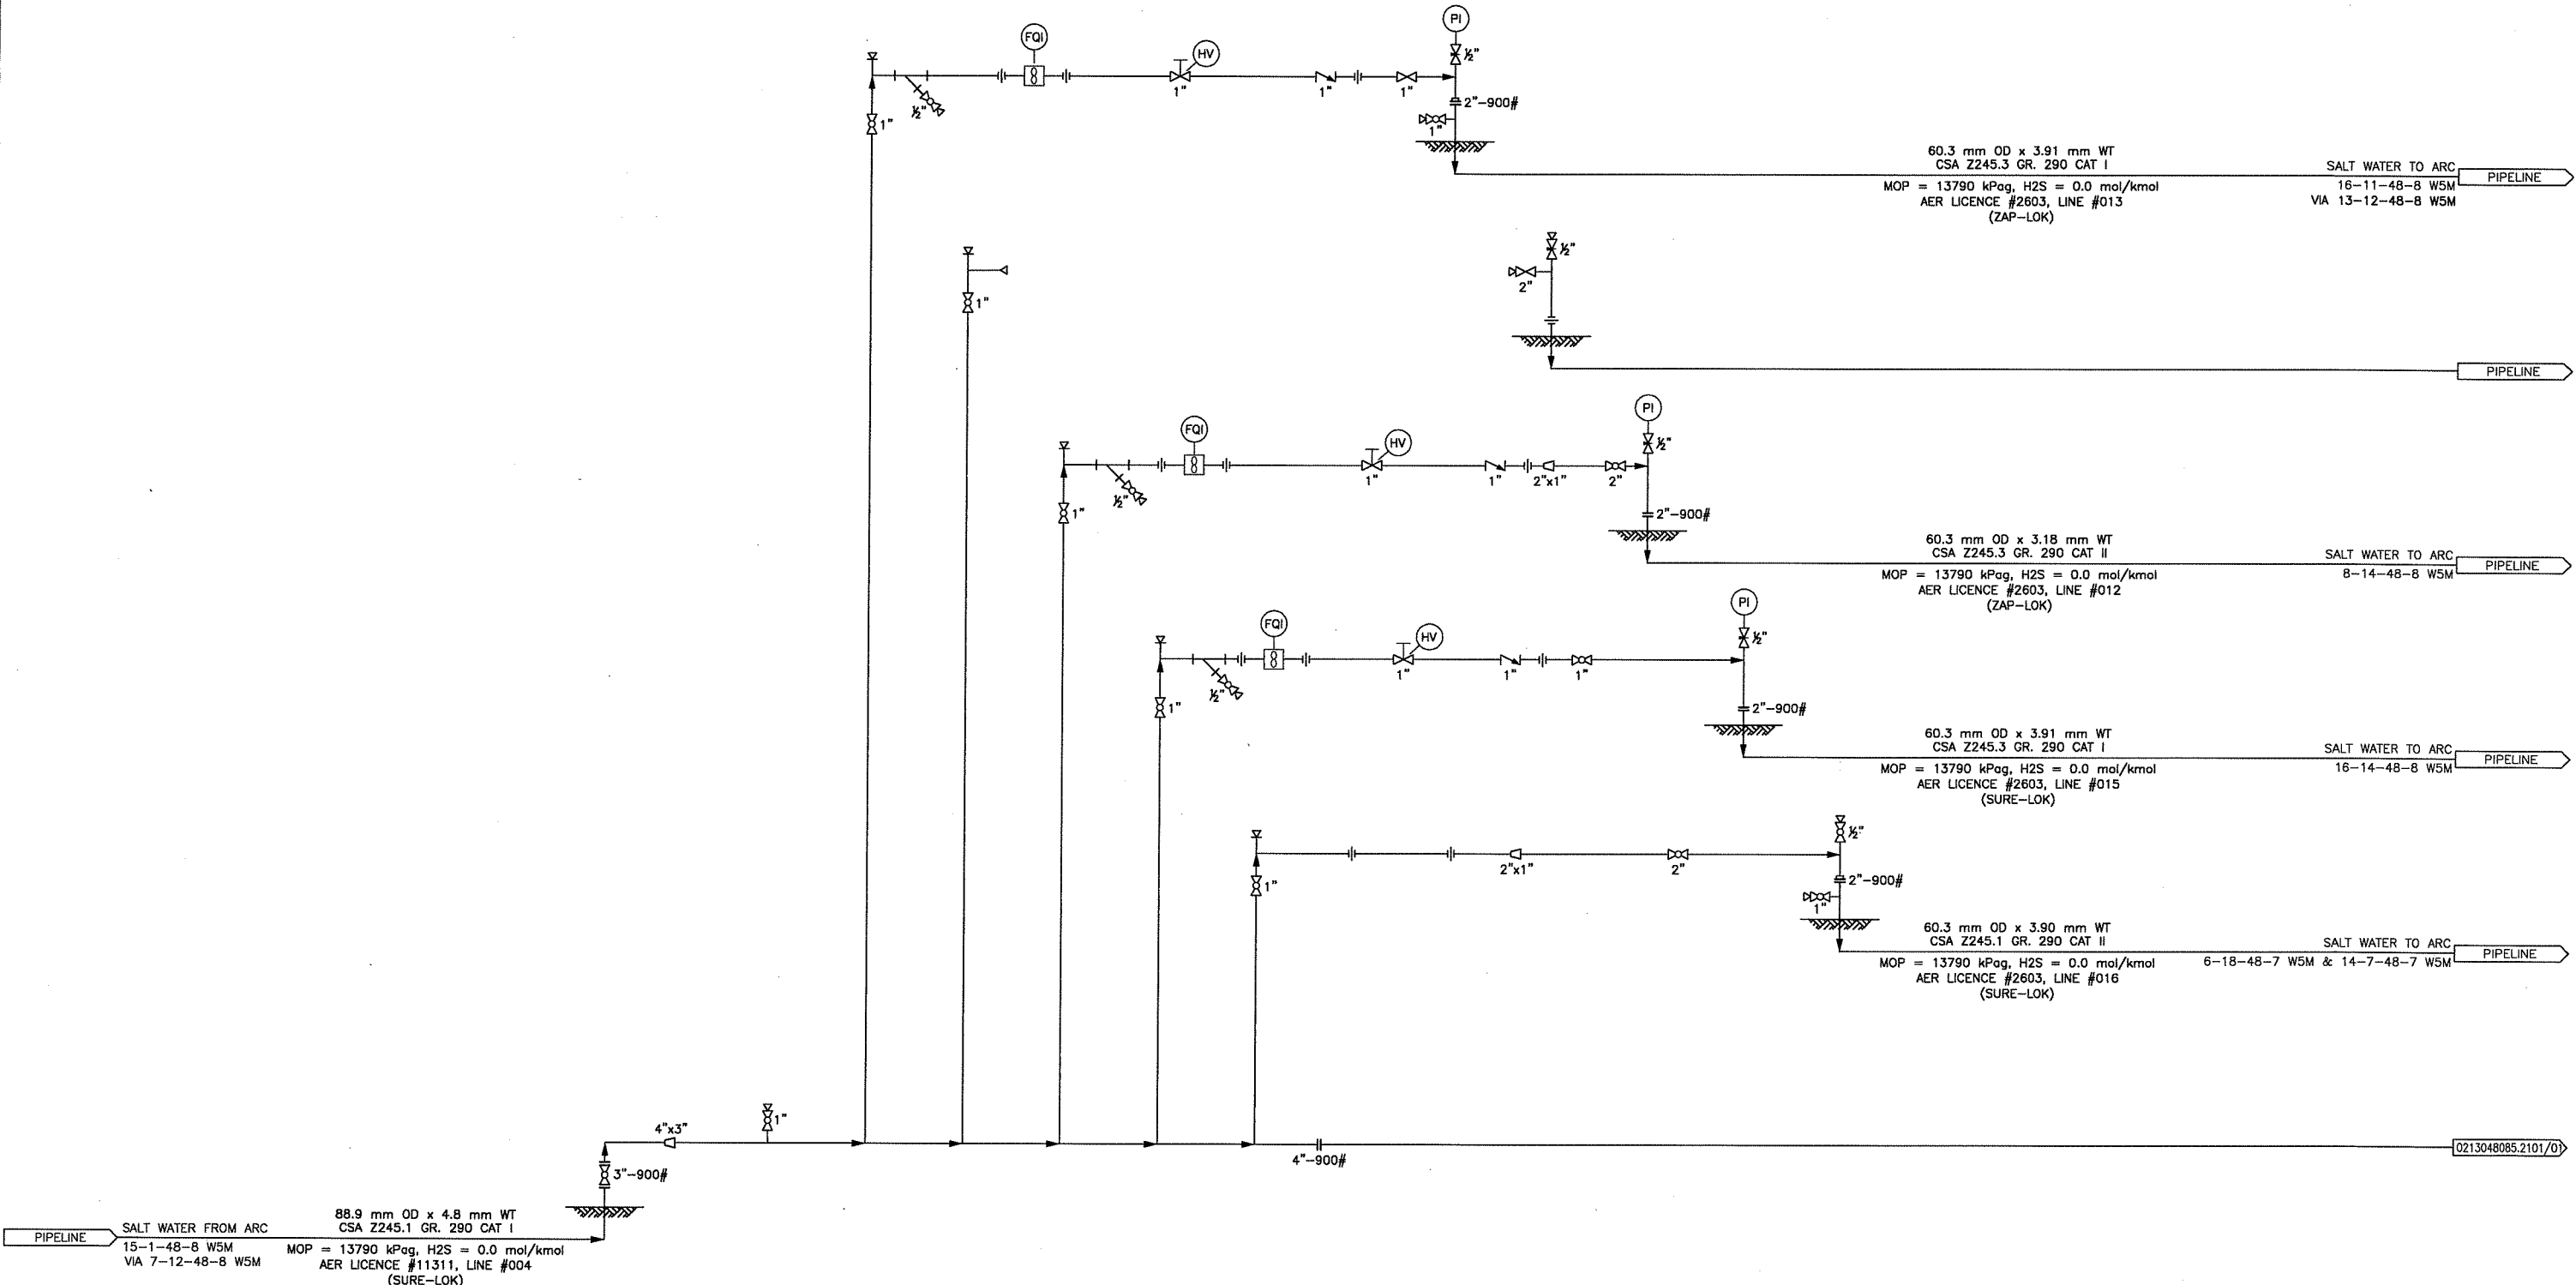

REV	DESCRIPTION	BY	MM/DD/YYYY	CHKD	APPD	JOB No.
A	AS-BUILT	EU	03/03/2014	KR		2136

PERMIT

STAMP

ENGINEERING RECORD


DRAWN:	E. USON	DATE:	03/03/2014
CHECKED:	K. ROBERTS	DATE:	03/03/2014
ENGINEER:		DATE:	
PROJECT MANAGER:	R. CUMBERLAND	DATE:	03/03/2014

SUITE 600, 639 - 5TH AVE SW
CALGARY, AB, T2P 0M9
(403) 387-2500 PHONE
(403) 387-2535 FAX


PEMBINA - MIPA 8
2-13-48-8 W5M
2-13 INJECTION SOUTH HEADER
PIPING AND INSTRUMENTATION DIAGRAM

SCALE	NTS	DWG	0213048085.2100/01	REV.	A
-------	-----	-----	--------------------	------	---

2:\CRATING\JOBS\ARC RESOURCES LTD\PERMENA\PIPA 8\02-13-048-C8 WSM\PAID\0213048085.2100D REV A.DWG

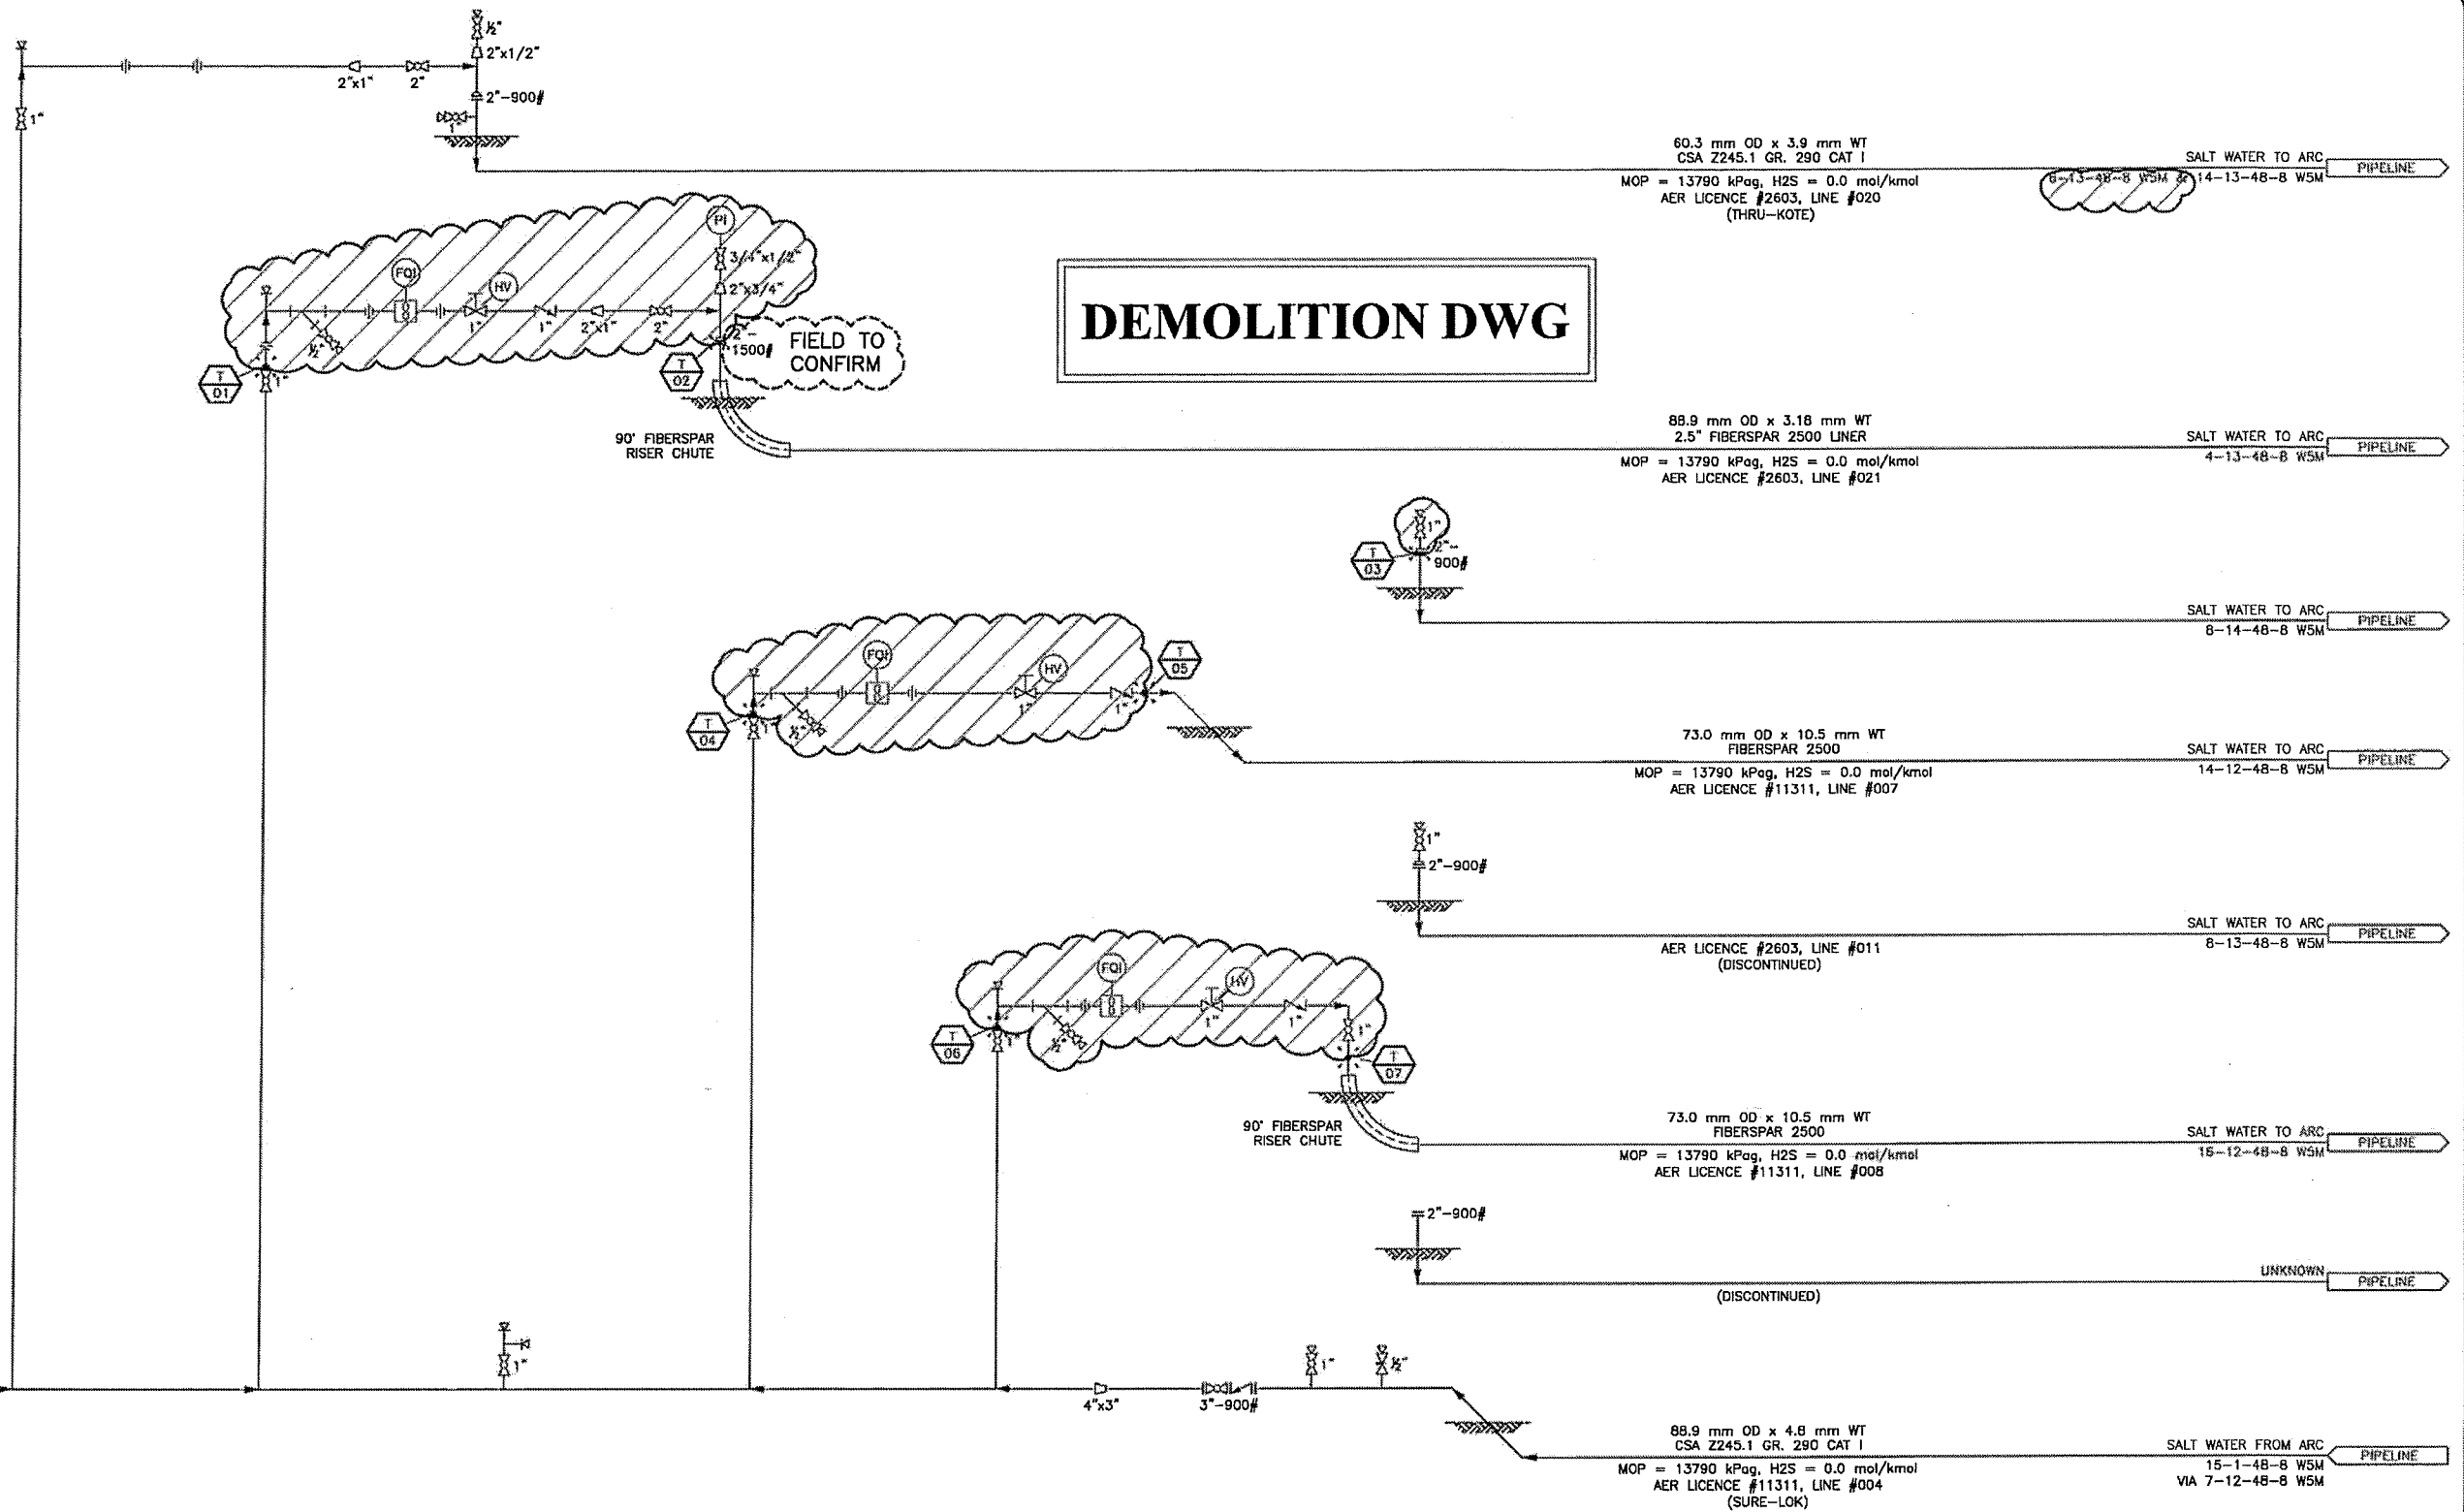[illegible]

PERMIT

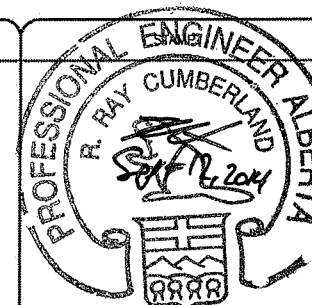

ARC RESOURCES LTD.

TNT Engineering Ltd. SUITE 600, 639 - 5TH AVE SW
CALGARY, AB, T2P 0M9
(403) 387-2500 PHONE
(403) 387-2535 FAX

ENGINEERING RECORD

DRAWN:	S. KIM	DATE:	08/11/2014
CHECKED:	K. ROBERTS	DATE:	08/11/2014
ENGINEER:	M. AALBERS	DATE:	08/11/2014
PROJECT MANAGER:	R. CUMBERLAND	DATE:	08/11/2014



PEMBINA - MIPA 8
2-13-48-8 W5M
2-13 INJECTION NORTH HEADER
PIPING AND INSTRUMENTATION DIAGRAM

SCALE	NTS	DWG	0213048085.2101D/01	REV.	A
-------	-----	-----	---------------------	------	---

PLOT BY: BWANG, 9/11/2014 2:48 PM


Z:\DRAFTING\JOBS\ARC RESOURCES LTD\PEMBINA\MIPA 8\02-13-048-08 WSM\2\0213048085.2100 REV 0.DWG

Z-900
POLYMER INJECTION PACKAGE
VENDOR: FABTECH - BLACK BOX
TYPE: CDG - CHROMIUM CROSS-LINKER
DATE: 2014

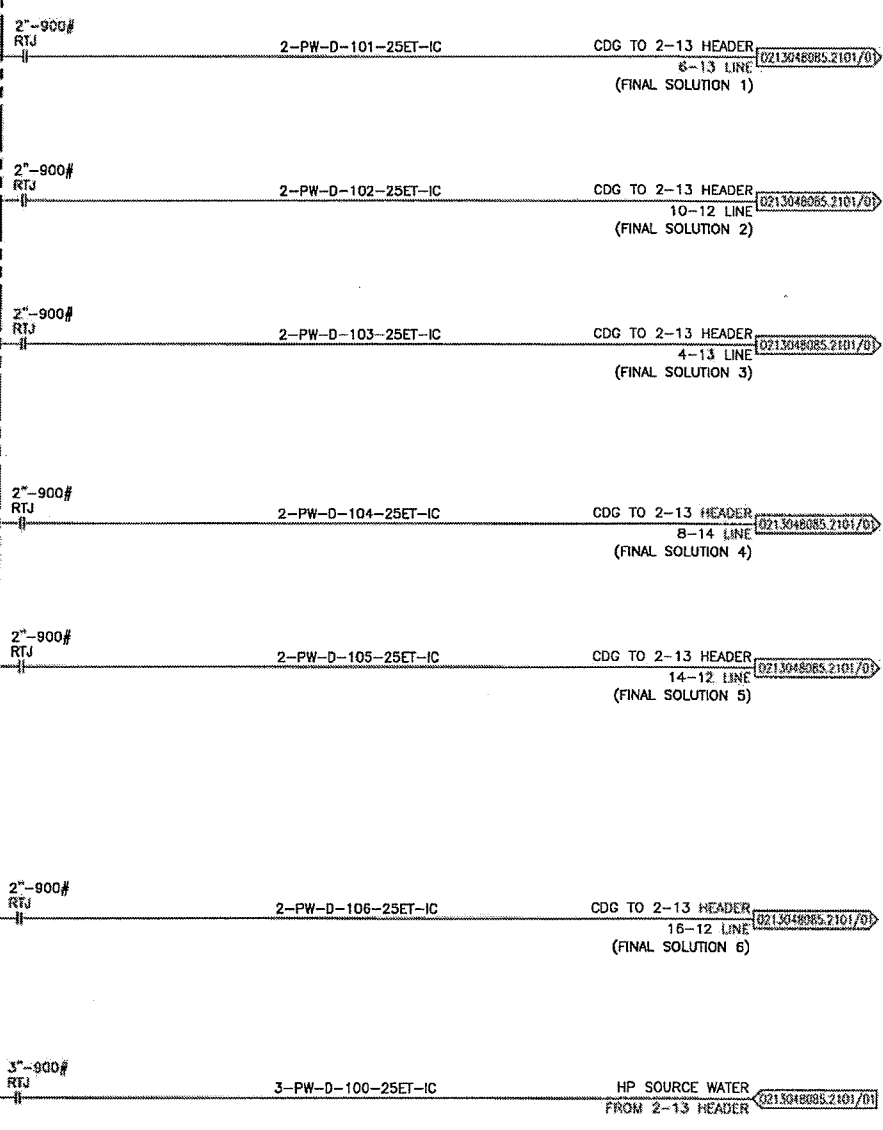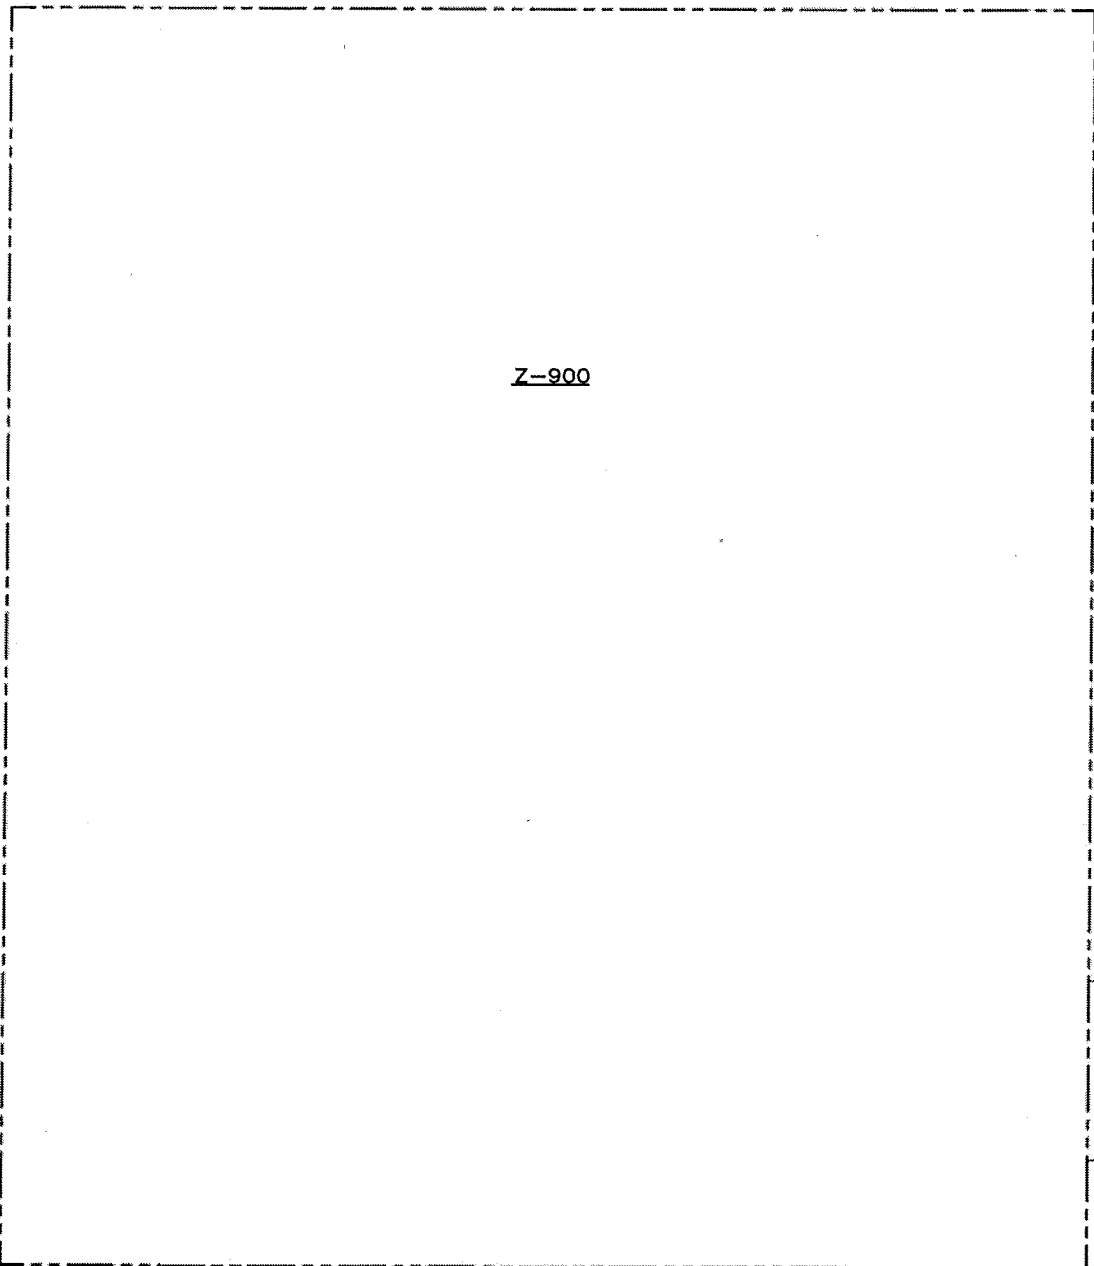

REV	DESCRIPTION	BY	MM/DD/YYYY	CHKD	APPD	JOB No.
0	ISSUED FOR CONSTRUCTION - 2-13 POLYMER INJECTION SKID	BW	09/11/2014	KR	MA	2136

PERMIT

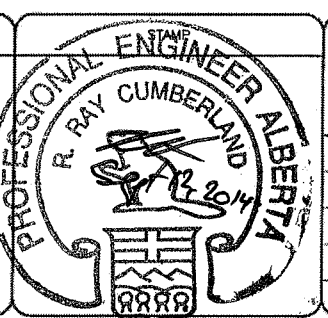

ARC RESOURCES LTD.

TNT Engineering Ltd.
SUITE 600, 639 - 5TH AVE SW
CALGARY, AB, T2P 0M9
(403) 387-2500 PHONE
(403) 387-2535 FAX

ENGINEERING RECORD

DRAWN:	G. WONG	DATE:	08/28/2014
CHECKED:	K. ROBERTS	DATE:	08/28/2014
ENGINEER:	M AALBERS	DATE:	08/28/2014
PROJECT MANAGER:	R. CUMBERLAND	DATE:	08/28/2014


PEMBINA - MIPA 8
2-13-48-8 WSM
2-13 CDG POLYMER SKID
PIPING AND INSTRUMENTATION DIAGRAM
SCALE: NTS
DWG: 0213048085.2102/01
REV: 0

21 DRAFTING JOBS VRC RESOURCES LTD PEMBINA TYPICAL F&D TYP PEMBINA.2010 REV 0.DWG

DRAWING SHEET SIZE: 11" x 17"

V-120
PROPANE TANK

1. AS PER CSA Z662 SECTION 13.1.2.9 CYCLIC PRESSURE SERVICE FACTOR APPLIES WHEN NORMAL OPERATING PRESSURE REGULARLY CYCLES MORE THAN 20% OF MOP.

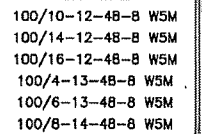[illegible]

ARC RESOURCES LTD.




TNT Engineering Ltd.

**SUITE 600, 639 - 5TH AVE SW
CALGARY, AB, T2P 0M9
(403) 387-2500 PHONE
(403) 387-2535 FAX**

ENGINEERING RECORD

DRAWN: K. ROBERTS	DATE: 08/18/2014
CHECKED:	DATE:
ENGINEER:	DATE:
PROJECT MANAGER: R. CUMBERLAND	DATE: 08/18/2014


PEMBINA TYPICAL CDG WATER INJECTION WELLHEAD AREA PIPING AND INSTRUMENTATION DIAGRAM			
SCALE	NTS	DWG TYP.PEMBINA.2010/02	REV. 0

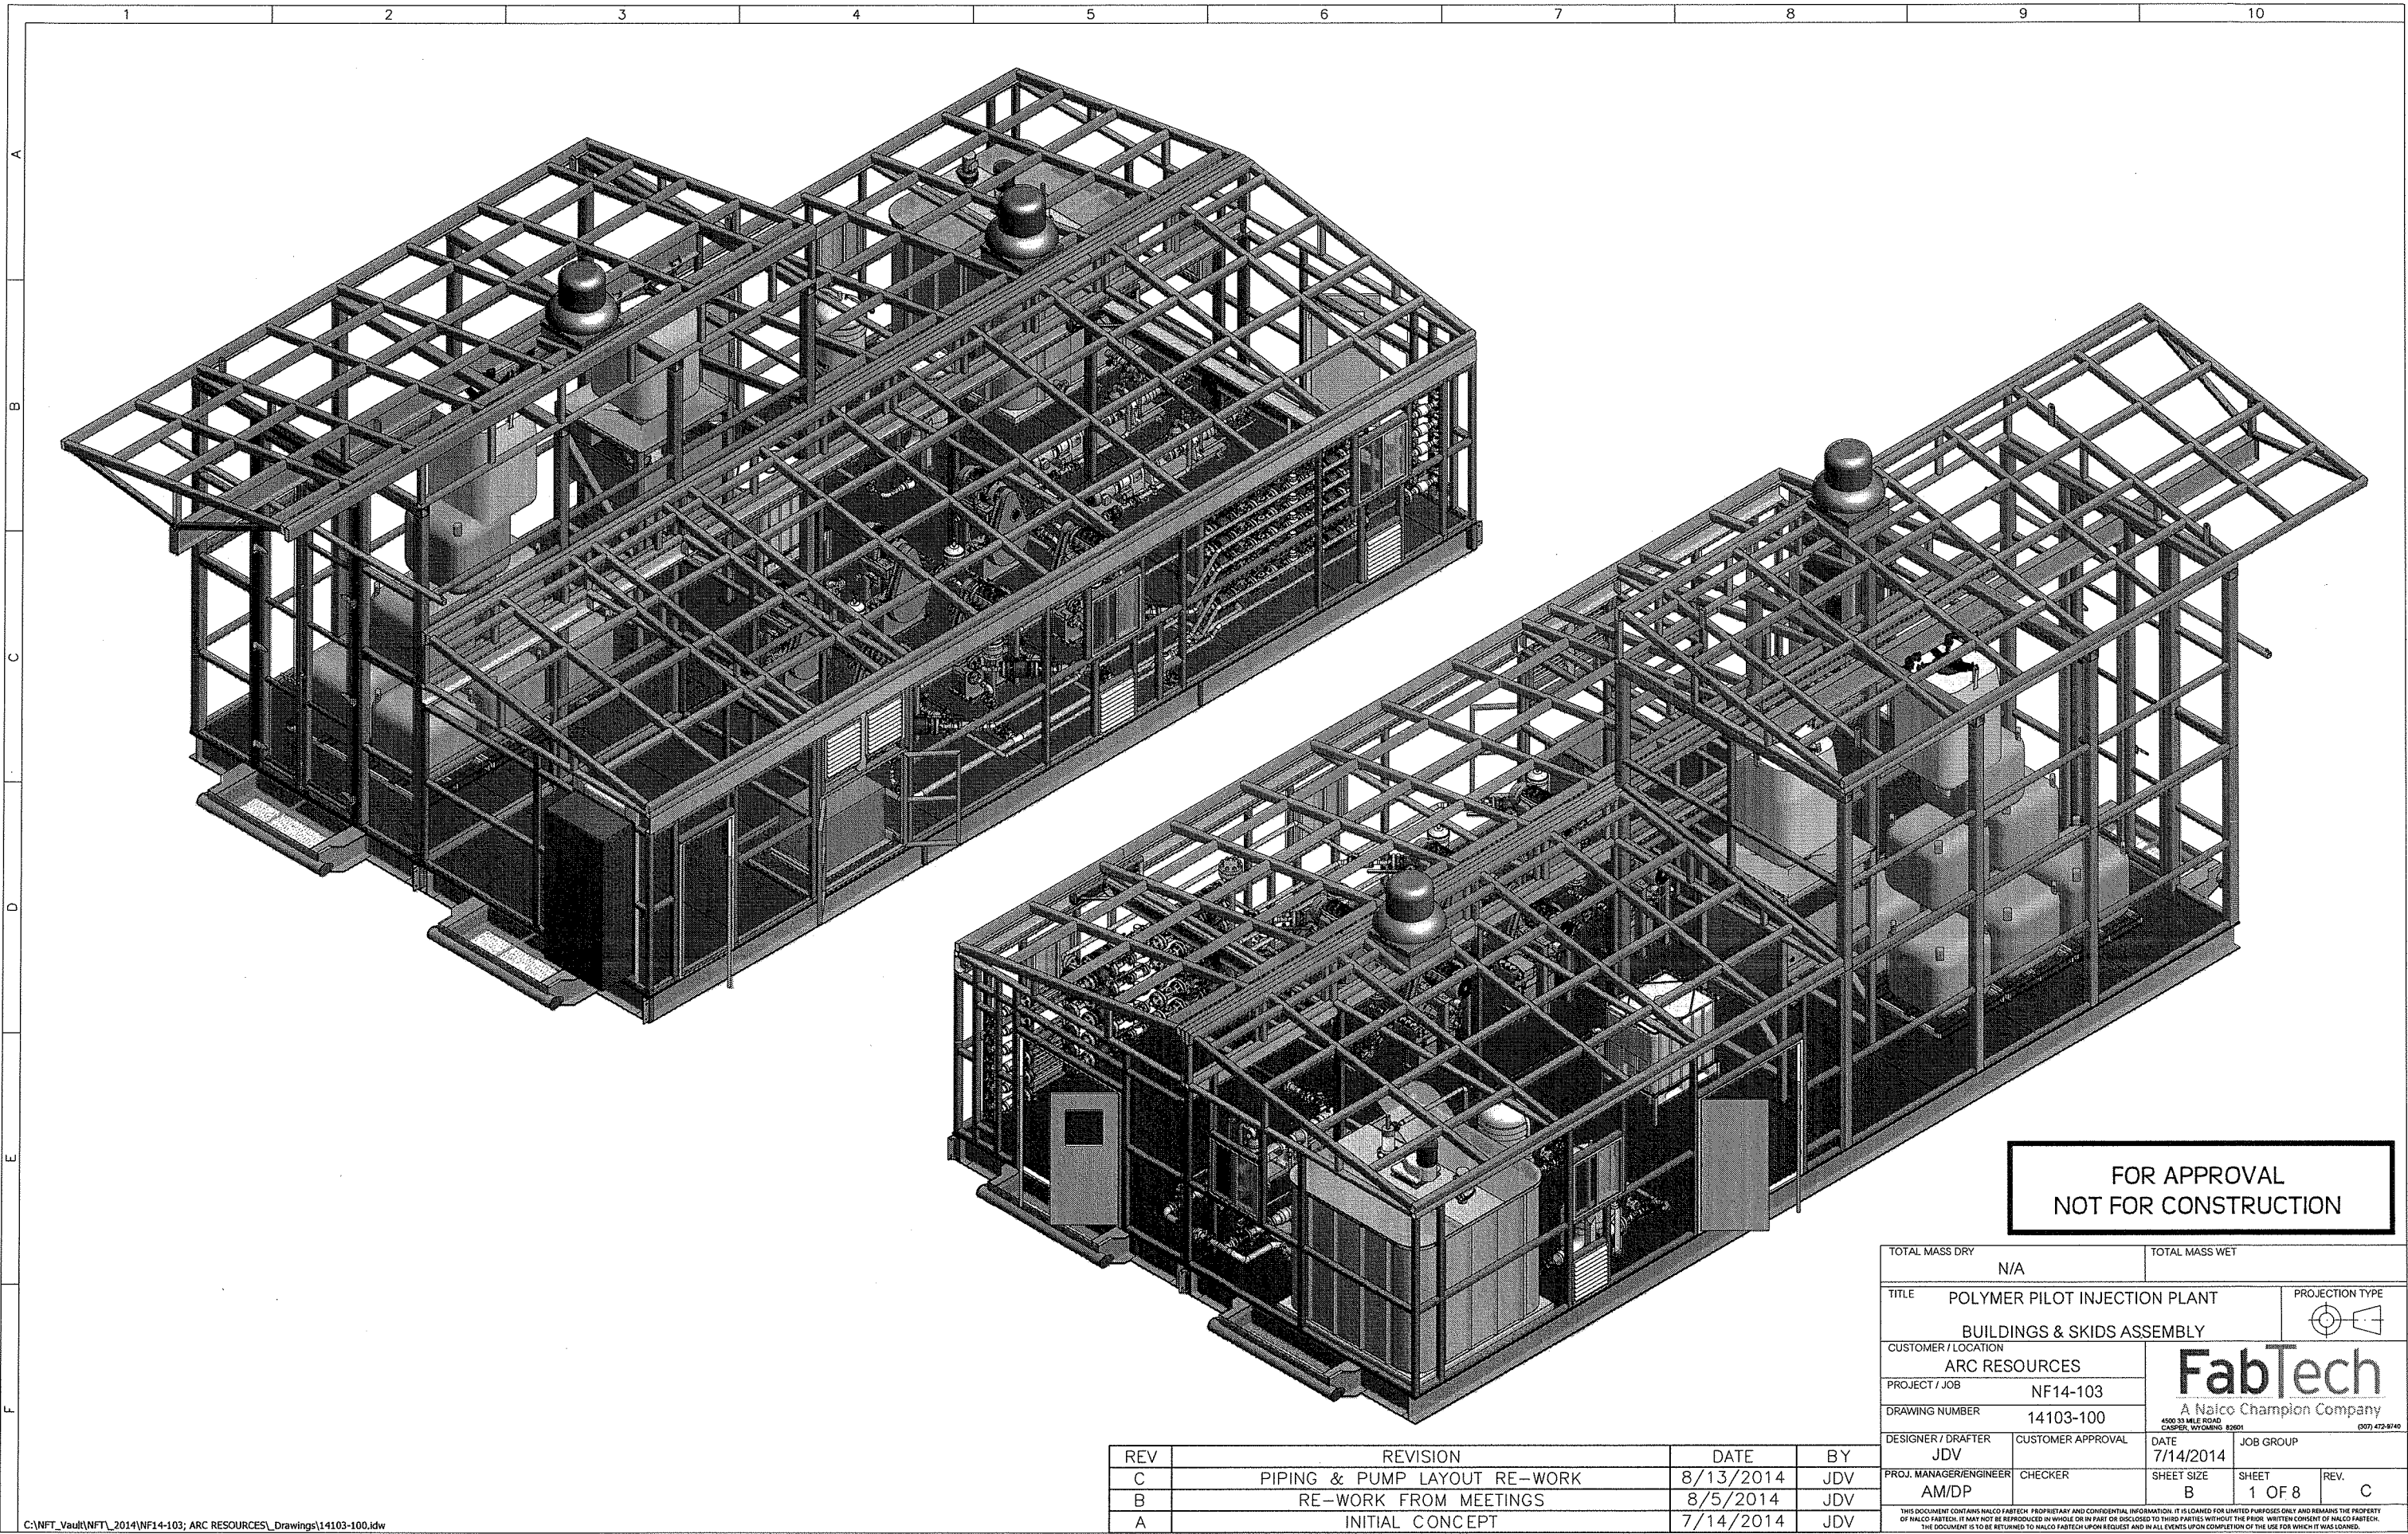


FOR APPROVAL
NOT FOR CONSTRUCTION

REV	REVISION	DATE	BY
C	PIPING & PUMP LAYOUT RE-WORK	8/13/2014	JDV
B	RE-WORK FROM MEETINGS	8/5/2014	JDV
A	INITIAL CONCEPT	7/14/2014	JDV

TOTAL MASS DRY N/A		TOTAL MASS WET	
TITLE POLYMER PILOT INJECTION PLANT BUILDINGS & SKIDS ASSEMBLY		PROJECTION TYPE 	
CUSTOMER / LOCATION ARC RESOURCES		FabTech A Naico Champion Company 4500 33 MILE ROAD CASPER, WYOMING 82401 (307) 472-8140	
PROJECT / JOB NF14-103			
DRAWING NUMBER 14103-100		DATE 7/14/2014	
DESIGNER / DRAFTER JDV	CUSTOMER APPROVAL	JOB GROUP	
PROJ. MANAGER/ENGINEER AM/DP	CHECKER	SHEET SIZE B	SHEET 1 OF 8
		REV. C	

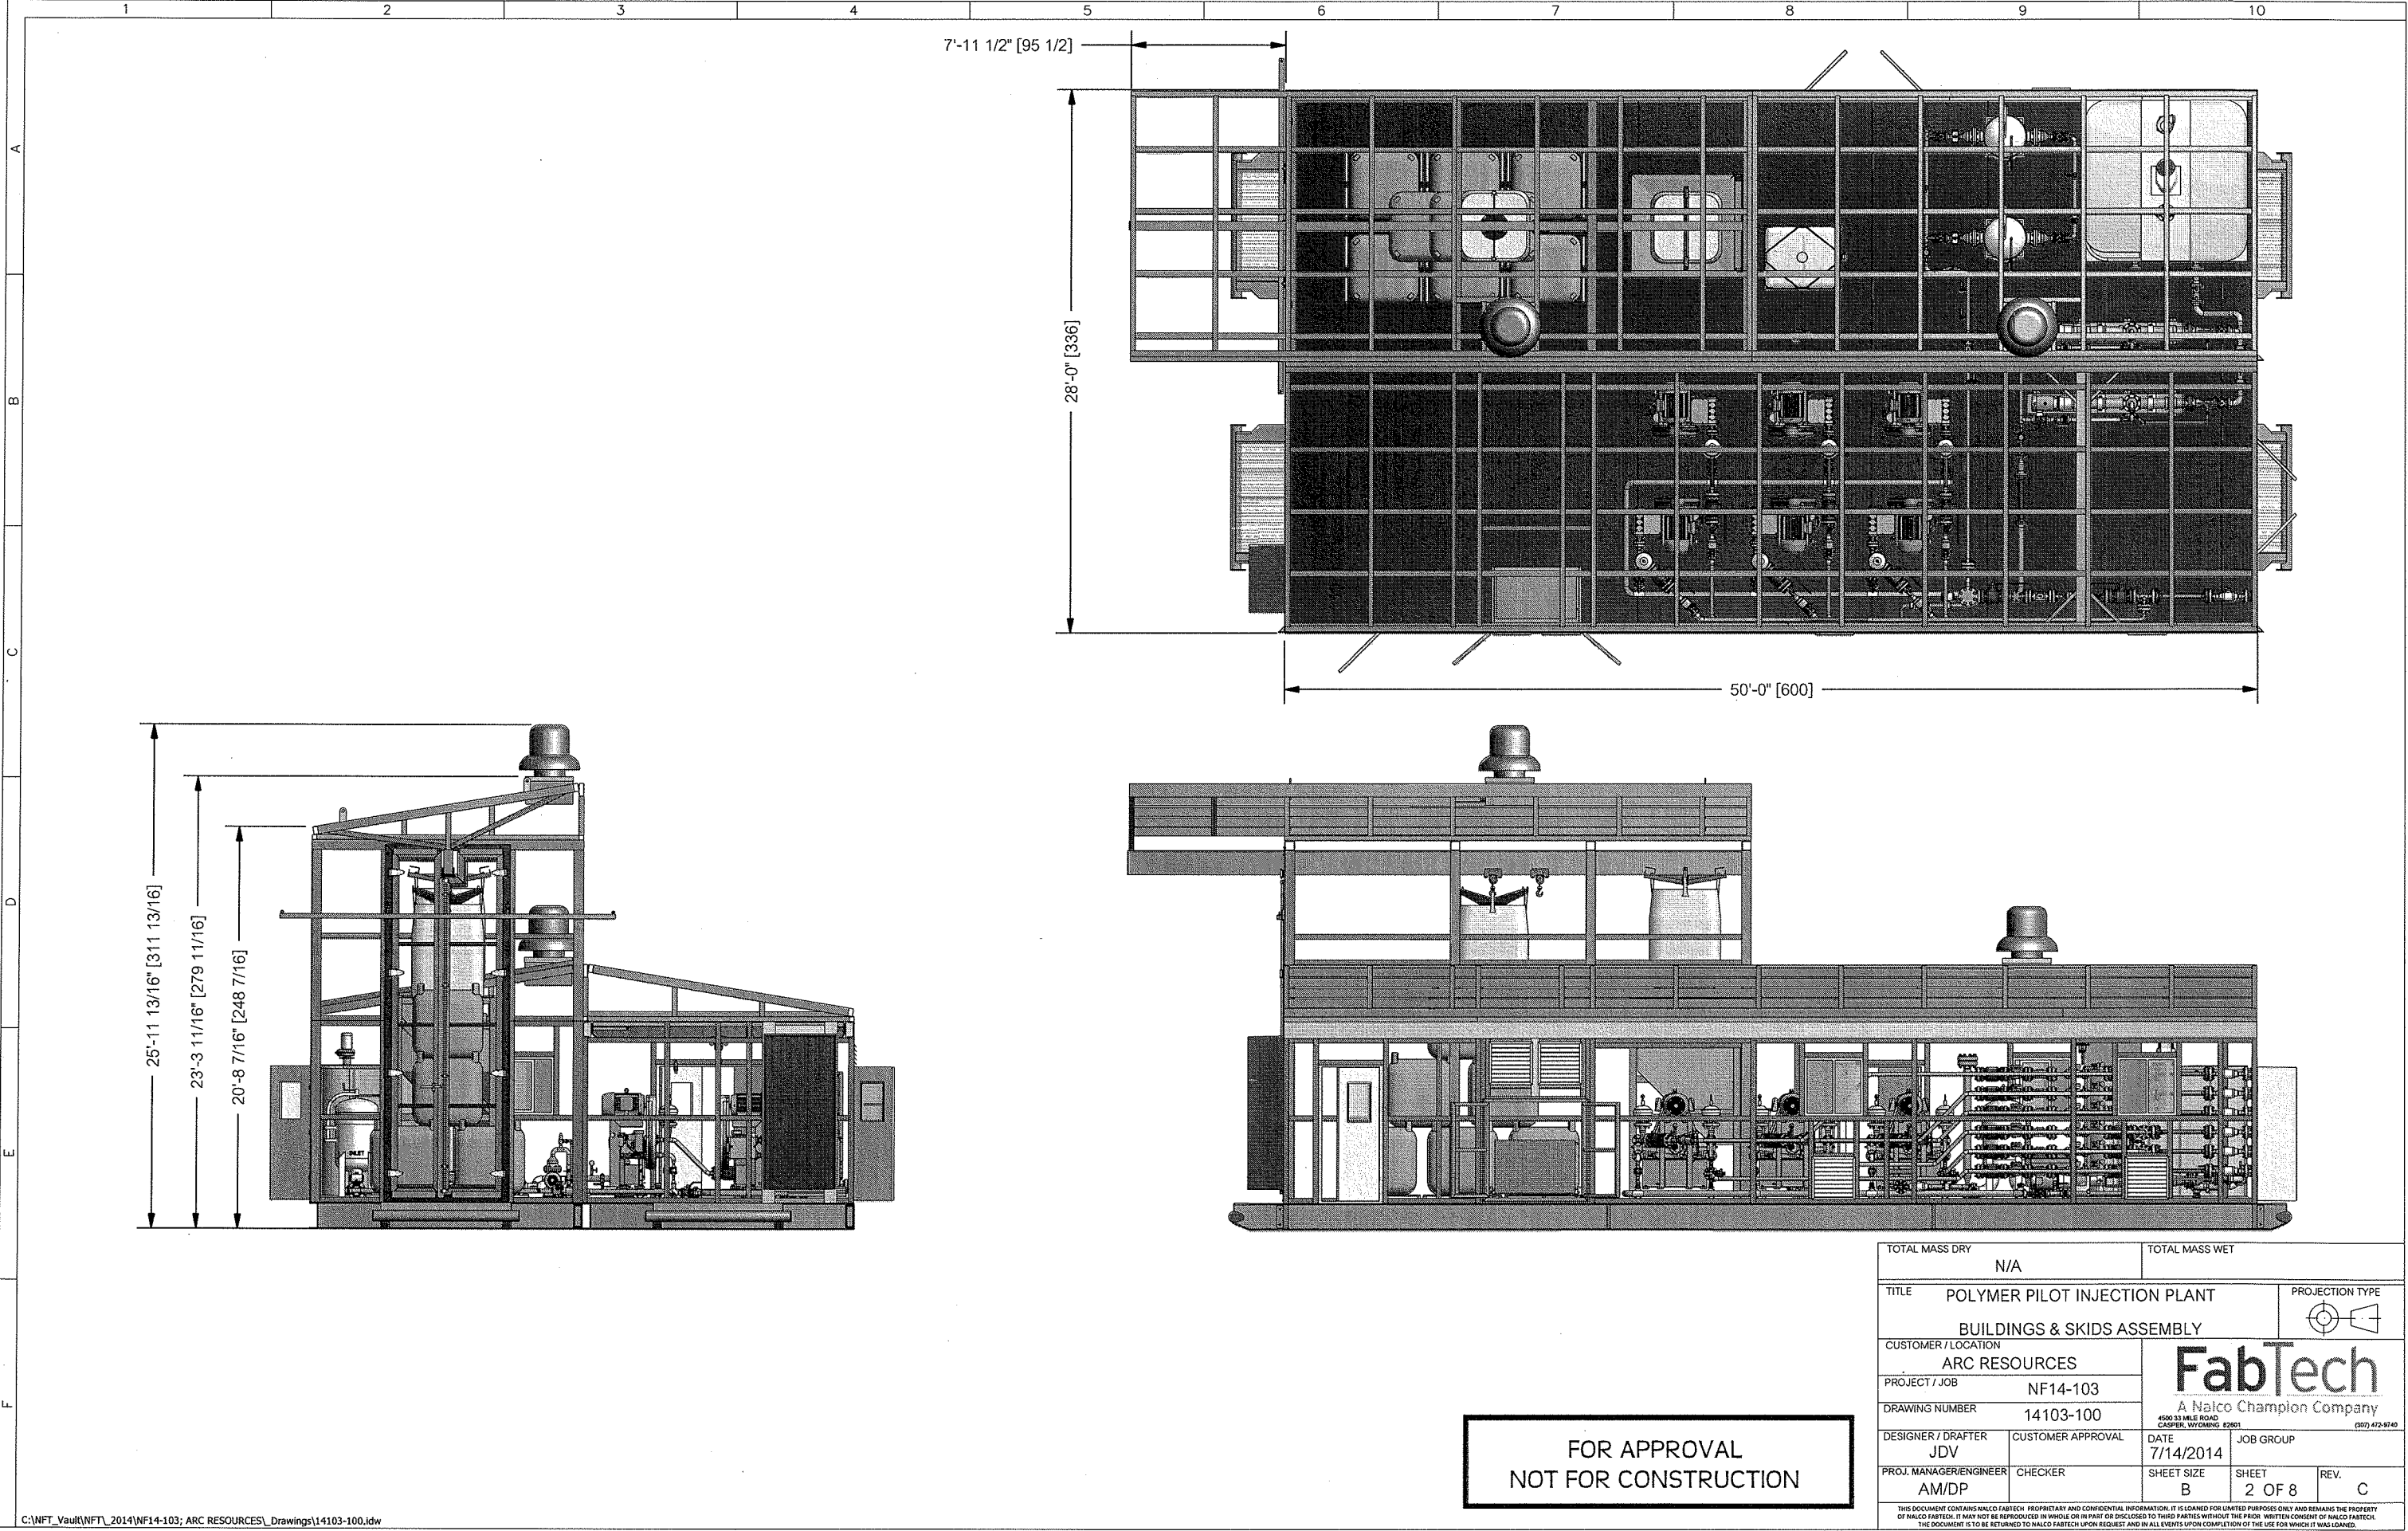

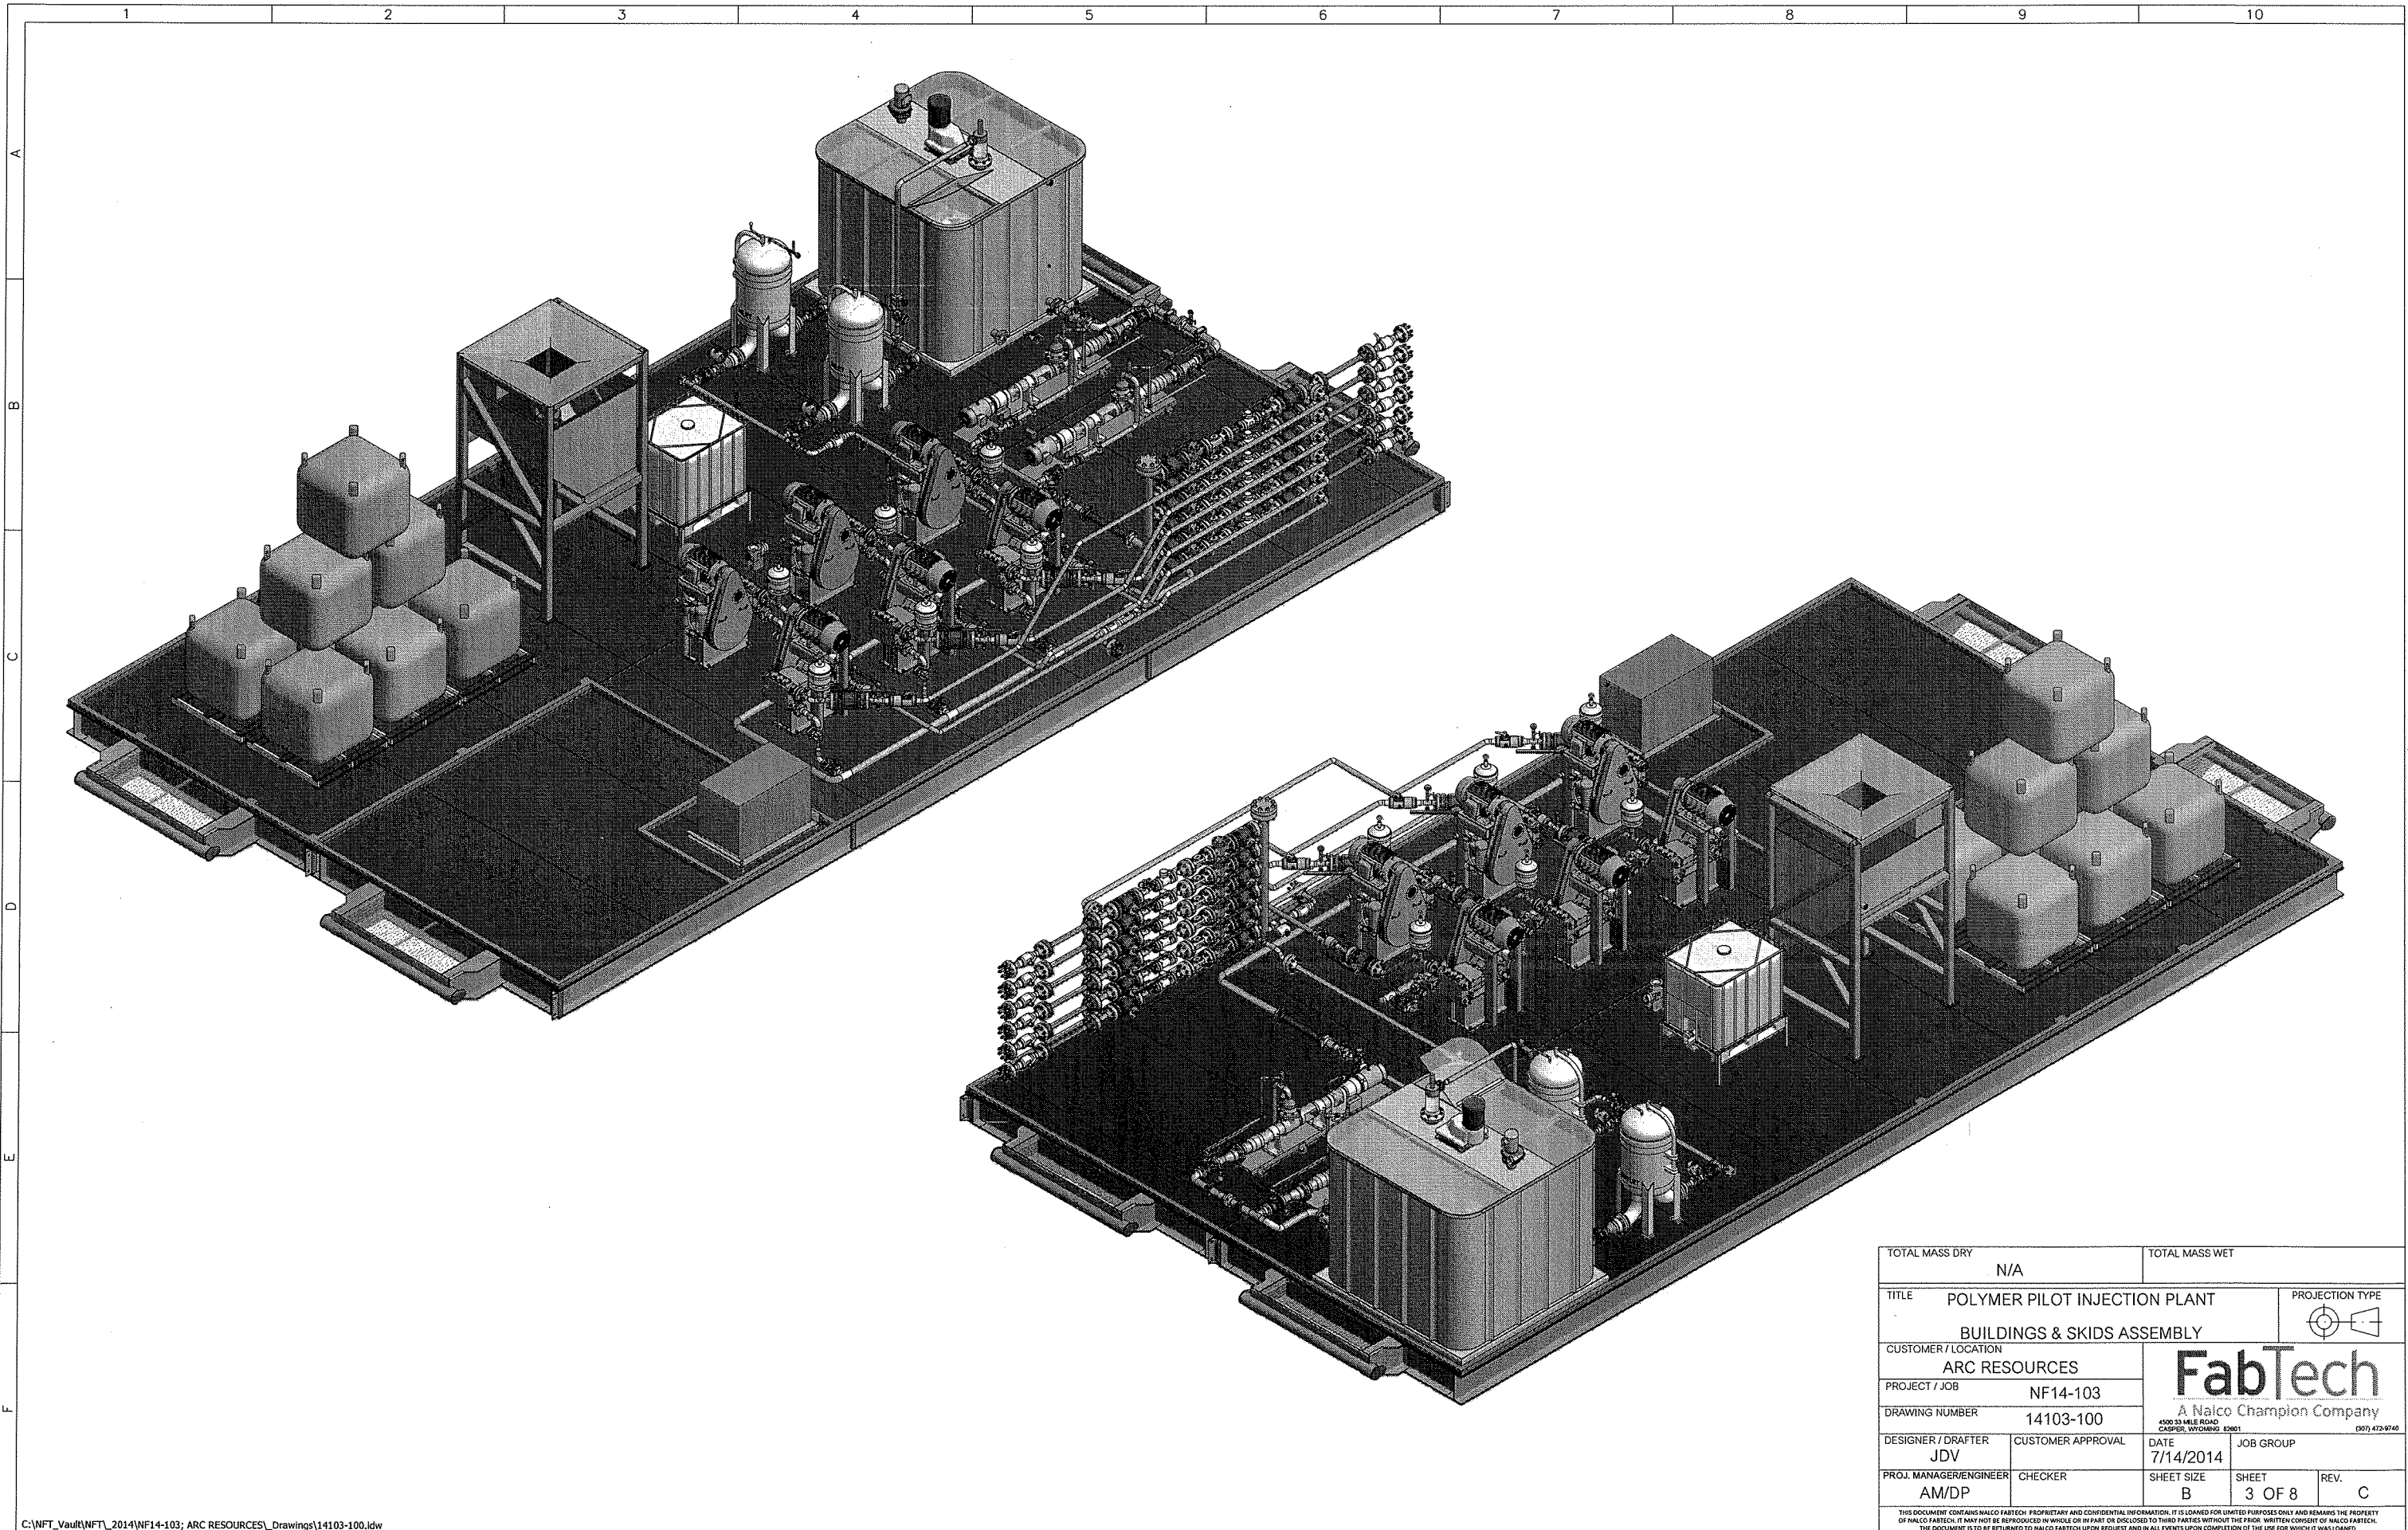


TOTAL MASS DRY		TOTAL MASS WET	
N/A			
TITLE		POLYMER PILOT INJECTION PLANT	PROJECTION TYPE
		BUILDINGS & SKIDS ASSEMBLY	
CUSTOMER / LOCATION		FabTech A Naico Champion Company 4500 33 MILE ROAD CASPER, WYOMING 82401 (307) 472-9740	
ARC RESOURCES			
PROJECT / JOB			
NF14-103			
DRAWING NUMBER			
14103-100			
DESIGNER / DRAFTER	CUSTOMER APPROVAL	DATE	JOB GROUP
JDV		7/14/2014	
PROJ. MANAGER/ENGINEER	CHECKER	SHEET SIZE	SHEET
AM/DP		B	3 OF 8
			REV.
			C
THIS DOCUMENT CONTAINS NALCO FABTECH PROPRIETARY AND CONFIDENTIAL INFORMATION. IT IS LOANED FOR LIMITED PURPOSES ONLY AND REMAINS THE PROPERTY OF NALCO FABTECH. IT MAY NOT BE REPRODUCED IN WHOLE OR IN PART OR DISCLOSED TO THIRD PARTIES WITHOUT THE PRIOR WRITTEN CONSENT OF NALCO FABTECH. THE DOCUMENT IS TO BE RETURNED TO NALCO FABTECH UPON REQUEST AND IN ALL EVENTS UPON COMPLETION OF THE USE FOR WHICH IT WAS LOANED.			

NOTES:
-WELD SIZE MINIMUM TO BE THE THINNER OF THE TWO MEMBERS UNLESS OTHERWISE NOTED
-MASS DOES NOT INCLUDE WELDS

-THIS DRAWING REFLECTS ONE (1) UNIT
-TWO (2) UNITS REQUIRED PER JOB

-WELD PROCEDURE: FT-2-3


Parts List								
CK	ITEM	QTY	DESCRIPTION	WIDTH	LENGTH	MATERIAL	CLENGTH (in)	WEIGHT
	1	2	ANGLE, EQUAL, 1 1/2" X 1 1/2" X 3/16"		18 in	A36	36.00 in	5.43
	2	2	ANGLE, EQUAL, 1 1/2" X 1 1/2" X 3/16"		30 in	A36	60.00 in	9.06
	3	1	ANGLE, EQUAL, 1 1/2" X 1 1/2" X 3/16"		34 15/16 in	A36	34.92 in	5.27
	4	6	BEAM, W12 X 45#		38 5/8 in	A992	231.75 in	828.86
	5	3	BEAM, W12 X 45#		79 3/8 in	A992	238.13 in	892.79
	6	4	BEAM, W16 X 67#		38 5/8 in	A992	154.50 in	785.94
	7	2	BEAM, W16 X 67#		79 3/8 in	A992	158.75 in	886.18
	8	2	BEAM, W16 X 67#		600 in	A992	1200.00 in	6699.07
	9	2	BEAM, W16 X 67#		652 in	A992	1304.00 in	7138.61
	10	26	BEAM, W8x18#		38 5/8 in	A992		1437.85
	11	13	BEAM, W8x18#		79 3/8 in	A992		1547.50
	12	1	GRATING, 19-W-4 (1 1/4" x 3/16")	18 in	68 3/4 in	SERRATED, RR-G-661b	68.75 in	439.25
	13	1	GRATING, 19-W-4 (1 1/4" x 3/16")	30 in	68 3/4 in	SERRATED, RR-G-661b	68.75 in	732.09
	14	4	PIPE, 1" s/80		9 1/4 in	A53B		3.35
	15	2	PIPE, 6" S/80		89 in	SA53B, WLD	178.00 in	424.29
	16	4	PLATE, 1/2"	6 7/8 in	9 9/16 in	A36, TAILROLL (USE TEMPLATE)	38.25 in	28.03
	17	2	PLATE, 1/4"	4 3/4 in	79 3/4 in	A36	159.50 in	53.78
	18	1	PLATE, DECK, 3/16	167 1/2 in	21 1/2 in	A786	21.50 in	191.47
	19	8	PLATE, DECK, 3/16	167 1/2 in	72 in	A786	576.00 in	5129.69
	20	2	SKID CONNECTION			SEE DWG. 11BCNH		48.61
	21	2	TUBE, 2x2x3/16x15		15 in	ASTM A500B CLEAN COAT		10.81

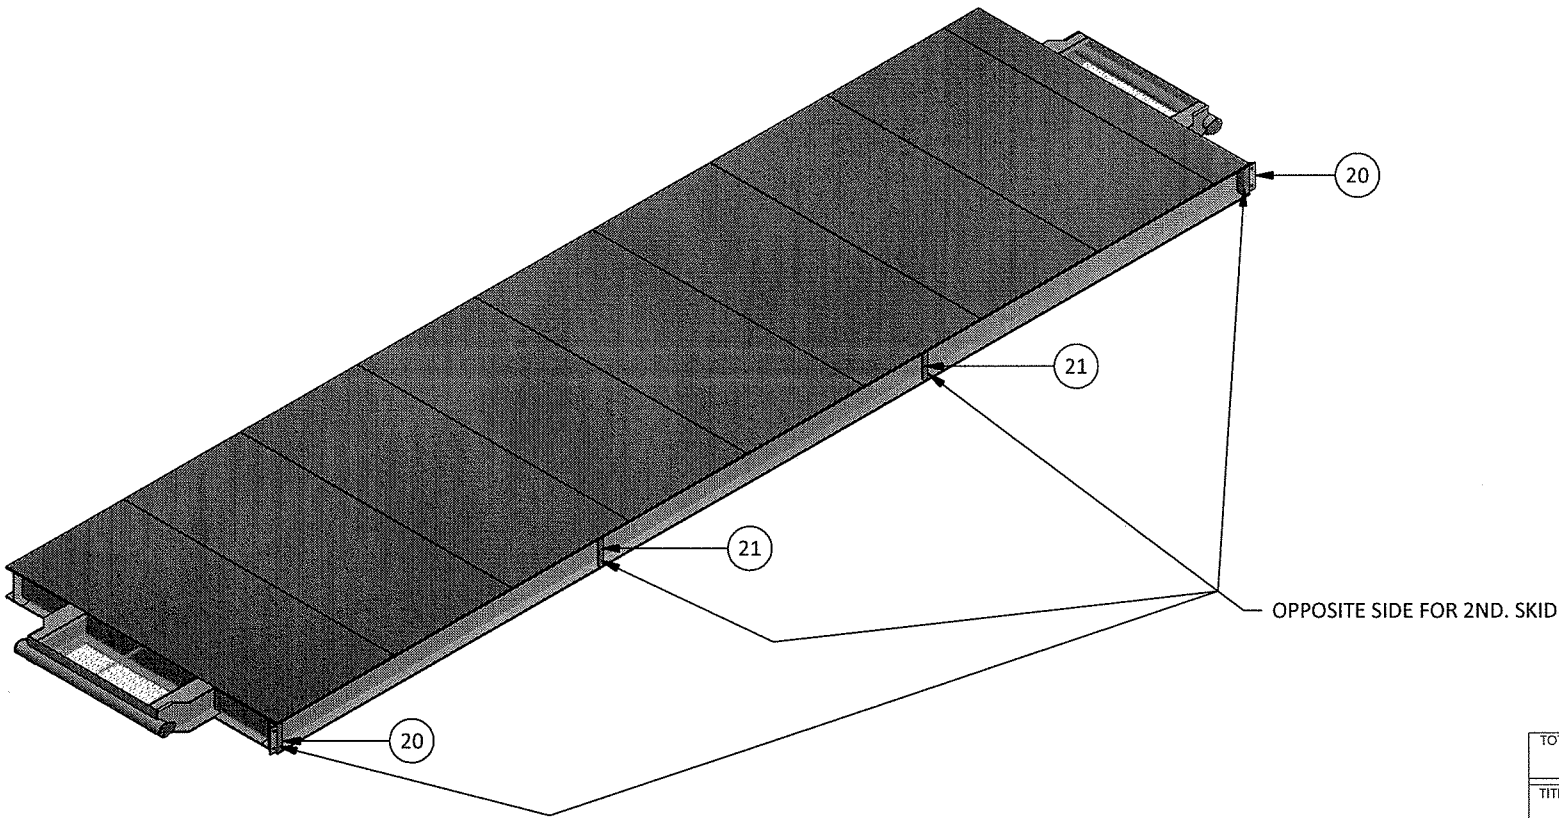

REV	REVISION	DATE	BY
2	REVISED TAILROLL	4/25/2014	JZL
1	CHANGED BEAM SIZE	4/17/2014	JZL
0	RELEASE FOR CONSTRUCTION	4/16/2014	JZL


TOTAL MASS DRY N/A		TOTAL MASS WET			
TITLE POLYMER PILOT INJECTION PLANT			PROJECTION TYPE 		
SKID					
CUSTOMER / LOCATION ARC RESOURCES		 A Naico Champion Company 4500 93 MILE ROAD CASPER, WYOMING 82501 (307) 472-9740			
PROJECT / JOB NF14-103					
DRAWING NUMBER 14103-600					
DESIGNER / DRAFTER JZL	CUSTOMER APPROVAL	DATE 4/10/2014	JOB GROUP G		
PROJ. MANAGER/ENGINEER AM	CHECKER CED	SHEET SIZE B	SHEET 1 OF 3		
			REV. 2		

THIS DOCUMENT CONTAINS NALCO FABTECH PROPRIETARY AND CONFIDENTIAL INFORMATION. IT IS LOANED FOR LIMITED PURPOSES ONLY AND REMAINS THE PROPERTY OF NALCO FABTECH. IT MAY NOT BE REPRODUCED IN WHOLE OR IN PART OR DISCLOSED TO THIRD PARTIES WITHOUT THE PRIOR WRITTEN CONSENT OF NALCO FABTECH. THE DOCUMENT IS TO BE RETURNED TO NALCO FABTECH UPON REQUEST AND IN ALL EVENTS UPON COMPLETION OF THE USE FOR WHICH IT WAS LOANED.

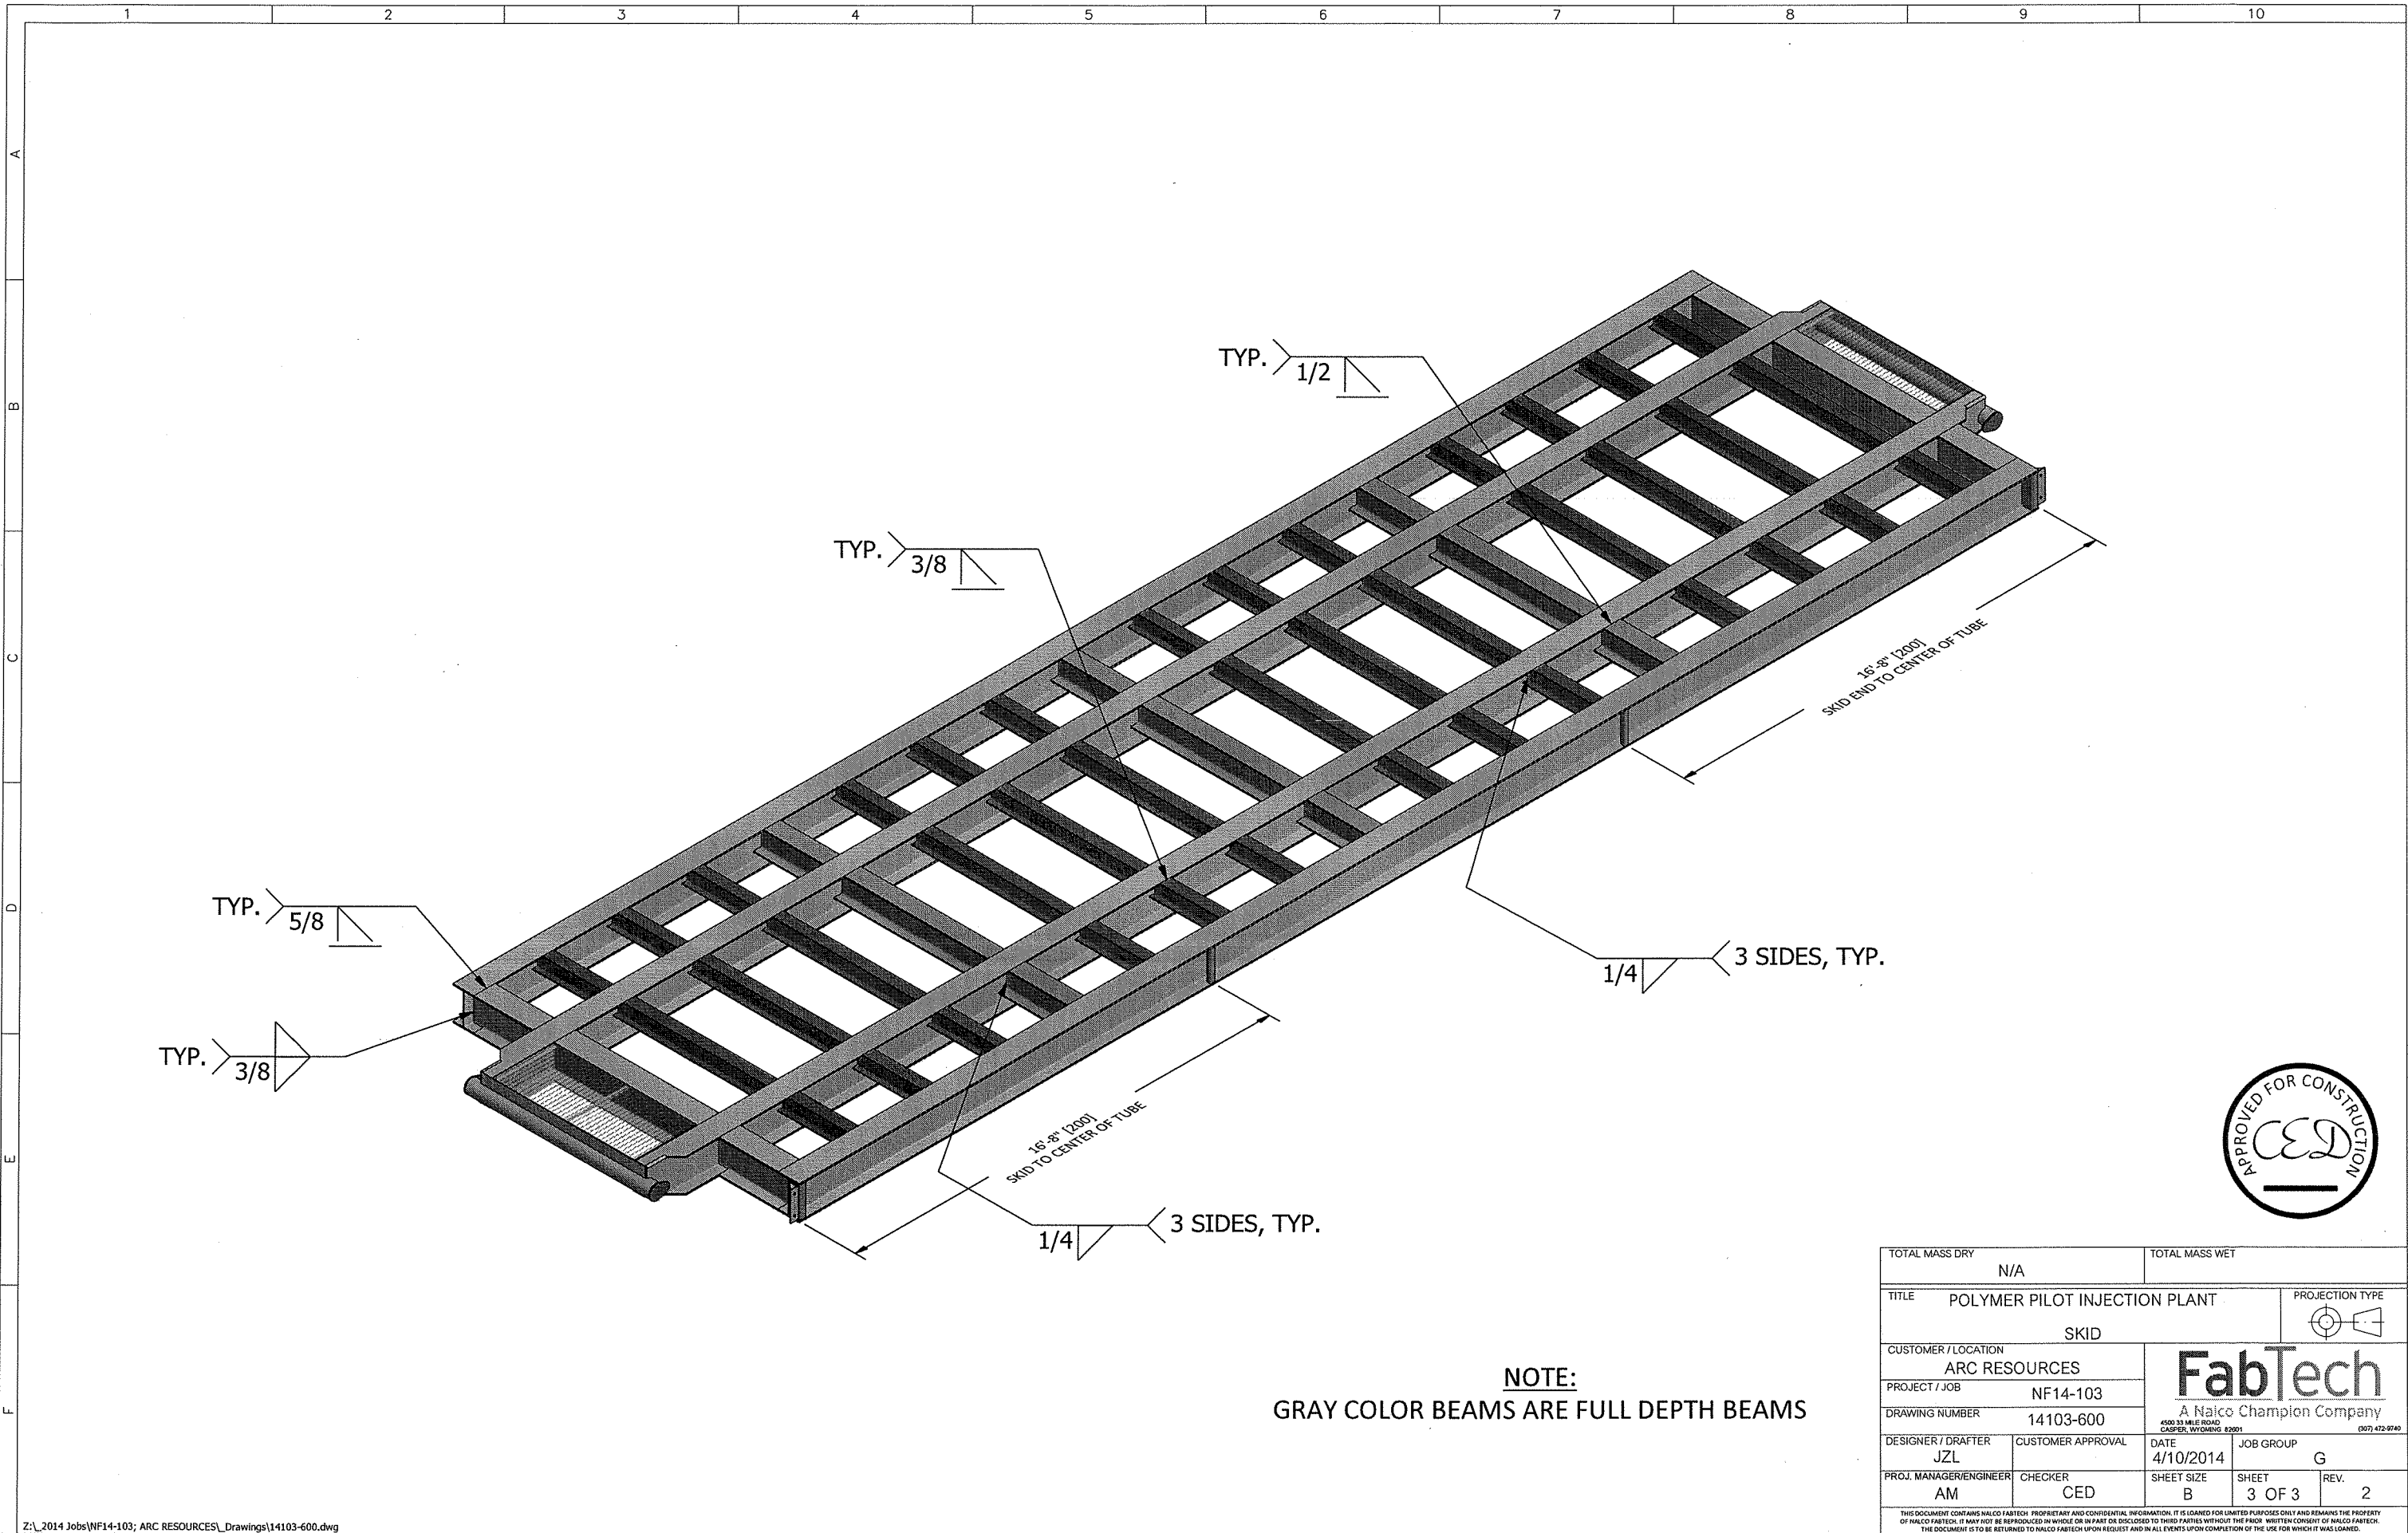


PILE SCHEDULE								
PILE NO.	PIPE SUPPORT-EQUIPMENT	NO. PILE REQUIRED	PILE INFORMATION					REMARKS
			PILE TYPE	DIAMETER	CAP PLATE	EMBEDMENT LENGTH	TOTAL LENGTH	
P-101 THRU P-115	INJECTION BUILDING	15	TYPE B	219	PL 20x370x370	13500	14500	

LEGEND
P-115
PILE NUMBER

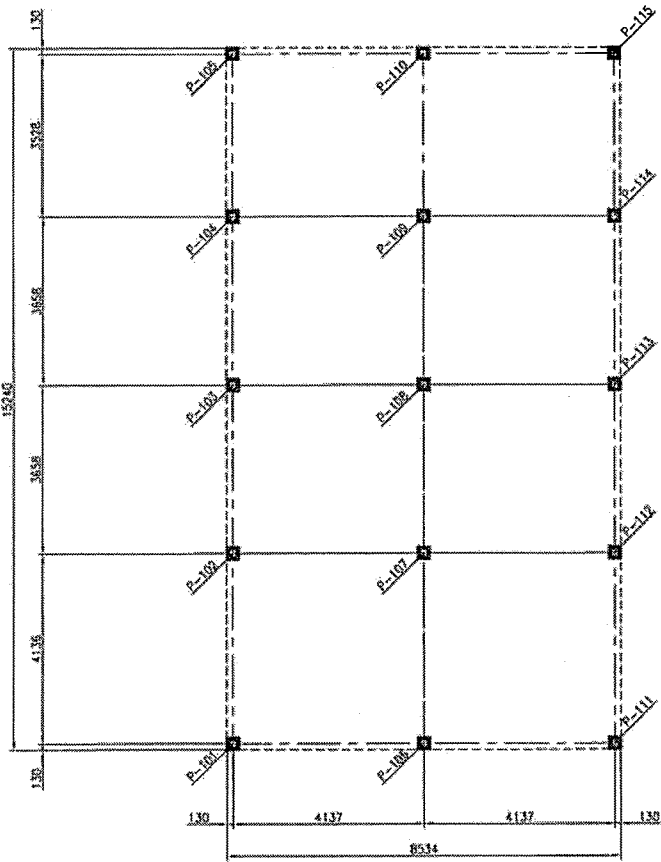

NOTES:
1. FOR GENERAL PIPING NOTES SEE PILING NOTES AND DETAILS DRAWINGS.

PERMIT:

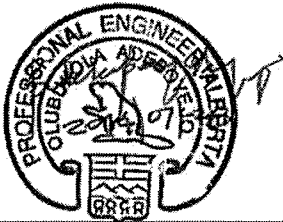

REV.	DESCRIPTION	BY	DATE	CHK	APP.	CLIENT
0	ISSUED FOR CONSTRUCTION	SP	2014-07-28			

DRAWN BY:	DATE
SP	2014-07-28
DESIGNED BY:	DATE
OA	2014-07-28
CHECKED BY:	DATE
OA	2014-07-28
APPROVED BY:	DATE
CLIENT BY:	DATE

TITLE			
PEMBINA POLYMER BUILDING LSD			
PILE LOCATION PLAN			
SCALE	JOB NO.	DRAWING NO.	REV.
1:75	14050	STR-001	0








GENERAL PILING NOTES

1. ALL WORK SHALL CONFORM TO THE LATEST EDITIONS OF THE FOLLOWING CODES AND STANDARDS:
-NATIONAL BUILDING CODE OF CANADA
-APPLICABLE CSA STANDARDS
2. NO GEOTECHNICAL INVESTIGATION WAS CARRIED OUT BY OWNER, DESIGN IS BASED ON ENGINEER'S EXPERIENCE.
3. ALL UNDERGROUND AND OVERHEAD SERVICES SHALL BE LOCATED BEFORE PILING BEGINS. LOCATION OF ALL UNDERGROUND SERVICES SHALL BE COORDINATED BETWEEN THE CONTRACTOR AND OWNER. ALL UNDERGROUND SERVICES WITHIN 2000mm OF A PILE LOCATION SHALL BE EXPOSED BY HAND DIGGING OR WATER JET AS DIRECTED BY THE OWNER.
4. STEEL PIPE PILES SHALL BE OF NEW STOCK AND SHALL HAVE A MINIMUM WALL THICKNESS EQUIVALENT TO SCHEDULE 40 AND HAVE A MINIMUM YIELD STRESS OF 240 MPa. PILES SHALL BE CLEAN AND FREE OF ALL PROTECTIVE SURFACE COATINGS, OIL, GREASE AND SOIL.
5. WHEREVER PRACTICAL, THE PILES SHALL BE PLACED IN ONE UNSPLICED LENGTH. THERE SHALL BE A MAXIMUM OF TWO SPLICES PER PILE. WHEN NECESSARY, SPLICES FOR STEEL PILES SHALL BE WELDED AND SHALL BE BEVELLED BUTT WELDS CAPABLE OF DEVELOPING THE FULL STRENGTH OF THE PILE SECTION.
6. STEEL PILES SHALL BE PLACED TO A TOLERANCE OF 75mm LATERALLY, WITHIN 2 PERCENT OF PLUMB, SHALL NOT BE STRUCTURALLY DAMAGED AND SHALL NOT HEAVE MORE THAN 6mm DURING PLACING OF ADJACENT PILES.
7. PILES SHALL BE DRIVEN OPEN ENDED.
8. PILES SHALL BE DRIVEN CONTINUOUSLY WITHOUT INTERRUPTION TO THE DEPTHS SHOWN ON THE DRAWING AND, IF INDICATED IN THE PILE SCHEDULE, UNTIL THE MINIMUM BLOW COUNT (BLOWS PER 300mm OR THE LAST 300mm) IS OBTAINED OR UNTIL REFUSAL. IF REFUSAL IS NOT DEFINED IN THE SOILS REPORT, IT SHALL BE DEFINED AS 20 BLOWS PER 250mm FOR THE LAST 300mm. IF REFUSAL IS NOT BEFORE THE SPECIFIED DEPTH IS REACHED THE ENGINEER SHALL BE NOTIFIED TO PROVIDE ALTERNATIVE DESIGN.
9. PILES SHALL BE DRIVEN USING THE DRIVING ENERGIES SHOWN BELOW. A PROPER CUSHION SHALL BE PROVIDED BETWEEN THE HAMMER AND THE PILE.


PILE DIA (mm)	DRIVING ENERGY (JOULES)
168	25,000
219	30,000
273	35,000
324	45,000
406	60,000

10. THE SUBCONTRACTOR SHALL MAINTAIN COMPLETE PILE INSTALLATION RECORD FOR EACH PILE DRIVEN. ONE COPY OF THESE RECORDS SHALL BE SENT TO THE ENGINEER WITHIN ONE WEEK OF DRIVING.
11. PILE CAP PLATES SHALL BE LOCATED EXACTLY AS SHOWN IN THE PLAN. CENTERLINES OF PILE AND CAP PLATE SHALL BE WITHIN 75mm IN BOTH NORTH-SOUTH AND EAST-WEST DIRECTIONS.
12. IF BEDROCK IS ENCOUNTERED, PRE-BORING OF PILOT HOLES INTO THE BEDROCK SHALL BE REQUIRED FOR PIPE PILES TO ACHIEVE A REQUIRED EMBEDMENT DEPTH. THE DIAMETER OF THE PRE-BORE SHALL BE 95% OF THE PILE DIAMETER. PRE-BORE LOGGING IS DEMONSTRATE THAT PREMATURE REFUSAL IS OCCURRING. IT MAY BE NECESSARY TO EXTRACT A PILE DUE TO PREMATURE REFUSAL IN PRE-BORED SUE. THEREFORE, IT IS RECOMMENDED TO DRIVE A TEST PILE IN A NON CRITICAL LOCATION UNTIL SUITABLE PRE-BORE DIAMETER IS ESTABLISHED.
13. IF CONDITIONS PREVENT THE WORK FROM BEING PERFORMED IN ACCORDANCE WITH THE DRAWINGS AND SPECIFICATIONS, CONTRACTOR SHALL NOTIFY THE ENGINEER IMMEDIATELY.
14. SKID BEAMS MUST BE WELDED TO PERIMETER PILES WITH FULL LENGTH 6mm FILLET WELDS MIN. TWO SIDES. VNU SKID BEAMS ARE TO BE WELDED TO ALL PILES WITH 12mm WELD.
15. FINISHED GRADE AROUND ALL BUILDINGS MUST GENTLY SLOPE AWAY FROM BUILDINGS.
16. ALL BEAMS AND PILES BELOW GRADE MUST BE COATED WITH COAL TAR EPOXY.

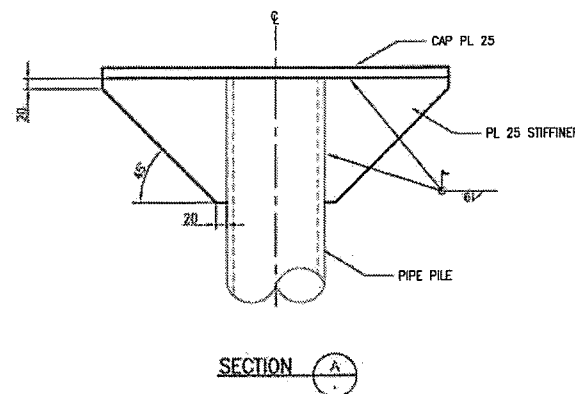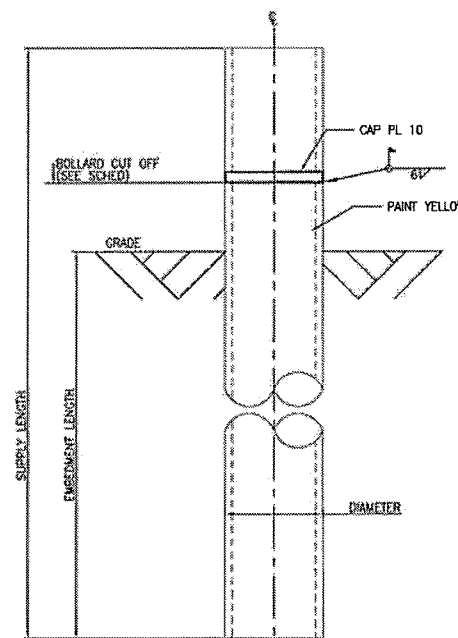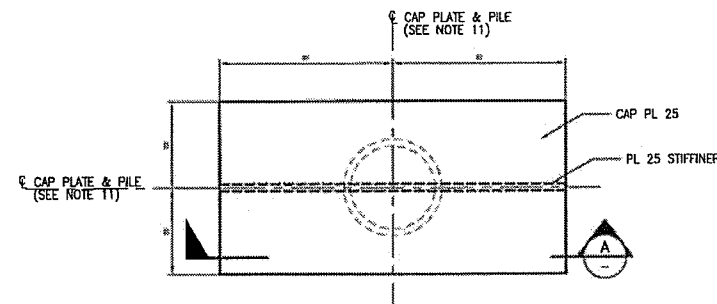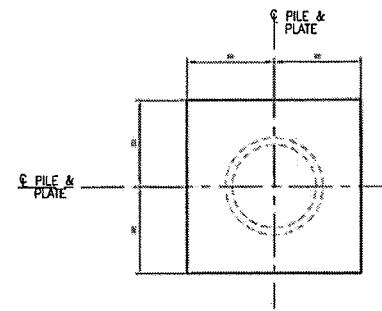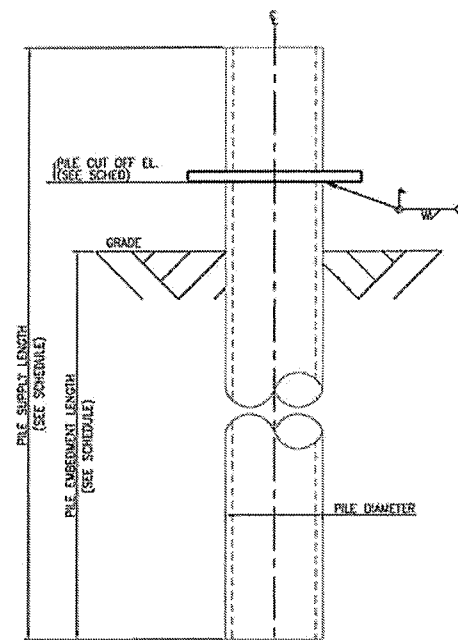

NOTES:

PERMIT:

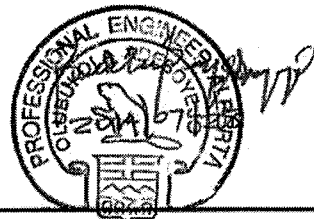

0	ISSUED FOR CONSTRUCTION	SP	2014-07-28		
REV.	DESCRIPTION	BY	DATE	CHK	APP. CLIP

DRAWN BY:	DATE
SP	2014-07-28
DESIGNED BY:	DATE
OA	2014-07-28
CHECKED BY:	DATE
OA	2014-07-28
APPROVED BY:	DATE
CLIENT BY:	DATE

28	TITLE
----	-------

PEMBINA POLYMER BUILDING
LSD

PILING NOTES AND DETAILS

SCALE
N.T.S.

JOB NO. 140

DRAWING NO.

EV.
0

