
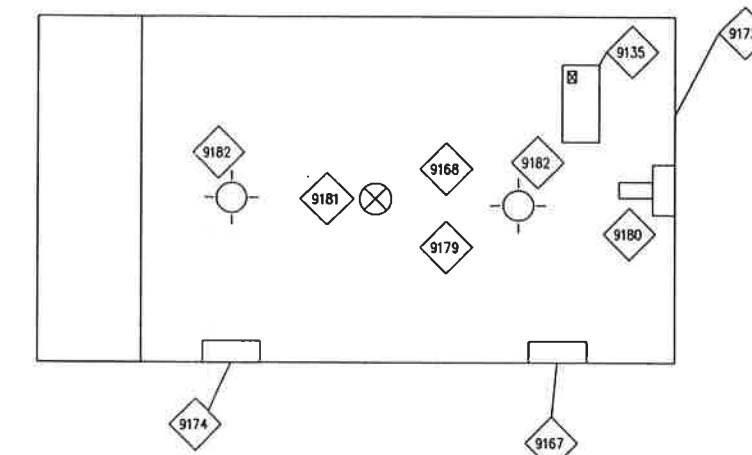


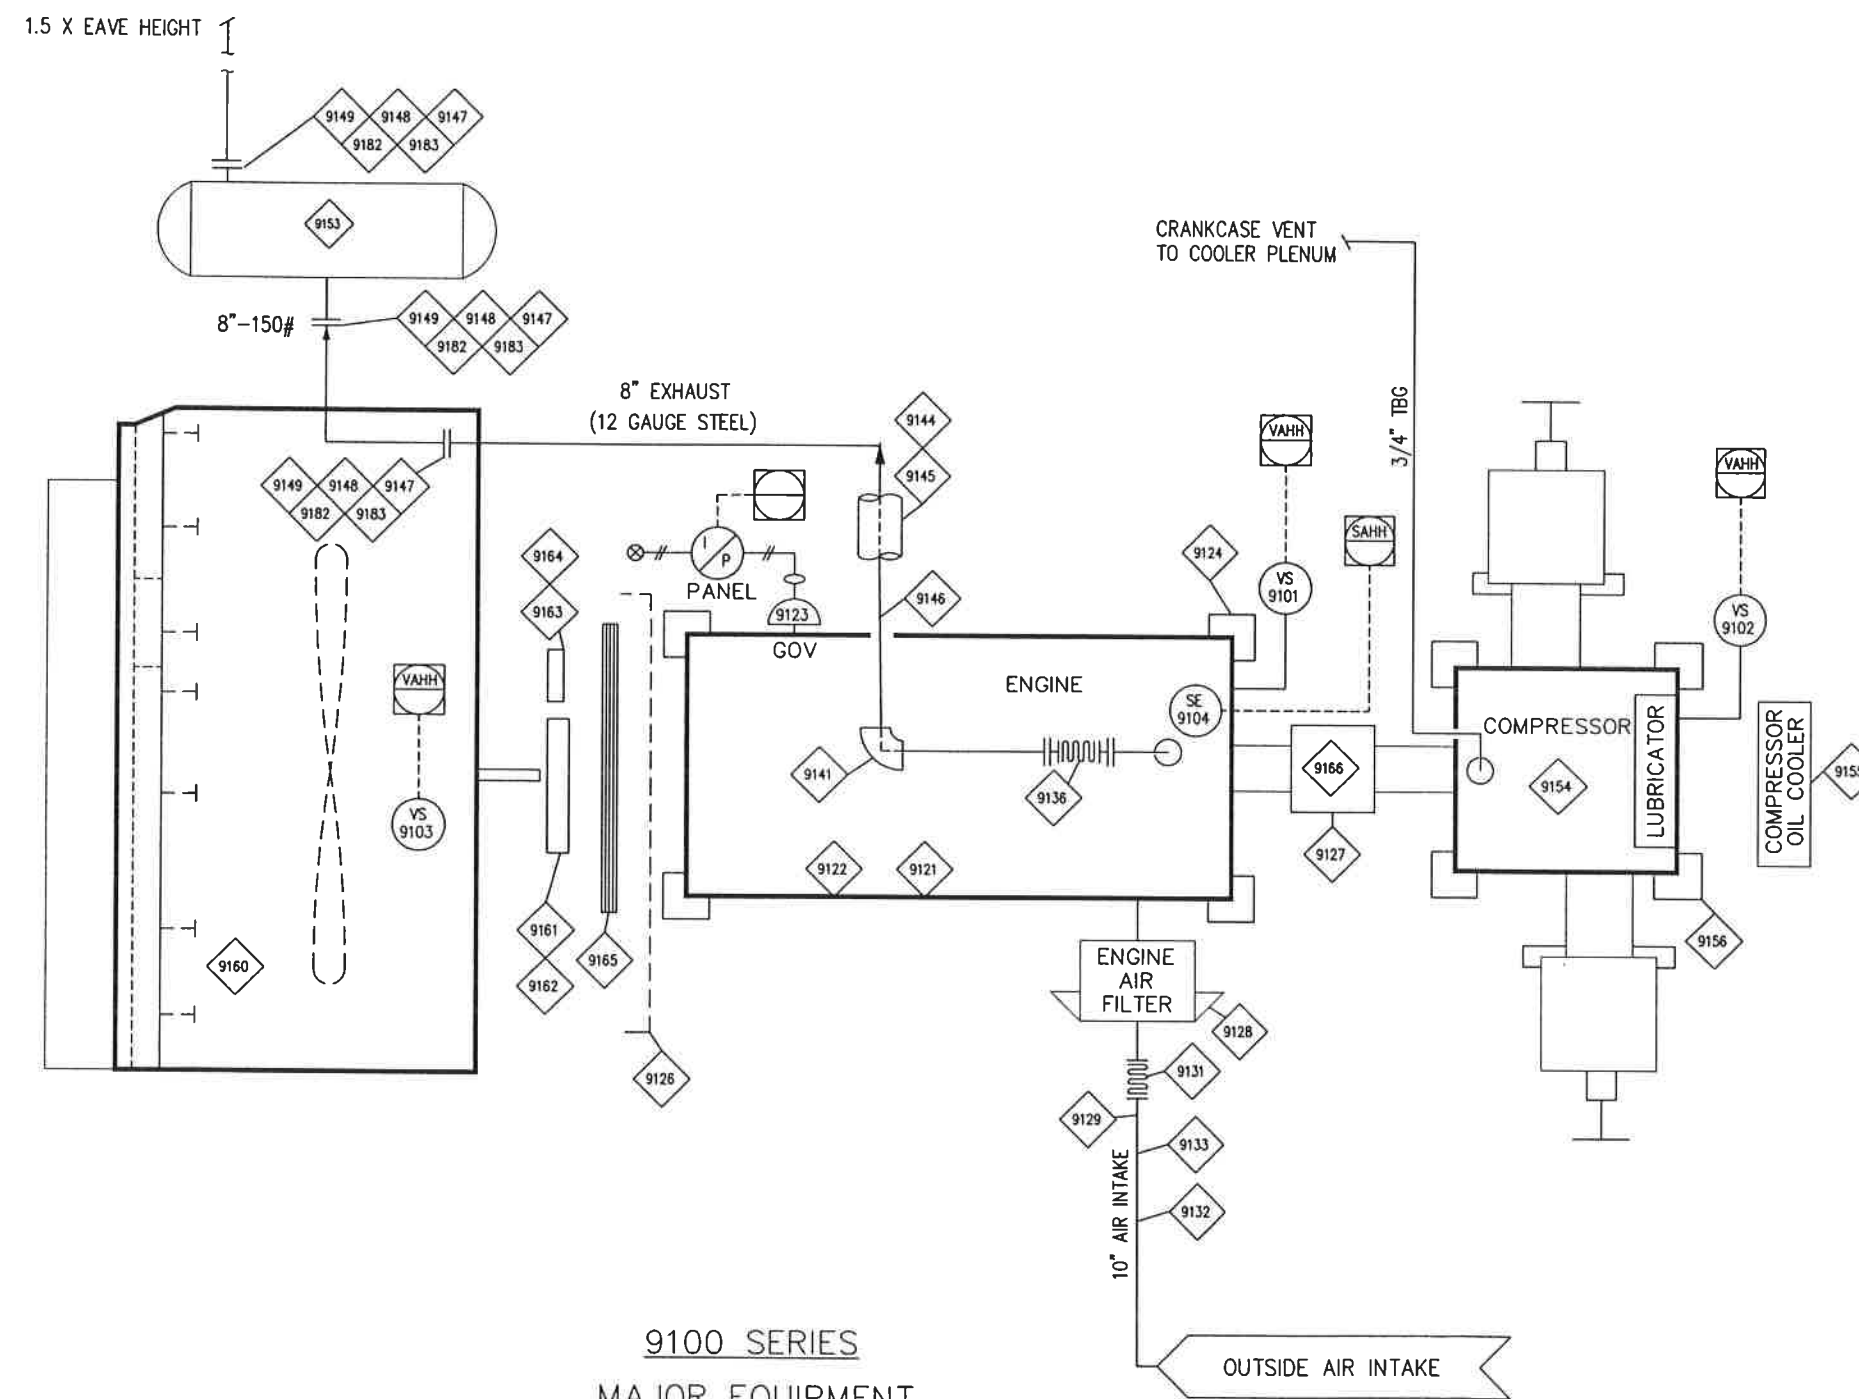

STRUCTURAL , BUILDING & ELECTRICAL

9100 SERIES
MAJOR EQUIPMENT

REV	DESCRIPTION	DATE	BY	CHK
2	AS BUILT	2/14/02	CJM	
1	GENERAL REVISIONS	1/18/02	LLP	
0	ISSUED FOR CONSTRUCTION	9/14/01	LLP	
REV	DESCRIPTION	DATE	BY	CHK

THIS DRAWING IS THE PROPERTY
OF HANOVER CANADA CORPORATION
AND IS NOT TO BE USED FOR ANY
PURPOSE OTHER THAN FOR WHICH
IT WAS INTENDED.



HANOVER CANADA
CORPORATION

HANOVER PLACE
500, 101-8TH AVE S.W.
CALGARY, ALBERTA T2P 5P6


MAIN: (403) 261-6501
FAX: (403) 266-1066
TOLL FREE 1-888-301-5452

ONE/TWO STAGE
COMPRESSOR PACKAGE
G3408TA/JGJ-2/84BVI

LEASE UNIT # 77359

MAJOR EQUIPMENT

2

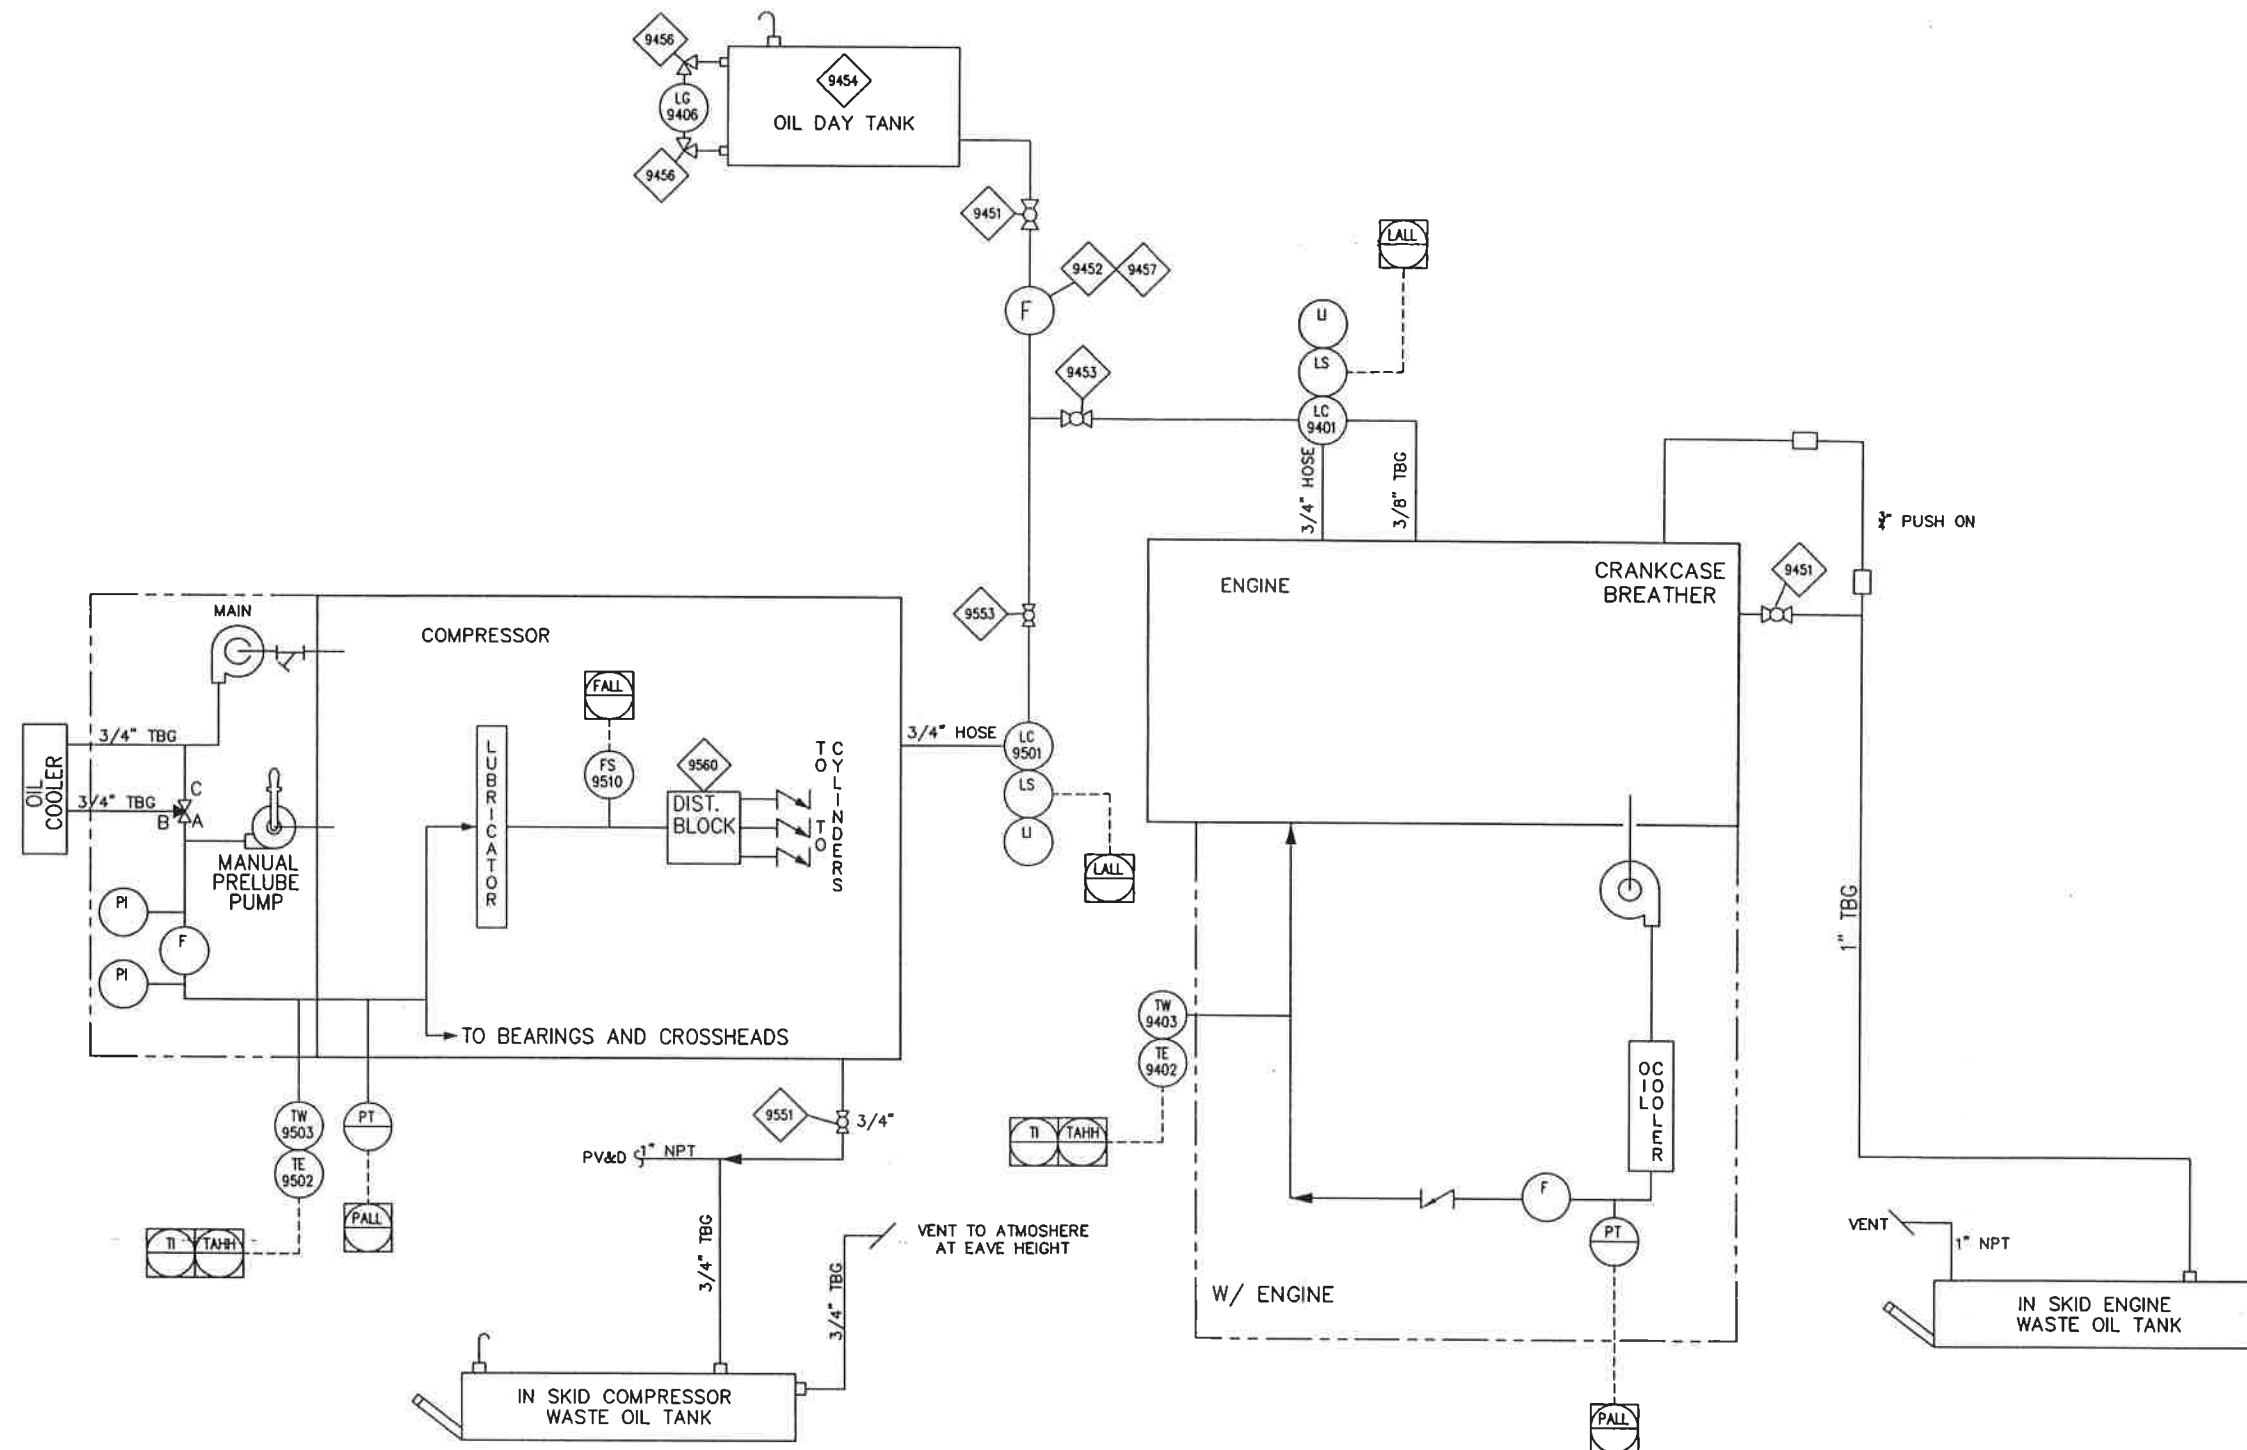


9500 SERIES
COMPRESSOR OIL UTILITIES

9400 SERIES
ENGINE OIL UTILITIES

					BY	DATE	 THE HANOVER COMPANY	HANOVER CANADA CORPORATION HANOVER PLACE 500, 101-6TH AVE. S.W. CALGARY, ALBERTA T2P 3P4 MAIN: (403) 261-6801 FAX: (403) 266-1066 TOLL FREE: 1-888-301-5452	ONE/TWO STAGE COMPRESSOR PACKAGE G3408TA/JGJ-2/84BVI
					L. PODLUBNY	9/14/01			
					D. DIEP	9/14/01			
					M. CRAWFORD	9/14/01			
2	AS BUILT	2/14/02	CJM		THIS DRAWING IS THE PROPERTY OF HANOVER CANADA CORPORATION AND IS NOT TO BE USED FOR ANY PURPOSE OTHER THAN FOR WHICH IT WAS INTENDED.			LEASE UNIT # 77359	OIL UTILITIES
1	GENERAL REVISIONS	1/17/02	LLP						
0	ISSUED FOR CONSTRUCTION	9/14/01	LLP						
REV	DESCRIPTION	DATE	BY	CHK					
REVISIONS									

SHORT 2 COMPARTMENT

VENT & DRAIN DETAIL
TWO COMPT. GUIDE
STYLE #2

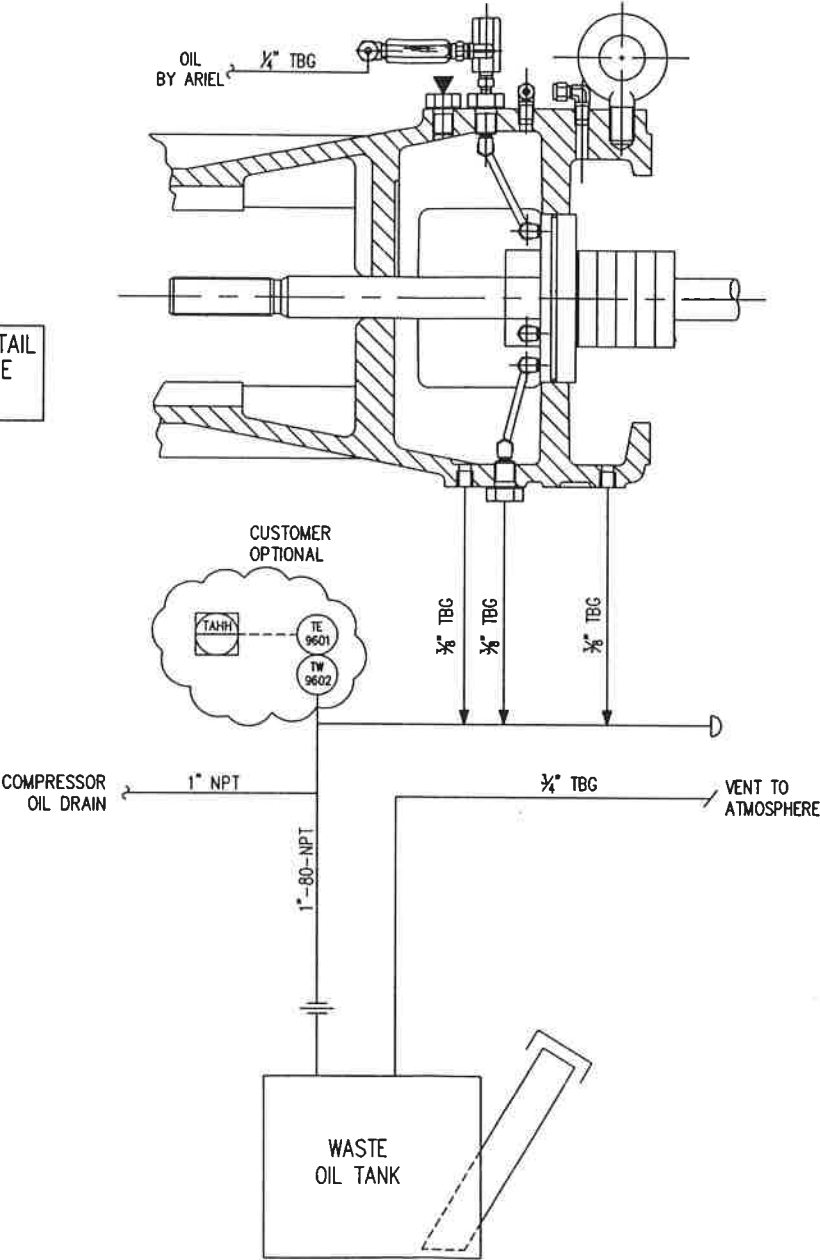

REV	DESCRIPTION	DATE	BY	CHK
2	AS BUILT	2/14/02	CJM	
1	GENERAL REVISIONS	1/17/02	LLP	
0	ISSUED FOR CONSTRUCTION	9/14/01	LLP	
REV	DESCRIPTION	DATE	BY	CHK

BY	DATE
L. PODLUBNY	9/14/01
D. DIEP	9/14/01
M. CRAWFORD	9/14/01
THIS DRAWING IS THE PROPERTY OF HANOVER CANADA CORPORATION AND IS NOT TO BE USED FOR ANY PURPOSE OTHER THAN FOR WHICH IT WAS INTENDED.	



HANOVER CANADA CORPORATION

HANOVER PLACE
500, 101-6TH AVE S.W.
CALGARY, ALBERTA T2P 3P4


MAIN: (403) 261-6801
FAX: (403) 266-1066
TOLL FREE: 1-888-301-5452

ONE/TWO STAGE COMPRESSOR PACKAGE G3408TA/JGJ-2/84BVI	
LEASE UNIT # 77359	
VENTS & DRAINS	2

OVERALL PACKAGE DIMENSIONS

LENGTH= 9630 mm
 WIDTH= 4166 mm
 HEIGHT= 4348 mm

*OVERALL WIDTH DOES NOT
 INCLUDE PULLOUTS

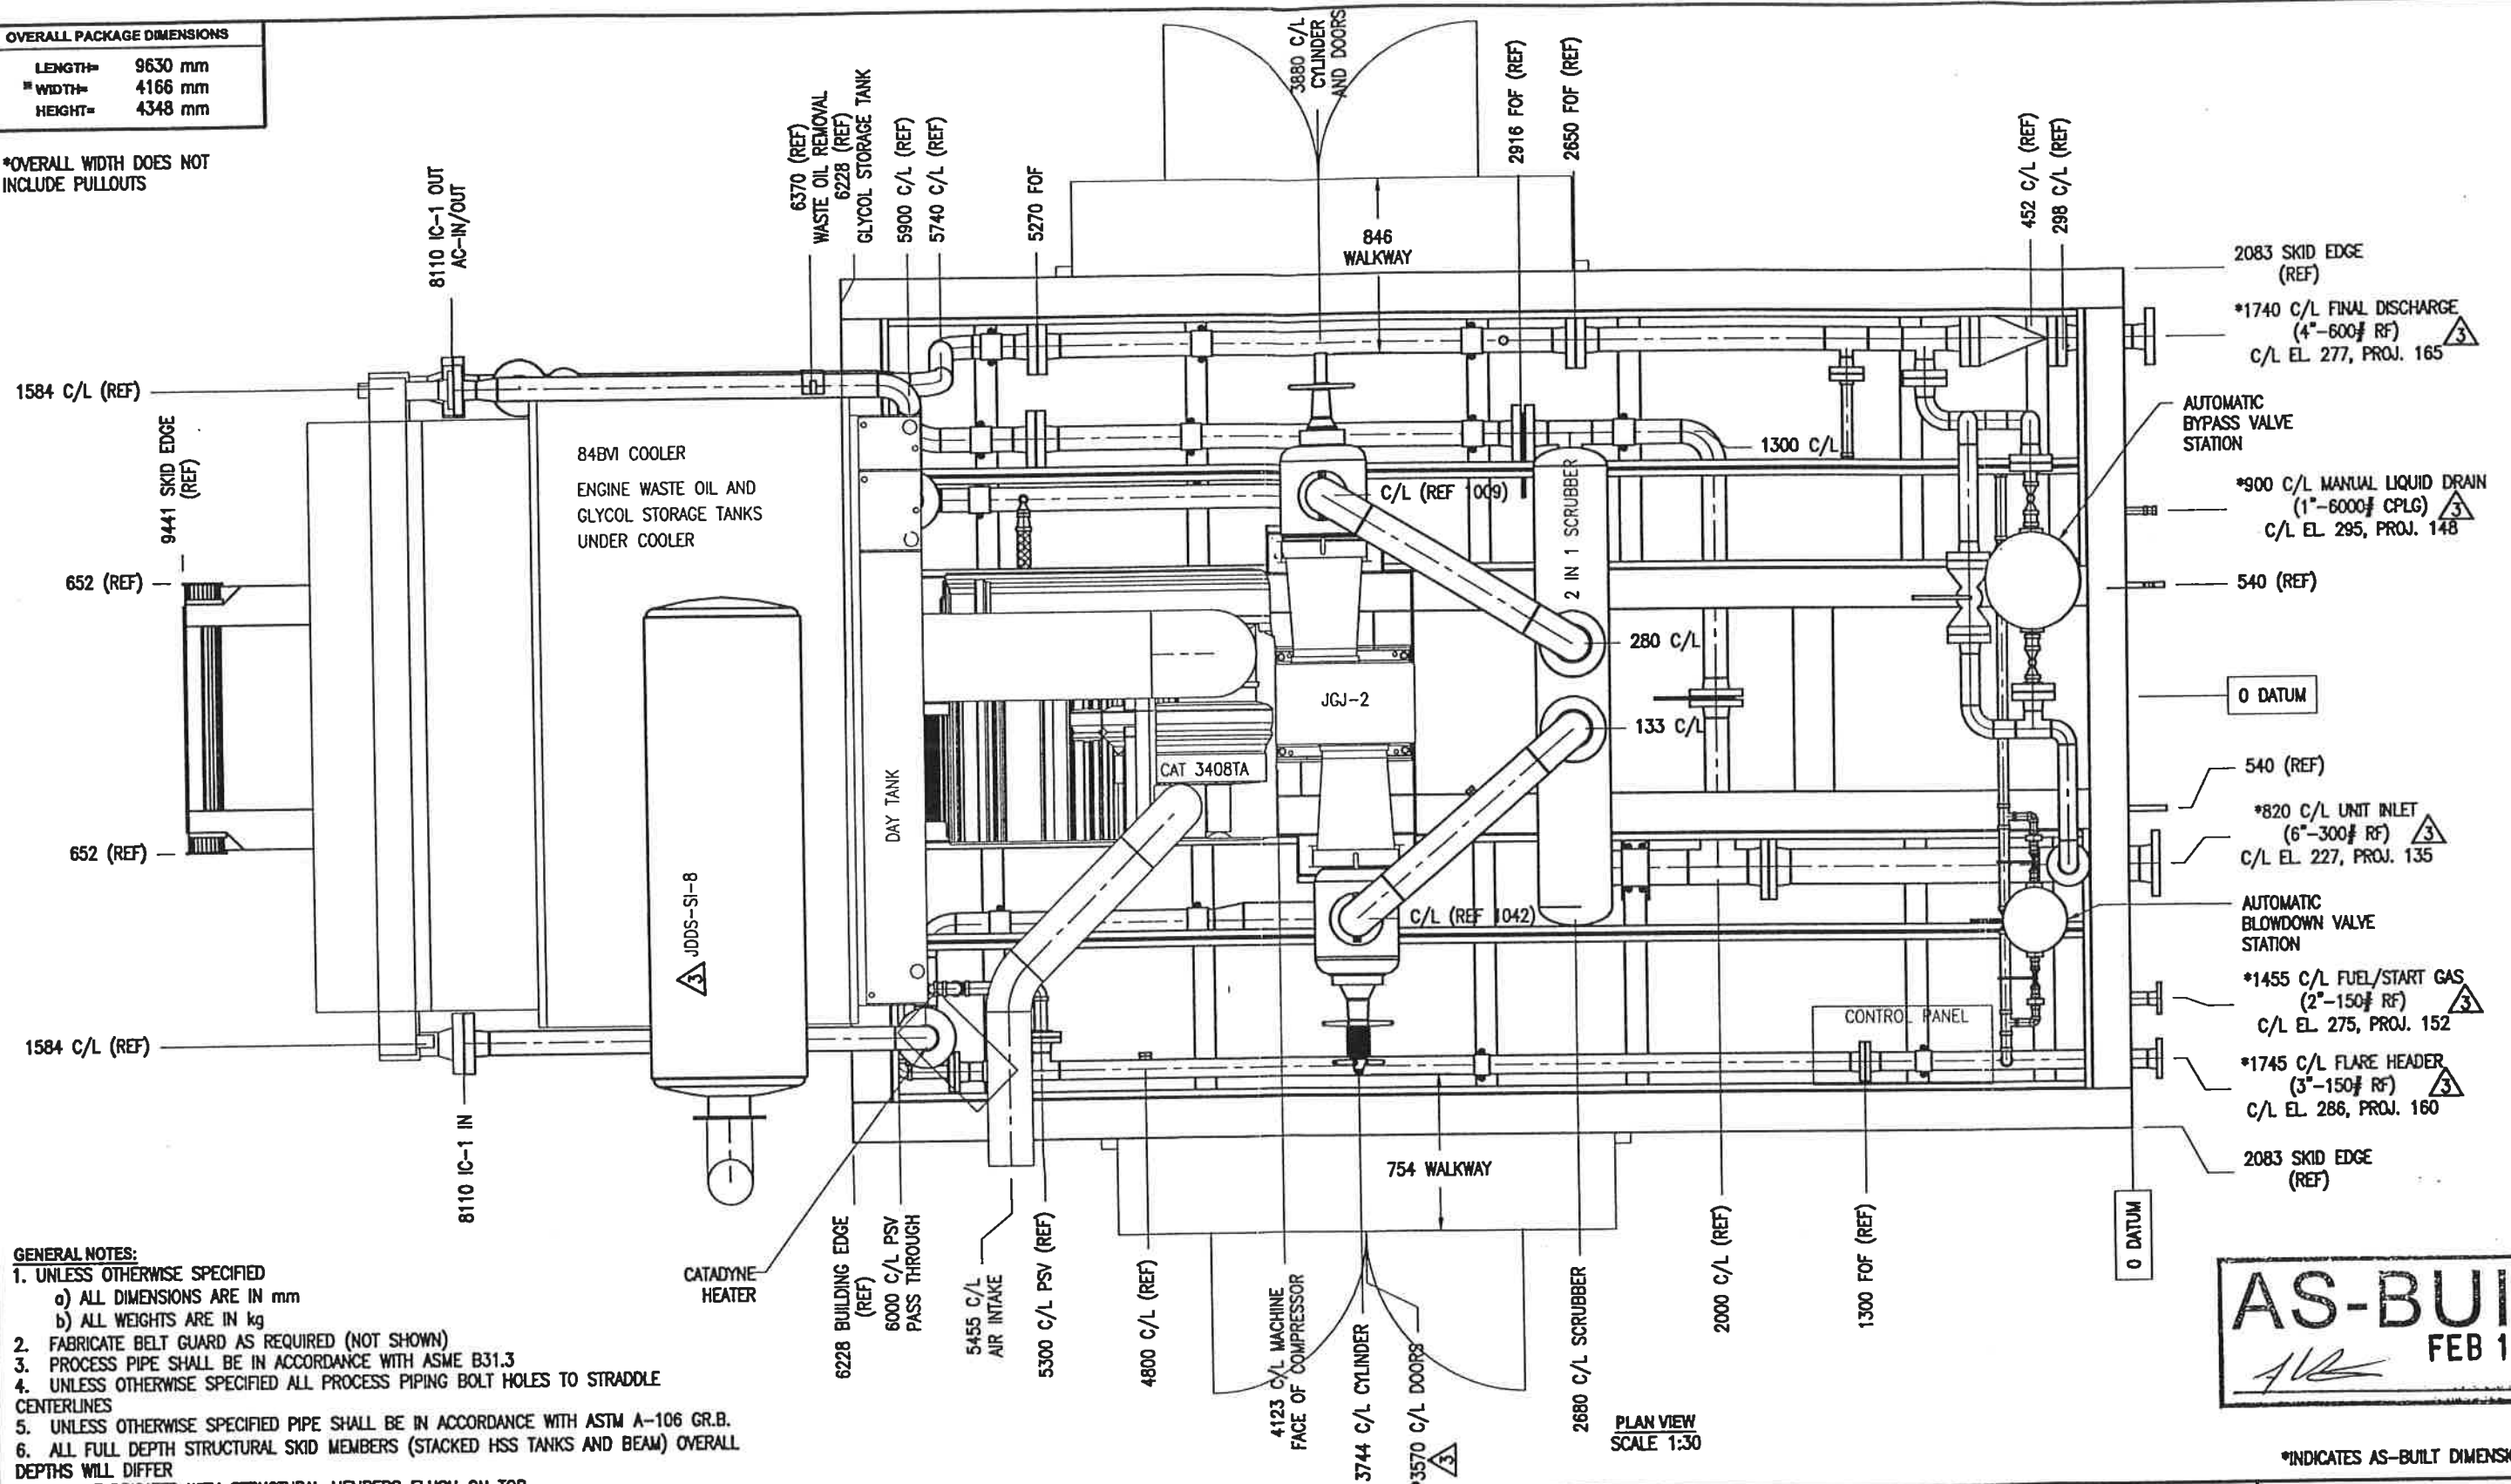

GENERAL NOTES:

- UNLESS OTHERWISE SPECIFIED
 - ALL DIMENSIONS ARE IN mm
 - ALL WEIGHTS ARE IN kg
- FABRICATE BELT GUARD AS REQUIRED (NOT SHOWN)
- PROCESS PIPE SHALL BE IN ACCORDANCE WITH ASME B31.3
- UNLESS OTHERWISE SPECIFIED ALL PROCESS PIPING BOLT HOLES TO STRADDLE CENTERLINES
- UNLESS OTHERWISE SPECIFIED PIPE SHALL BE IN ACCORDANCE WITH ASTM A-106 GR.B.
- ALL FULL DEPTH STRUCTURAL SKID MEMBERS (STACKED HSS TANKS AND BEAM) OVERALL DEPTHS WILL DIFFER
- SKID FABRICATED WITH STRUCTURAL MEMBERS FLUSH ON TOP

MAJOR EQUIPMENT							
COMPRESSOR	JGJ-2						
CROSSHEAD GUIDE	CAT 3408TA			3	AS-BUILT	02.01.02	DBT
CYL BORE/MODEL	5-1/8" RJ			2	ADDED PULLOUTS AND DISCHARGE VALVE	01.23.02	SMC D.D.
CYL BORE/MODEL	7-3/8" RJ			1	REVISED CYLINDERS	01.17.02	CJM D.D.
CYL BORE/MODEL				0	ISSUE FOR CONSTRUCTION	08.29.01	MKW
DESCRIPTION	DRAWING	REV.	REV.	DESCRIPTION	DATE	BY	ENG
COUPLING	CMR450						

CUSTOMER
 CHC LEASE
 SOUTHWARD ENERGY

LOCATION

Collicutt Hanover

SERVICES LTD.
 CORPORATE OFFICE
 7550 EDGAR INDUSTRIAL DRIVE RED DEER, AB CANADA
 T4P 3R2 PHONE (403) 358-3200 FAX (403) 358-3210

DATE: 08.29.01
 BY: M. WHITE

DATE: 08.29.01
 BY: M. CRAWFORD

*INDICATES AS-BUILT DIMENSIONS

1-2 STAGE COMP PKG.
 GENERAL ARRANGEMENT
 3408TA / JGJ-2 / 84BV

FH218


2936B01

1/5

AS-BUILT

FEB 14 2002

THIS DRAWING IS THE PROPERTY OF COLLICUTT HANOVER SERVICES LTD. AND IS NOT TO BE USED FOR ANY PURPOSE OTHER THAN FOR WHICH IT IS INTENDED.

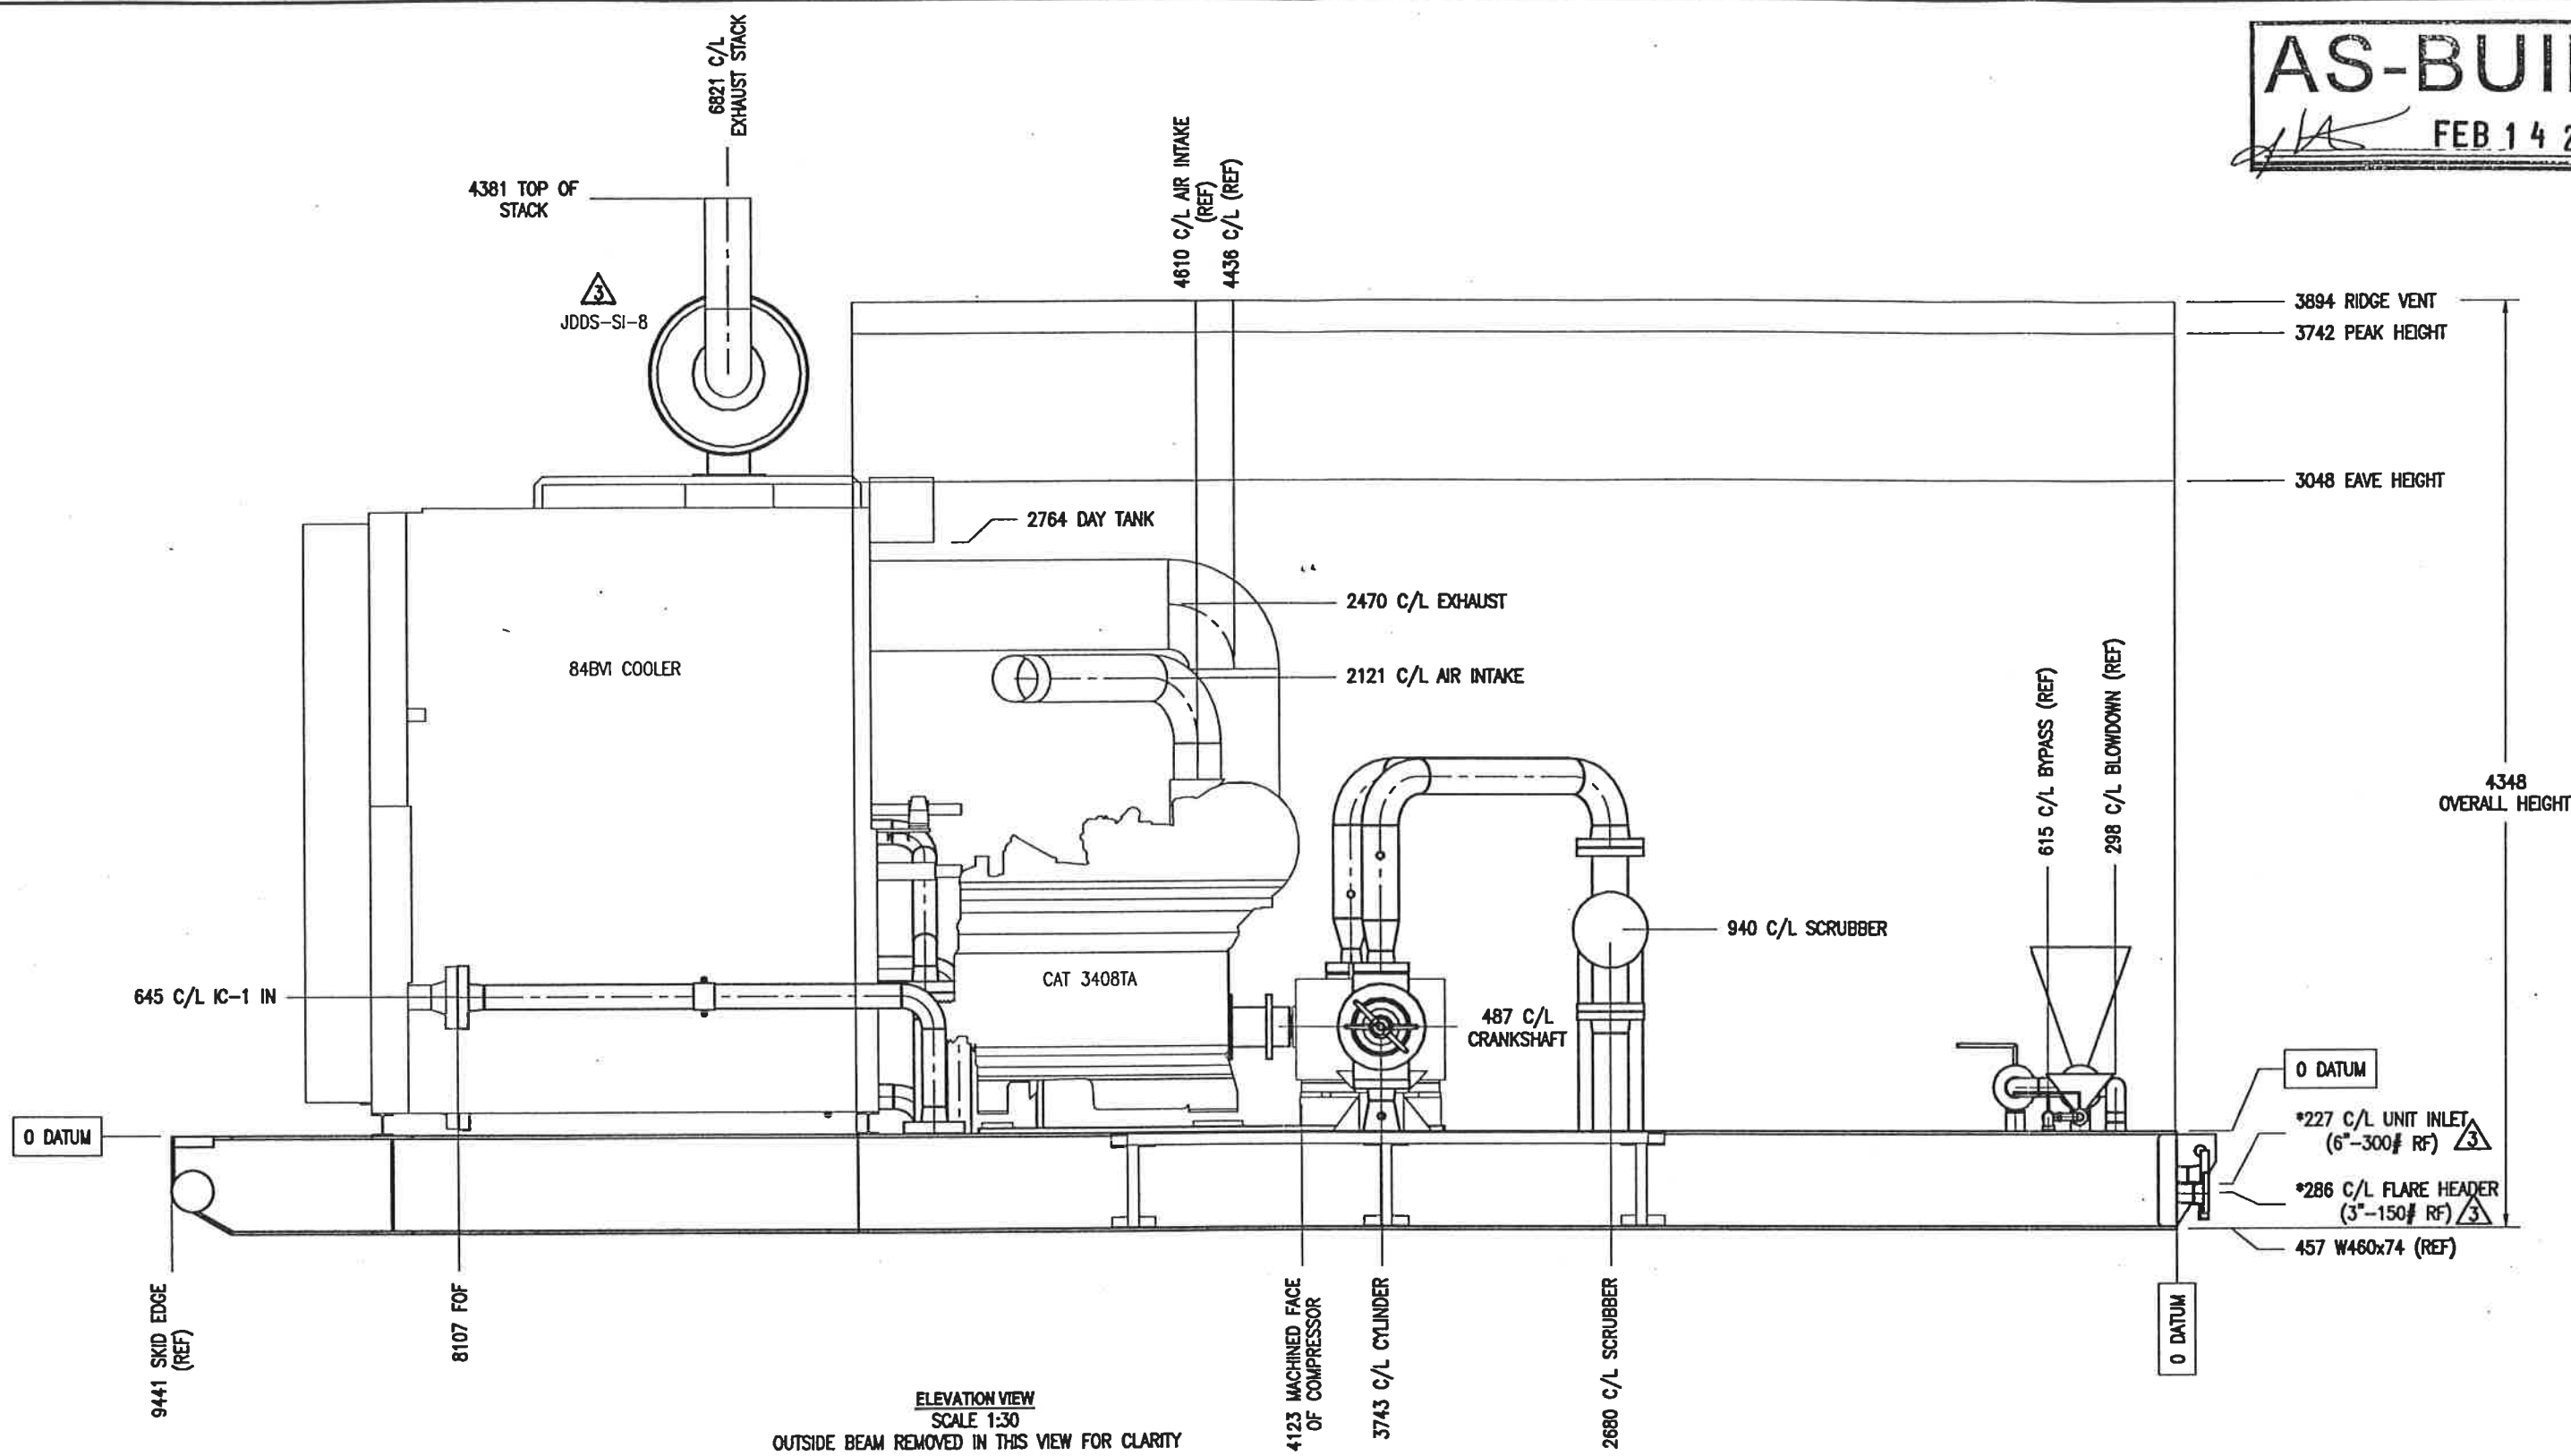

ELEVATION VIEW
 SCALE 1:30
 OUTSIDE BEAM REMOVED IN THIS VIEW FOR CLARITY

MAJOR EQUIPMENT										CUSTOMER				Collicutt Hanover SERVICES LTD. CORPORATE OFFICE 7550 EDGAR INDUSTRIAL DRIVE RED DEER, AB CANADA T4P 3R2 PHONE (403) 358-3200 FAX (403) 358-3210				1-2 STAGE COMP PKG. GENERAL ARRANGEMENT 3408TA / JGJ-2 / 84BVI				
COMPRESSOR	JGJ-2									CHC LEASE SOUTHWARD ENERGY												
CROSSHEAD GUIDE	CAT 3408TA			3	AS-BUILT	02.01.02	DBT															
CYL BORE/MODEL	5-1/8" RJ			2	ADDED PULLOUTS AND DISCHARGE VALVE	01.23.02	SMC	D.D														
CYL BORE/MODEL	7-3/8" RJ			1	REVISED CYLINDERS	01.17.02	CJM	D.D														
CYL BORE/MODEL				0	ISSUE FOR CONSTRUCTION	08.29.01	MKW			LOCATION	DATE 08.29.01	BY M. CRAWFORD	ENG D.DIEP	INITIALS	DATE 08.29.01	BY M. CRAWFORD	ENG D.DIEP	INITIALS				
CYL BORE/MODEL		DESCRIPTION	DRAWING	REV.	REV.	DESCRIPTION	DATE	BY	ENG										INITIALS			
COUPLING	CMR450	REFERENCE DRAWINGS			REVISIONS																	


THIS DRAWING IS THE PROPERTY OF COLLICUTT HANOVER SERVICES LTD. AND IS NOT TO BE USED FOR ANY PURPOSE OTHER THAN FOR WHICH IT IS INTENDED

AS-BUILT
FEB 14 2002

CUSTOMER CONNECTIONS SCHEDULE

SERVICE	SIZE	RATING	C/L DIM.	C/L EL.	PROJ.
FINAL DISCHARGE	4"	600# RF	1740	277	165
MANUAL LIQUID DRAIN	1"	5000# CPLG	900	295	148
UNIT INLET	6"	300# RF	820	227	135
FUEL & START GAS	2"	150# RF	1455	275	152
FLARE HEADER	3"	150# RF	1745	286	160


NOTE--: ALL DIMENSIONS ARE FROM DATUM AND AS-BUILT

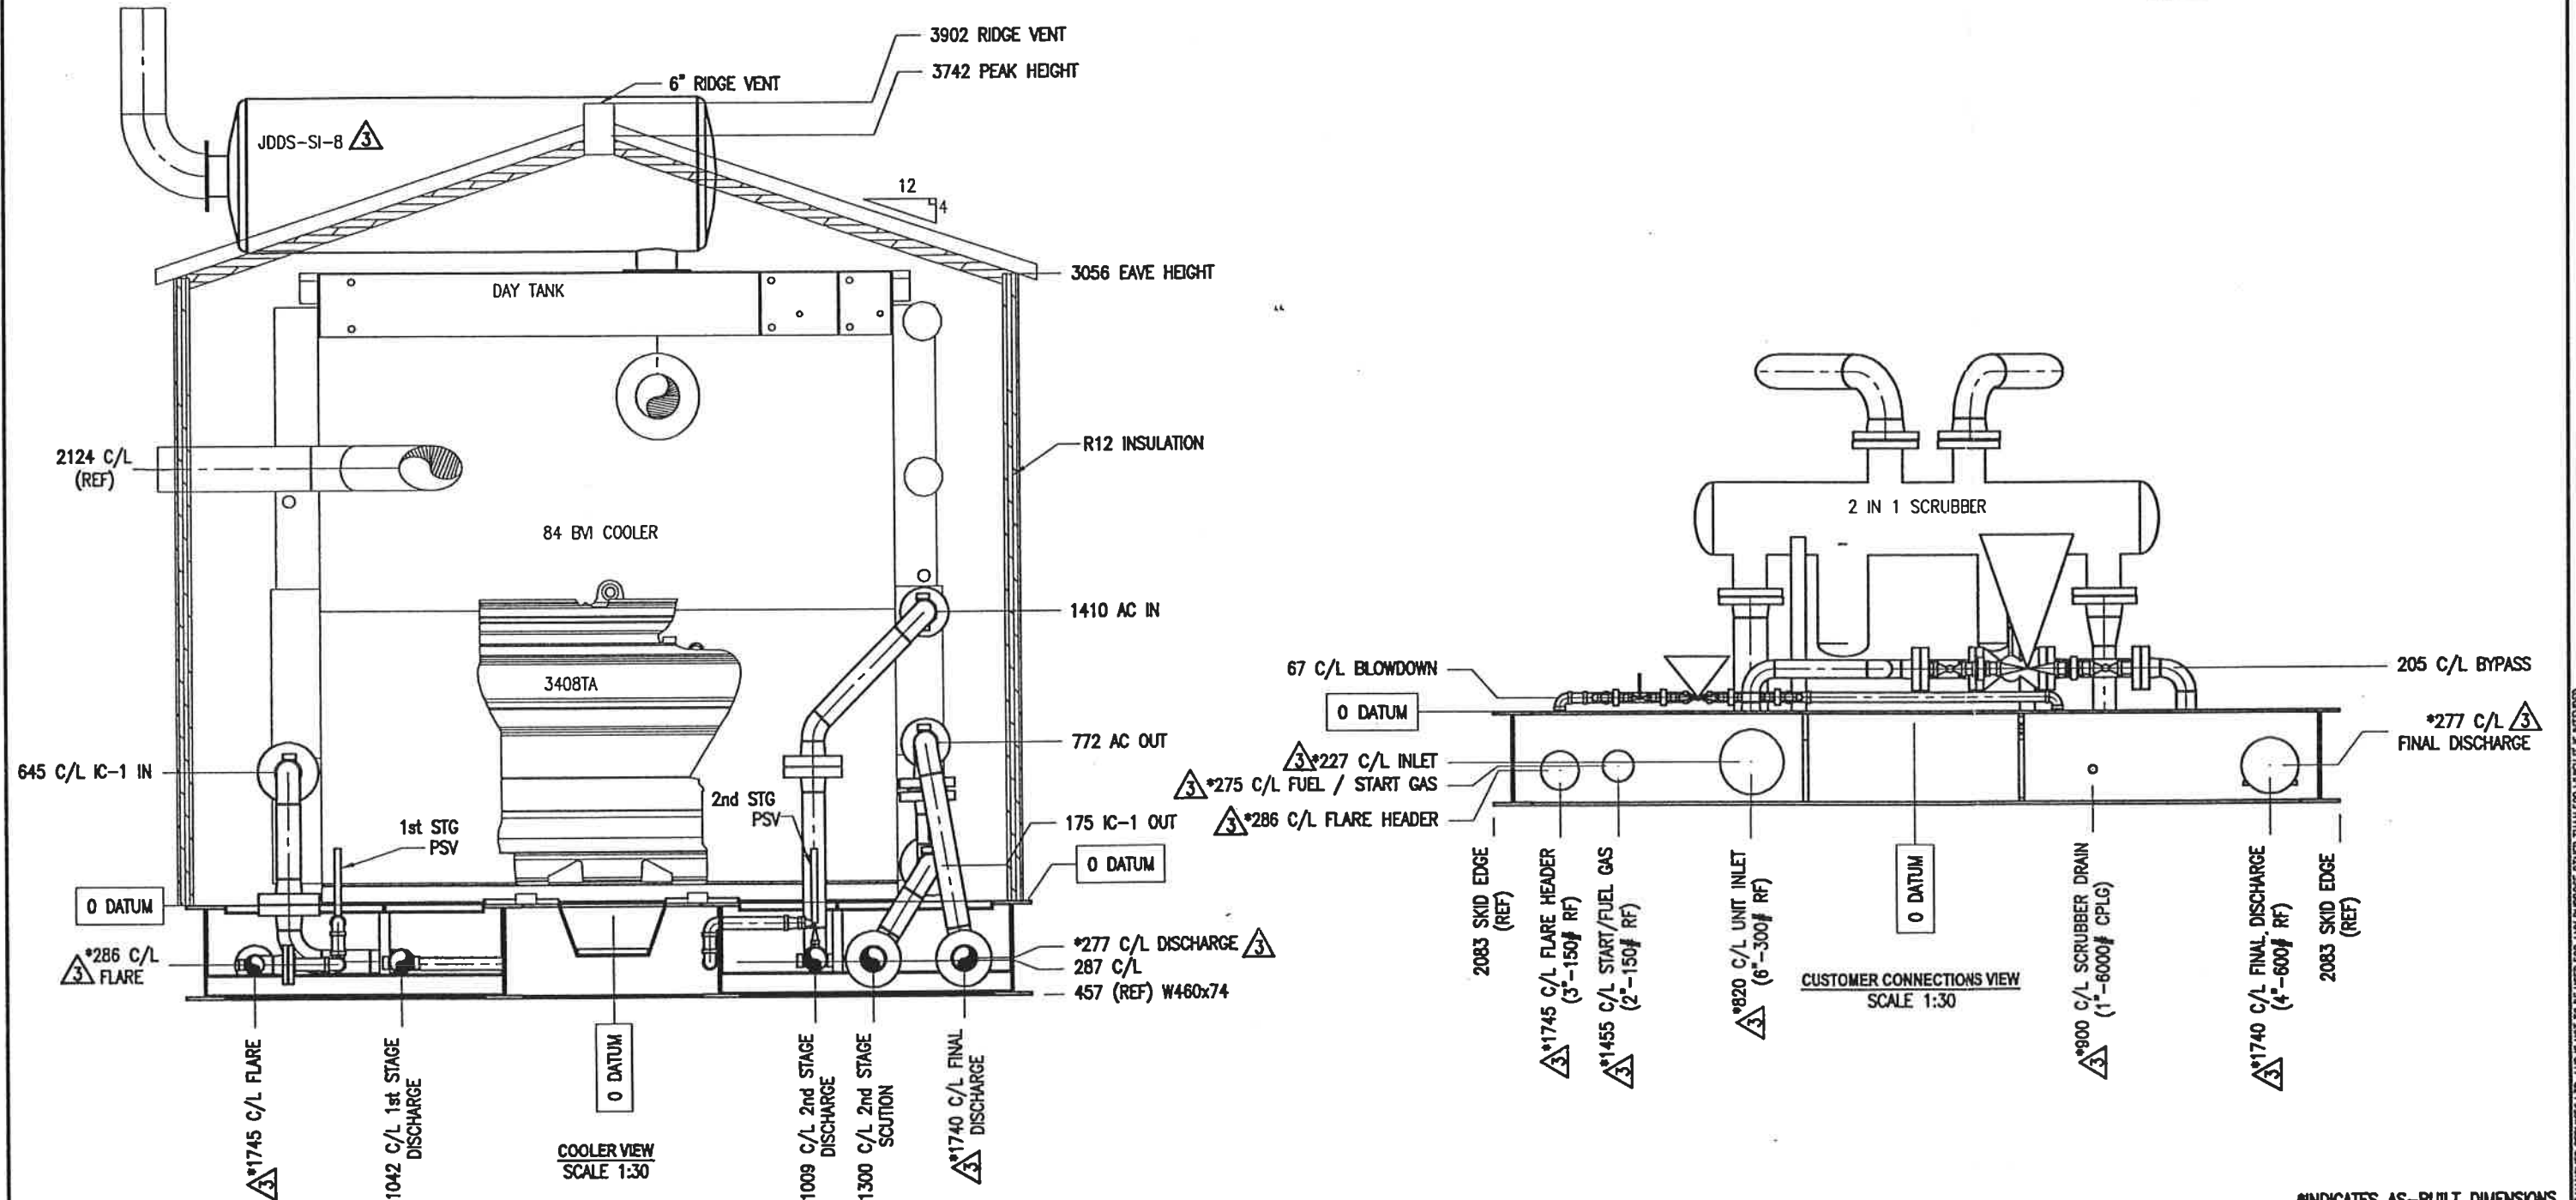

*INDICATES AS-BUILT DIMENSIONS

MAJOR EQUIPMENT																														CUSTOMER					Collicutt Hanover SERVICES LTD. CORPORATE OFFICE 7550 EDGAR INDUSTRIAL DRIVE RED DEER, AB CANADA T4P 3R2 PHONE (403) 358-3288 FAX (403) 358-3210					1-2 STAGE COMP PKG.					GENERAL ARRANGEMENT					3408TA / JGJ-2 / 84BVI																																																																																																																																																																																																																																																																																																																																																																																																																																																																																																																																																																																																																																																																																																																																																																																																																																																																																																																																																																																																																																																																																																																																																																																																																																																																																																																																																																																																																																																																																																																																																																																																																																																																																																																																																																															
COMPRESSOR	JGJ-2																																																																																																																																																																																																																																																																																																																																																																																																																																																																																																																																																																																																																																																																																																																																																																																																																																																																																																																																																																																																																																																																																																																																																																																																																																																																																																																																																																																																																																																																																																																																																																																																																																																																																																																																																																																																																																


AS-BUILT
FEB 14 2002

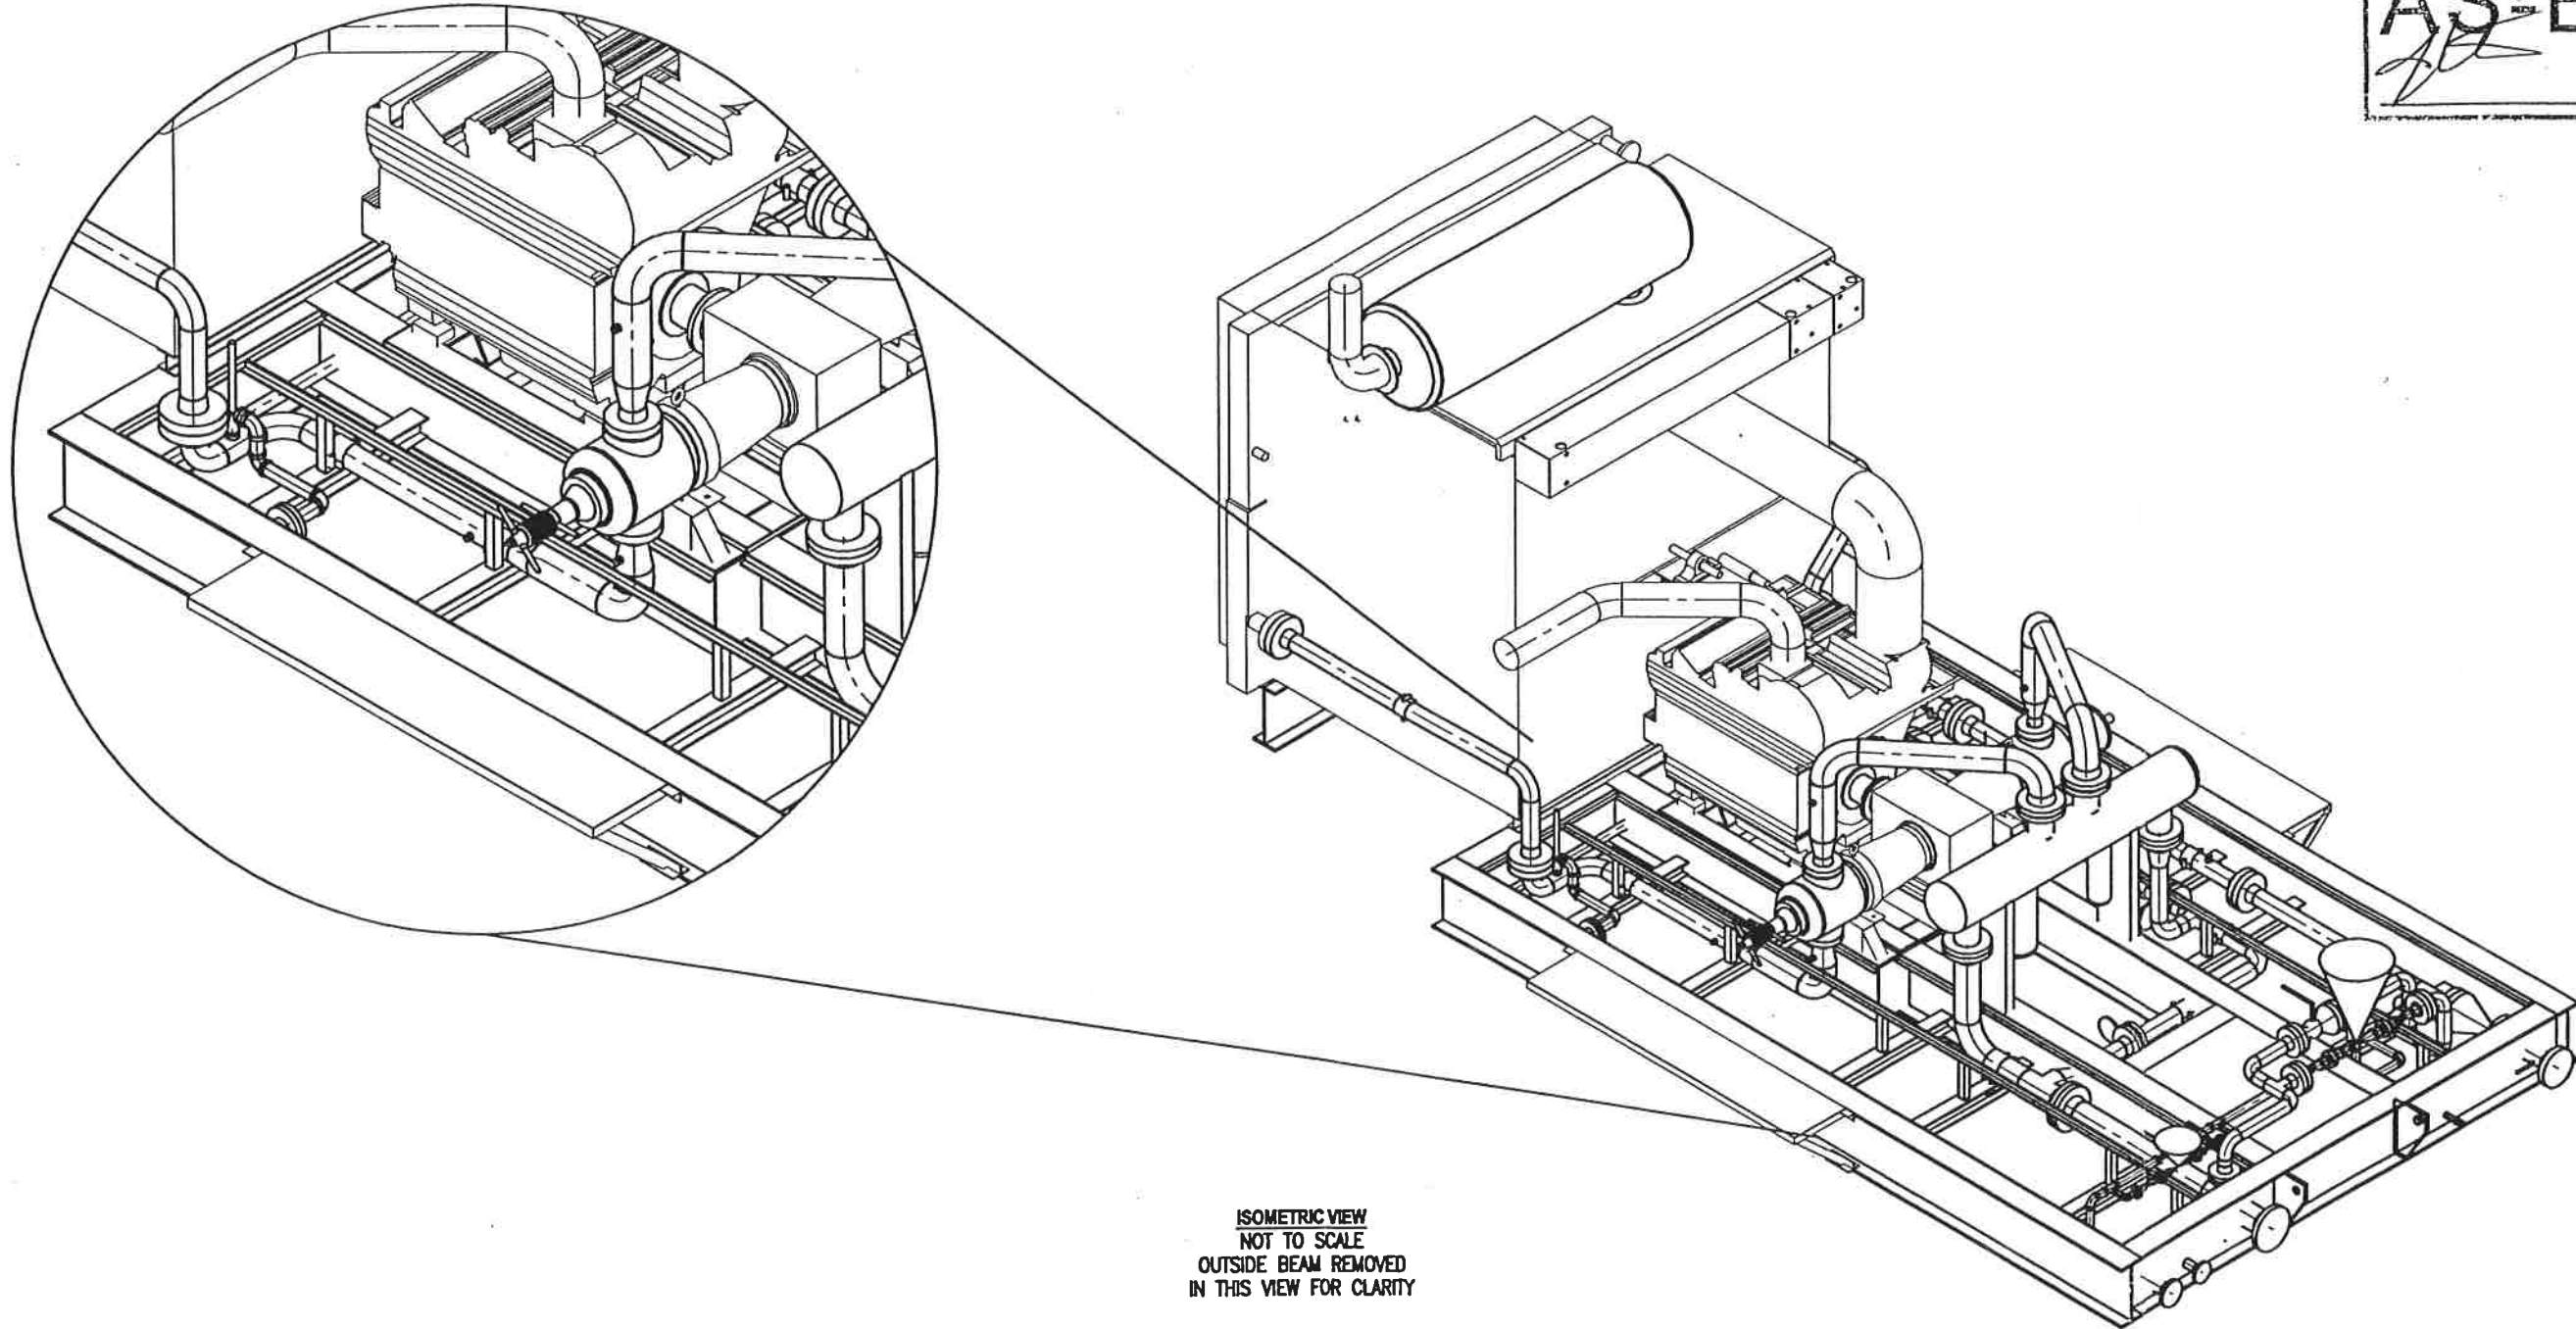

ISOMETRIC VIEW
NOT TO SCALE
OUTSIDE BEAM REMOVED
IN THIS VIEW FOR CLARITY

MAJOR EQUIPMENT										CUSTOMER CHC LEASE SOUTHWARD ENERGY				Collicutt Hanover SERVICES LTD. CORPORATE OFFICE 7550 EDGAR INDUSTRIAL DRIVE RED DEER, AB CANADA T4P 3R2 PHONE (403) 358-3200 FAX (403) 358-3210				1-2 STAGE COMP PKG. GENERAL ARRANGEMENT 3408TA / JGJ-2 / 84BV1			
COMPRESSOR	JGJ-2																				
CROSSHEAD GUIDE	CAT 3408TA			3	AS-BUILT	02.01.02	DBT														
CYL BORE/MODEL	5-1/8" RJ			2	ADDED PULLOUTS AND DISCHARGE VALVE	01.23.02	SMC	D.D.													
CYL BORE/MODEL	7-3/8" RJ			1	REVISED CYLINDERS	01.17.02	CJM	D.D.													
CYL BORE/MODEL				0	ISSUE FOR CONSTRUCTION	08.29.01	MKW														
CYL BORE/MODEL		DESCRIPTION	DRAWING	REV.	REV	DESCRIPTION	DATE	BY	ENG	INITIALS	LOCATION	DWG BY: M. WHITE	DWG DATE: 08.29.01	DRAWN BY: D.DIEP	DRAWN DATE: M. CRAWFORD	2936B01	REV 3				
COUPLING	CMR450	REFERENCE DRAWINGS			REVISIONS												FH218	4/5			

THIS DRAWING IS THE PROPERTY OF COLLECTIT HANOVER SERVICES LTD. AND IS NOT TO BE USED FOR ANY PURPOSE OTHER THAN FOR WHICH IT IS INTENDED

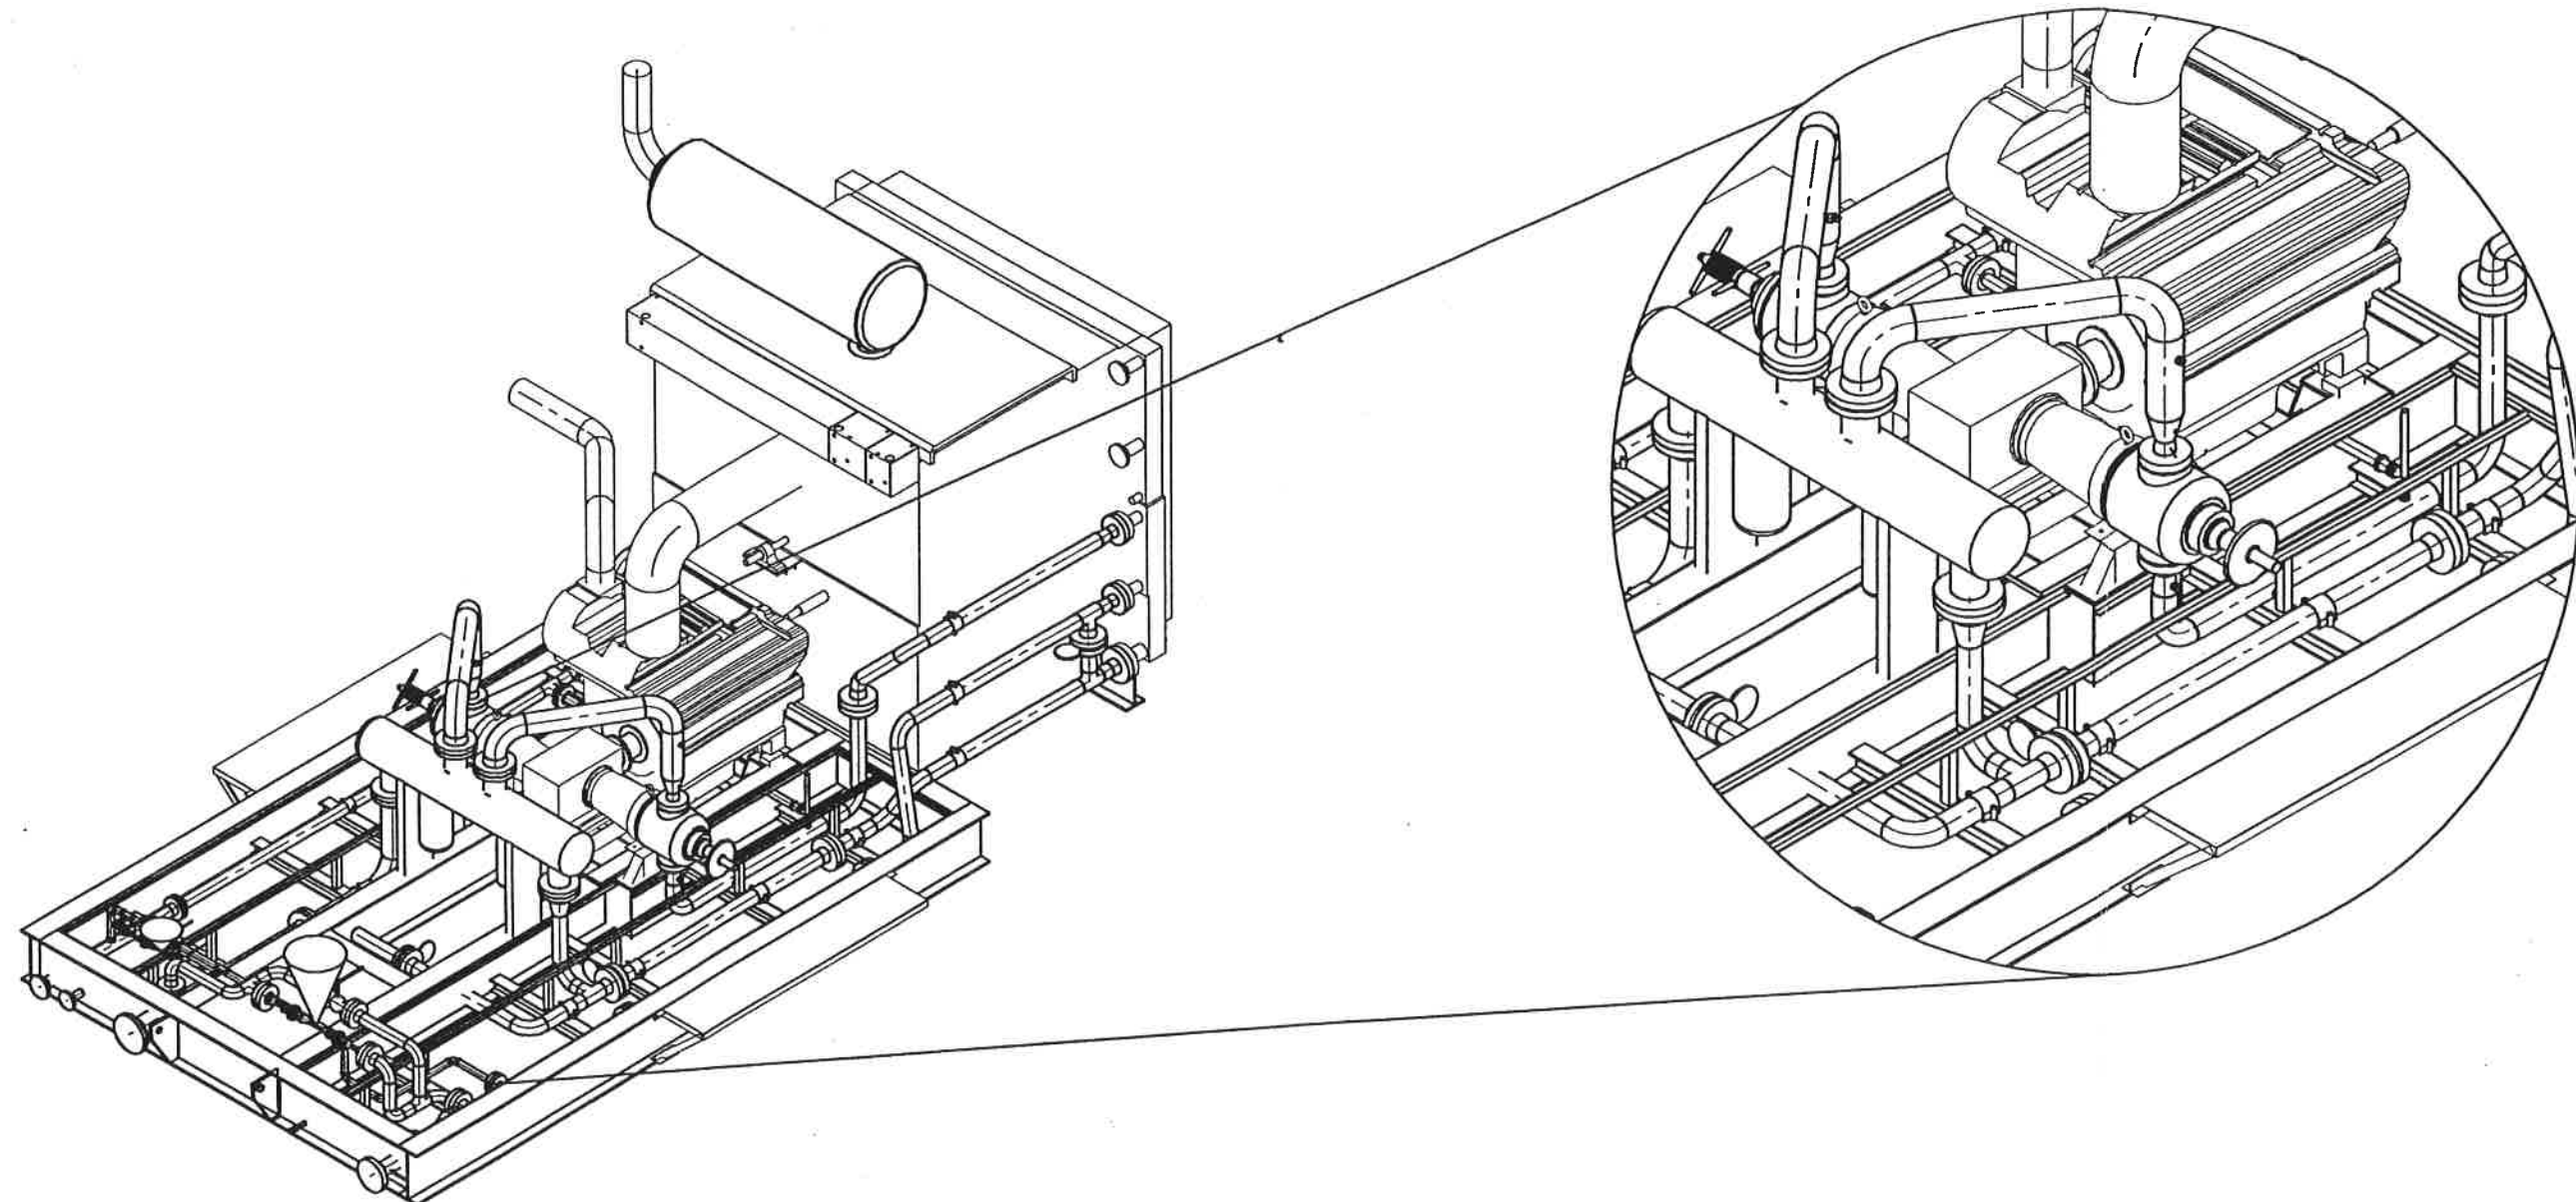

ISOMETRIC VIEW
NOT TO SCALE
OUTSIDE BEAM REMOVED IN
THIS VIEW FOR CLARITY

MAJOR EQUIPMENT										CUSTOMER CHC LEASE SOUTHWARD ENERGY		Collicutt Hanover SERVICES LTD. CORPORATE OFFICE 7550 EDGAR INDUSTRIAL DRIVE RED DEER, AB CANADA T4P 3R2 PHONE (403) 358-3200 FAX (403) 358-3210		1-2 STAGE COMP PKG. GENERAL ARRANGEMENT 3408TA / JGJ-2 / 84BVI					
COMPRESSOR	JGJ-2																		
CROSSHEAD GUIDE	CAT 3408TA			3	AS-BUILT	02.01.02	DBT												
CYL BORE/MODEL	5-1/8" RJ			2	ADDED PULLOUTS AND DISCHARGE VALVE	01.23.02	SMC	D.D.											
CYL BORE/MODEL	7-3/8" RJ			1	REVISED CYLINDERS	01.17.02	CJM	D.D.											
CYL BORE/MODEL				0	ISSUE FOR CONSTRUCTION	08.29.01	MKW												
CYL BORE/MODEL		DESCRIPTION	DRAWING	REV.	REV	DESCRIPTION	DATE	BY	ENG	INITIALS	LOCATION	DATE BY: M. WHITE	DATE: 08.29.01	DATE BY: D. DIEP	DATE: M. CRAWFORD	2936B01	FH218	5/	
COUPLING	CMR450	REFERENCE DRAWINGS			REVISIONS														