


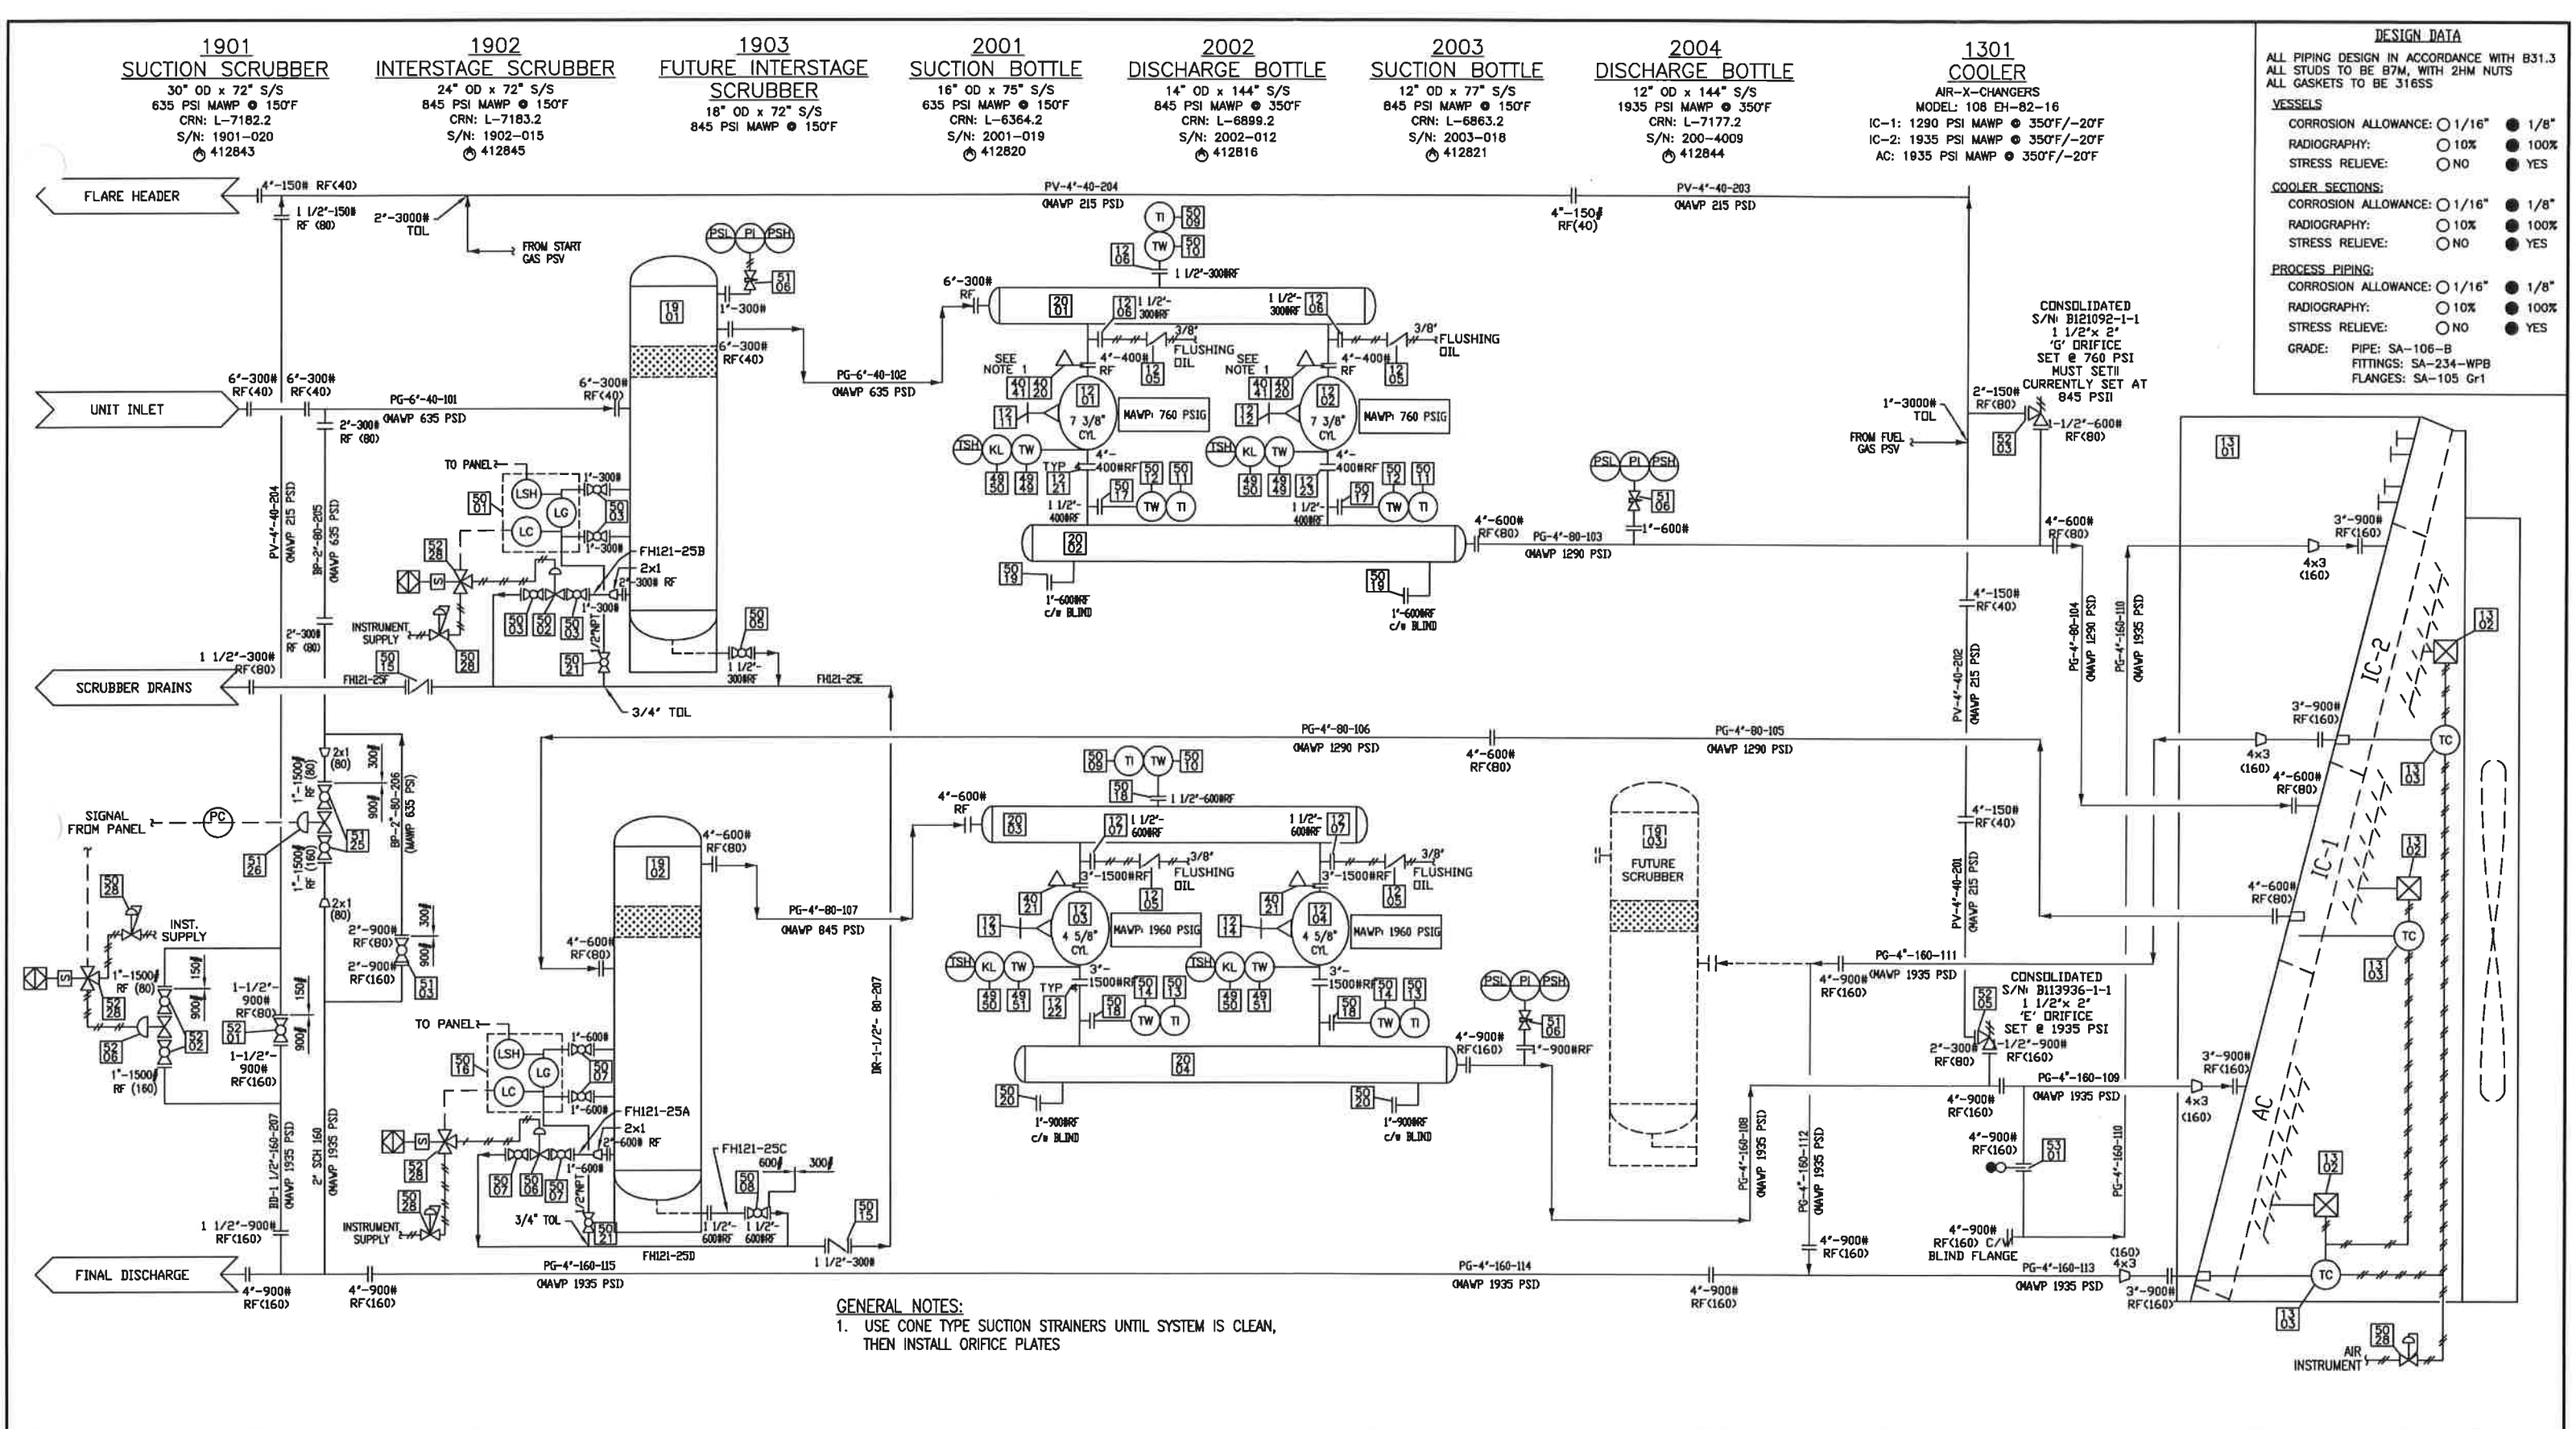

DESIGN DATA	
ALL PIPING DESIGN IN ACCORDANCE WITH B31.3	
ALL STUDS TO BE B7M, WITH 2HM NUTS	
ALL GASKETS TO BE 316SS	
VESSELS	
CORROSION ALLOWANCE:	1/16" 1/8"
RADIOGRAPHY:	10% 100%
STRESS RELIEVE:	NO YES
COOLER SECTIONS:	
CORROSION ALLOWANCE:	1/16" 1/8"
RADIOGRAPHY:	10% 100%
STRESS RELIEVE:	NO YES
PROCESS PIPING:	
CORROSION ALLOWANCE:	1/16" 1/8"
RADIOGRAPHY:	10% 100%
STRESS RELIEVE:	NO YES
GRADE:	PIPE: SA-106-B
	FITTINGS: SA-234-WPB
	FLANGES: SA-105 Gr1

MAJOR EQUIPMENT	
COMPRESSOR	ARIEL JGH-4, S/N F14247
CYLINDER	(2) 7-3/8 E, 7.375" BORE, MAWP 760 PSIG, S/N C-42476, C-42475
CYLINDER	(2) 4-5/8 E, 4.625" BORE, MAWP 1960 PSIG, S/N C-42477, C-42478
ENGINE	WAUKESHA F352IGSIU, 738 HP @ 1200 RPM, S/N 288726
COOLER	AIR-X-CHANGER 108 EH, S/N 991731
PANEL	AMOT HAWK-1 8650B, S/N H101548

LINE DESIGNATION	
XX-XX-XX-XXX	
LINE NUMBER	
LINE SCHEDULE	
LINE SIZE	
LINE SERVICE	




REV	DESCRIPTION	DATE	BY	CHK
0	AS BUILT	10/07/99	JCB	
REVISIONS				

BY	DATE
JCB	10/07/99
THIS DRAWING IS THE PROPERTY OF HANOVER CANADA CORPORATION AND IS NOT TO BE USED FOR ANY PURPOSE OTHER THAN FOR WHICH IT WAS INTENDED	



HANOVER CANADA CORPORATION
HANOVER PLACE
800 101-8TH AVE. S.W.
CALGARY, ALBERTA T2P 3P4
MAIN (403) 261-6831
FAX (403) 261-1066
TOLL FREE 1-888-551-5432

TWO STAGE COMPRESSOR PACKAGE G3521/JGH-4/108EH	
LEASE UNIT # 73252	
CA-73252-00-001	1

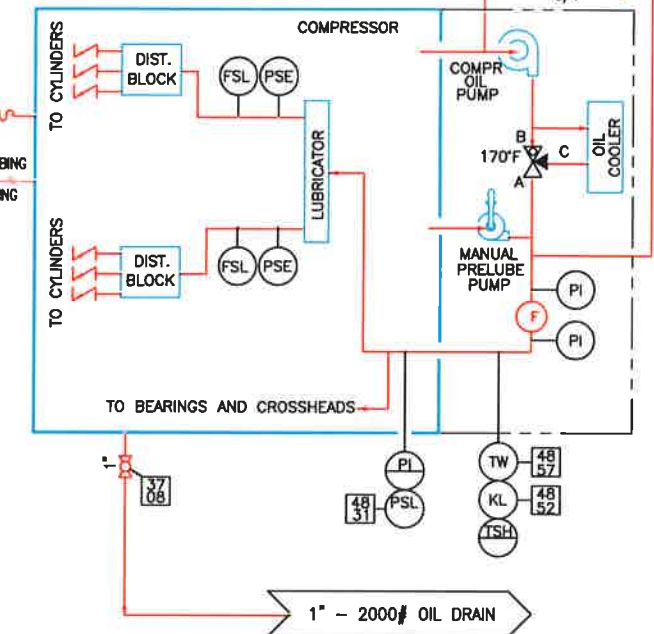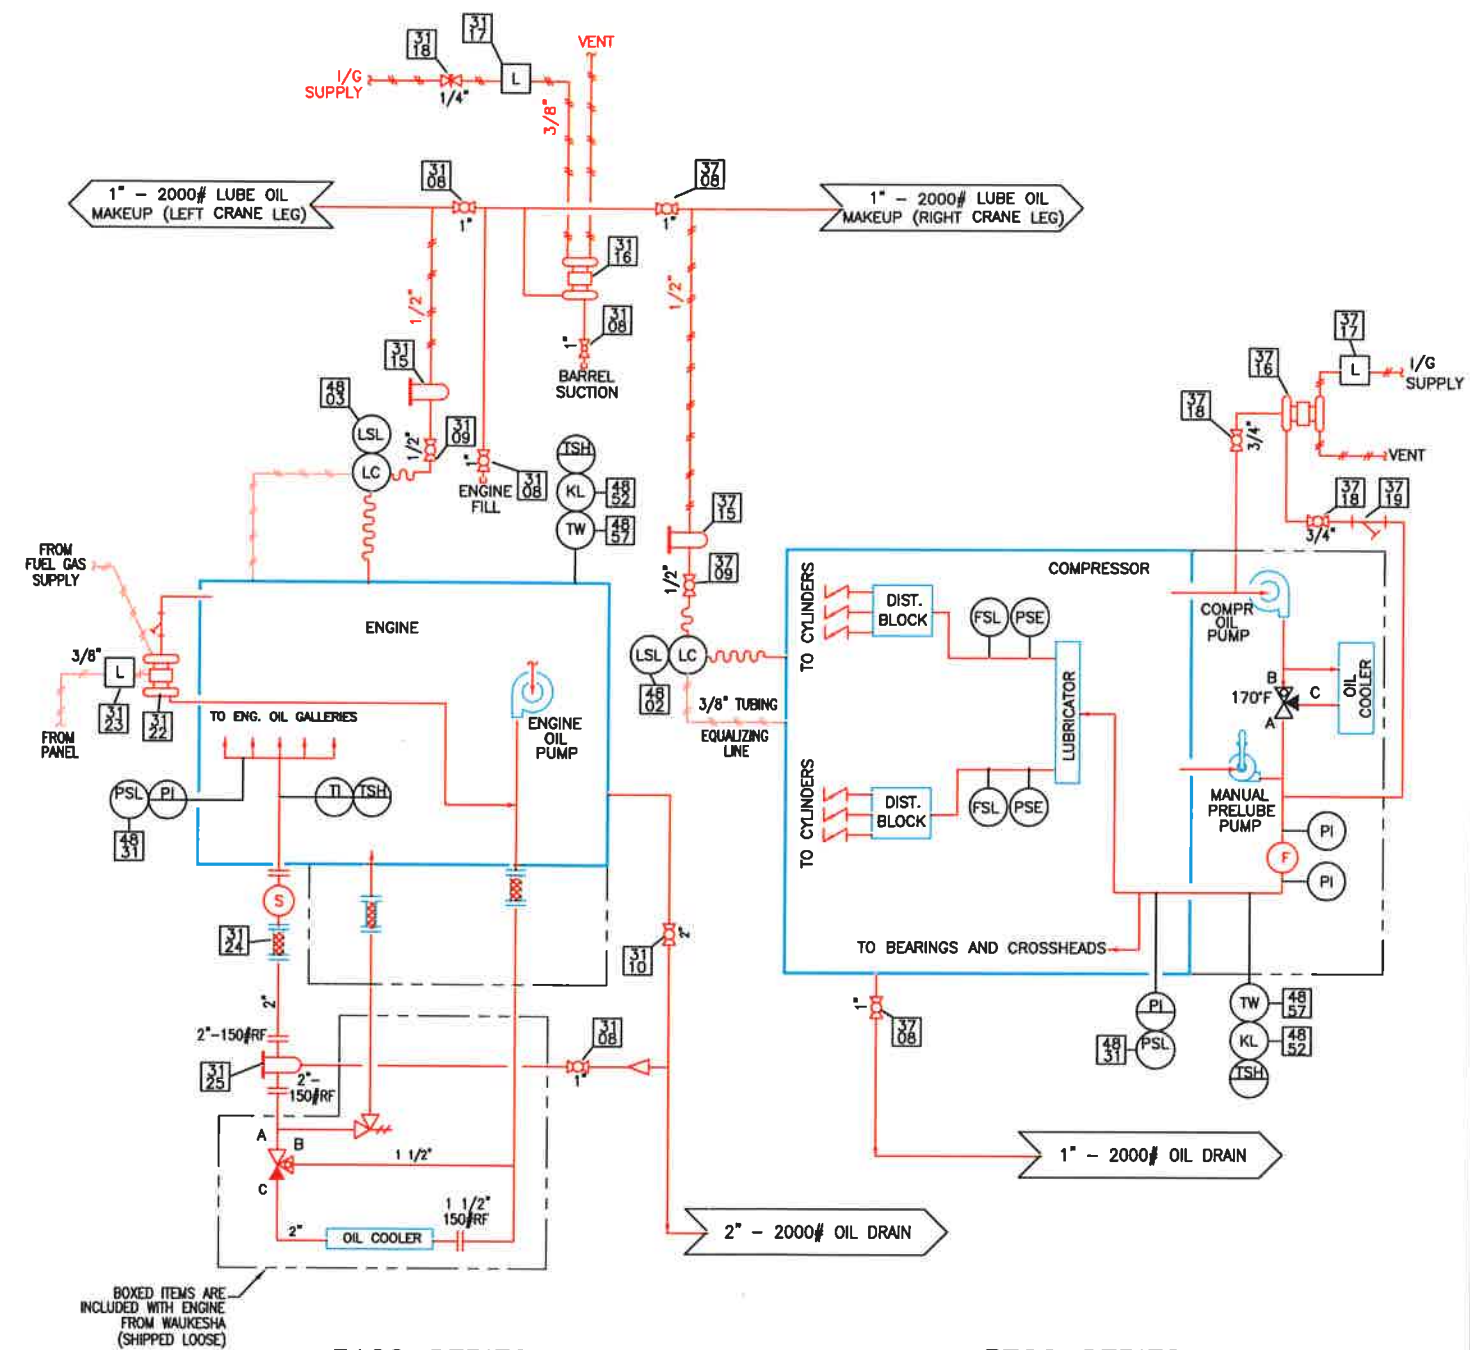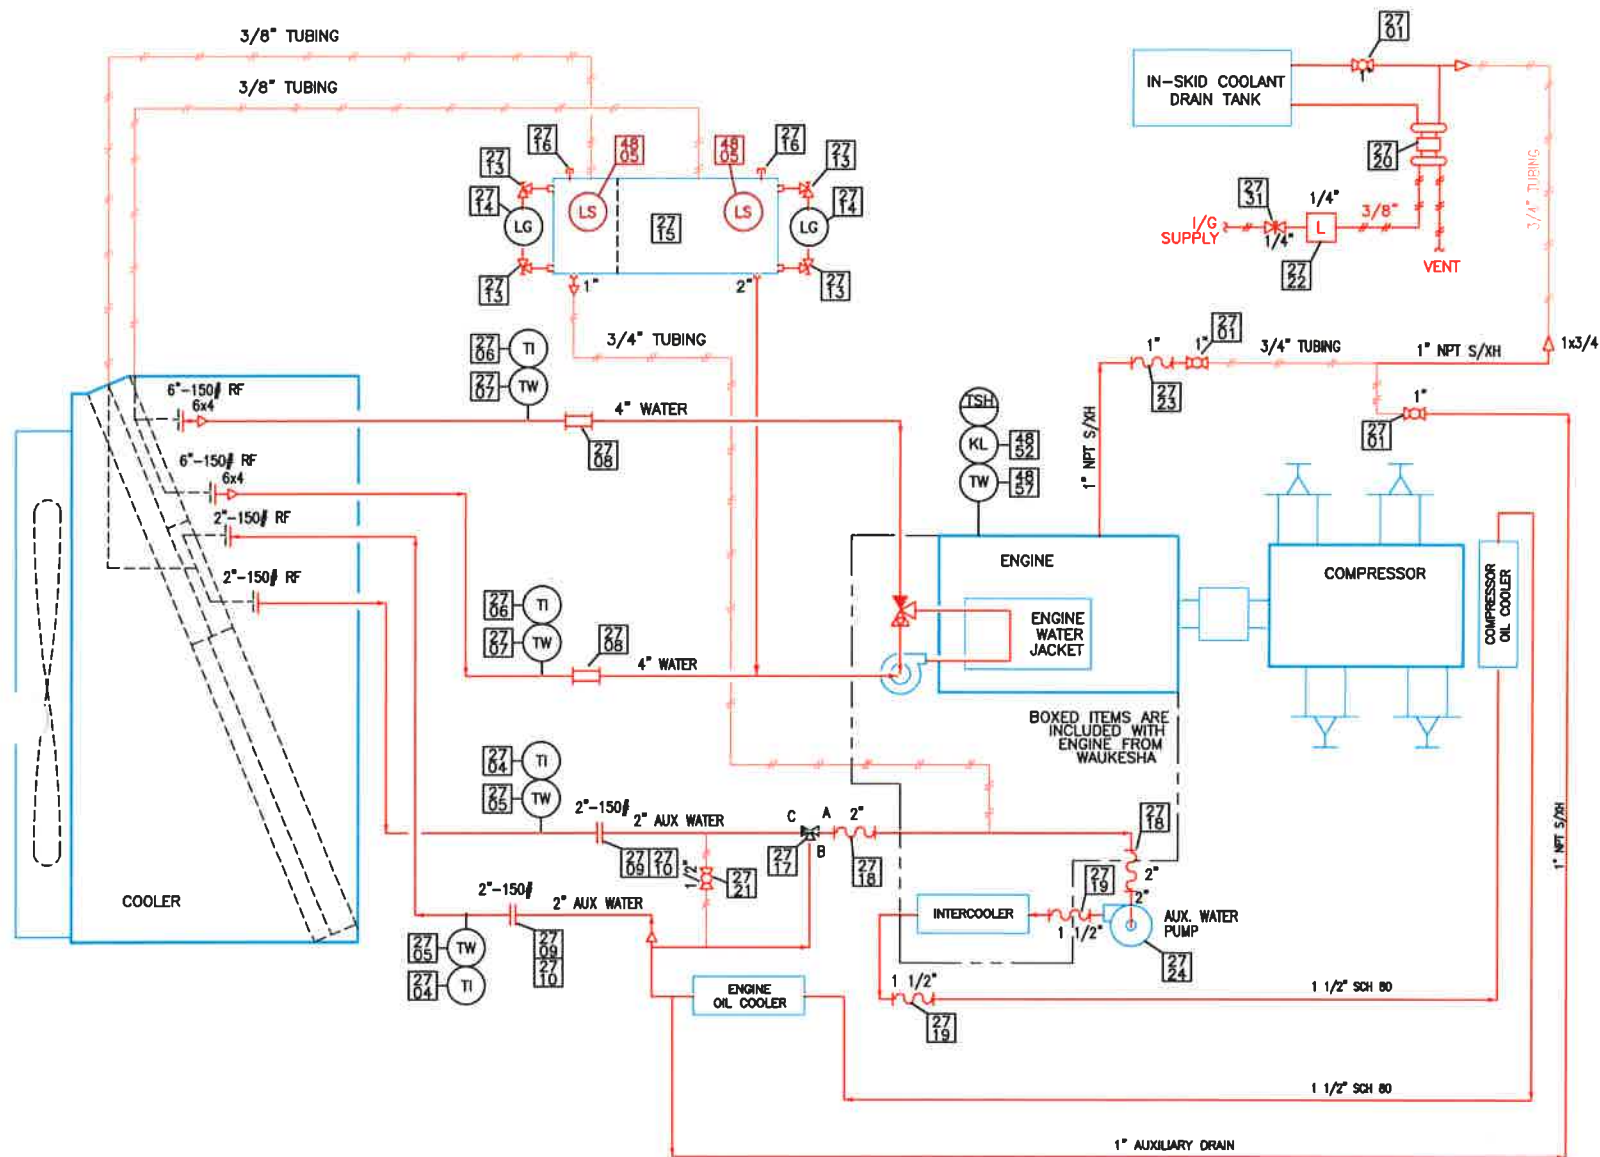

		1	AS BUILT	10.07.99	jcb	
DESCRIPTION	DRAWING NO.	REV	DESCRIPTION	DATE	BY	CN
REFERENCE DRAWINGS		REVISIONS				

BY	DATE
OWN KPB	08.12.99
CHK	
APP	
DSN	

THIS DRAWING IS THE PROPERTY OF COLLIQUITT
HANOVER SERVICES LTD. AND IS NOT TO BE
USED FOR ANY PURPOSE OTHER THAN FOR
WHICH IT IS INTENDED




CHS
COLLICUTT HANOVER
SERVICES INC.

8133 EDGAR INDUSTRIAL CLOSE
RED DEER, ALBERTA, CANADA T4P 3R4
PH: (403) 342-1607
FAX: (403) 342-0400


WT N/A SCALE NONE

TWO STAGE COMP PKG 3521GSI / JGH-4 / 108 EH WATER & OIL UTILITIES			
CHC LEASE GENESIS - WINDFALL			
JOB NO FH121	REV 1	DWG NO 100A727	SHT C

6-5/8" OD x 70" S/S
275 PSI MAWP @ 100°F/-20°F
CRN: H-3934.2
S/N: 2901-005

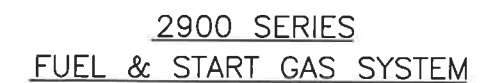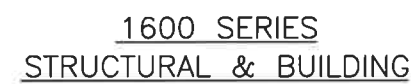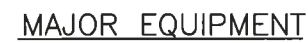


MAJOR EQUIPMENT		LINE DESIGNATION						BY		DATE		 HANOVER CANADA CORPORATION HANOVER PLACE 500 101-6TH AVE S W CALGARY ALBERTA T2P 3P4 MAIN: (403) 261-6801 FAX: (403) 266-1066 TOLL FREE: 1-888-301-5452		TWO STAGE COMPRESSOR PACKAGE G3521/JGH-4/108EH	
COMPRESSOR	ARIEL JGH-4, S/N F14247						JCB	06/12/99							
CYLINDER	(2) 7-5/8 E, 7 375" BORE, MAWP 760 PSIG, S/N C-42476, C-42475														
CYLINDER	(2) 4-5/8 E, 4 625" BORE, MAWP 1960 PSIG, S/N C-42477, C-42478														
ENGINE	WAUKESHA F552IGSIU, 738 HP • 1200 RPM, S/N 288726											THIS DRAWING IS THE PROPERTY OF HANOVER CANADA CORPORATION AND IS NOT TO BE USED FOR ANY PURPOSE OTHER THAN FOR WHICH IT WAS INTENDED.			
COOLER	AIR-X-CHANGER 108 EH, S/N 991731														
PANEL	AMOT HAWK-I 8630B, S/N HH01548														
		XX-XX-XX-XXX		LINE NUMBER		AS BUILT		10/07/99	JCB				LEASE UNIT # 73252		
				LINE SCHEDULE		REV	DESCRIPTION	DATE	BY	CHK					
				LINE SIZE		REVISIONS									
				LINE SERVICE											

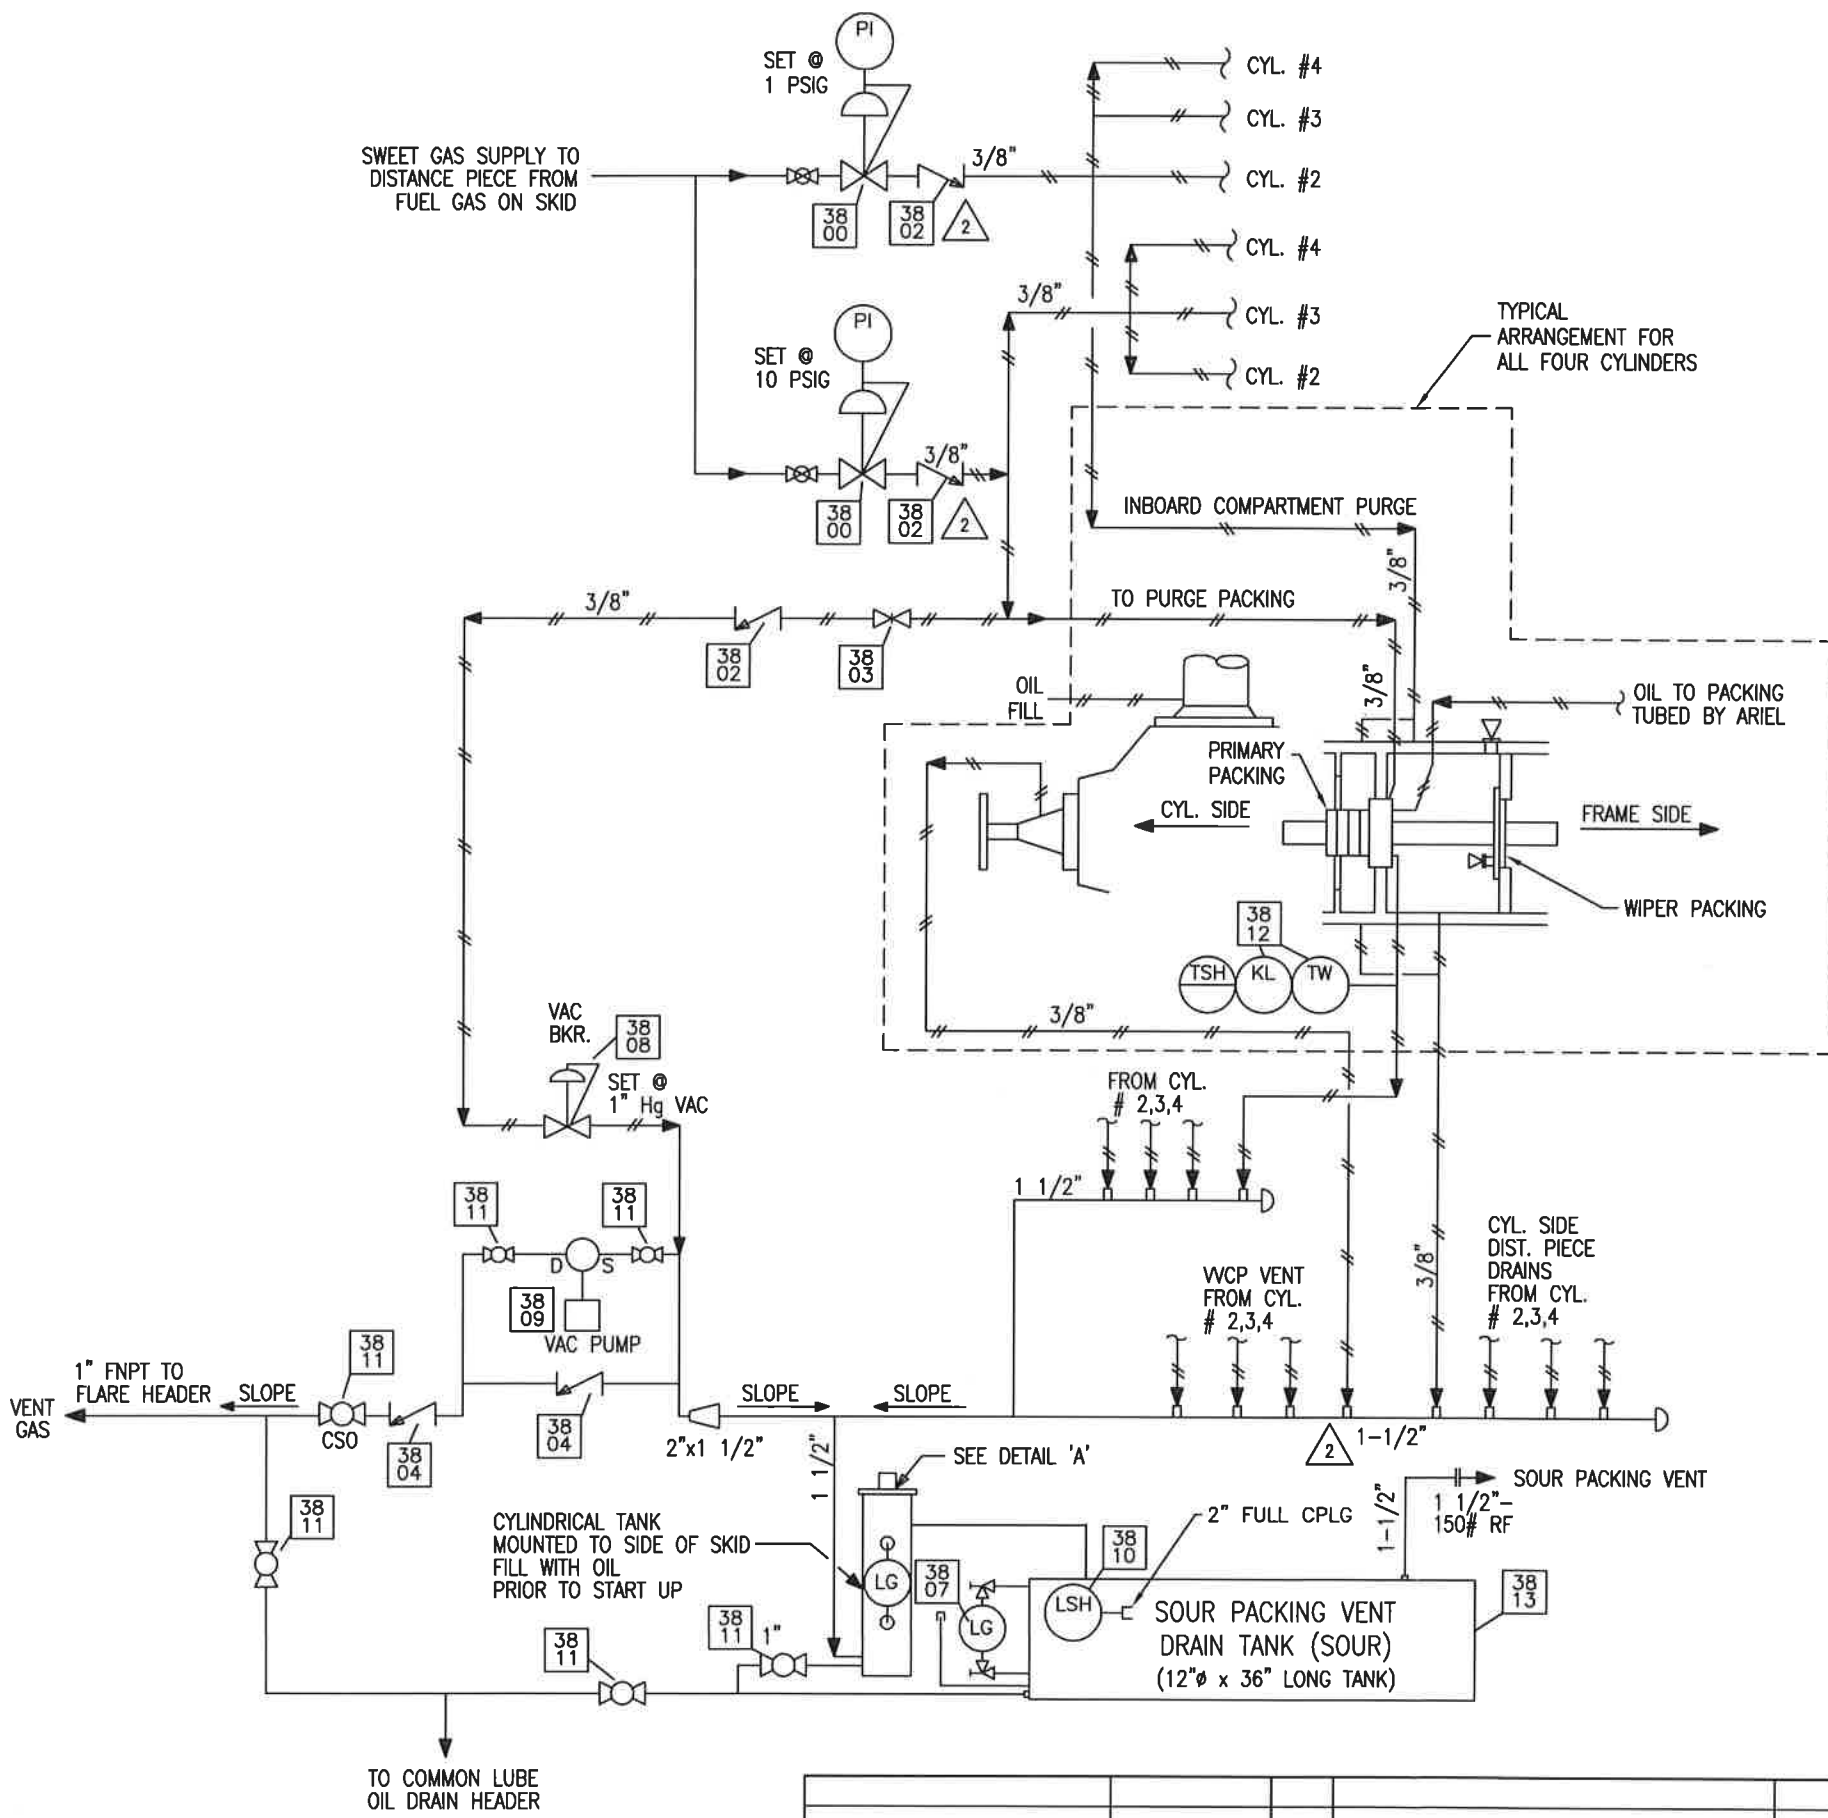

BILL OF MATERIALS

ITEM	QTY.	DESCRIPTION
3800	2	FISHER, TYPE 67AFR REGULATOR, 0-35 PSIG
3801	-	----
3802	3	CHECK VALVE, NUPRO S3-CH56BU1/3
3803	1	PLUG VALVE, NUPRO, 3/8" TUBE W/ SS PLUG
3804	2	PISTON CHECK, 1" NPT STEEL, DANIEL, NACE
3805		(NOT USED)
3807	2	LEVEL INDICATOR (JERGUSON), C/W LEVEL GAUGES (NACE)
3808	1	VAC BREAKER FISHER Y610 1" NPT SET @ 1" Hg VACUUM SOUR TRIM
3809	1	VACUUM PUMP, UTILE LGA-18, 1725 RPM, ___ VOLT, ___ AMP, 1 PHASE, 60 Hz MOTOR TO BE CONFIRMED
3810	2	NORRISEAL 1005E, 2" NPT LEVEL SWITCH, 018-BVS, 1018 AVE, SS (FOR SOUR SERVICE)
3811	5	1" NPT WKM NACE BALL VALVE
3812	4	K LEAD
3813	1	SOUR PACKING VENT DRAIN TANK (12" x 36")
3814	-	----
3815	1	SEAL POT (4" NPS x 41" S/S)

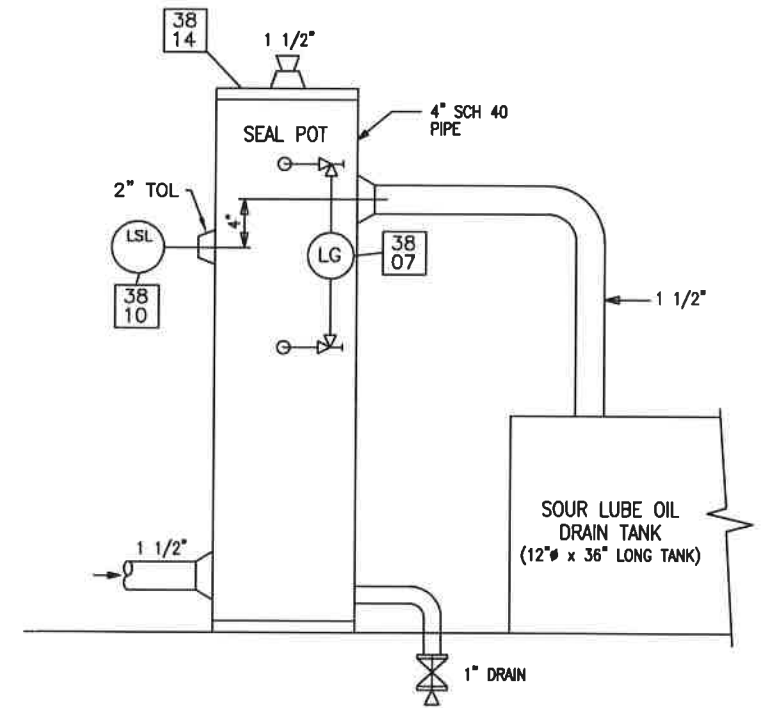

DETAIL 'A'
SEAL ARRANGEMENT

DESCRIPTION	DRAWING NO.	REV	DESCRIPTION	DATE	BY	CN
REFERENCE DRAWINGS		REVISIONS				
		2	REVISED PER MARK-UPS	99.11.18	kaw	
		1	SHORT 2-COMPARTMENT, REVISE B.O.M.	09.20.99	KPB	

BY DWN JCH	DATE 08.30.99	 8133 EDGAR INDUSTRIAL CLOSE RED DEER, ALBERTA, CANADA T4P 3R4 PH: (403) 342-1607 FAX: (403) 342-0400	SHORT 2-COMP DIST PCE & PACKING VENT DRAIN AND PURGE SCHEMATIC			
CHK			CHC LEASE / GENESIS WINDFALL			
APP			JOB NO FH121	REV 2	DWG NO 100A751	SHT A
DSN						

THIS DRAWING IS THE PROPERTY OF COLLICUTT HANOVER SERVICES LTD. AND IS NOT TO BE USED FOR ANY PURPOSE OTHER THAN FOR WHICH IT IS INTENDED

1. 3 TON CRANE
2. 120 VOLT LIGHTS
3. 4 LIGHTS
4. NO SKID PAN
5. (2), 48"x24" CATADYNE HEATERS
6. (2), 24"x24" CATADYNE HEATERS

GENERAL ARRANGEMENT COMPRESSOR PACKAGE 3521 GSI/JGH-4/108EH			
CHC LEASE GENESIS WINDFALL			
JOB NO FH121	REV A	DWG NO 100A743	SHT A

