


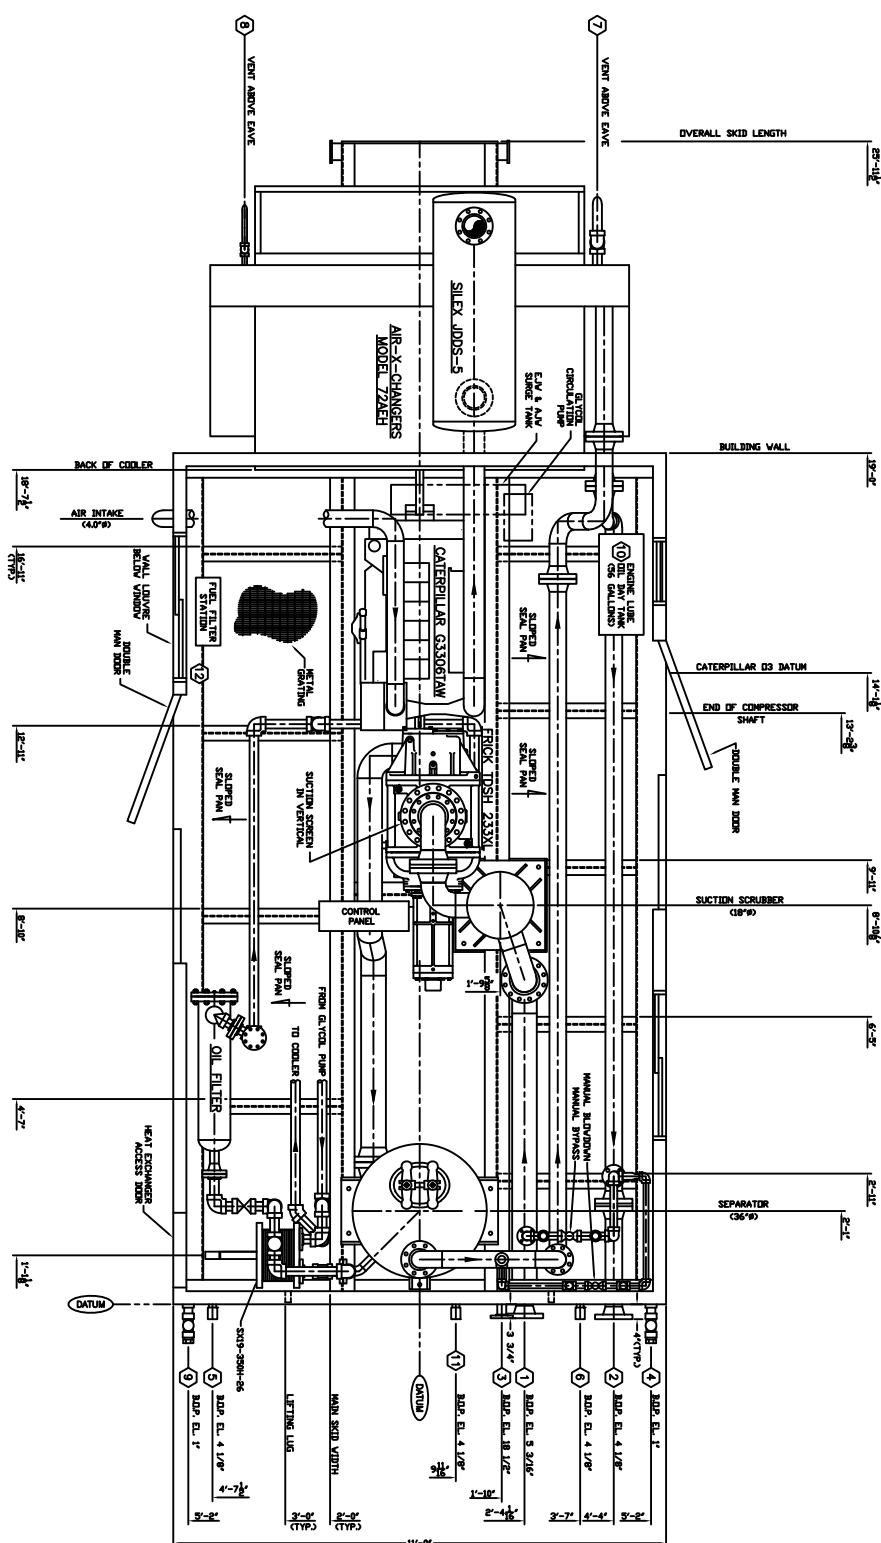


- NOTES:**
1. ALL PROCESS TUBING TO BE SWEET C/V CHROMIUM PLATED
 2. ALL INSTRUMENTATION TUBING TO BE SWEET C/V CHROMIUM
 3. ALL SWEET FITTINGS AND STAINLESS STEEL FERRULES
 4. UNIT COMPLETE WITH SEAL, PUMP
 5. HAVE 1/2" CA. SPOT 3" DIA. AND HYDRO TESTING
 6. SANDBLAST SECTION SPILLS DOWNSTREAM OF ONE SCREENS
 7. ESTIMATE INCHLB. WEIGHT 23,000 LBS. (TAC)
 8. BUILDING OVERALL HEIGHT IS 11'-3" 1/2"

- 1** INITIAL SECTION
2 FINAL DISCHARGE
3 HIGH PRESSURE VENT HEADER
4 ENGINE WASTE OIL TANK BRAIN
5 OIL TANK FILL/BRN
6 SCUBBER BRAIN HEADER
7 LOW PRESSURE STARTER VENT HEADER
8 LOW PRESSURE INSTRUMENT VENT HEADER

- CUSTOMER CONNECTIONS:**
- 1-4" 3000 BRVN
 - 2-4" 3000 BRVN
 - 3-4" 3000 BRVN
 - 100-4" 3000 BRVN

1	-	-	---	---	
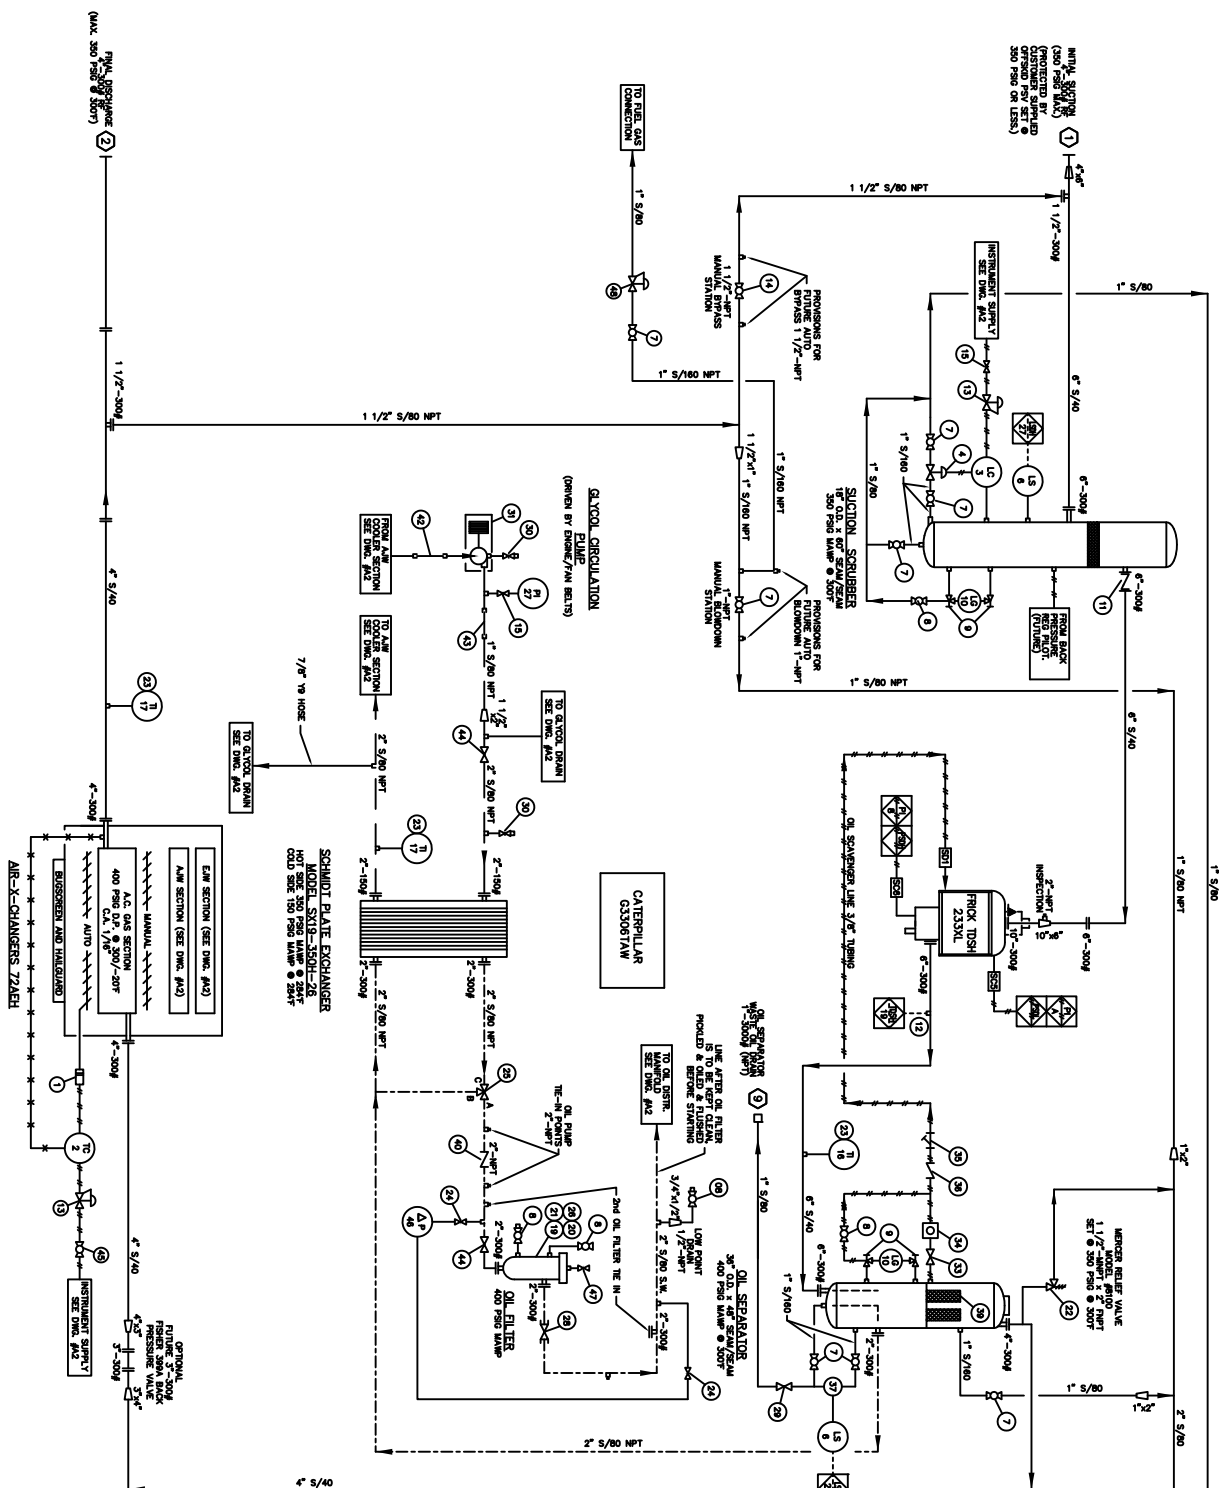

FRICK TDSH 233L PORT DESCRIPTIONS
(AS PER FRICK DWG. #033400224)



1. FOR ALL OTHER NOTES AND GENERAL INFORMATION SEE DIV. 601

2	SOLD TO HUSKY/CHANGED FRAME SIZE FROM 23XL TO 23XSL	10/05/01	UK
1	AS BUILT	09/11/01	UK
0	ISSUED FOR CONSTRUCTION	04/09/01	UK
No.	REVISION	DATE	BY

ENERGY INDUSTRIES INC. 4303 - 17TH STREET NE, CALVERT, ALBERTA CANADA		DISTRICT:	
TITLE:		HARRY ENERGY INC. OPERATIONAL EXPENSE SOUNDS GAS COMPRESSION DATE: 09-17-99-01 W44	
UTILITY FLOW DIAGRAM OPERATIONAL EXPENSE DATE: 04/09/01 DR-X-CHANNERS 7249H		DATE RECEIVED:	
STEP: 510	SCALE: NONE	UNIT: 5100	RELEASED BY:
DATE: 04/09/01		DRAWING NO.: 5100-02	
UNIT: 5100		REL: 2	