


OPTION No.	OPTION DESCRIPTION	OPTION No.	OPTION DESCRIPTION
☒ 5001B	AUTO BYPASS CAPACITY CONTROL	☒ 5006A	AUTO BLOWDOWN
☒ 5003	AUTO BY-PASS BLOCK VALVES	☒ 5027A	GLOBE VALVE ON SCRUBBER DRAIN 1-2 STG
☒ 5004B	AUTO SUCTION PRESSURE CONTROLLER	☒ 5027C	GLOBE VALVE ON MANUAL BLOWDOWN
☐ 5005B	SUCTION RELIEF VALVE (THERMAL)	☒ 5028A	BLOWDOWN BLOCK VALVE
☒ 5036A	FLUSHING OIL, STD FOR > 2% SOUR, 1/2 STG	☐ 5036B	FLUSHING OIL, STD FOR > 2% SOUR, 3 STG

EFX Compression
ENERFLEX
4700 47 Street SE Calgary AB Canada T2B 3R1 Canada Tel. +1.403.236.6800 Fax +1.403.279.0367
www.enerflex.com

FOR: ENCANA		<u>ENCANA CORPORATION</u>	
		HORN RIVER	
CONSULTANT: SOLARIS MANAGEMENT		CON. INC.	
P.O.:		LSD: C-37-K/94-0-8 JOB No.: 080359	
DRWN BY: MGN	DESIGN BY: MGN	DATE: 08/10/31	DWG. No.
DATE: 08/10/31	CHKD BY: GW	DATE:	OP#
SCALE: NTS	APPVD BY:	DATE:	PF-080359-50
			50

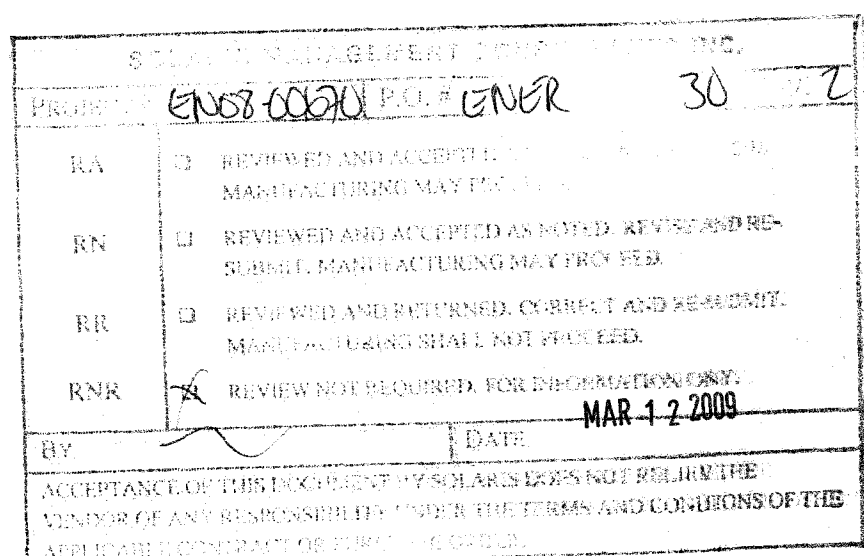


OPTION SELECTION	OPTION NUMBER	OPTION DESCRIPTION
☒	2712	LUBE OIL TRANSFER STATION FOR GAS SUPPLY (NO OP. 2714)
☐	2713	ENGINE DIAPHRAGM PRE/POST LUBE PUMP
☒	SOUR	OIL TANK CHECK VALVE (REQUIRED FOR SOUR SERVICE)
☒	2717	WASTE LUBE OIL SKID STORAGE TANK SIGHT GLASS
☒	128451	OPTION KIM HOTSTART W/ PRESSURE SWITCH (SEE ALSO SF-24)
☐		
☐		
OPTIONS			
ITEM	QTY	EFX CODE	DESCRIPTION
			OPTION SOUR - OIL TANK CHECK VALVE
19	1	118537	VALVE, CHECK, SWING, 2" NPT, 800# WOG, CS, NACE [NAVCO, CS-R20S08A12]
			OPTION 2717- WASTE LUBE OIL SKID STORAGE TANK SIGHT GLASS
60	2	102724	FTG, TUBE, 3/4"-3/4"NPT 90DEG ELBOW,CS [SWAGELOK, S-1210-2-12]
61	1	128246	TUBING, POLYCARBONATE, CLEAR,3/4" OD X 1/2" I, .125" WALL [GE POLYMER, 81300505]
			BOM: M 128357 : OPTION 2717, WASTE LUBE OIL SKID STORAGE TANK SIGHT GLASS
			OPTION 2711 - MICROSPINNER FOR WAUKESHA VHP
			OPTION 2712 - LUBE OIL TRANSFER SYSTEM (X1)
31	1	102973	VALVE, BALL, 3/4" NPT, 2000# WOG, RP, 316SS, NACE C/W [NAVCO, C1-R07S20A]
32	1	119928C	PUMP, DIAPHRAGM, LEVEL III ASSEMBLY,1/2"NPT ALUM,SOUR GAS,CSA [WARREN RUPP, G05]
33	1	102974	VALVE, BALL, 3/8" NPT, 2000# WOG, RP, A105 BODY, NACE C/W [NAVCO, H1-R03S20S]
34	1	127639	ASSEMBLY, BRACKET, CLIP FOR BARREL TRANSFER STATION
			OPTION KIM HOTSTART W/ PRESSURE SWITCH (SEE ALSO SF-24)
41	1	NPN	HEATING SYSTEM, OIL & COOLANT, CSA C/W SWITCH [KIM HOTSTART, COLER3180/0604]
42	1	114147	VALVE, BALL, 1-1/2" NPT, 1500# WOG, FP, SS, 2 PIECE C/W LOCKING HANDLE [MAS, G2]
43	1	114146	VALVE, BALL, 1" NPT, 2000# WOG, FP, SS, 2 PIECE C/W LOCKING HANDLE [MAS, G2]
45	1	109946	VALVE, CHECK, PISTON, 1-1/2" NPT, 800# WOG, CS [NAVCO, CP-R15S08A8]
46	1	113090	VALVE, BALL, 1/4" NPT, 2000# WOG, FP, SS, 2 PIECE C/W LOCKING HANDLE [MAS, G2]

 Compression			
			
4700 42 Street SE Calgary AB Canada T2B 3R1 Canada Tel. +1.403.236.6800 Fax +1.403.279.0367 www.enerflex.com			
TITLE:		SERVICE FLOW ENGINE LUBE OIL FOR L7042GSI	
FOR:		<u>ENCANA CORPORATION</u> HORN RIVER	
CONSULTANT: SOLARIS MANAGEMENT CONSULTANTS		LSD: C-67-K/94-0-8 JOB No.: 080360	
DRWN BY: MGN DATE: 08/10/23 SCALE: NTS	DESIGN BY: MGN CHKD BY: GW APPVD BY: -	DATE: 08/10/22 DATE: - DATE: -	DWG. No. SF-080360-27
			OP 27

NOTES:
1. VIBRATION SWITCHES AND TRANSMITTERS TO BE FIRMLY MOUNTED TO THE MACHINE SURFACE, ORIENTED SO THE SENSITIVE AXIS POINTS INTO THE DIRECTION OF ROTATION NEAR CRANKSHAFT HEIGHT. (THE SENSITIVE AXIS FOR TRANSMITTERS IS INLINE WITH THE STUD, FOR SWITCHES IT IS THE DIRECTION THE RESET BUTTON POINTS).

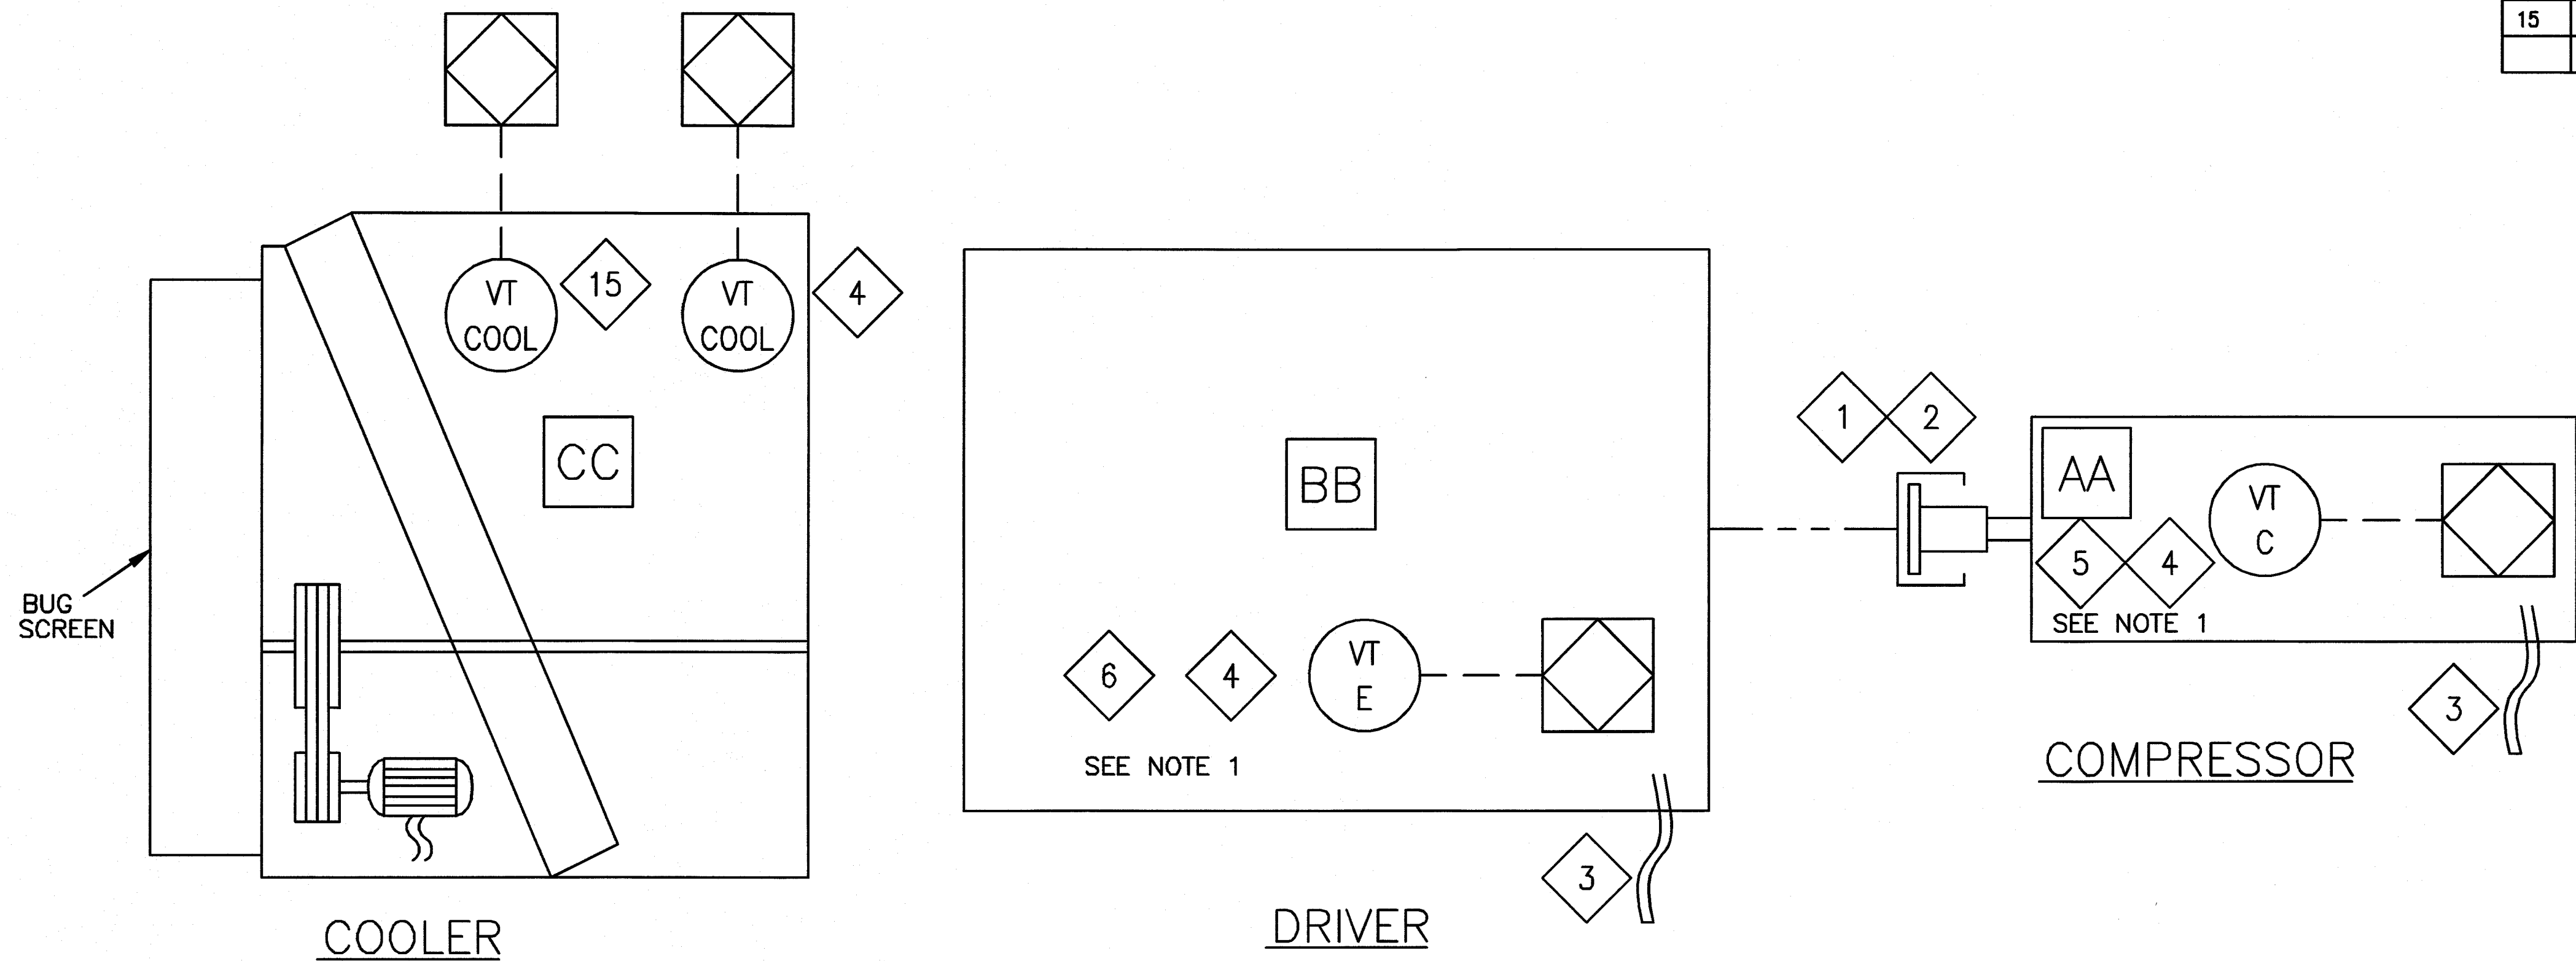

(2) 40 HP, 1765 RPM,
460-3-60 V/PH/HZ,
TEFC CHEM DUTY MOTORS
(VFD COMPATIBLE)
MOTORS SHALL BE RATED
FOR INSTALLATION IN A
CLASS I, DIV. 2, GROUP IIA AREA.

- 7 ENGINE MOUNT x 8
- 8 STUD x 8
- 9 NUT/WASHER x 8
- 10 PLATE x 8

- 11 COMP. FRAME MOUNT x 6
- 12 STUD x 6
- 13 DISTANCE PIECE MOUNT X 8
- 14 STUD x 8

SOLARIS MANAGEMENT CONSULTANTS INC.	
PROJECT: ENCANA CORP. 29150000	
RA	☐ REVIEWED AND ACCEPTED FOR MANUFACTURING
RN	☐ REVIEWED AND ACCEPTED AS NOTED, RE-REVIEWED, MANUFACTURING MAY PROCEED.
RR	☐ REVIEWED AND RETURNED, CORRECT AND RE-SUBMIT, MANUFACTURING SHALL NOT PROCEED.
RNR	☒ REVIEW NOT REQUIRED, FOR INFORMATION ONLY.
BY	DATE: MAR 12 2009
ACCEPTANCE OF THIS DRAWING BY SOLARIS DOES NOT RELIEVE THE VENDOR OF ANY RESPONSIBILITY UNDER THE TERMS AND CONDITIONS OF THE APPLICABLE PURCHASE ORDER.	

BILL OF MATERIAL

ITEM	QTY	PART ID	DESCRIPTION
1	1	105068	COUPLING, ADAPTER PLATE 22.5" OD HD [FORMFLEX, FSH70-22B-GK-HD]
2	1	110097	COUPLING GUARD, ALUMINUM, BUILD TO SUIT
3	2	104389	GROUND STRAP, WHEEL, 5/8", 4 GA., HEAVY DUTY [NAPA, 712084]
4	3	104787	TRANSMITTER, VIBRATION, 4-20MA, 24VDC CSA, IS [METRIX, ST5484E-767]
5	1	117546B	WIRE SUPPORT, COMPRESSOR SIDE DOOR [AGS, W11350346452001]
6	1	128331	MOUNTING PLATE, VIBRATION SWITCHES & TRANSMITTERS, WAUK VHP
7	8	127556	MOUNT, ALLOY STEEL [VIBRACON, SM20AS-LP-EV34]
8	8	127969B	STUD, 3/4" X 30-1/8" LONG SA193-B7M (100% TESTED) [AGSGRO]
9	8	127562	NUT/WASHER, 3/4", ENGINE, GEN III/CBM SKID
10	8	129072	PLATE, ENGINE NUT/WASHER, GEN III, CBM SKID
11	6	128074	MOUNT, ALLOY STEEL, SM30AS-LP [VIBRACON, SM30AS-LP]
12	6	127968	STUD, 1-1/8" X 32-1/4" LONG SA193-B7M (100% TESTED) [AGSGRO]
13	8	128075	MOUNT, ALLOY STEEL, [VIBRACON, SM20AS-LP-EV34-ID30]
14	8	123636	STUD, 1-1/8" X 10" LONG SA193-B7M (100% TESTED) [AGS]
15	1	104787	TRANSMITTER, VIBRATION, 4-20MA, 24VDC CSA, IS [METRIX, ST5484E-767]

4	AS BUILT	09/02/12	DZH	GW
3	ADDED SOME NOTES ABOUT MOTORS	09/01/21	CAL	GW
2	ITEM # 15 ADDED ON BOM	08/12/30	DZH	GW
1	ISSUED FOR CONSTRUCTION	08/12/08	MGN	GW
0	ISSUED FOR APPROVAL	08/10/31	MGN	GW

REV	DESCRIPTION	DATE	DRAWN BY	CHECKED BY
-----	-------------	------	----------	------------

EFX Compression


4700 47 Street SE Calgary AB Canada T2B 3R1 Canada Tel. +1.403.236.6800 Fax +1.403.279.0367
www.enerflex.com

TITLE: SERVICE FLOW
DRIVE TRAIN
WAUKESHA L7042 GSI EXT-GC ESM

FOR: ENCANA CORPORATION
(HORN RIVER)

CONSULTANT: SOLARIS MANAGEMENT CONSULTANTS LSD: C-67-K/94-0-8
P.O.: - JOB No.: 080360

DRWN BY: MGN	DESIGN BY: MGN	DATE: 08/10/30	DWG. No.	OP#
DATE: 08/10/30	CHKD BY: GW	DATE: -	SF-080360-28	28
SCALE: NTS	APPVD BY: -	DATE: -		

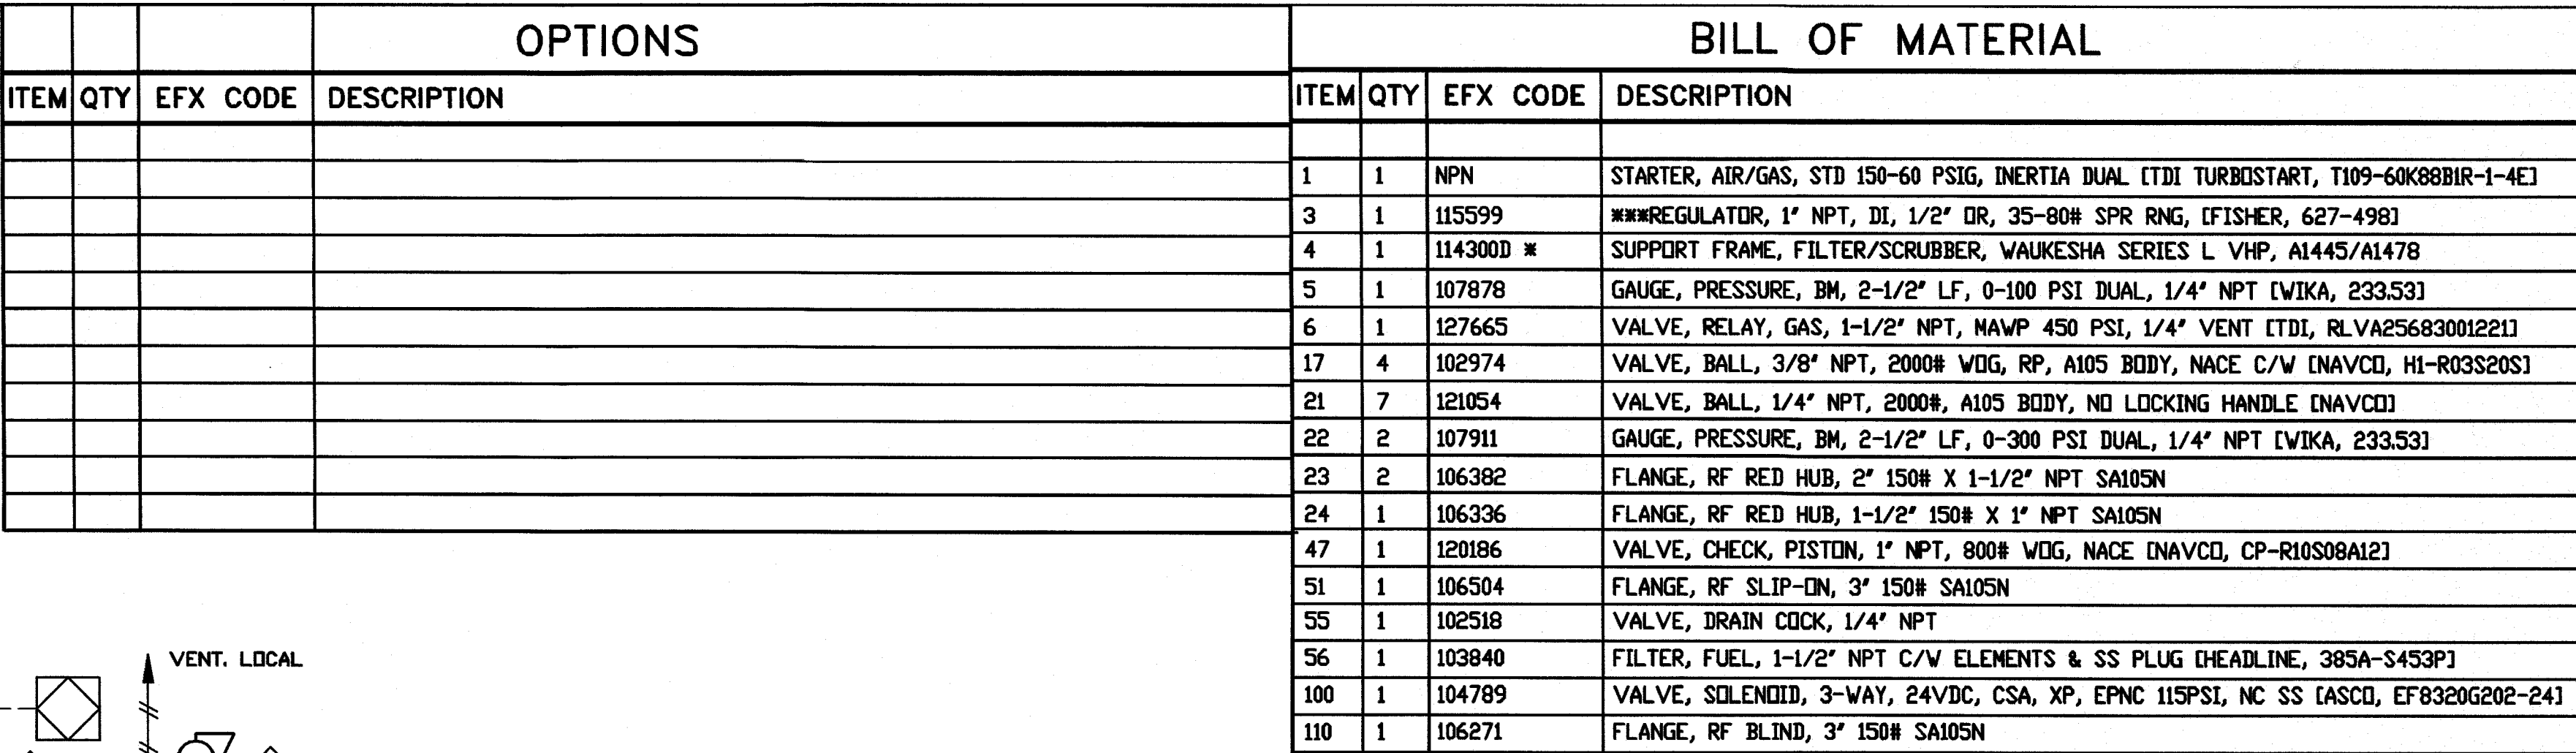


4	AS BUILT	09/02/12	CAL	GW
3	ADDED THE HEIGHT OF VESSEL	09/01/21	CAL	GW
2	RELOCATED ITEM# 56	08/12/30	MGN	GW
1	ISSUED FOR CONSTRUCTION	08/12/08	MGN	GW
0	ISSUED FOR APPROVAL	08/11/03	MGN	GW
REV	DESCRIPTION	DATE	DRAWN BY	CHECKED BY

4700 47 Street SE Calgary AB Canada T2B 3R1 Canada Tel. +1.403.236.6800 Fax +1.403.279.0367
www.enerflex.com

FOR: ENCANA CORPORATION
HORN RIVER
CONSULTANT: SOLARIS MANAGEMENT CONSULTANTS LSD: C-67-K/94-0-8
P.O.: - JOB No.: 080359

DRWN BY: MGN	DESIGN BY: MGN	DATE: 08/10/21	DWG. No.	OP
DATE: 08/10/31	CHKD BY: GW	DATE: -	SF-080359-22	22
SCALE: NTS	APPVD BY: -	DATE: -		

RELATED INFORMATION
-DA22.0001, FUEL AND START GAS FOR BTB "A" SERIES PACKAGES
-DA22.0002, CSA/CGA APPROVED FUEL AND START HOSE USAGE

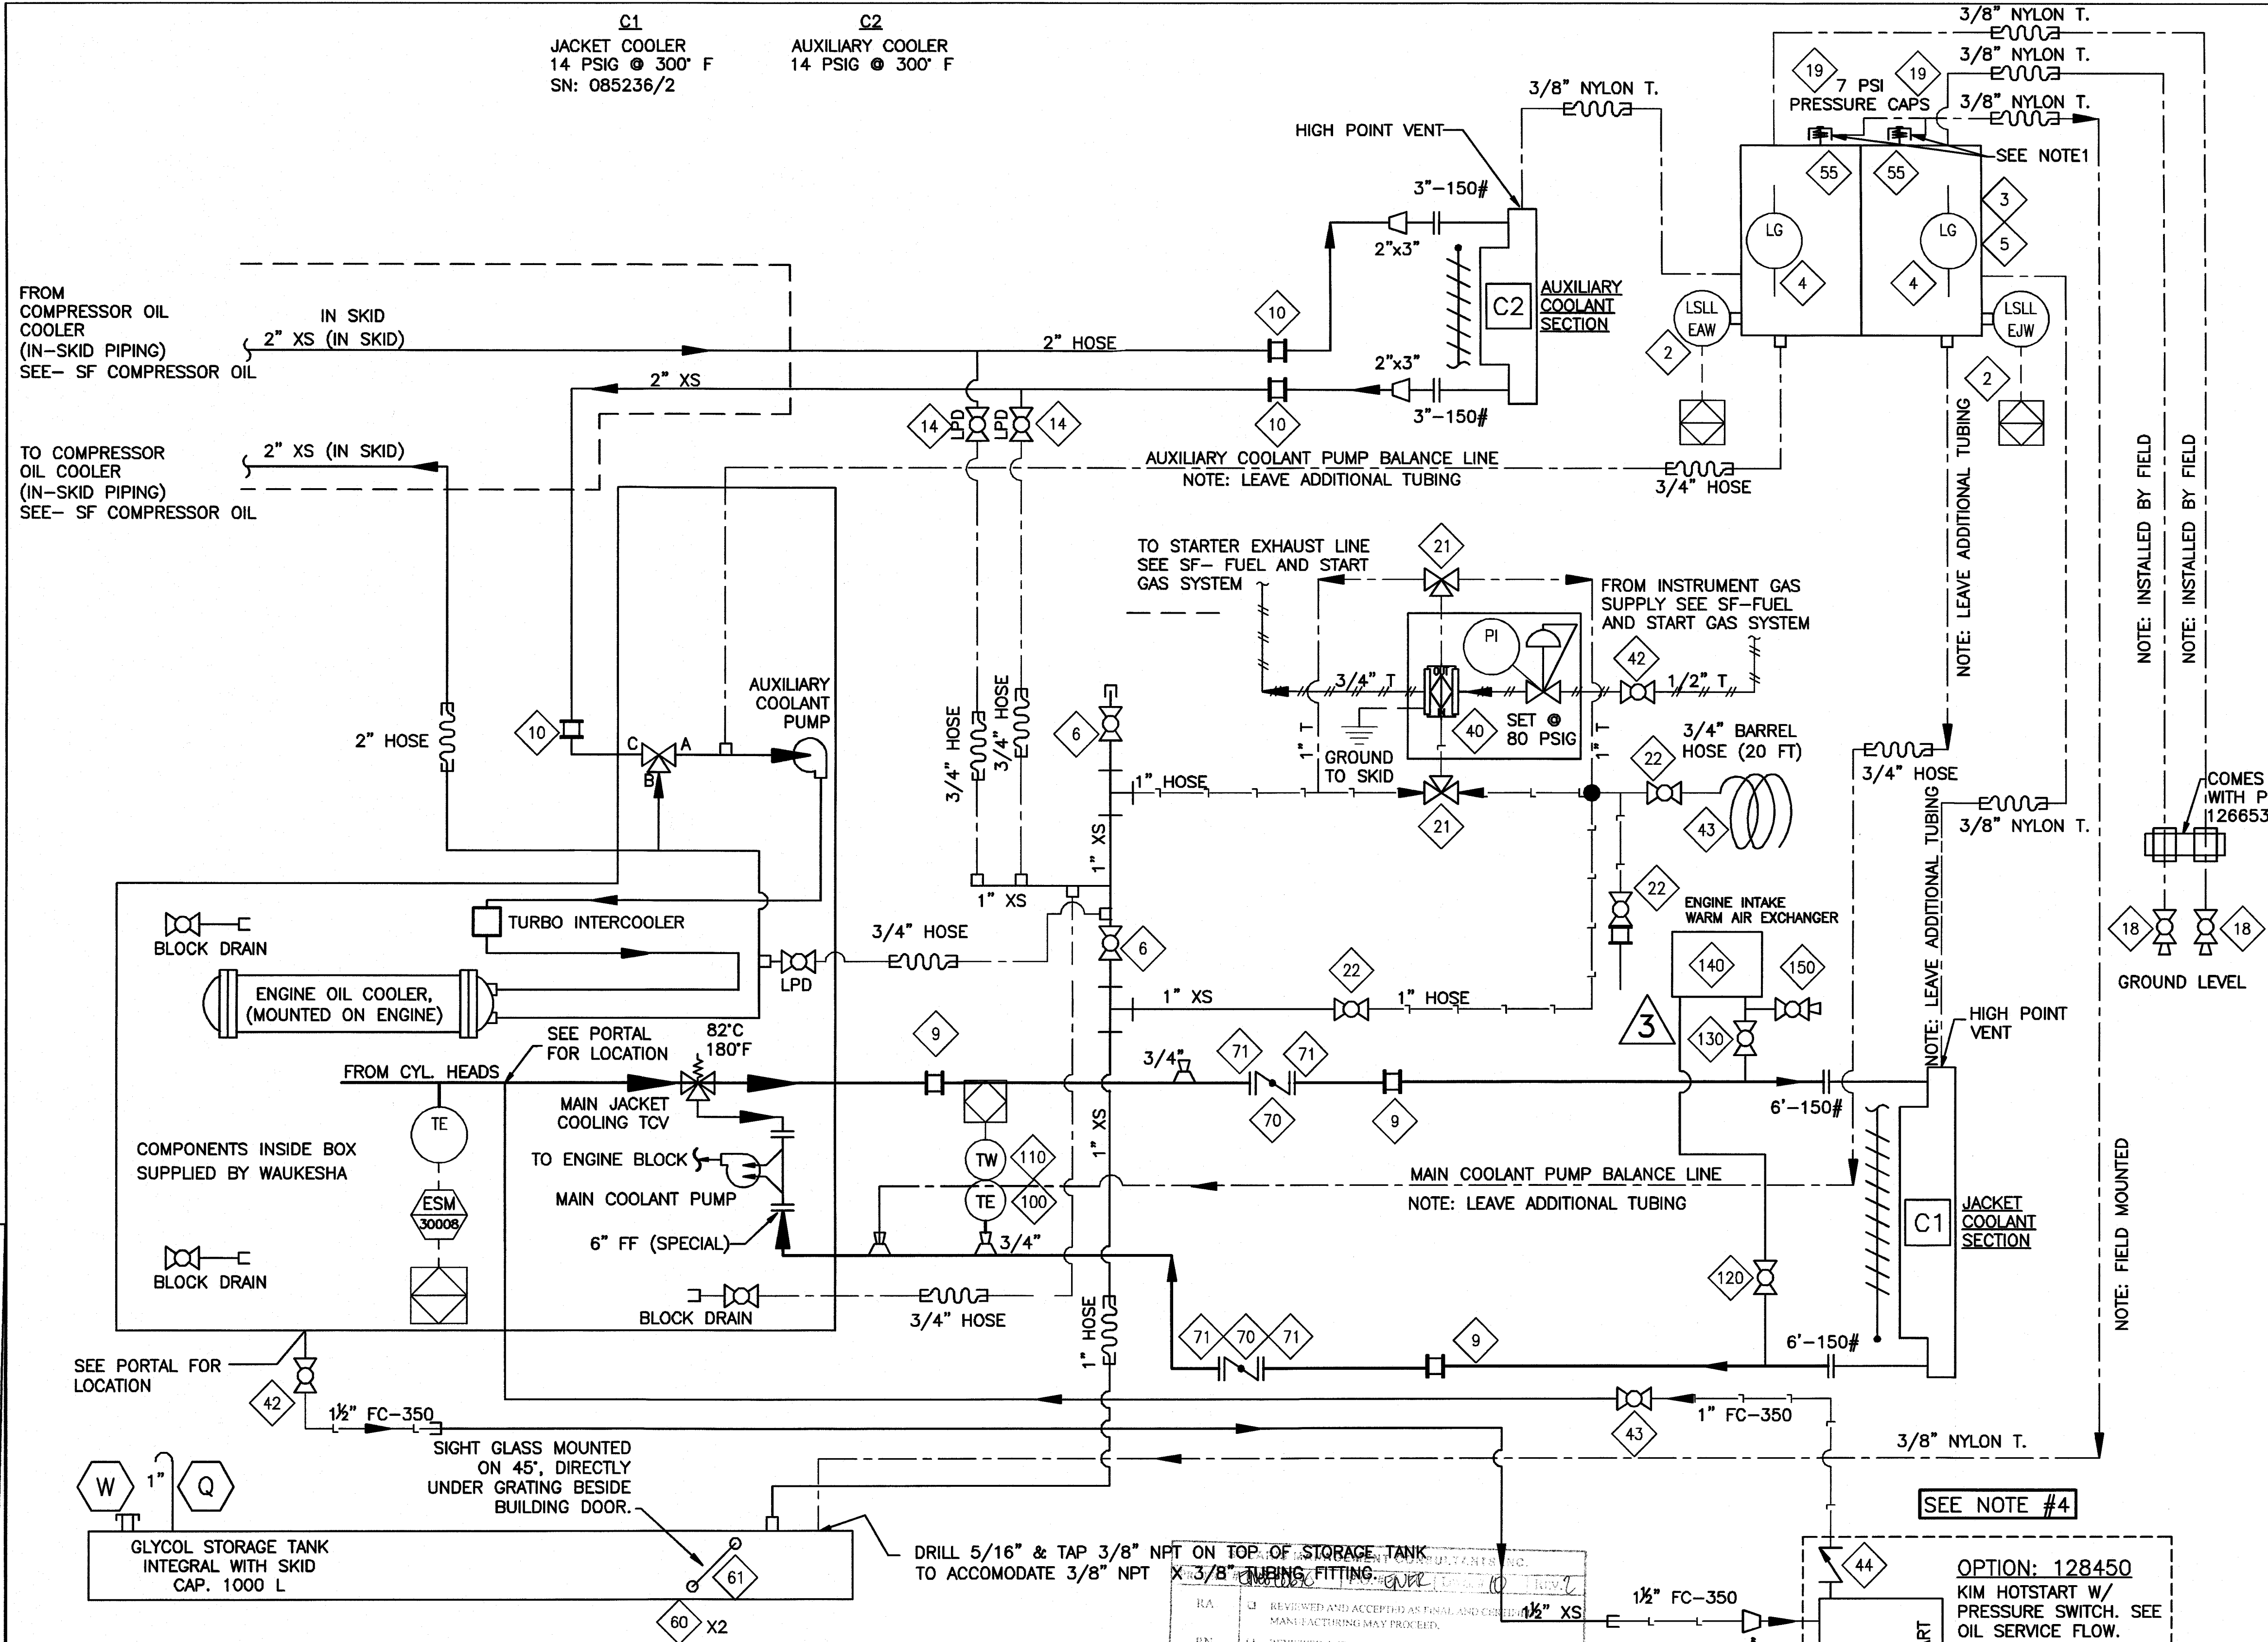

- NOTES:**
- * DRAWINGS TO BE RELEASED FOR FABRICATION
 - ** ASSEMBLY BOM TO BE ADDED TO THE JOB WORK ORDER.
 - 1. DRILL NYLON TUBE ID TO 5/16" TO FIT OVER PRESSURE CAP VENT TUBE.
 - 2. WHEN THE ESM SYMBOL CONTAINS A FIVE DIGIT NUMBER, THE PANEL IS COMMUNICATING THROUGH MODBUS RS-485 TO THE ESM AND THE NUMBER IS THE ESM MODBUS ADDRESS TO LOCATE THE STORED DATA.
 - 3. REFER TO PHOTOS IN GPS BINDER FOR PUMP LOCATIONS
 - 4. TO AVOID PUMP DAMAGE, PRIME THE PUMP AND FILL THE SUCTION LINE BEFORE STARTING THE SYSTEM. BE SURE TO BLEED ALL TAPPED AIR FROM THE PUMP PRIOR TO START.

GLYCOL REQUIREMENTS			
LOCATION	EJW(L)	AJW(L)	
Engine	379	26.4	
Cooler	215.76	124.91	
Surge Tank	100	39.53	
Piping	229.73	26.37	
TOTAL	924.49	217.21	
System Total		1141.70	
Glycol Storage Tank Capacity (35FT x (2) 12x8 HSS)		1187.12	
DIFFERENCE		45.42L	

REVIEWED AND ACCEPTED AS FINAL AND CORRECTED FOR FABRICATION. MAKE LACTURING MAY PROCEED.

REVIEWED AND ACCEPTED AS NOTED. REVISE AND RE-SUBMIT. MAKE LACTURING MAY PROCEED.

REVIEWED AND RETURNED. CORRECT AND RE-SUBMIT. MAKE LACTURING SHALL NOT PROCEED.

REVIEW NOT REQUIRED. FOR INFORMATION ONLY.

BY: [Signature] DATE: 08/02/12

6002 Z 1 444

OPTION SELECTION	OPTION NUMBER	OPTION DESCRIPTION
☒	2404A	GLYCOL TRANSFER STATION FOR INSTRUMENT GAS SUPPLY (NO OPTION 2411)
☒	2412	GLYCOL SKID STORAGE TANK SIGHT GLASS
☒	128450	KIM HOTSTART, GLYCOL & OIL, W/ PRESSURE SWITCH (SEE ALSO SF-27)
☐		

BILL OF MATERIAL

ITEM	QTY	EFX CODE	DESCRIPTION
2	2	122432	SWITCH, LEVEL, 1-1/2" NPT, XP, CSA, C/W 316SS FLOAT [MURPHY, L1100SF]
3	1	113883H*	TANK, SURGE, 2-COMPARTMENT, 150/59L, A1445/A1478 AS PER DRAWING
4	2	126697	INDICATOR, LEVEL, SIGHT GLASS WINDOW, 10" BOLT CENTER [LUBE DEVICES, G605-10-A-1]
5	2	128917	PLATE, SOLE, SURGE TANK, 150L/59L
6	2	102937	VALVE, BALL, 1" NPT, 2000# WOG, RP, 316SS, NACE C/W LOCKING [NAVCO, C1-R10S20A]
9	2	101238	COUPLING, STRAIGHT, 6", STYLE 38 [DRESSER, 0038-0057-011]
10	3	101245	COUPLING, STRAIGHT, 2", STYLE 90 [DRESSER, 0090-0005-082]
14	2	102973	VALVE, BALL, 3/4" NPT, 2000# WOG, RP, 316SS, NACE C/W [NAVCO, C1-R07S20A]
18	3	102974	VALVE, BALL, 3/8" NPT, 2000# WOG, RP, A105 BODY, NACE C/W [NAVCO, H1-R03S20S]
19	2	112239	RADIATOR CAP & NECK, 2" FNPT, 7 LBS PRESSURE RATING [KENCO, 1794-7]
50	100	129945	COOLANT, 50/50 GLYCOL/WATER (BULK) [UCATHERM, 1277953]
55	2	102315	HOSE CLAMP, 3/8" OD [TRIDON, MH-6]
70	2	116800	VALVE, BUTTERFLY, 6" 150#, WAFER STYLE, DI BODY, [5122BL]
71	4	ON ISO DWG	FLANGE, RF WN, 6" 150# SCH STD SA105N
100	1	123380	THERMOCOUPLE, K TYPE 316SS, 1/4" [THERMOKINETICS, K250-316-S-010.0-B-82X-YM4-72]
110	1	114392	THERMOWELL, 316SS, 1/2" X 3/4" NPTM X 4" LONG, U=2.5", .260" BORE, TAPERED
120	1	102866	VALVE, GLOBE, 1-1/2" NPT, 800# WOG, CS [NEWCO, 28T-FS2]
130	1	102933	VALVE, BALL, 1-1/2" NPT, 2000# WOG, RP, 316SS, NACE C/W [NAVCO, C1-R15S20A]
140	1	NPN***	<<HEAT EXCHANGER, RUFFNECK<<
150	1	102950	VALVE, BALL, 1/4" NPT, 2000# WOG, RP, 316SS, NACE C/W [NAVCO, C1-R02S20A]

OPTIONS

ITEM	QTY	EFX CODE	DESCRIPTION
			OPTION 2404A - GLYCOL TRANSFER STATION FOR INSTR. GAS SUPPLY
21	2	121379	VALVE, BALL, 3-WAY, 3/4" NPT, FULL SS, 800 PSI C/W LOCKING HANDLE [MAS, G4]
22	3	102937	VALVE, BALL, 1" NPT, 2000# WOG, RP, 316SS, NACE C/W LOCKING [NAVCO, C1-R10S20A]
40	1	119928C	PUMP, DIAPHRAGM, LEVEL III ASSEMBLY, 1/2" NPT ALUM, SOUR GAS, CSA [WARREN RUPP, G05]
42	1	120928	VALVE, BALL, 3/8" NPT, 2000# WOG, FP, 316SS, NACE, 2 PIECE [NAVCO, C1-R03S20A]
43	1	127639	ASSEMBLY, BRACKET, CLIP FOR BARREL TRANSFER STATION
			OPTION 2412- GLYCOL SKID STORAGE TANK SIGHT GLASS
60	2	102724	FTG, TUBE, 3/4" T-3/4" NPT 90DEG ELBOW, CS [SWAGelok, S-1210-2-12]
61	1	128246	TUBING, POLYCARBONATE, CLEAR, 3/4" OD X 1/2" I, .125" WALL [GE POLYMER, 81300505]
			OPTIONS: KIM HOTSTART, GLYCOL & OIL, W/ PRESSURE SWITCH (SEE ALSO SF-27)
42	1	114147	VALVE, BALL, 1-1/2" NPT, 1500# WOG, FP, SS, 2 PIECE C/W LOCKING HANDLE [MAS, G2]
43	1	114146	VALVE, BALL, 1" NPT, 2000# WOG, FP, SS, 2 PIECE C/W LOCKING HANDLE [MAS, G2]
44	1	109945	VALVE, CHECK, PISTON, 1" NPT, 800# WOG, CS [NAVCO, CP-R10S08AB]


REV	DESCRIPTION	DATE	DRAWN BY	CHECKED BY
3	AS BUILT	08/02/12	DZH	GW
2	OPTION KIM HOTSTART GLAYCOL W/ PRESSURE SWITCH ADDED	08/01/05	DZH	GW
1	ISSUED FOR CONSTRUCTION	08/12/08	MGN	GW
0	ISSUED FOR APPROVAL	08/10/22	MGN	GW

EFX Compression

4700 47 Street SE Calgary AB Canada T2B 3R1 Canada Tel. +1.403.236.6800 Fax +1.403.279.0367
www.enerflex.com

TITLE:	SERVICE FLOW ENGINE GLYCOL SYSTEM FOR L7042GSI A1478HP
FOR:	ENCANA CORPORATION HORN RIVER
CONSULTANT:	SOLARIS MANAGEMENT CONSULTANTS P.O.: -
DATE:	08/10/22
SCALE:	NTS
DESIGN BY:	MGN
CHKD BY:	GW
APPVD BY:	-
DATE:	08/10/22
DATE:	-
DWG. No.	SF-080359-24
OP	24

- NOTE:
1. SIGN SHOULD BE PLACED ON WARM AIR SELECTOR HANDLE TO INDICATE WARM/COLD AIR SETTINGS.
 2. WHEN THE ESM SYMBOL CONTAINS A FIVE DIGIT NUMBER, THE PANEL IS COMMUNICATING THROUGH MODBUS RS-485 TO THE ESM AND THE NUMBER IS THE ESM MODBUS ADDRESS TO LOCATE THE STORED DATA.

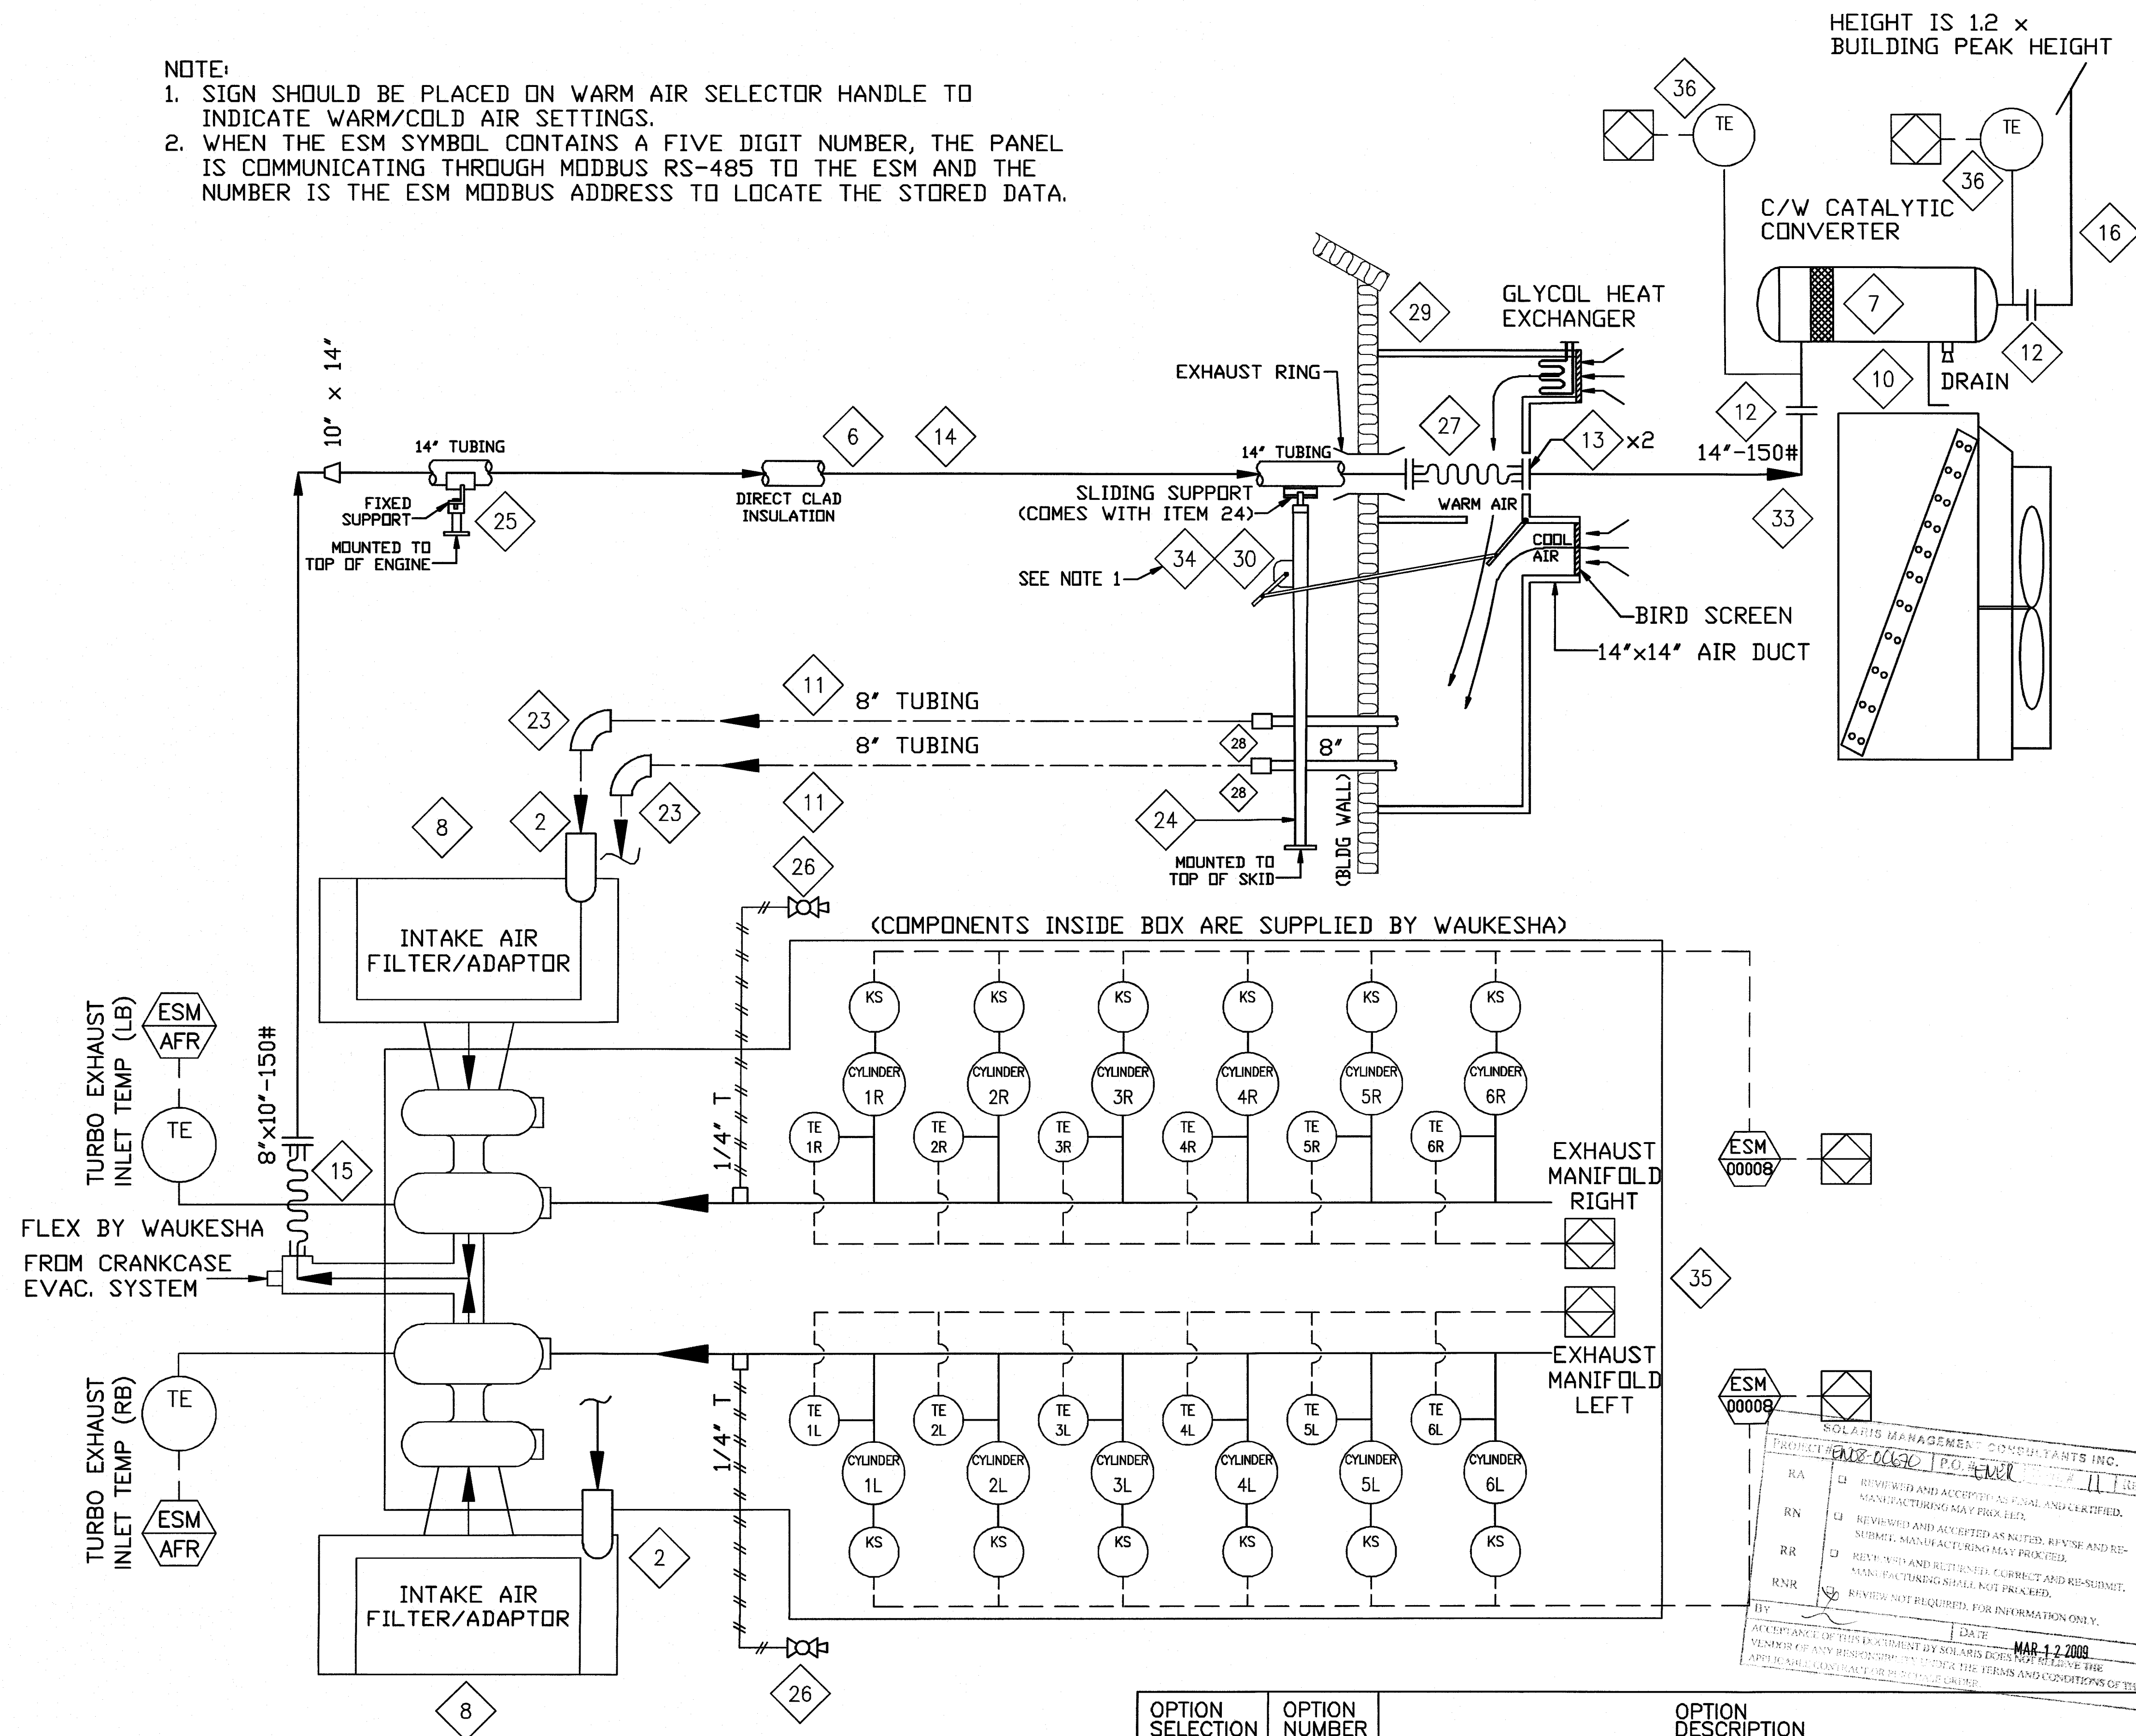

BILL OF MATERIAL


ITEM	QTY	EFX CODE	DESCRIPTION
2	2	103614	ELBOW, RUBBER, 90 DEG, 8" DONALDSON, P11-26061
6	1	NPN-REQ	ASSEMBLY, EXHAUST LINE, 14", SS, WAUKESHA L-VHP SERIES, CUSTOM
7	1	127258	MUFFLER,CATALYTIC CONVERTER,HOSP GR,14"150#EIED (SILENDX, SNT-14-NX60S-ST-LAL
8	2	113677E	AIR FILTER ADAPTER, DRY TYPE, 8" OD, WAUKESHA L-VHP, A1445/A1478
10	1	121763C	SUPPORT, MUFFLER, COOLER MOUNTED
11	1set	113676C	INTAKE LINE, AIR, CS, 8" OD, WAUKESHA L-VHP, A1445/A1478
12	2	113500	GASKET, EXHAUST, NON-ASBESTOS, NA-60, 1/16" THK, 14" 150#FF EXTERNAL STYLE, 500F
13	2	113509	GASKET, EXHAUST, NON-ASBESTOS, NA-60, 1/16" THK, 14" INTERNAL STYLE, 500F
14	1	122059	INSULATION, FOR 14" 150# SS EXHAUST LINE, NO AIR SPACE, CUSTOM
15	1	121922	GASKET, EXHAUST, THERMICULITE, 1/16" THK, 8" 150# FF EXTERNAL STYLE, 1400 DEG.F
16	1	NPN	EXHAUST STACK, 14" ANSI
23	2	113759	ELBOW, RUBBER, 45 DEG, 8" DONALDSON, P11-26061
24	1	114299J	SUPPORT FRAME, AIR, JW & EXHAUST, WAUKESHA SERIES L VHP, A1445/A1478
25	1	129351	SUPPORT FRAME, AIR & EXHAUST, WAUKESHA SERIES L VHP, A1445/A1478, GC
26	2	102950	VALVE, BALL, 1/4" NPT, 2000# WDG, RP, 316SS, NACE C/W (NAVCD, CI-R02S20A)
27	1	104189	EXPANSION BELLOW, 14" 150# INTERNAL FLANGES C/W 2" COLLAR & SS LINER X 12" LONG
28	2	103610	HUMPHOSE, STRAIGHT, RUBBER, 8" DONALDSON, P11-26081
29	1	128961	AIR INTAKE, TWO-WAY DIVERTER, WARM/COOL AIR, A1478 1/2/3 STAGE
30	1	127128B	MANUAL POSITIONER FOR WARM AIR SELECTOR, A1478
33	1	NPN-REQ	EXHAUST LINE, CS, 14", FLANGED, WAUKESHA SERIES, EXTERIOR, CUSTOM
34	1	127827B	SIGN, ADHESIVE BACKED, RECTANGULAR, 1" X 7" LONG, WHITE PERMAGRIP VINYL
35	1	NPN	PYROMETER (SUPPLIED BY WAUKESHA)
36	2	104483	T-COUPLE ASSY, K TYPE C/W T-WELL, 316SS, 1/2" NPTM, U=2.5" (MURPHY, TCK225)

REV	DESCRIPTION	DATE	DRAWN BY	CHECKED BY
3	AS BUILT	08/02/12	DZH	GW
2	ITEMS # 9 DELETED AND ITEMS # 36 ADDED ON BOM	09/01/05	CAL	GW
1	ISSUED FOR CONSTRUCTION	08/12/08	MGN	GW
0	ISSUED FOR APPROVAL	08/10/23	MGN	GW

EFX Compression

4700 47 Street SE Calgary AB Canada T2B 3R1 Canada Tel. +1.403.236.6800 Fax +1.403.279.0367
www.enerflex.com

TITLE:		SERVICE FLOW AIR AND EXHAUST SYSTEM - WAUKESHA L7042 GSI 1478HP STANDARD ENCANA PACKAGE		
FOR:		ENCANA CORPORATION HORN RIVER		
CONSULTANT: SOLARIS MANAGEMENT CONSULTANTS		LSD: C-67-K/94-0-8 JOB No.: 080359		
DRWN BY: MGN	DESIGN BY: MGN	DATE: 08/10/21	DWG. No.	OP
DATE: 08/10/22	CHKD BY: GW	DATE: -	SF-080359-26	26
SCALE: NTS	APPRD BY: -	DATE: -		

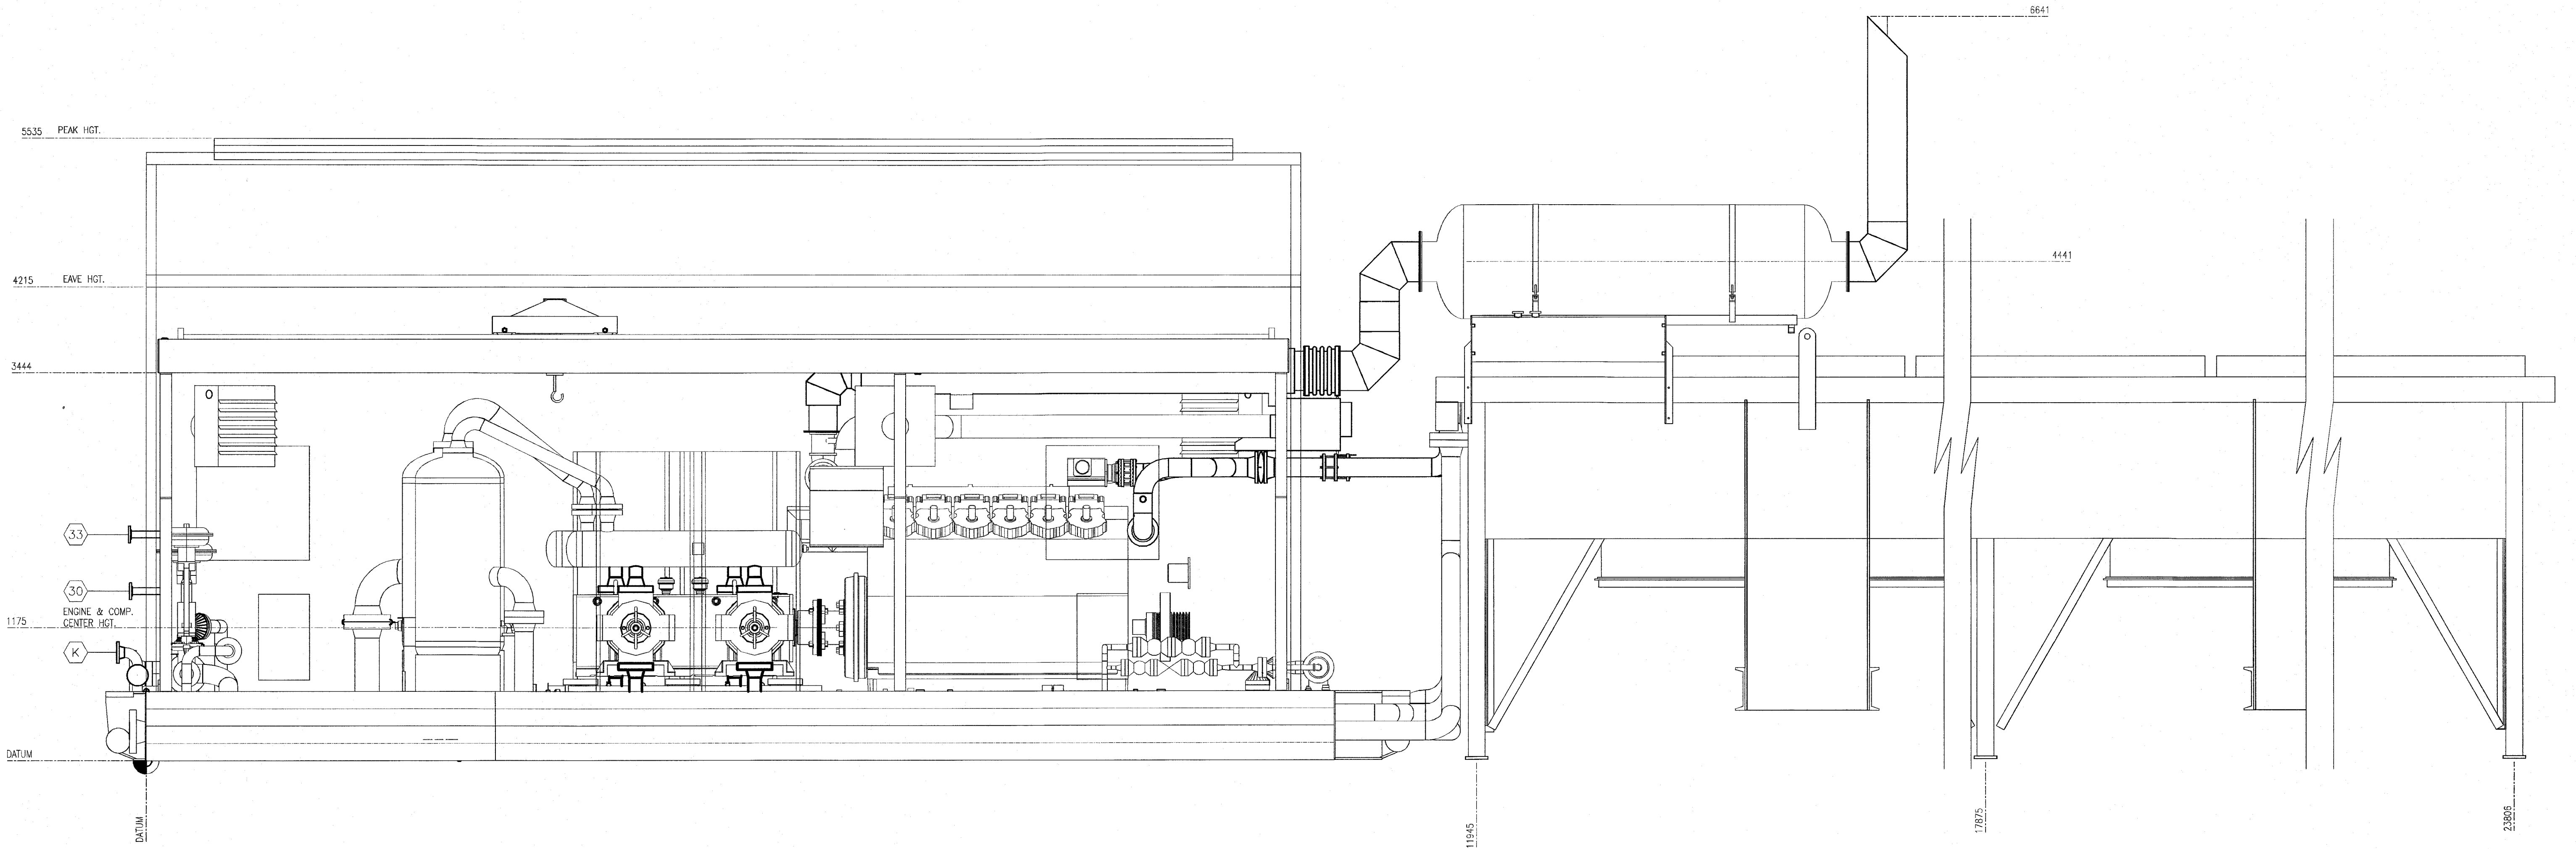

ELEVATION 'A-A'

SOLARIS MANAGEMENT CORPORATION
Project: ENCANA CORP. - GULF SHEET 5
Drawing: ENC-080359-1
RA ☐ REVIEWED AND ACCEPTED FOR MANUFACTURING MAY PROCEED.
RN ☐ REVIEWED AND ACCEPTED AS NOTED, REVISE AND RESUBMIT. MANUFACTURING MAY PROCEED.
RR ☐ REVIEWED AND RETURNED CORRECT AND RESUBMIT. MANUFACTURING SHALL NOT PROCEED.
RNP ☒ REVIEW NOT REQUIRED FOR INFORMATION ONLY.
BY: [Signature] DATE: MAR 12 2009
I, [Signature], ACCEPTANCE OF THIS DOCUMENT BY SOLARIS DOES NOT RELIEVE THE VENDOR OF ANY RESPONSIBILITY UNDER THE TERMS AND CONDITIONS OF THE APPLICABLE CONTRACT.

REV	DESCRIPTION	DATE	DRAWN BY	CHECKED BY
5	AS BUILT	09/02/02	MGN	GW/DZH
4	ADDED COOLER DIMENSION (SEE PAGE 1)	09/01/22	CAL	GW
3	ADD A GLOBAL VALVE ON THE BY-PASS	09/01/07	CAL	GW
2	GENERAL REVISION	08/12/30	MGN	GW
1	ISSUED FOR CONSTRUCTION	08/12/08	MGN	GW
0	FOR APPROVAL	08/11/03	HJZ	GW

BFX Compression

4700 47 Street SE Calgary AB Canada T2B 3R1 Canada Tel: +1.403.236.6800 Fax: +1.403.279.6367
www.enerflex.com

TITLE:		ELEVATION VIEW 'A-A'	
		ARIEL JGK/4, WAUKESHA L7042 GSI, AXC 144 2Z	
		COMPRESSOR PACKAGE	
FOR:		ENCANA CORPORATION	
CONSULTANT:		SOLARIS MANAGEMENT CON. INC.	
P.O.:		LSD: C-37-K/94-0-8	
		JOB No.: 080359	
DRWN BY: HJZ	DESIGN BY: HJZ	DATE: 08/11/03	DWG. No.
DATE: 08/11/03	CHKD BY:	DATE:	OP#
SCALE: 1:30	APPVD BY:	DATE:	GA-080359 10