


THIS DRAWING IS SOLE PROPERTY OF BIDELL EQUIPMENT INC.
AND SHALL NOT BE REPRODUCED, COPIED, LENT, ALTERED
NOR USED FOR ANY PURPOSE OTHER THAN WHICH IT IS FURNISHED
EXCEPT WITH THE WRITTEN PERMISSION OF BIDELL EQUIPMENT INC.

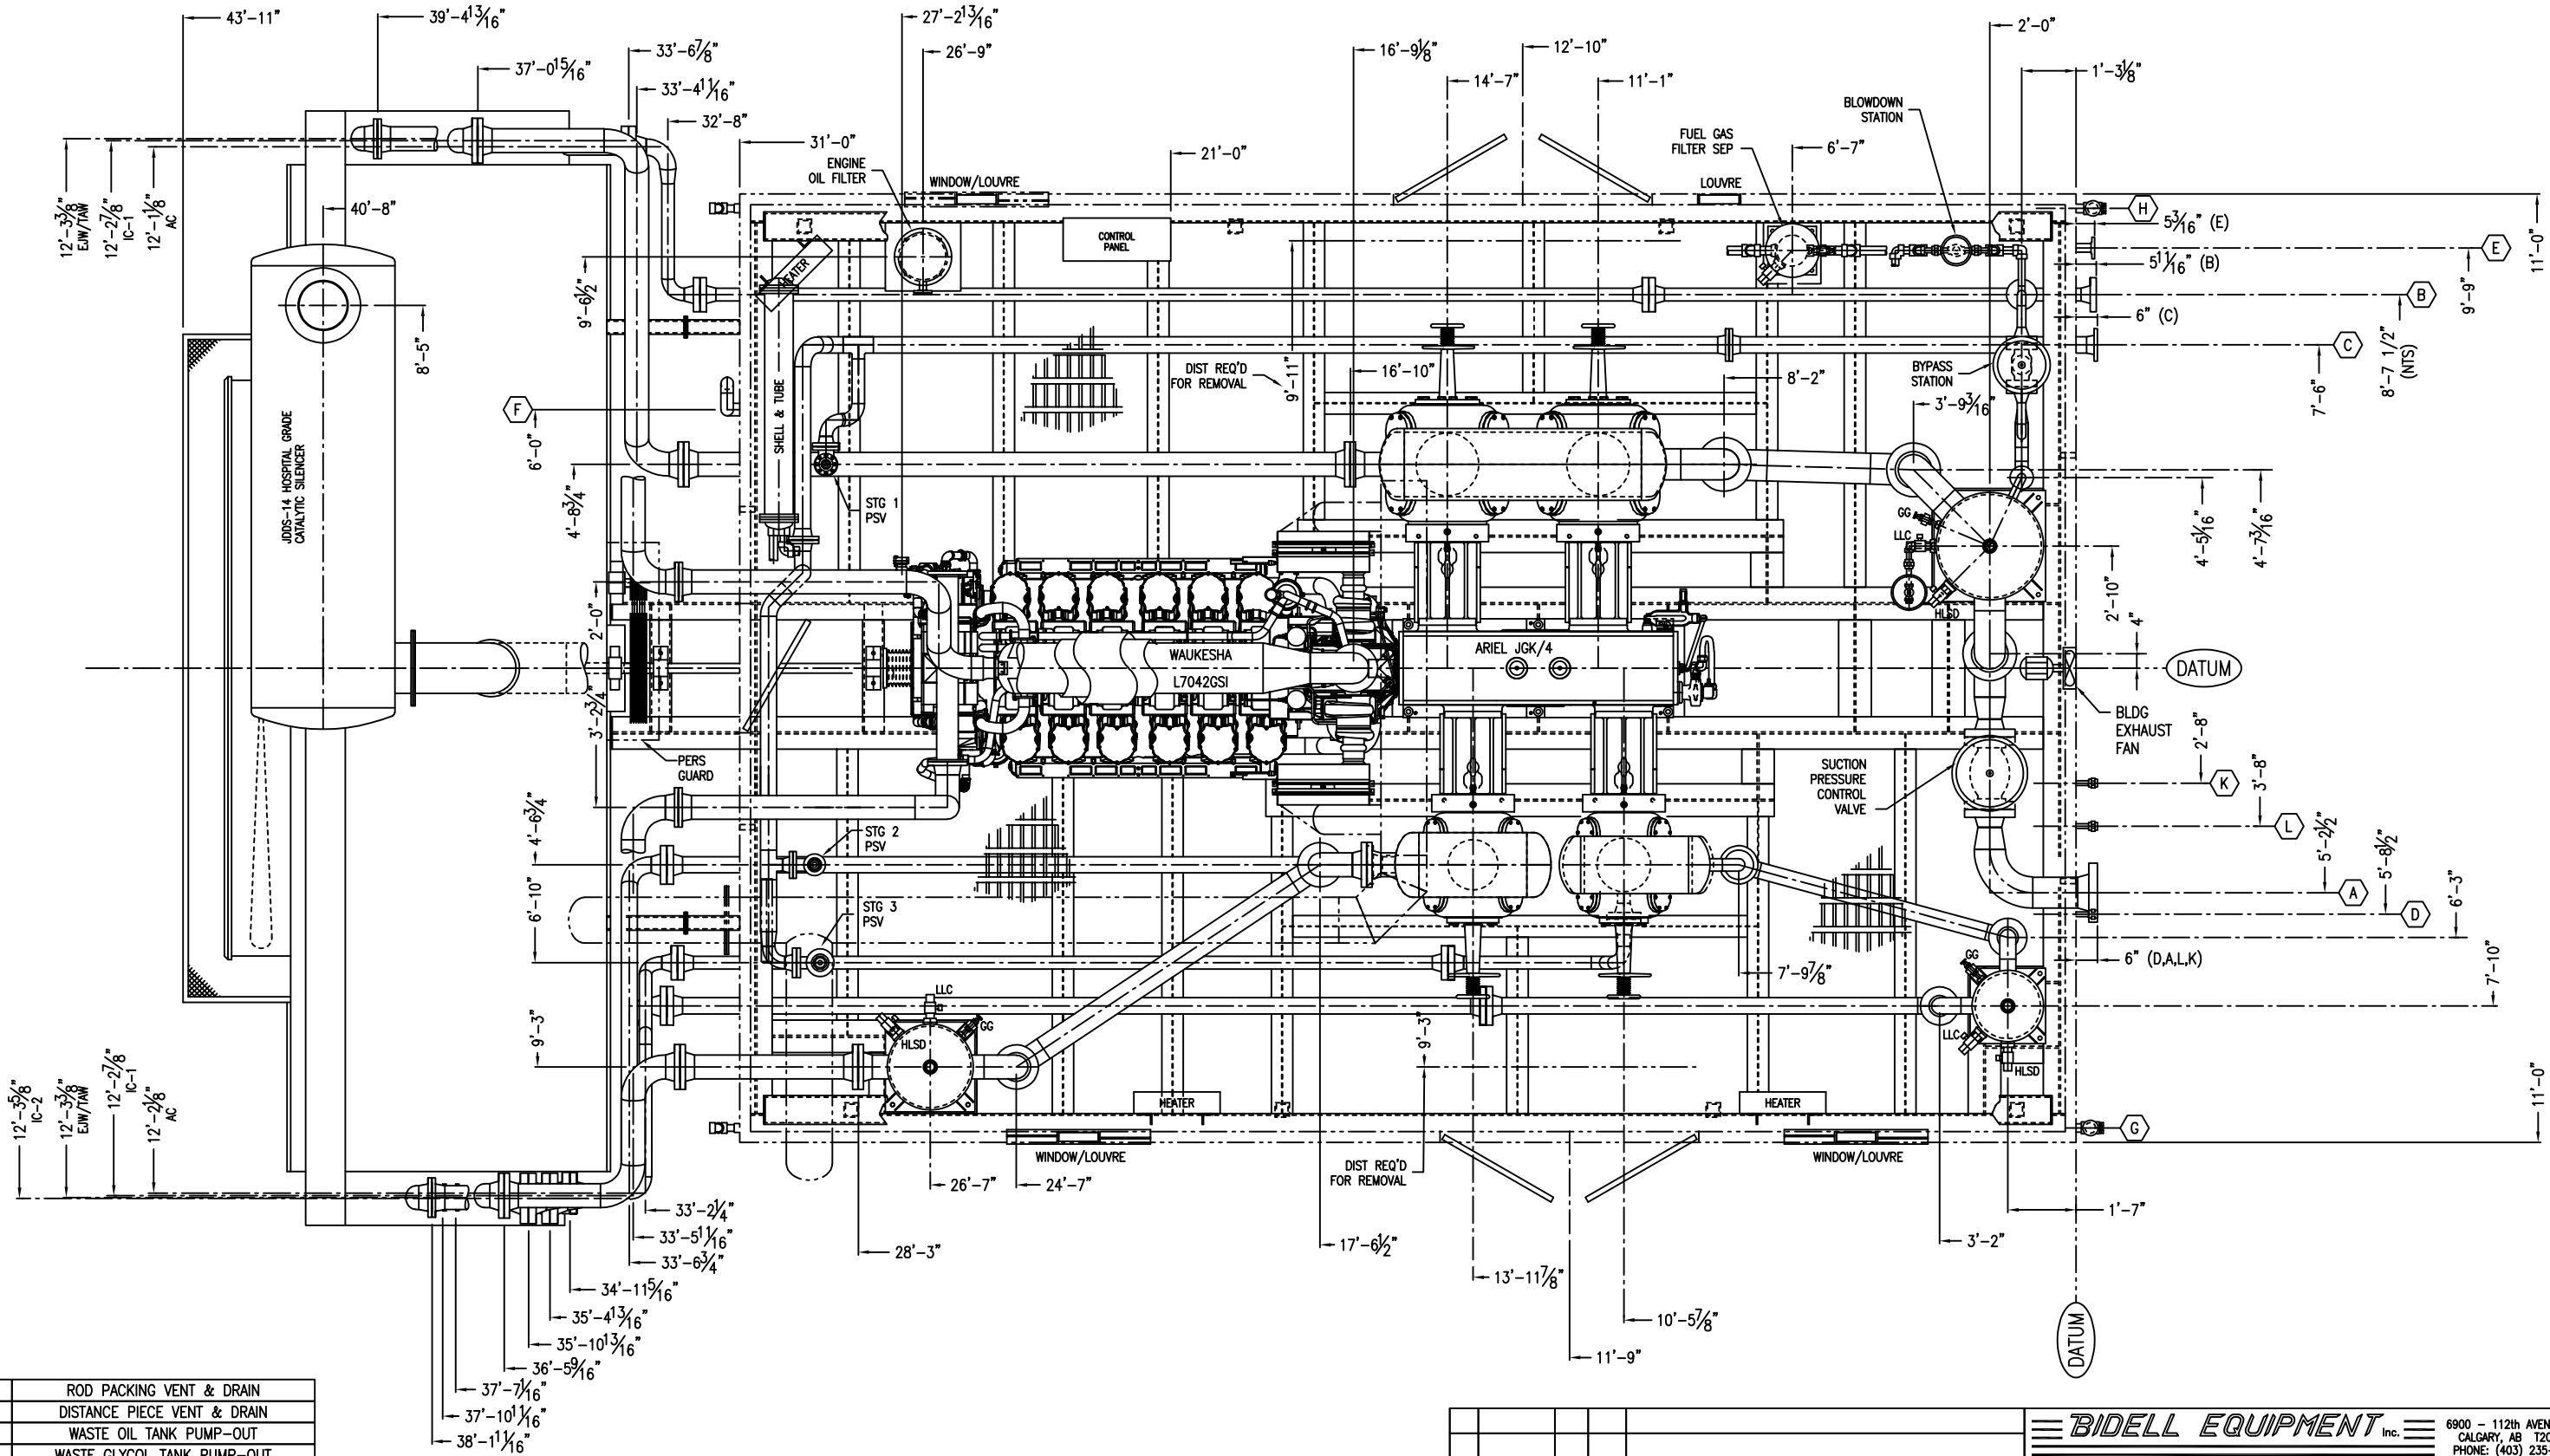

L	1"-NPT	ROD PACKING VENT & DRAIN
K	1"-NPT	DISTANCE PIECE VENT & DRAIN
H	2"-NPT	WASTE OIL TANK PUMP-OUT
G	2"-NPT	WASTE GLYCOL TANK PUMP-OUT
F	3"-PIPE	ENGINE STARTER EXHAUST
E	2"-150#RF THRD	ENGINE START/FUEL GAS SUPPLY
D	1"-NPT	SCRUBBER DRAIN MANIFOLD
C	4"-150#RF	RELIEF VALVE HEADER
B	3"-900#RF	DISCHARGE OUTLET
A	8"-600#RF	SUCTION INLET
TAG	SIZE & RATING	SERVICE / DESCRIPTION

SCHEDULE OF OPENINGS

UNIT DESIGNED FOR JACK & ROLL LOADING ONLY
TOTAL PACKAGE WEIGHT = APPROX 152,000 lbs (w/o COOLER)
TOTAL COOLER WEIGHT = 25,900 lbs
TOTAL PACKAGE LENGTH = APPROX 34'-8" (w/o COOLER)
TOTAL PACKAGE WIDTH (Incl. Eaves) = 22'-8" (w/o COOLER)
TOTAL PACKAGE HEIGHT = APPROX 18'-10"

REV	DATE	BY	APPR	DESCRIPTION
A	04-07-19	BK	LT	AS BUILT
O	04-05-07	LS	LT	ISSUED FOR APPROVAL
				REVISIONS

BIDELL EQUIPMENT Inc.		6900 - 112th AVENUE S.E. CALGARY, AB T2C 4Z1 PHONE: (403) 235-5877 FAX: (403) 272-7749
GAS COMPRESSION		
GENERAL ARRANGEMENT		
WAUKESHA L7042GSI / ARIEL JGK/4 / AIR-X-HEMPHILL 144EF		
CUSTOMER: CAVELL ENERGY CORPORATION c/o SEIDLITZ ENGINEERING LTD		JOB#: 03-248
LOCATION: RECIPROCATING COMPRESSOR		LS: 02-02-69-03 WSM
SERVICE: SOUR GAS		
DWN	DATE	SCALE
LS	04-05-07	1/4" = 1'-0"
DWG#	03-248-100A	
REV	A	