


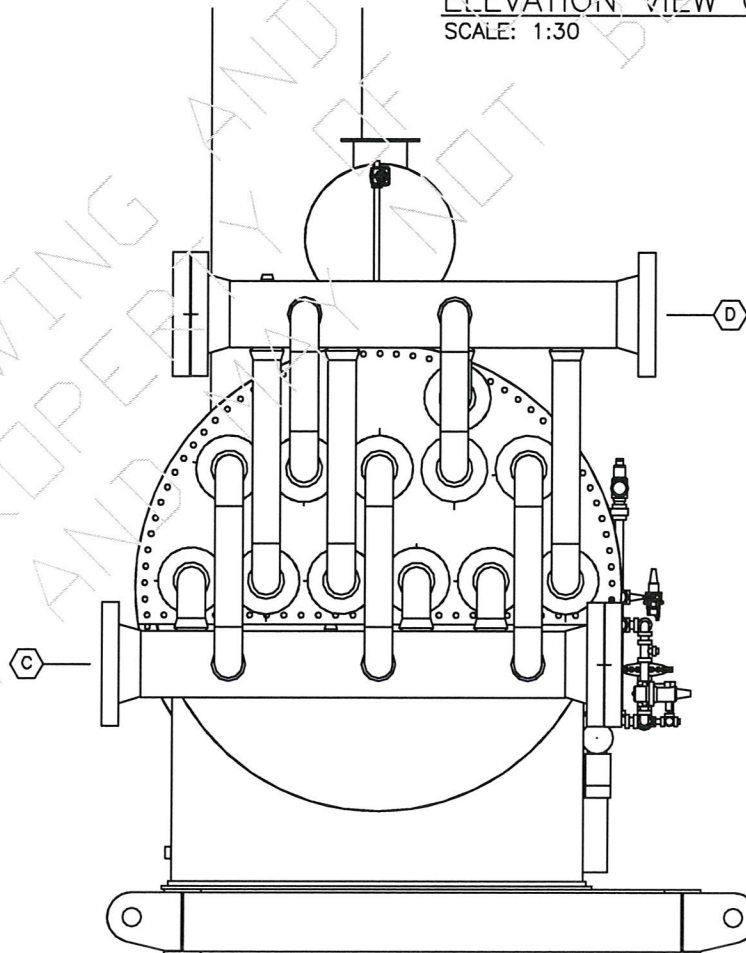

ELEVATION VIEW C
SCALE: 1:30



ELEVATION VIEW D
SCALE: 1:30

AS BUILT

1	17-09-18	AS BUILT	KG	
0	17-06-05	ISSUED FOR CONSTRUCTION	KG	JB
NO.	DATE	REVISION	BY	APP
<div><div></div><div>CAPE MANUFACTURING LTD. PO BOX# 216 HALKIRK, AB T0C 1M0 TELEPHONE: (403) 884-2442</div><div></div></div>				
CLIENT: BIRCHILL CANADA LTD. PARTNERSHIP c/o: OEL PROJECTS LTD.				
LSD: 11-13-43-13 W5M		<u>72" OD LINE HEATER</u>		
DATE: 17-04-12		72" OD x 24'-0" F/F, 2.5MMBTU		
JOB NO.: CML-170649		24 PASSES OF 4"-600CL RF		
SCALE: SEE DWG.				
DRAWN BY: KG				
CHECKED BY: DH		DWG NO.: CML-160520ELE		REV. 1
SHEET 2 OF 2				