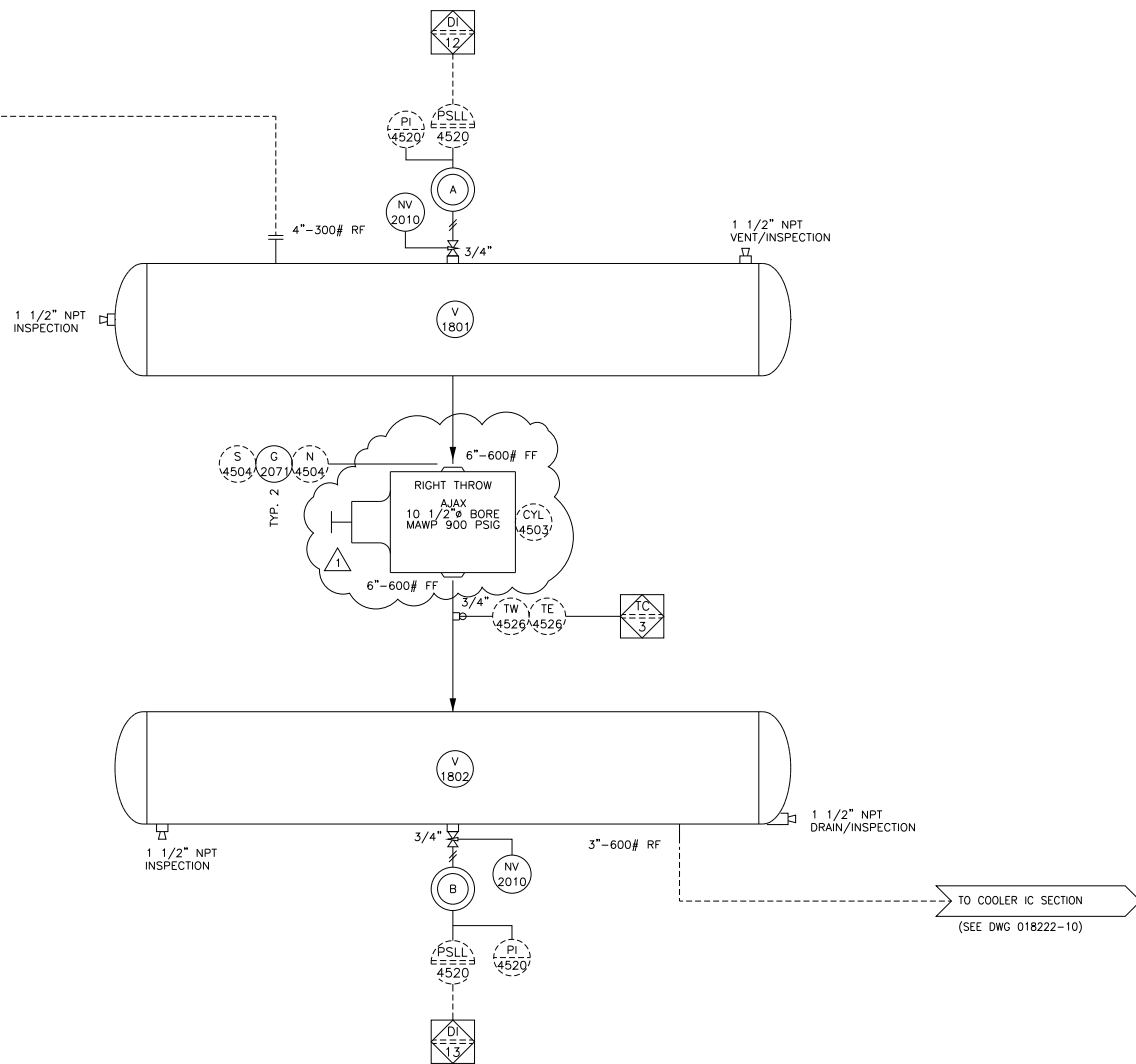
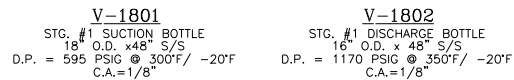
[illegible][illegible]


GENERAL NOTES	
1. PROCESS INSTRUMENT LINES:	316SS TUBING c/w 3/8" 316SS SWAGelok FITTINGS & 316SS FERRULES.
2. UTILITY INSTRUMENT LINES:	316SS TUBING c/w 3/8" 316SS SWAGelok FITTINGS & 316SS FERRULES.
3. INSTRUMENT MEDIUM:	CLEAN DRY GAS (UPTO 1.5% H2S CONTENT)
4. ALL PIPING 2" AND UNDER TO BE XH MINIMUM.	
5. ALL FITTINGS TO BE 6000# RATING UNLESS OTHERWISE NOTED.	
6. CORROSION ALLOWANCE: 1/8"	
7. AREA CLASSIFICATION:	CLASS 1, DIVISION 2
8. CONDUIT TYPE:	ALUMINUM
9. INSTRUMENT TAGS REQUIRED:	☐ YES ☒ NO
10. SURFACE PREPARATION:	SSPC SP2
11. PAINT (1) COATS:	UC STD HIGH SOLIDS EPOXY (WARM GREY)

STAMP AREA				 UNIVERSAL[®] COMPRESSION 4949 - 76th Avenue S.E. 403/236-5252 Main P.O. Box 5308, Station 'A' 800/661-5252 Toll Free Calgary, Alberta, Canada T2H 1X6 403/236-4261 Fax			
THIS DOCUMENT IS SUPPLIED IN CONFIDENCE. REPRODUCTION OR DISTRIBUTION IN WHOLE OR PART WITHOUT THE WRITTEN PERMISSION OF UNIVERSAL COMPRESSION INC. IS STRICTLY PROHIBITED.				TITLE: PROCESS & INSTRUMENT DIAGRAM AJAX DPC-2202, AMERCOOL 72VCI, 2 THROW, 2 STAGE NATURAL GAS COMPRESSOR PACKAGE (UP TO 5% SOUR)			
				END USER/CONSULTANT: LEASE FLEET LOCATION: TBA LSD: TBA			
3	KMB	CHANGED STG.#2 PSV SETTING TO 9700 kPa	25 FEB 03	DWG. REFERENCE: 998188-D-10 (REV.0)		REVISION: 3 DWG. No. 018222-D-10 (SHEET 1 OF 1)	
2	KMB	BM ADDED AUTO SPEED / BYPASS	21 FEB 03	DRAWN: DGD DATE: 01 FEB 00		W.O. No. 018222 UNIT No. -	
1	MD	BM AS BUILT	18 DEC 01	CHK'D: B.MINSHULL PROJ. MGR: B.MINSHULL		No. REQ'D: ONE(1) SCALE: N.T.S.	
0	MD	BM ISSUED FOR FABRICATION	13 NOV 01				
REV.	BY	CHK'D	REVISION DESCRIPTION	DATE			

[illegible][illegible]



GENERAL NOTES	
1.	SEE DWG. 018222-D-10 FOR NOTES.

STAMP AREA						 UNIVERSAL[®] COMPRESSION 4949 - 76th Avenue S.E. P.O. Box 5308, Station 'A' Calgary, Alberta, Canada T2H 1X6 403/236-5252 Main 800/661-5252 Toll Free 403/236-4261 Fax					
THIS DOCUMENT IS SUPPLIED IN CONFIDENCE. REPRODUCTION OR DISTRIBUTION IN WHOLE OR PART WITHOUT THE WRITTEN PERMISSION OF UNIVERSAL COMPRESSION INC. IS STRICTLY PROHIBITED.						TITLE: STAGE ONE PRESSURE VESSEL SYSTEM					
						AJAX DPC--2202, AMERCOOL 72VCI, 2 THROW, 2 STAGE NATURAL GAS COMPRESSOR PACKAGE (UP TO 5% SOUR)					
						END USER/CONSULTANT:			CUST. P.O. No.:		
						LEASE FLEET			-		
						LOCATION: TBA			REVISION: 1		
						LSD: TBA			DWG. REFERENCE: 998188-D-20 (REV.0)		
						DRAWN: DGD		W.O. No. 018222			
						DATE: 01 FEB 00		UNIT No. --		DWG. No. --	
1 MD STG.#1 CYL. REVISED TO 10.5" (WAS9.5") 12 FEB 02						CHK'D: B.MINSHULL		No. REQ'D ONE(1)		018222-D-20 (SHEET 1 OF 1)	
0 MD BM ISSUED FOR FABRICATION 13 NOV 01						PROJ. MGR: B.MINSHULL		SCALE: N.T.S.			
REV. BY CHK'D REVISION DESCRIPTION DATE											

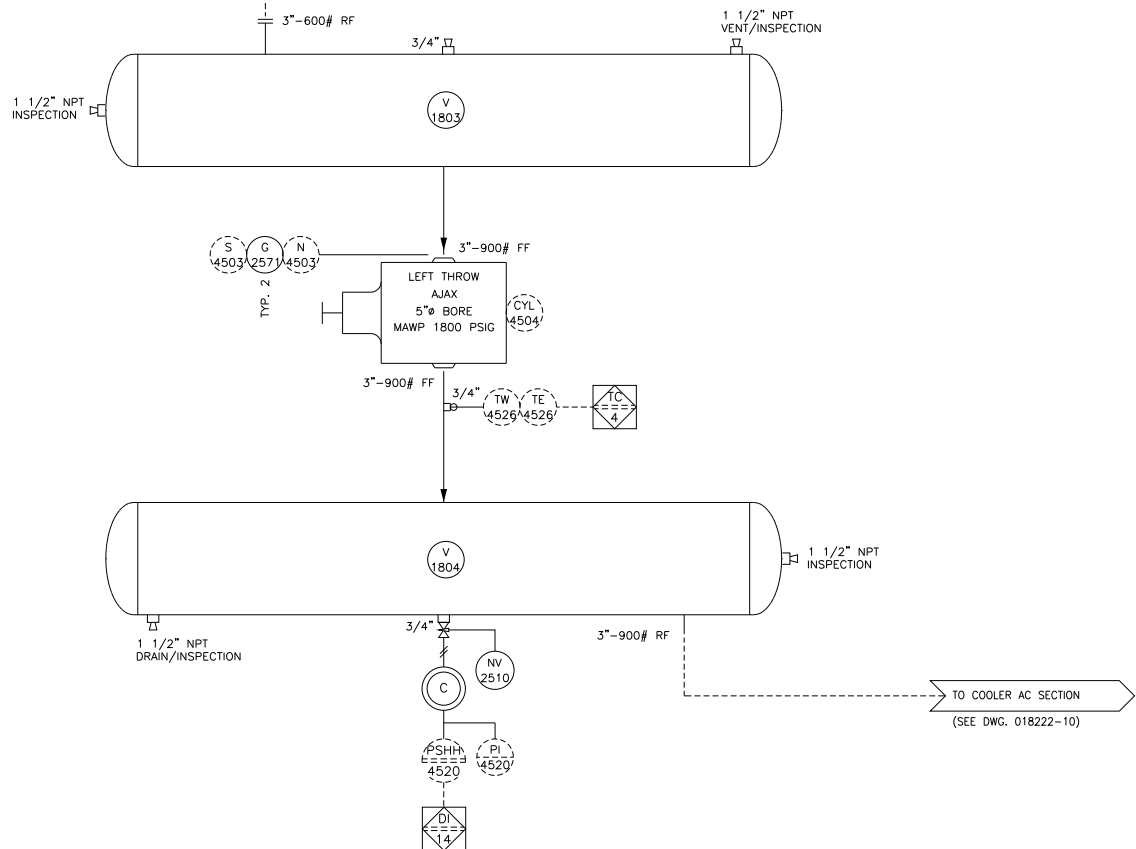[illegible][illegible]


GENERAL NOTES	
1.	SEE DWG 018222-D-10 FOR NOTES.

STAMP AREA						 UNIVERSAL[®] COMPRESSION 4949 - 76th Avenue S.E. P.O. Box 5308, Station 'A' Calgary, Alberta, Canada T2H 1X6 403/236-5252 Main 800/661-5252 Toll Free 403/236-4261 Fax					
						TITLE: STAGE TWO PRESSURE VESSEL SYSTEM AJAX DPC-2202, AMERCOOL 72VCI, 2 THROW, 2 STAGE NATURAL GAS COMPRESSOR PACKAGE (UP TO 5% SOUR)					
THIS DOCUMENT IS SUPPLIED IN CONFIDENCE. REPRODUCTION OR DISTRIBUTION IN WHOLE OR PART WITHOUT THE WRITTEN PERMISSION OF UNIVERSAL COMPRESSION INC. IS STRICTLY PROHIBITED.											
						END USER/CONSULTANT: LEASE FLEET				CUST. P.O. No.: -	
						LOCATION: TBA LSD: TBA				REVISION: 0	
						DRAWN: DGD	W.O. No.	018222		DWG. REFERENCE: 998188-D-25 (REV.0)	
						DATE: 02 FEB 00	UNIT No.	-		DWG. No.	
0	MD		ISSUED FOR FABRICATION			CHK'D:	B.MINSHULL	No. REQ'D:	ONE(1)		018222-D-25
REV.	BY	CHK'D	REVISION DESCRIPTION			DATE	PROJ. MGR:	B.MINSHULL	SCALE:	N.T.S. (SHEET 1 OF 1)	
					13 NOV 01						

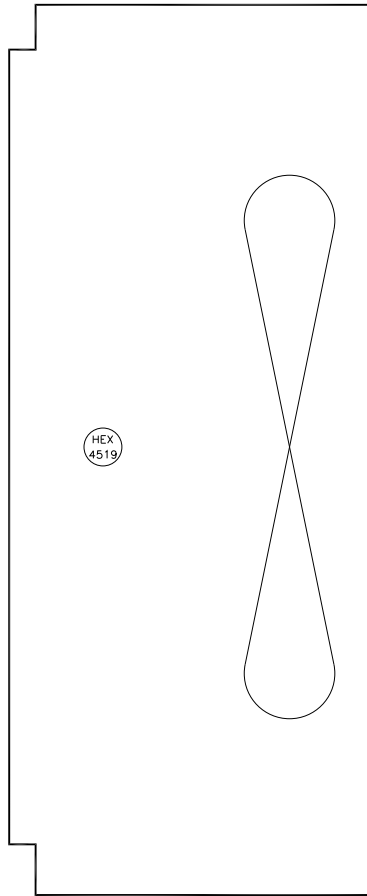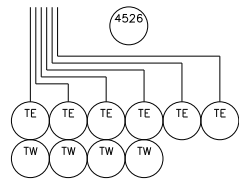

BILL OF MATERIAL				
NOTE: ITEM No. = FIRST TWO DIGITS (Work Center), LAST TWO DIGITS (Item No.)				
ITEM	PART NO.	TOTAL QUANTITY	DESCRIPTION	REV
4500	813-5955	1.00 EA	INTEGRAL,AJAX,DPC-2202	
			INTEGRAL ENGINE-COMPRESSOR	
			STANDARD BURN	
			296HP @ 440RPM	
			LOW PRESSURE TDI STARTER	
4502	813-9996	1.00 EA	VALVE,CONTROL,FISHER,357,	
			1"NPT,WCC STEEL BODY,3/4"	
			17-4PH(DHT)SST MICROFORM TRIM,	
			TFE PACKING,COMPLIES WITH NACE	
			FAIL OPEN,0-35 PSI	
4503	813-4119	1.00 EA	CYLINDER,AJAX,YK11EA,1050-1	
			C/W POPPET VALVES	
4504	813-5949	1.00 EA	CYLINDER,AJAX,YKCC,11500-1@	
			USE P#814-4178	
4519	813-6126	1.00 EA	COOLER,AJAX-2202/2802,72VCI*	
			AJAX DPC-2202/2802STD SOUR GAS	
			COOLER AMI RE: 9H1118C.	
			MODEL 72VCI AIR COOLED HEAT	
			EXCHANGER IN ACCORDANCE WITH	
			THE ENCLOSED SPEC. SHEETS	
			089-01AM THROUGH 089-03AM	
			DATED JANUARY 31, 2000 C/W	
			-SHOP PRIMER FINISH	
			-CRN AND ASME CODE STAMP ON	
			GAS SECTIONS	
			-MANUAL LOUVERS ON EACH GAS	
			COIL	
			-MANUAL LOUVERS ON WATER COIL	
			-BUG SCREENS	
			-HAIL GUARDS	
			-SOUR GAS TRIM	
			-V-BELT FAN DRIVE UTILIZING	
			ONE 15HP TEFC ELECTRIC MOTOR	
4520	813-6135	1.00 EA	PANEL,AJAX,MURPHY,TID-JR,*	
			PANEL-FRONT ACCESS(CLASS I,	
			DIV II)"MURPHYMATIC" CONTROL	
			PANEL HOUSED IN A 24"x30"x9"	
			FRONT ACCESS WALL MOUNT	
			ENCLOSURE W/ FRONT LOCKING	
			DOOR AND A 30" REVERSED FREE-	
			STANDING BASE. PANEL WILL	
4525	813-9126	1.00 EA	PANEL,OPTION,WING,MURPHY,	
			AUTO SPEED/BY-PASS,1-4150 &	
			2-2506,C/W AUTO MANUAL CUTOUTS	
4534	814-7628	1.00 EA	CONTROLLER,FISHER,4150K,	
			0-200PSI,BOURDON TUBE,3-15PSI	
			OUTPUT,PANEL MOUNT,DIRECT	
			ACTING,NACE	
4535	814-7622	1.00 EA	CONTROLLER,FISHER,2506,	
			RECEIVER/CONTROLLER,BELLOWS,	
			3-15PSI IN,6-30PSI OUT,NACE	
4536	814-7625	1.00 EA	CONTROLLER,FISHER,2506,	
			RECEIVER/CONTROLLER,BELLOWS,	
			3-15PSI IN & OUT,NACE	
4537	814-0725	1.00 EA	PANEL OPTION,AUTO MAN,0-60,AJA	
4538	814-7631	1.00 EA	PANEL,ORIFICE,AJAX,	
			AUTO MANUAL,0-30PSI,AJAX	
4539	812-0568	1.00 EA	REGULATOR,FISHER,67CFR-N224,	
			1/4" NPT,0-35PSI,VENT.CAP,SOUR	
4540	813-5571	5.00 EA	~VALVE,NEEDLE,CM2-1-M221-DN-T*	
			CENTURY,0.25"MXF,6000PSI,NACE	
4595	813-4032	1.00 EA	INTEGRALOP,IGN,2202/2802,	
			STANDARD BURN	
4596	813-4215	2.00 EA	COUNTERWEIGHT,AJAX,K-63473J-1	
			SAE 1020STL	
			(6) THERMOCOUPLES (TYPE J)	
			C/W QUICK DISCONNECTS	
			(1) 3-1/2"-3/4" 316SS	
			THERMOWELL	
			(3) 2"-3/4" 316SS THERMOWELL	
			(1) WIRING HARNESS	
			C/W QUICK CONNECTS	

CUSTOMER CONNECTIONS						GENERAL NOTES	STAMP AREA										
TAG	DESCRIPTION		SIZE	TAG	DESCRIPTION		SIZE	FOR NOTES SEE DRAWING 018222-10									

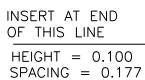

NOTE: ITEM No. = FIRST TWO DIGITS (Work Center), LAST TWO DIGITS (item No.)

NOTE: ITEM No. = FIRST TWO DIGITS (Work Center), LAST TWO DIGITS (item No.)

CUSTOMER CONNECTIONS

GENERAL NOTES

STAMP AREA



4949 - 76th Avenue S.E.
P.O. Box 5308, Station "A"
Calgary, Alberta, Canada T2H 1X6

403/236-5252 Main
800/661-5252 Toll Free
403/236-4261 Fax


TITLE: UTILITIES & INSTRUMENTATION DIAGRAM
AJAX DPC-2202
ENGINE OIL & COOLING SCHEMATIC

END USER/CONSULTANT:	CUST. P.O. No.:
LEASE FLEET	—

LOCATION: TBA	REVISION:	1
LSD: TBA	DWG. REFERENCE:	

DRAWN:	DGD	W.O. No.	018222	998188-D-60 (REV.0)
DATE:	02 FEB 00	UNIT No.	-	

CHK'D:	B.MINSHULL	No. REQ'D:	ONE (1)	018222-D-60 (SHEET 1 OF 1)
PROJ. MGR	B.MINSHULL	SCALE:	N.T.S.	

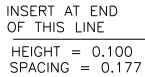

BILL OF MATERIAL

NOTE: ITEM No. = FIRST TWO DIGITS (Work Center), LAST TWO DIGITS (Item No.)				
ITEM	PART NO.	TOTAL QUANTITY	DESCRIPTION	REV
6500	803-9681	1.00 EA	FILTER, HEADLINE, 1,680A21-70C REPLACE ELEMENT #38-152-70C	
6503	807-6913	2.00 EA	VALVE, BALL, SCR, 1-2000, APOLLO, R. PORT, NACE, MODEL# 73-165-01	
6504	804-5803	1.00 EA	VALVE, BALL, SCR, 2-1500, APOLLO* R. PORT, MODEL# 89-108-27*HL	
6506	813-5859	1.00 EA	VALVE, CHECK, BALL, .25"NPT, 3000# SS, 90336 (PREMIER)	
6510	812-4025	1.00 EA	VALVE, RELIEF, FISHER, 1805-2, 1"NPT, WCB, NACE, 5-35 PSIG NITRILE DIA, CLOSING CAP *TEST REPORTS MUST BE SUPPLIED WITH VALVE UPON SHIPMENT.	
6513	813-5571	2.00 EA	VALVE, NEEDLE, CM2-1-M22T-D-N-T* CENTURY, 0.25"MXF, 6000PSI, NACE	
6515	803-9665	1.00 EA	VALVE, FUEL, MURPHY, M5081CM1 2"NPT, ALUM. BODY, CD IGNITION	
6518	813-4902	1.00 EA	REGULATOR, FISHER, 622, NACE, 1"NPT, CS, 5-20 PSI, 1/4" ORIFICE	
6541	800-9762	1.00 EA	STRAINER, Y, 2,NPT, CS, MUELLER, #581, CLASS 600	
6562	803-2252	1.00 EA	GAUGE, PRESS, 2.5, 0-60PSI, WIKA, BTM MOUNT, DUAL SCALE, L.F. MODEL# 233.53	
6564	803-9649	1.00 EA	GAUGE, PRESS, 2.5, 0-200PSI, WIKA, BTM MOUNT, DUAL SCALE, L.F. MODEL# 233.53	
6568	801-3527	1.00 EA	COUPLING, DRESSER, 1.50, STR	
6569	801-3576	1.00 EA	COUPLING, DRESSER, 4.00, STR	

CUSTOMER CONNECTIONS

GENERAL NOTES

STAMP AREA



UNIVERSAL[®] COMPRESSION

4949 - 76th Avenue S.E. 403/236-5252 Main
P.O. Box 5308, Station 'A' 800/661-5252 Toll Free
Calgary, Alberta, Canada T2H 1X6 403/236-4261 Fax

TITLE: UTILITIES & INSTRUMENTATION DIAGRAM
AJAX DPC-2202
FUEL & START GAS SCHEMATIC

END USER/CONSULTANT:	CUST. P.O. No.:
----------------------	-----------------

LEASE FLEET	-
-------------	---

LOCATION: TBA	REVISION: 0
---------------	-------------

LSD: TBA	DWG. REFERENCE: 008188-D-65 (REV 0)
----------	--

DRAWN:	UGD	W.O. No.	018222	990100 9 00 (REV.0)
--------	-----	----------	--------	---------------------


DATE:	02 FEB 00	UNIT No.	-	DWG. No.	
Sheet	01 of 01	N. 550'S	ONE(1)	018233	D 65

CHK'D:	B. MINSHULL	NO. REQ'D:	ONE (1)	018222-D-03 (SHEET 1 OF 1)
PROJ. MGR:	B. MINSHULL	SCALE:	N.T.S.	

NO. 404	DUNNELL	SOFT	N.Y.S.	(SHEET 1 OF 1)
---------	---------	------	--------	----------------


HEIGHT = 0.100
SPACING = 0.177

NOTE: ITEM No. = FIRST TWO DIGITS (Work Center), LAST TWO DIGITS (item No.)

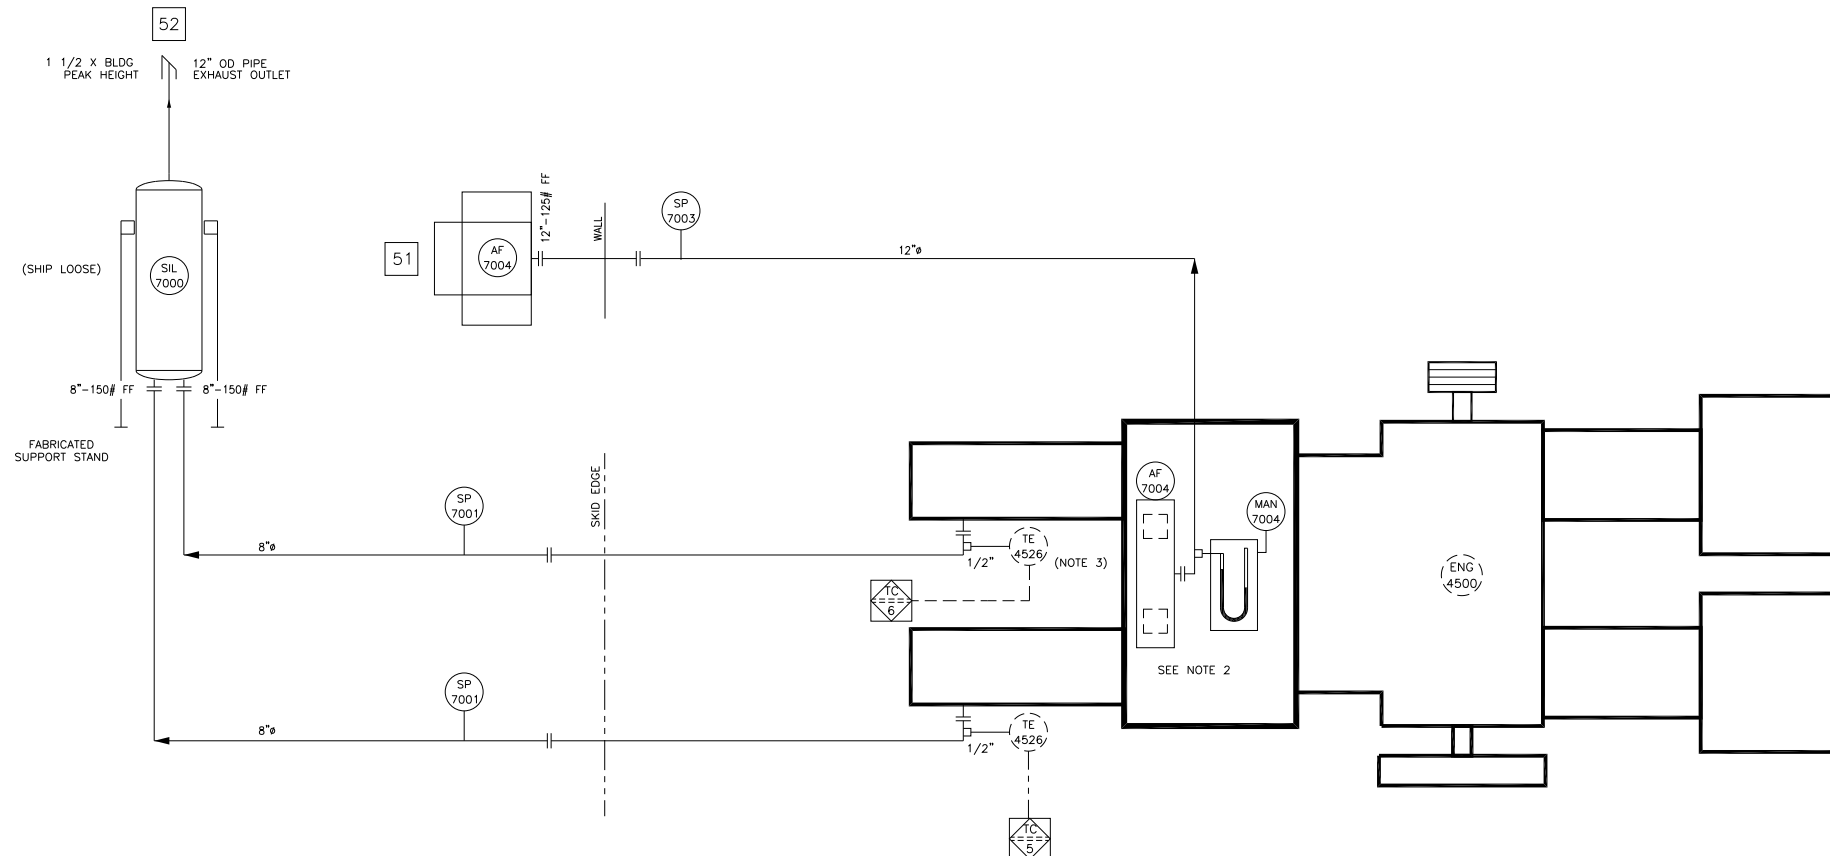
[illegible][illegible]

- ## GENERAL NOTES
-
1. SEE DWG. 018222-D-10 FOR NOTES.
 2. REED VALVE ASSEMBLY TO BE LOCATED ON TOP OF AIR MANIFOLD ASSEMBLY.
 3. LOCATE THERMOCOUPLE ON 1/2" T.O.L., 6" BELOW MACHINED FACE OF POWER CYLINDER. (SEE TE4526 ON EXHAUST SPOOL)
-
1. UTILITY INSTRUMENT LINES: 316SS TUBING
 c/w SWAGELOCK CAD PLATED
 FITTINGS & 316SS FERRULES.
 2. INSTRUMENT MEDIUM: CLEAN, DRY GAS.
 3. ALL PIPING 2" & UNDER TO BE XH MINIMUM.
 4. ALL FITTINGS TO BE 3000# RATING UNLESS OTHERWISE NOTED.
 5. AREA CLASSIFICATION: TBA.
 6. CONDUIT TYPE: TBA.
 7. INSTRUMENT TAGS REQUIRED: ☐ YES ☐ NO
 8. ARRANGE ALL PIPING TO AVOID LIQUID TRAPS.

STAMP AREA			
THIS DOCUMENT IS SUPPLIED IN CONFIDENCE. REPRODUCTION OR DISTRIBUTION IN WHOLE OR PART WITHOUT THE WRITTEN PERMISSION OF UNIVERSAL COMPRESSION INC. IS STRICTLY PROHIBITED.			
0	MD		
REV.	BY	CHK'D	DATE
		ISSUED FOR FABRICATION	13 NOV 01
		REVISION DESCRIPTION	

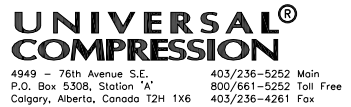

TITLE: UTILITIES & INSTRUMENTATION DIAGRAM				
AJAX DPC-2202				
INTAKE & EXHAUST SCHEMATIC				
END USER/CONSULTANT:			CUST. P.O. No.:	
LEASE FLEET			-	
LOCATION: TBA			REVISION: 0	
LSD: TBA			DWG. REFERENCE:	
			998188-D-70 (REV.0)	
DRAWN:	DGD	W.O. No.	018222	
DATE:	02 FEB 00	UNIT No.	-	DWG. No.
CHKD:	B.MINSHULL	No. REQ'D:	ONE(1)	018222-D-70
PROJ. MGR	B.MINSHULL	SCALE:	N.T.S.	(SHEET 1 OF 1)

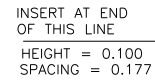[illegible][illegible]

- | GENERAL NOTES | |
|---------------|--|
| 1. | SEE DWG. 018222-D-10 FOR NOTES. |
| 1. | UTILITY INSTRUMENT LINES: 316SS TUBING
c/w SWAGELOCK CAD PLATED
FITTINGS & 316SS FERRULES. |
| 2. | INSTRUMENT MEDIUM: CLEAN, DRY GAS. |
| 3. | ALL PIPING 2" & UNDER TO BE XH MINIMUM. |
| 4. | ALL FITTINGS TO BE 3000# RATING UNLESS OTHERWISE NOTED. |
| 5. | AREA CLASSIFICATION: TBA. |
| 6. | CONDUIT TYPE: TBA. |
| 7. | INSTRUMENT TAGS REQUIRED: ☐ YES ☐ NO |
| 8. | ARRANGE ALL PIPING TO AVOID LIQUID TRAPS. |

STAMP AREA



**UNIVERSAL[®]
COMPRESSION**


4949 - 76th Avenue S.E.
P.O. Box 5308, Station "A"
Calgary, Alberta, Canada T2H 1X6

403/236-5252 Main
800/661-5252 Toll Free
403/236-4261 Fax

TITLE: UTILITIES & INSTRUMENTATION DIAGRAM
AJAX DPC-2202
COMPRESSOR PACKING VENT & DRAIN SCHEMATIC


THIS DOCUMENT IS SUPPLIED IN CONFIDENCE. REPRODUCTION OR DISTRIBUTION IN WHOLE OR PART WITHOUT THE WRITTEN PERMISSION OF UNIVERSAL COMPRESSION INC. IS STRICTLY PROHIBITED.

WHOLE OR PART WITHOUT THE WRITTEN PERMISSION OF UNIVERSAL COMPRESSION INC. IS STRICTLY PROHIBITED.										END USER/CONSULTANT: LEASE FLEET										CUST. P.O. No.: —										
										LOCATION: TBA LSD: TBA										REVISION: 0										
										DRAWN: DGD DATE: 02 FEB 00 W.O. No. 018222 UNIT No. —										DWG. REFERENCE: 998188-D-80 (REV.0)										
ISSUED FOR FABRICATION										13 NOV 01										DWG. No. 018222-D-80										
0	MD	REVISION DESCRIPTION								CHK'D: B.MINSHULL PROJ. MGR										NO. REV'D: ONE(1) SCALE: N.T.S.										
REV.	BY	CHK'D	REVISION DESCRIPTION								DATE										(SHEET 1 OF 1)									


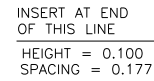
[illegible][illegible]

- | GENERAL NOTES | |
|---------------|--|
| 1. | SEE DWG.018222-D-10 FOR NOTES. |
| 2. | GENERATOR STAND SHOP TO FIT. |
| 1. | UTILITY INSTRUMENT LINES: 316SS TUBING
c/w SWAGELOCK CAD PLATED
FITTINGS & 316SS FERRULES. |
| 2. | INSTRUMENT MEDIUM: CLEAN, DRY GAS. |
| 3. | ALL PIPING 2" & UNDER TO BE XH MINIMUM. |
| 4. | ALL FITTINGS TO BE 3000# RATING UNLESS OTHERWISE NOTED. |
| 5. | AREA CLASSIFICATION: TBA. |
| 6. | CONDUIT TYPE: TBA. |
| 7. | INSTRUMENT TAGS REQUIRED: ☐ YES ☐ NO |
| 8. | ARRANGE ALL PIPING TO AVOID LIQUID TRAPS. |

						STAMP AREA		 UNIVERSAL[®] COMPRESSION 4949 - 76th Avenue S.E. P.O. Box 5308, Station 'A' Calgary, Alberta, Canada T2H 1X6 403/236-5252 Main 800/661-5252 Toll Free 403/236-4261 Fax			
THIS DOCUMENT IS SUPPLIED IN CONFIDENCE. REPRODUCTION OR DISTRIBUTION IN WHOLE OR PART WITHOUT THE WRITTEN PERMISSION OF UNIVERSAL COMPRESSION INC. IS STRICTLY PROHIBITED.						TITLE: UTILITIES & INSTRUMENTATION DIAGRAM					
						AJAX DPC-2202 COOLER DRIVE SCHEMATIC					
						END USER/CONSULTANT: LEASE FLEET				CUST. P.O. No.: —	
						LOCATION: TBA LSD: TBA				REVISION: 0	
						DRAWN: DGD		W.O. No.	018222		
						DATE: 02 FEB 00		UNIT No.	—		
						CHK'D: B.MINSHULL		No. REQ'D:	ONE (1)		
						PROJ. MGR: B.MINSHULL		SCALE:	N.T.S.		
REV. BY CHK'D ISSUED FOR FABRICATION 13 NOV 01						DATE		DWG. No. 018222-D-85			
REV. BY CHK'D REVISION DESCRIPTION						DATE		(SHEET 1 OF 1)			

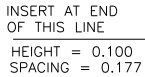[illegible]

CUSTOMER CONNECTIONS						GENERAL NOTES	STAMP AREA	<
----------------------	--	--	--	--	--	---------------	------------	---

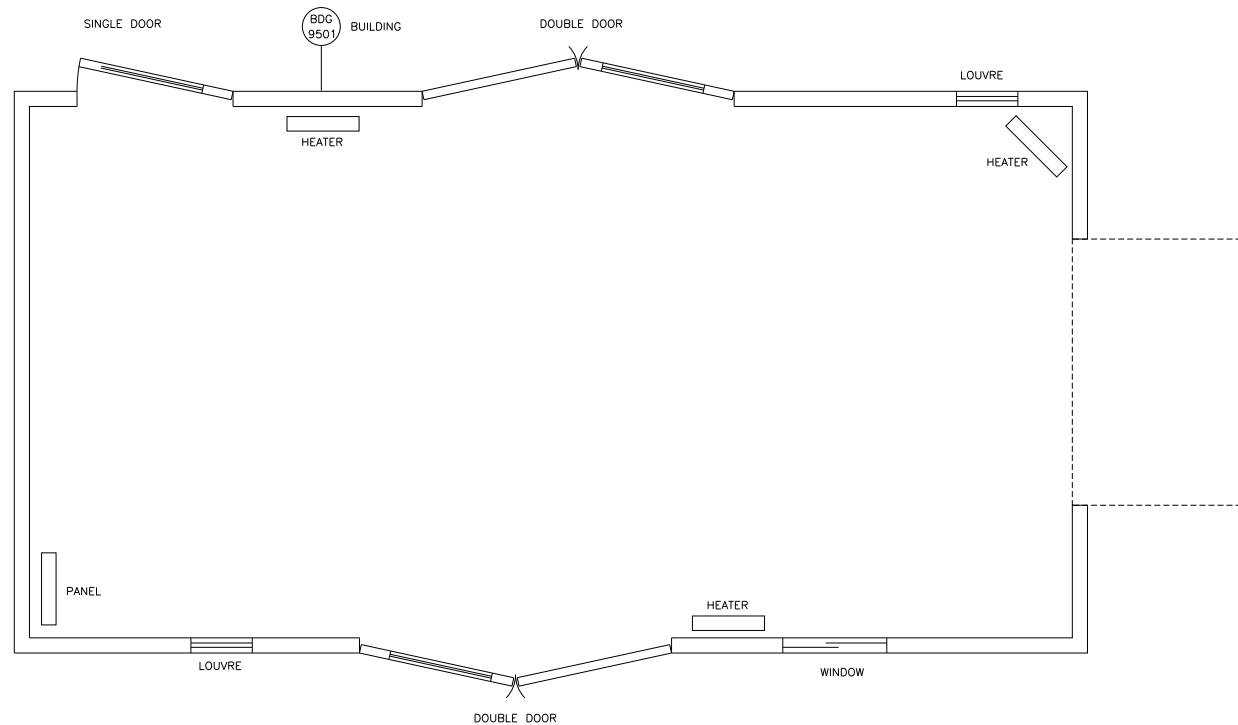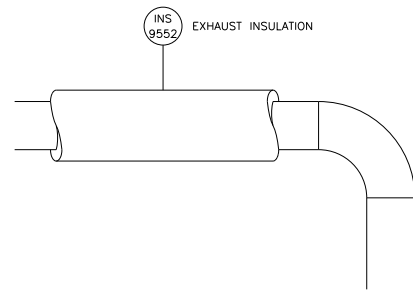

INSERT AT END
OF THIS LINE

HEIGHT = 0.100
SPACING = 0.177

PS
9500,

PULSATION STUDY

BE

OIL
9553

OIL
9595


TB
9554

BILL OF MATERIAL


NOTE: ITEM No. = FIRST TWO DIGITS (Work Center), LAST TWO DIGITS (item No.)

[illegible]

CUSTOMER CONNECTIONS						GENERAL NOTES		STAMP AREA		 UNIVERSAL[®] COMPRESSION 4949 - 76th Avenue S.E. 403/236-5252 Main P.O. Box 5308, Station "A" 800/661-5252 Toll Free Calgary, Alberta, Canada T2H 1X6 403/236-4261 Fax	
TAG	DESCRIPTION	SIZE	TAG	DESCRIPTION	SIZE					TITLE: UTILITIES & INSTRUMENTATION DIAGRAM AJAX DPC-2202, AMERCOOL 72VCI, 2 THROW, 2 STAGE MISCELLANEOUS EQUIPMENT AND ACCESSORIES SCHEMATIC	
						1. SEE DWG.018222-D-10 FOR NOTES.		THIS DOCUMENT IS SUPPLIED IN CONFIDENCE. REPRODUCTION OR DISTRIBUTION IN WHOLE OR PART WITHOUT THE WRITTEN PERMISSION OF UNIVERSAL COMPRESSION INC. IS STRICTLY PROHIBITED.		END USER/CONSULTANT: LEASE FLEET	
						1. UTILITY INSTRUMENT LINES: ELECTROGALVANIZED STEEL TUBING c/w SWAGELOCK CAD PLATED FITTINGS & SS FERRULES.				CUST. P.O. No.: -	
						2. INSTRUMENT MEDIUM: CLEAN, DRY GAS.				REVISION: 0	
						3. ALL PIPING 2" & UNDER TO BE XH MINIMUM.		LOCATION: TBA		DWG. REFERENCE: 998188-D-95 (REV.0)	
						4. ALL FITTINGS TO BE 3000# RATING UNLESS OTHERWISE NOTED.		LSD: TBA			
						5. AREA CLASSIFICATION: TBA.				DRAWN: DGD W.O. No. 018222	
						6. CONDUIT TYPE: TBA.				DATE: 02 FEB 00 UNIT No. -	
						7. INSTRUMENT TAGS REQUIRED: ☐ YES ☐ NO				CHK'D: B.MINSHULL No. REQ'D: ONE(1)	
										DWG. No. 018222-D-95	
										SCALE: N.T.S. (SHEET 1 OF 1)	
0	MD					ISSUED FOR FABRICATION		13 NOV 01			
REV.	BY	CHK'D		REVISION	DESCRIPTION	DATE		PROJ. MGR			

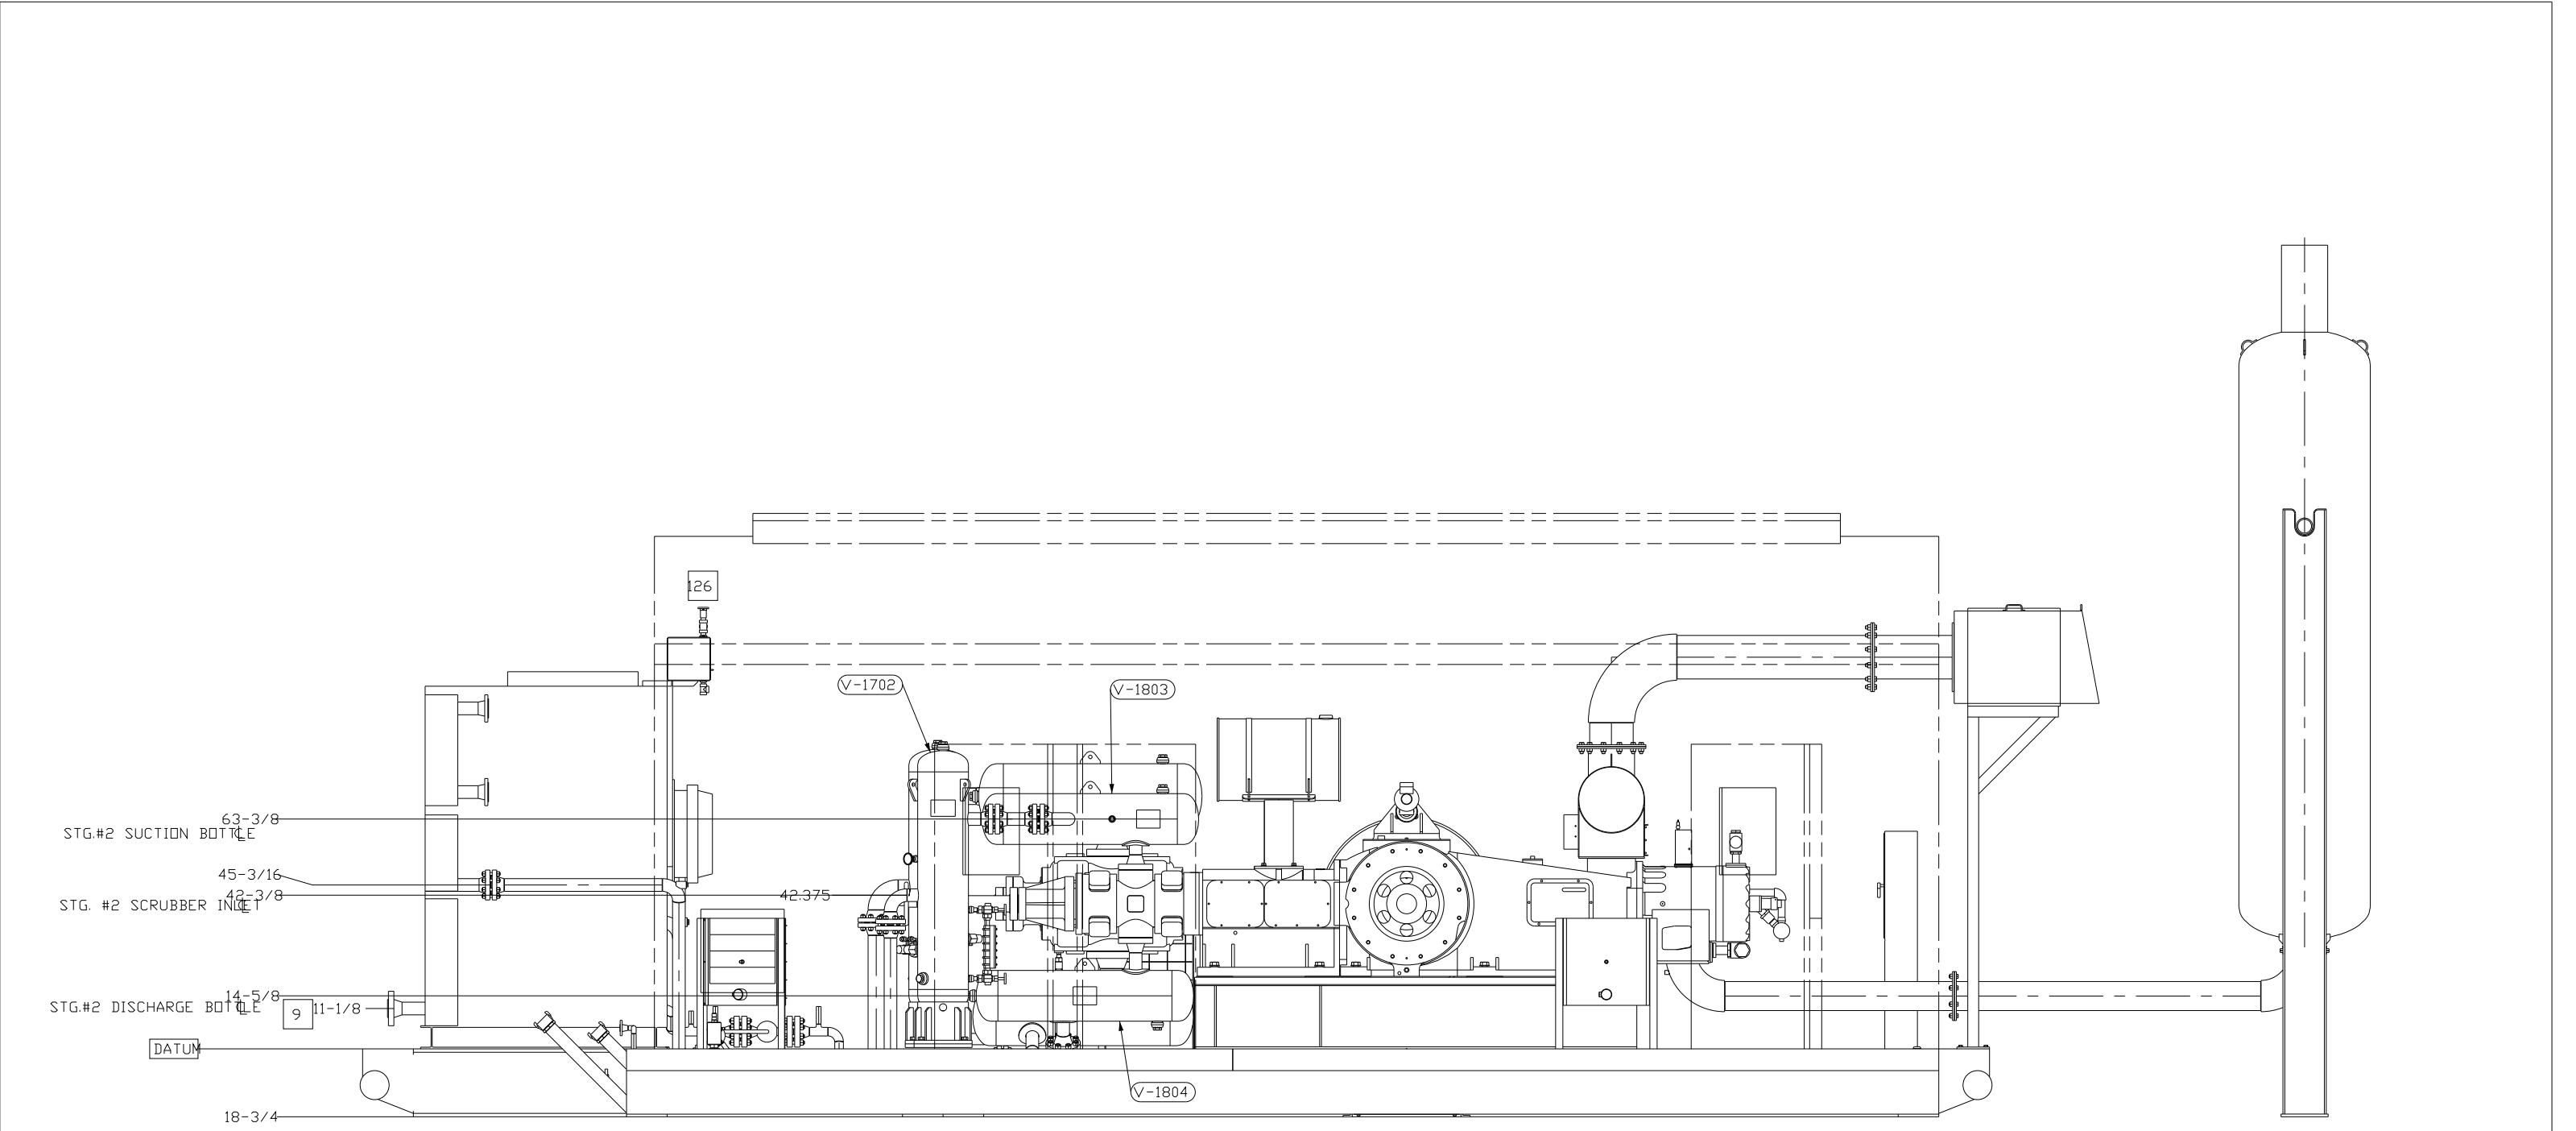

GENERAL NOTES			CUSTOMER CONNECTIONS			CUSTOMER CONNECTIONS			ESTIMATED WEIGHTS			STAMP AREA			
1. IT IS UC'S RECOMMENDATION THAT ANY PRE-SPOOLING TO THIS COMPRESSOR PACKAGE FIELD WELDS AT ALL CUSTOMER CONNECTIONS. 2. ALL PIPING MUST BE SELF SUPPORTING BEYOND THIS COMPRESSOR PACKAGE. 3. ALL DIMENSIONS ARE IN INCHES (UNLESS OTHERWISE SPECIFIED). 4. DIMENSIONS IN "BOLD PRINT" DENOTE REFERENCE DIMENSIONS. 5. DO NOT SCALE THIS DRAWING FOR CONSTRUCTION PURPOSES. 6. PRIMER:.....N/R PAINT: PACKAGE - (1) COAT UC STANDARD HIGH-SOLIDS EPOXY - COLOR:IT TO MATCH GRATING - (2) COATS MACHINE ENAMEL - BLACK 7. DENOTES RECOMMENDED LOCATION OF SUPPORTS REQUIRED TO AID CENTER BOARD SUPPORTS. 8. DENOTES CENTER OF GRAVITY. (TBA)			TAG	DESCRIPTION	SIZE	TAG	DESCRIPTION	SIZE	DESCRIPTION	SHIPPING ARRANGEMENT	WEIGHT (lb)	THIS DOCUMENT IS SUPPLIED IN CONFIDENCE. REPRODUCTION OR DISTRIBUTION IN WHOLE OR IN PART WITHOUT THE WRITTEN PERMISSION OF UNIVERSAL COMPRESSION IS PROHIBITED. END USER/CONSULTANT: CUST. P.D. No. LOCATION: TBA Isd: TBA DRAWN: MD DATE: 14-Nov-01 CHK'D: B.MINSHULL PRJ.LDR: B.MINSHULL W.D. No. UNIT No No REQ'D SCALE: 3/64 018222-D-20 (SHEET 2 OF 4)			
			1	STAGE ONE INLET	4-300# RF	-	-	-	COMPRESSOR	MOUNTED	29000				
			9	FINAL DISCHARGE	3-900# RF				DRIVER	MOUNTED	-				
			10	SCRUBBER DRAIN HEADER	1 NPTF				COOLER	S. LOOSE	12800				
			23	PSV HEADER	3-150# RF				SKID	MOUNTED/S. LOOSE	30000				
			46	FUEL / START GAS SUPPLY	2-150# RF				VESSEL	MOUNTED	5900				
			51	ENGINE AIR INTAKE	12 Ø				EXHAUST SYSTEM	MOUNTED/S. LOOSE	TBA				
			52	ENGINE EXHAUST	8 Ø				MISC.	MOUNTED/S. LOOSE	16300				
			126	JACKET WATER FILL/VENT	2 -7 #PRCAP				CRANE	S. LOOSE	-				
			129	START GAS VENT	4-150# RF				BUILDING	FIELD ERECTED	12000				
			130	CRANCASE VENT	1-1/2 CPLG				TOTAL APPROX. SHIPPING WEIGHT		106600				
131	CONTROL VENT HEADER	1-1/2-150# RF				TOTAL APPROX. WEIGHT OF ALL EQUIPMENT		110300							
132	PACKING VENT DRAIN TANK VENT	2-150# RF				OVERALL DIMENSIONS			ISSUED FOR FABRICATION						
136	ENGINE OIL DAY TANK VENT	2 STACK													
137	ENGINE OIL DAY TANK VENT	2 STACK													
138	PACKING VENT DRAIN TANK PUMP-OUT	3 CAMLOCK													
139	JACKET WATER FILL/DRAIN	3 CAMLOCK				DESCRIPTION	LENGTH FT-IN (mm)	WIDTH FT-IN (mm)	HEIGHT FT-IN (mm)	REV.	BY	CHK'D	ECR No. or	REVISION DESCRIPTION	DATE
						SHIPPING	39'-4"	14'-0"	13'-6"	0	MD				16 NOV 01
						OVERALL	46'-2"	14'-0"	20'-2"						

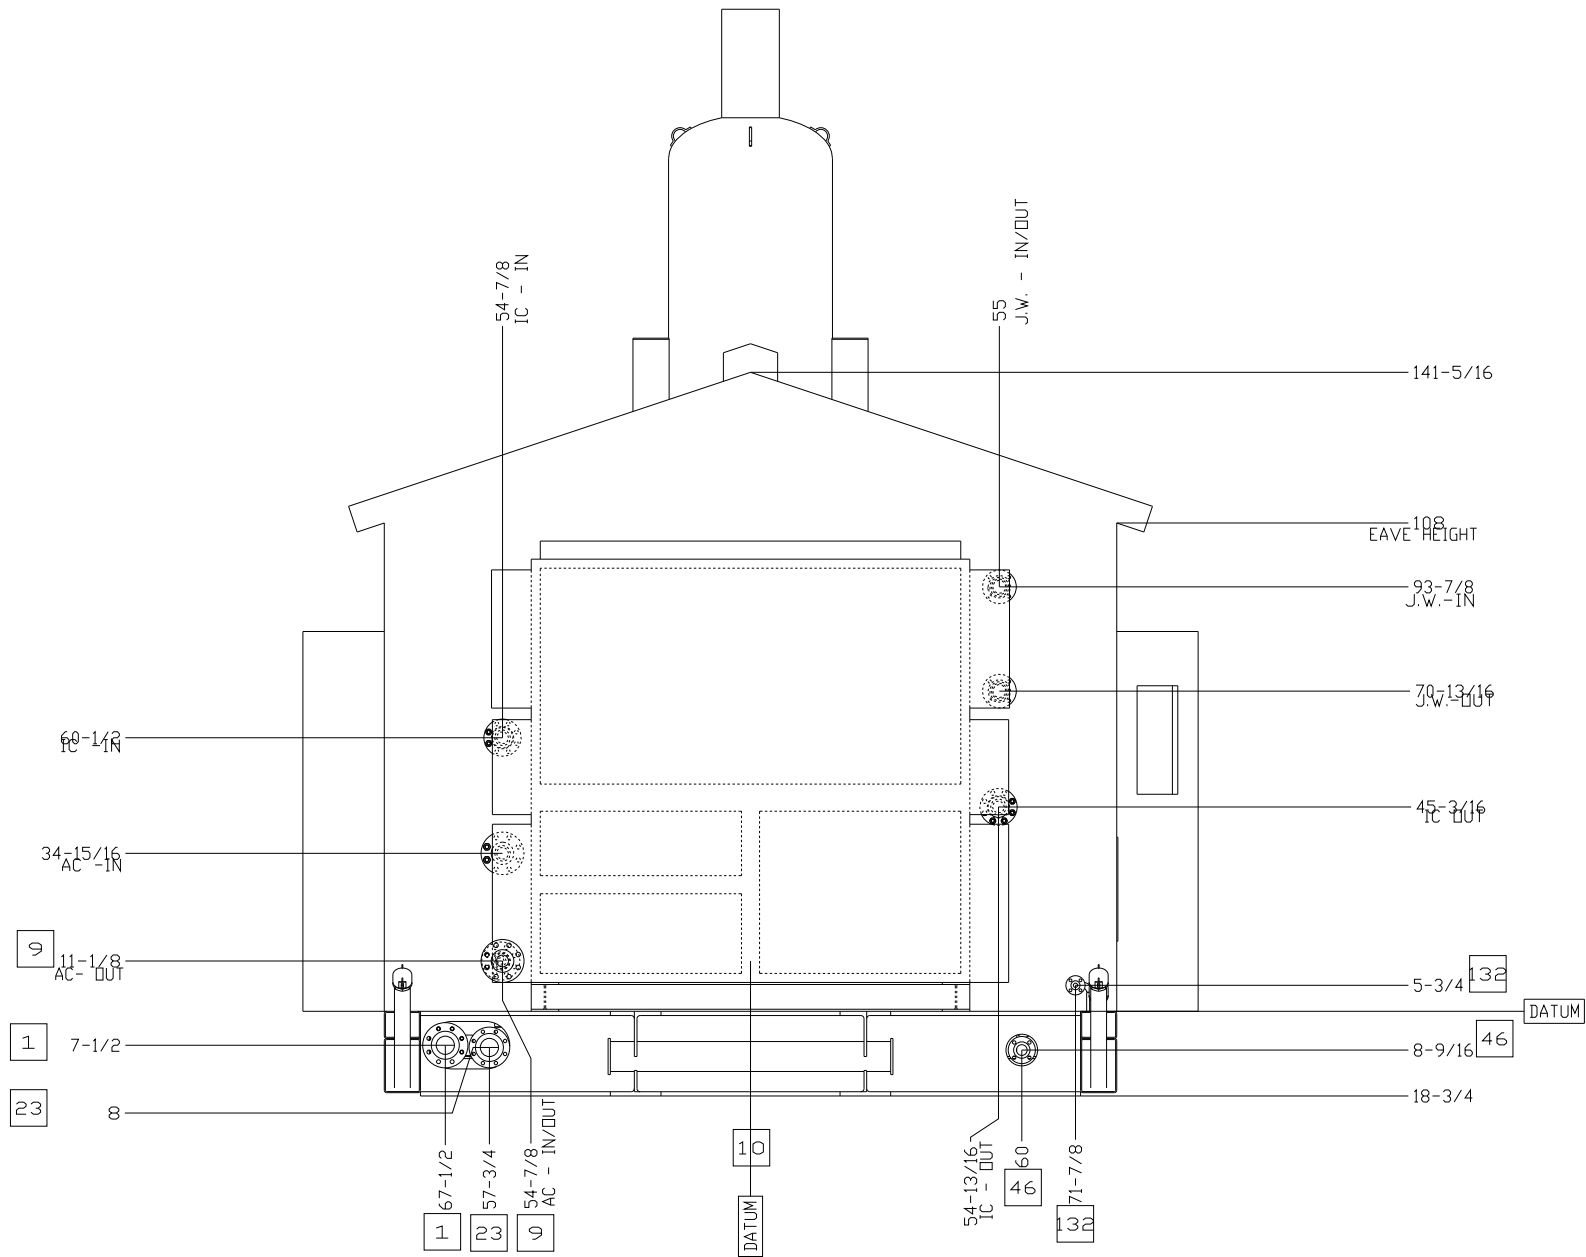

GENERAL NOTES			CUSTOMER CONNECTIONS			CUSTOMER CONNECTIONS			ESTIMATED WEIGHTS			STAMP AREA			UNIVERSAL COMPRESSION		
1. IT IS UC'S RECOMMENDATION THAT ANY PRE-SPOOLING TO THIS COMPRESSOR PACKAGE CONTAIN FIELD WELDS AT ALL CUSTOMER CONNECTIONS. 2. ALL PIPING MUST BE SELF SUPPORTING BEYOND THIS COMPRESSOR PACKAGE. 3. ALL DIMENSIONS ARE IN INCHES (UNLESS OTHERWISE SPECIFIED). 4. DIMENSIONS IN "BOLD PRINT" DENOTE REFERENCE DIMENSIONS. 5. DO NOT SCALE THIS DRAWING FOR CONSTRUCTION PURPOSES. 6. PRIMER:.....N/R PAINT: PACKAGE - (1) COAT UC STANDARD HIGH-SOLIDS EPOXY - COLOUR TO MATCH UNIT GRATING - (2) COATS MACHINE ENAMEL - BLACK 7. DENOTES RECOMMENDED LOCATION OF SUPPORTS REQUIRED TO AID THE OUTBOARD CYLINDER SUPPORTS. 8. DENOTES CENTER OF GRAVITY. (TBA)			TAG	DESCRIPTION	SIZE	TAG	DESCRIPTION	SIZE	DESCRIPTION	SHIPPING ARRANGEMENT	WEIGHT (lb)	THIS DOCUMENT IS SUPPLIED IN CONFIDENCE. REPRODUCTION OR DISTRIBUTION IN WHOLE OR IN PART WITHOUT THE WRITTEN PERMISSION OF UNIVERSAL COMPRESSION IS STRICTLY PROHIBITED. REV. BY CHK'D ISSUED FOR FABRICATION 14 NOV 01 PRJ.L DR. BMINSHULL SCALE: 3/64			UNIVERSAL COMPRESSION 4949 - 76th Avenue S.E. 403/236-5252 Main P.O. Box 5308, Station 'A' 800/661-5252 Toll Free Calgary, Alberta, Canada T2H 1X6 403/236-4261 Fax		
			1	STAGE ONE INLET	4-300# RF	-	-	-	COMPRESSOR	MOUNTED	29000						
			9	FINAL DISCHARGE	3-900# RF				DRIVER	MOUNTED	-						
			10	SCRUBBER DRAIN HEADER	1 NPTF				COOLER	S. LOOSE	12800						
			23	PSV HEADER	3-150# RF				SKID	MOUNTED/S. LOOSE	30000						
			46	FUEL/ START GAS SUPPLY	2-150# RF				VESSEL	MOUNTED	5900						
			51	ENGINE AIR INTAKE	12 Ø				EXHAUST SYSTEM	MOUNTED/S. LOOSE	TBA						
			52	ENGINE EXHAUST	8 Ø				MISC.	MOUNTED/S. LOOSE	16300						
			126	JACKET WATER FILL/VENT	2 -7 #PRCAP				CRANE	S. LOOSE	-						
			129	START GAS VENT	4-150# RF				BUILDING	FIELD ERECTED	12000						
130	CRANKCASE VENT	1-1/2 CPLG				TOTAL APPROX. SHIPPING WEIGHT		106600									
131	CONTROL VENT HEADER	1-1/2-150# RF				TOTAL APPROX. WEIGHT OF ALL EQUIPMENT		110300									
						OVERALL DIMENSIONS						LEASE FLEET TBA 1501 TBA					
												DRAWN: MD DATE: 14-Nov-01 CHK'D: BMINSHULL PRJ.L DR. BMINSHULL UNIT No. 018222 No. REQ'D ONE PER W.O. SCALE: 3/64					




HOLE LOCATION TAG	MAIN MEMBER COPED	MAIN MEMBER	OUTRIGGER	JACKING BOLT/GUSSETS	SLEEVES	JACK & ROLL BRACKET	DECK PLATE	WASTE TANK
HOLE SIZE DISTANCE FROM HORIZONTAL OR VERTICAL DATUM DISTANCE DOWNWARD FROM TOP OF STEEL	1.	2.	3.	4.	5.	6.	7.	8.

GENERAL NOTES

1. CUSTOMER TO ENSURE THAT SITE FOUNDATION OR CONCRETE BASE PROVIDES ADEQUATE SUPPORT FOR ALL MAIN SKID MEMBERS, CYLINDERS AND VESSEL BASES.
2. FOUNDATION AND PILE DESIGN BY CUSTOMER.
3. WELDING SHALL BE FLUX CORE WPS 107, 3/16" FILLET WELD MIN. UND.
4. ALL PROJECTED CORNERS SHALL BE ROUNDED.
5. ALL MEMBERS SHALL BE FLUSH ON TOP UNLESS INDICATED OTHERWISE.
6. DRIP LIP SHALL BE INSTALLED AROUND COMPRESSOR AREA.
7. WELD DETAIL 1 IS ONLY TO BE USED WHERE INDICATED ON DRAWING.
8. SANDBLAST PRIOR TO PRIMING.
9. PRIME (1) COAT ZINC CHROMATE (SHOP PRIMER).
10. SKID TO ENSURE GRATING IS SUPPORTED AT MAXIMUM OF EVERY FOUR FEET.
11. SKID TO BE LEVEL BEFORE ASSEMBLY.
12. TANK VENTS TO GO THROUGH CRANE LEGS, SEE CRANE DRAWING.
13. GAUGE PLATE TO BE USED UNDER SKID AS SEAL PAN, SLOPED AS SHOWN.
14. INSPECTION "HOLD POINTS":
 - 1) AFTER FIT-UP, PRIOR TO WELDING.
 - 2) AFTER WELDING AND CLEANING, PRIOR TO CONCRETE PLACEMENT.
 - 3) FINAL, PRIOR TO SETTING OF MAJOR EQUIPMENT OR ENTERING INTO STOCK.
15. ESTIMATED WEIGHT: 32890 LBS

2	DGD		ADDED CROSS OVER PIPE AND TANK VENTS	25 APR 00
1	RR	GK	ADD SLEEPERS, MODIFY PANEL SUPPORT	23 FEB 00
0	RR	GK	ISSUED FOR FABRICATION	23 NOV 99
REV.	BY	CHK'D	ECR No. or REVISION DESCRIPTION	DATE

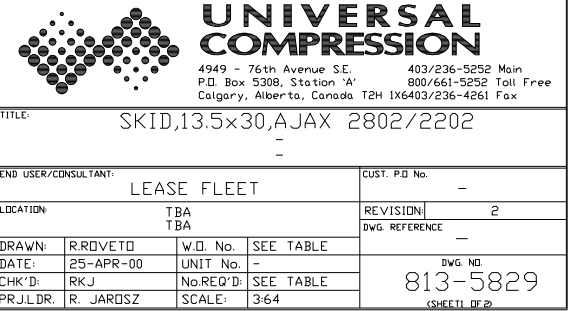



HOLE LOCATION TAG	MAIN MEMBER COPED	MAIN MEMBER	OUTRIGGER	JACKING BOLT/GUSSETS	SLEEVES	JACK & ROLL BRACKET	DECK PLATE	WASTE TANK
HOLE SIZE DISTANCE FROM HORIZONTAL OR VERTICAL DATUM DISTANCE DOWNWARD FROM TOP OF STEEL	1.	2.	3.	4.	5.	6.	7.	8.

GENERAL NOTES

1. ALL DIMENSIONS ARE IN INCHES (UNLESS OTHERWISE SPECIFIED).
2. CUSTOMER TO ENSURE THAT SITE FOUNDATION OR CONCRETE BASE PROVIDES ADEQUATE SUPPORT FOR ALL MAIN CYLINDERS, MEMBERS, CYLINDERS AND VESSEL BASES.
3. FOUNDATION AND PILE DESIGN BY CUSTOMER.
4. WELDING SHALL BE FLUX CORE WPS 107, 3/16" FILLET WELD MIN. UND.
5. ALL PROJECTED CORNERS SHALL BE ROUNDED.
6. ALL MEMBERS SHALL BE FLUSH ON TOP UNLESS OTHERWISE SPECIFIED.
7. WELD DETAIL 1 IS ONLY TO BE USED WHERE INDICATED ON DRAWING.
8. SANDBLAST PRIOR TO PAINTING.
9. PRIME.....N/R
10. PAINT.....(1) COAT AMERLOCK 400 HIGH EPOXY (TO MATCH UNIT)
11. SHOP TO ENSURE GRATING IS SUPPORTED AT MAXIMUM OF EVERY FOUR FEET.
12. SKID TO BE LEVEL BEFORE ASSEMBLY.
13. GAUGE PLATE TO BE USED UNDER SKID AS SEAL PAN, SLOPED AS SHOWN
13. INSPECTION 'HOLD POINTS':
 - 1) AFTER FIT-UP, PRIOR TO WELDING.
 - 2) AFTER WELDING AND CLEANING, PRIOR TO CONCRETE PLACEMENT.
 - 3) FINAL, PRIOR TO SETTING OF MAJOR EQUIPMENT OR ENTERING INTO STOCK.

THIS DOCUMENT IS SUPPLIED IN CONFIDENCE. REPRODUCTION OR DISTRIBUTION IN WHOLE OR IN PART WITHOUT THE WRITTEN PERMISSION OF UNIVERSAL CORPORATION IS PROHIBITED.

REV.	BY	CHK'D	ECR No. or REVISION DESCRIPTION	DATE
------	----	-------	---------------------------------	------



UNIVERSAL COMPRESSION

4949 - 76th Avenue S.E. 403/236-5252 Main
P.O. Box 5308, Station 'A' 800/661-5252 Toll Free
Calgary, Alberta, Canada T2H 1X6 403/236-4261 Fax

TITLE:	SKID,13.5x30,AJAX 2802/2202
--------	-----------------------------

END USER/CONSULTANT:

CUST. P.D. No.

LOCATION

TRA

REVISION:	3
-----------	---

DRAWN:	R. ROVE
--------	---------

W.D. No.	SEE TABLE
----------	-----------

[illegible]

DATE:	25-APR
-------	--------

UNIT No.	-
----------	---


	DWG. NO.
--	----------

CHK'D:	RKJ
--------	-----

	No.REQ'D:	S
--	-----------	---

813-5829

DWG. NO.
813-5829

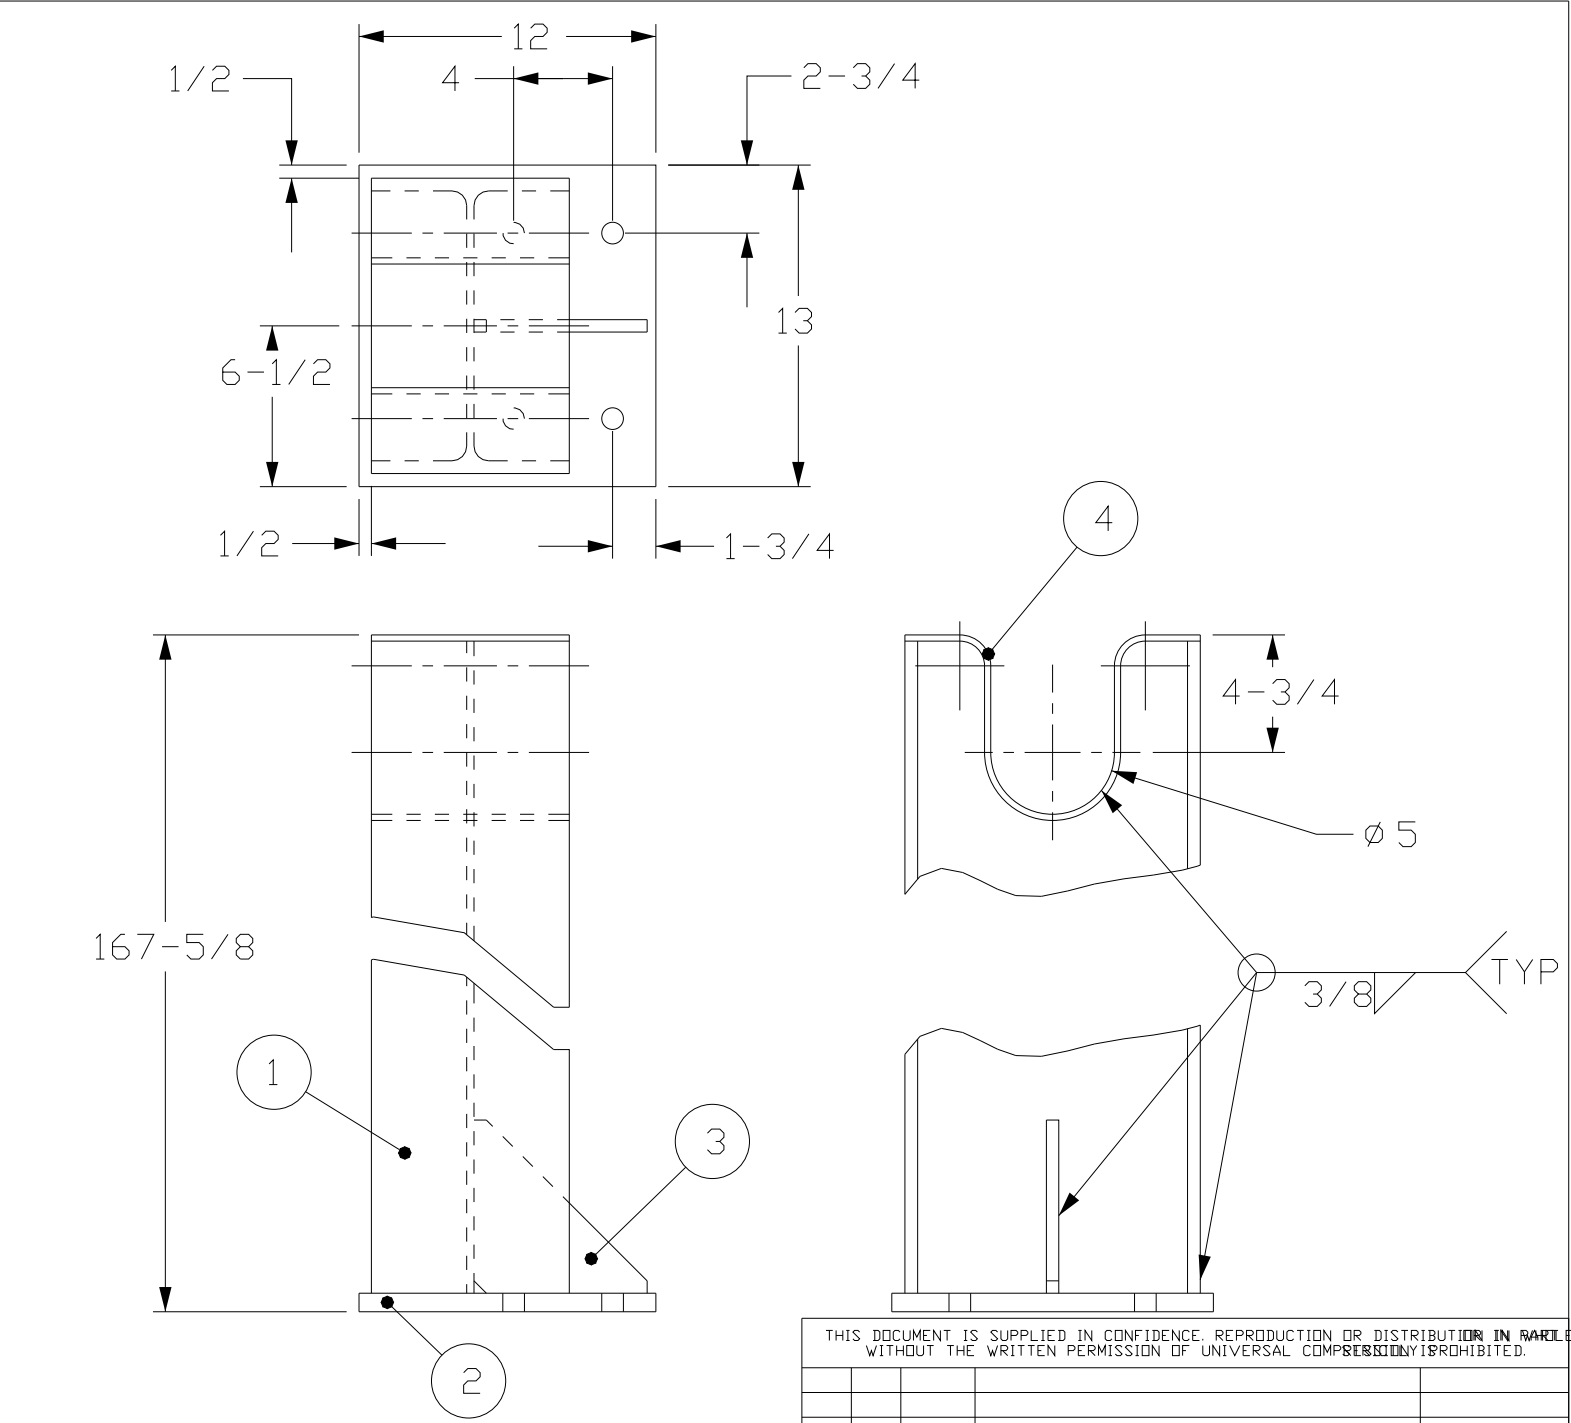

W.O. DESIGNATION TABLE			
W.O.#	REV.	SERIAL #	QTY
9989239	0	-	2
9989250	0	-	2
9989258	0	-	2
018222	0	-	2
018343	0	-	2
028066	0	-	2

BILL OF MATERIAL					
NOTE: ITEM No. = FIRST TWO DIGITS (WORK CENTER), LAST TWO DIGITS (ITEM No.)					
ITEM	PART No.	QTY	STOCK REQ	DESCRIPTION	REV
5501	801-2303	1	166.605	WIDE FLANGE,12x40	
5502	601-1402	1	12.00 x 13.00	PLATE,3/4,MILD STEEL	
5503	600-7962	1	7.00 x 7.00	PLATE,1/2,MILD STEEL	
5504	801-0368	1	8.00 x 23.23	PLATE,1/4,MILD STEEL	

THIS DOCUMENT IS SUPPLIED IN CONFIDENCE. REPRODUCTION OR DISTRIBUTION IN WHOLE OR IN PART WITHOUT THE WRITTEN PERMISSION OF UNIVERSAL COMPRESSION IS PROHIBITED.

0	DGD		ISSUED FOR CONSTRUCTION		30 MAR 00
REV.	BY	CHK'D	ECR No. or REVISION DESCRIPTION		DATE



**UNIVERSAL
COMPRESSION**
4949 - 76th Avenue S.E. 403/236-5252 Main
P.O. Box 5308, Station 'A' 800/661-5252 Toll Free
Calgary, Alberta, Canada T2H 1X6403/236-4261 Fax

TITLE: SUPPORT,SILENCER
AJAX DPC 2202,AMERCOOL 72VCI
NATURAL GAS COMPRESSION PACKAGE

END USER/CONSULTANT: LEASE FLEET				CUST. P.O. No. cust_po	
Location: TBA Issd: TBA				REV.	0
				DWG. REFERENCE: -	
DRAWN:	DGD	W.O. No.	SEE TABLE	813-6177 (SHEET 1 OF 1)	
DATE:	30-MAR-00	UNIT No.	-		
CHK'D:		No.REQ'D:	SEE TABLE		
PRJ.LDR.	B.MINSHULL	SCALE:	1:8		