

V-110
SUCTION SCRUBBER

Manufacturer: IPS MANUFACTURING LTD.
Size: 24" x 72" S/S
Rated: 285psi @ 100°F
1/8" CA

V-140
INLET GAS FILTER

Manufacturer: ENERFLEX - STETTLER
Type: COALESCING
Rated: 200psi @ 100°F
1/8" CA

H-410
NATURAL GAS HEATER


Manufacturer: CIS-CAN
Size: 24" x 24"
16,000 btu/hr
12 Volt Start
Protection Grill

H-420
NATURAL GAS HEATER

Manufacturer: CIS-CAN
Size: 24" x 24"
16,000 btu/hr
12 Volt Start
Protection Grill

MATERIAL LIST

ITEM	DESCRIPTION	MAKE	MODEL
PSV-1101	PRESSURE SAFETY VALVE, 1"x1" NPT, SET @150 psi	MERCER	E ORIFICE
HS-1101	EMERGENCY SHUTDOWN HAND SWITCH	TELEMECANIQUE	#XAL B174H29H7
LSHH-1101	LEVEL SHUTDOWN HIGH	MURPHY	L1200
UY-1101	PRESSURE SWITCH, TYPE CP	AMOT	4057D025H2
PC-1101	PRESSURE CONTROLLER, SPRING RANGE SET @ 0-100 psi	FISHER	4150KR
PCV-1101	PRESSURE CONTROL VALVE - FC, 2" 300# VEE-BALL	FISHER	1052-V200
LG-1101	LEVEL GAUGE	PENBERTHY	1RM-7STLNE
PI-1101	PRESSURE INDICATOR 1/2"BTM x 4"FACE, 0-400psi/0-2800kPa	WIKA	SSLF
PI-1102	PRESSURE INDICATOR 1/4"LBM x 4"FACE,-30"HG-100psi/-100-700kPa	WIKA	SSLF
PISLL-3103	PRESSURE INDICATING SWITCHGAGE, 0-150psi/0-1000kPa, SET @ 30psi FALLING	MURPHY	A25PEF-150
DPI-1401	DIFFERENTIAL PRESSURE INDICATOR, 0-50psi	MID-WEST	120AA-00-00 (CA)
PCV-4101	PRESSURE CONTROL VALVE, SET @ 1/2 psi	FISHER	912
PCV-4201	PRESSURE CONTROL VALVE, SET @ 1/2 psi	FISHER	912
PCV-4102	PRESSURE CONTROL VALVE	MAXITROL	ES404
PCV-4202	PRESSURE CONTROL VALVE	MAXITROL	ES404
TSDV-4101	TEMPERATURE SHUTDOWN VALVE, c/w HEATER	BASO	H17CB-5
TSDV-4201	TEMPERATURE SHUTDOWN VALVE, c/w HEATER	BASO	H17CB-5
PSHH-1101	PRESSURE SWITCH HIGH, SET @ 50psi Inc.	CCS	6900GZE16
AIT-1101	LEL REDUCED POWER GAS DETECTION	NET SAFETY	MLP-LP-ARS-SC1100
UY-1102	PRESSURE SWITCH, TYPE: CP	AMOT	4057D025H2
FD-1102	FIRE DETECTION CONTROLLER, 15 psi FALLING	CCS	6900GZE12
TSE-1102	TEMPERATURE SAFETY ELEMENT, GREEN, SET @ 255°F(124°C)	SWAGELOK	SS-6-FTA-255
TSE-1103	TEMPERATURE SAFETY ELEMENT, GREEN, SET @ 255°F(124°C)	SWAGELOK	SS-6-FTA-255
TSE-1104	TEMPERATURE SAFETY ELEMENT, RED, SET @ 281°F(138°C)	SWAGELOK	SS-6-FTA-281
RO-1102	RESTRICTION ORIFICE, 0.014"	AMOT	2185L-011

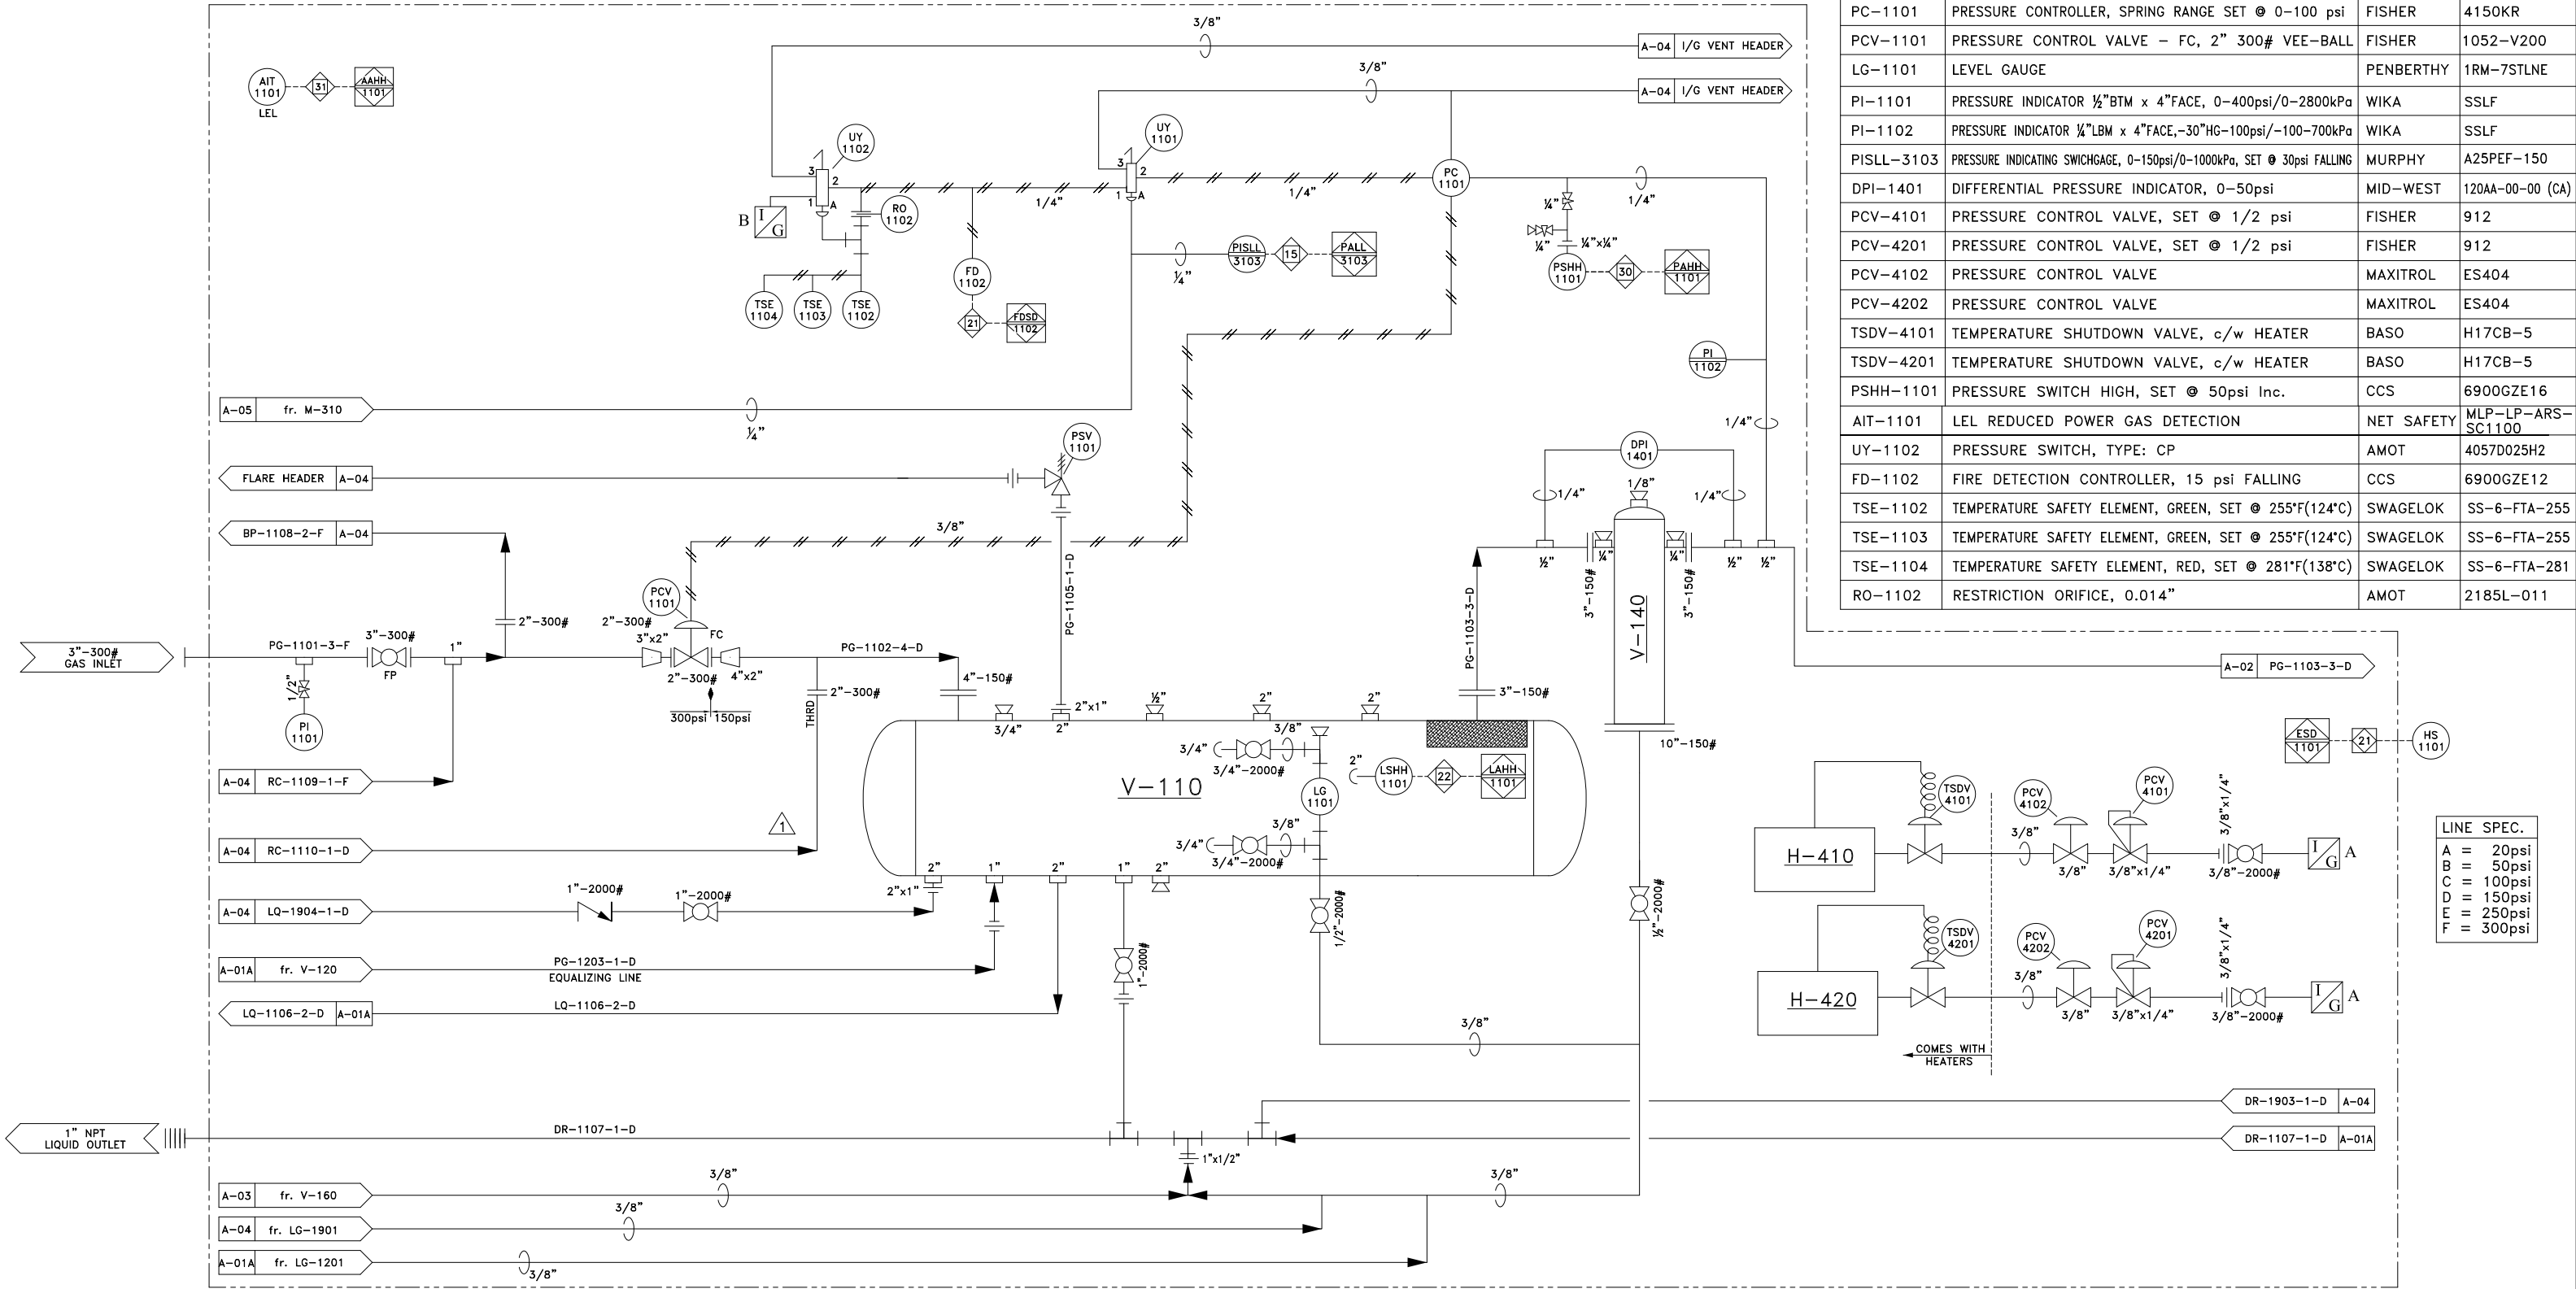

LINE TYPE	LEGEND	PROCESS TUBING/ INSTRUMENT SUPPLY
————	MAIN PROCESS GAS	———— PNEUMATIC SIGNAL
————	SECONDARY PROCESS	———— HYDRAULIC SIGNAL
————	UTILITY PROCESS	----- ELECTRIC SIGNAL

2	AS BUILT	KMW	06-06-28	CAD	ENG
1	REVISED FOR SC-1619-C1	KMW	06-06-21	WST	SE
0	ISSUED FOR CONSTRUCTION	KMW	06-05-03	WST	SE
REV.	DESCRIPTION	BY	DATE	CHKD	APPD

Jiro
ENERFLEX

5221-46th St. Stettler Alberta Phone: 403.742.5538
Box 1450, T0C 2L2 Fax: 403.742.5539


3500 SERIES COMPRESSOR
G.D. SSH w/ 3304 NA ENGINE
TRAILER MOUNTED, SOUR SERVICE

COMPANY:		ENCANA		JOB NO.:	
				35396	
Drawn by:	Checked by:	Approved by:	DATE:	SCALE:	DRAWING NO.:
SLS			05-06-29	N.T.S.	CDL-35396-A-01
					REV.: 2

V-120
BLOWCASE

Manufacturer: ENERFLEX-STETTLER
Size: 12" x 60" S/S
Rated: 375psi @ 250°F
1/8" CA

Cycles: 0-350psi DIFFERENTIAL (ONE MILLION CYCLES)

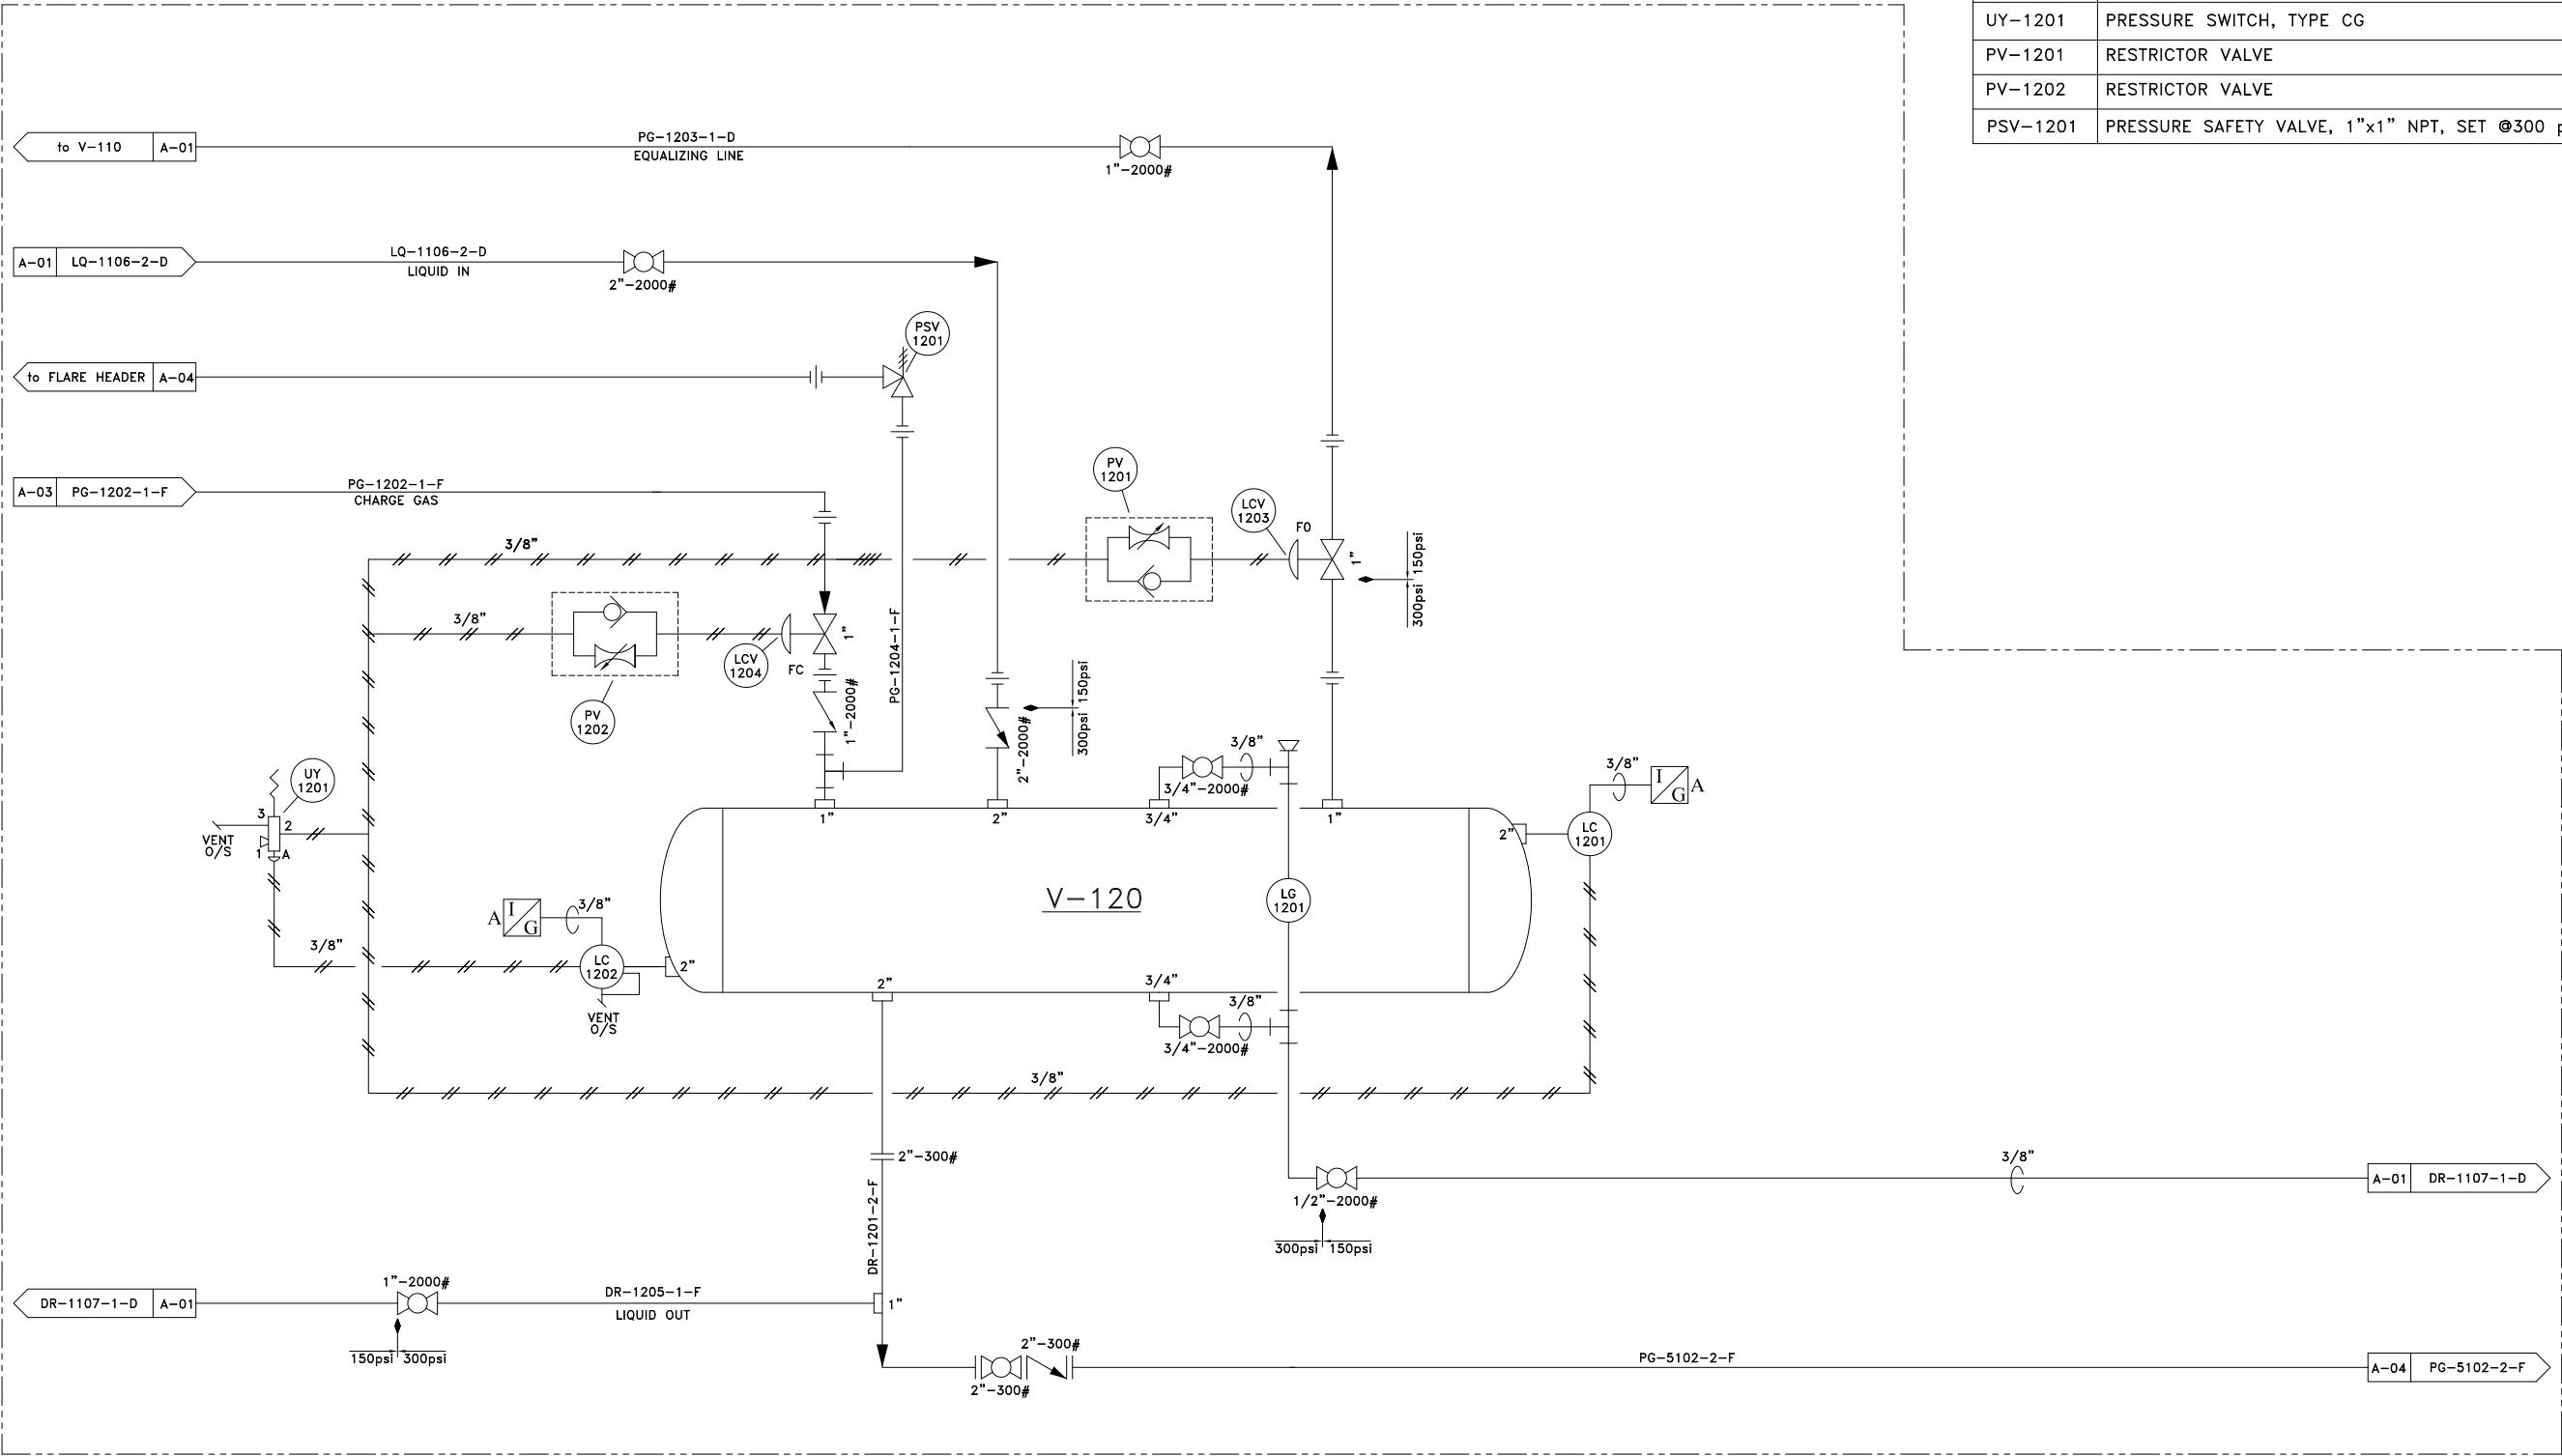

MATERIAL LIST

ITEM	DESCRIPTION	MAKE	MODEL
LC-1201	LEVEL CONTROLLER	MURPHY	L1200N
LC-1202	LEVEL CONTROLLER	MURPHY	L1200NDVO
LCV-1203	LEVEL CONTROL VALVE, 1" NPT, 1/2" PORT F.O.	NORRISEAL	SN40DTV-9BA2
LCV-1204	LEVEL CONTROL VALVE, 1" NPT, 1/2" PORT F.C.	NORRISEAL	SN40RTV-9BA4
LG-1201	LEVEL GAUGE	PENBERTHY	1RM7-STLNE
UY-1201	PRESSURE SWITCH, TYPE CG	AMOT	4057D031H1
PV-1201	RESTRICTOR VALVE	SMC	NAS4000
PV-1202	RESTRICTOR VALVE	SMC	NAS4000
PSV-1201	PRESSURE SAFETY VALVE, 1"x1" NPT, SET @300 psi	MERCER	E ORIFICE

LINE TYPE	LEGEND
	PROCESS TUBING/ INSTRUMENT SUPPLY
	MAIN PROCESS GAS
	SECONDARY PROCESS
	UTILITY PROCESS
	PNEUMATIC SIGNAL
	HYDRAULIC SIGNAL
	ELECTRIC SIGNAL

2	AS BUILT	KMW	06-06-28	CAD	ENG
1	REVISED FOR SC-1619-C1	KMW	06-06-21	WST	SE
0	ISSUED FOR CONSTRUCTION	KMW	06-05-03	WST	SE
REV.	DESCRIPTION	BY	DATE	CHKD	APPD



5221-46th St. Stettler Alberta Phone: 403.742.5538
Box 1450, T0C 2L2 Fax: 403.742.5539

3500 SERIES COMPRESSOR
G.D. SSH w/ 3304 NA ENGINE
TRAILER MOUNTED, SOUR SERVICE

COMPANY:				JOB NO.:			
ENCANA				35396			
Drawn by:	Checked by:	Approved by:	DATE:	SCALE:	DRAWING NO.:	REV.:	
SLS			05-06-29	N.T.S.	CDL-35396-A-01A	2	

S-210
SCREW COMPRESSOR
Manufacturer: GARDNER DENVER
Model: SSHG99D
BELL HOUSING MOUNTED
Max. of 50psi Suction
Max. of 300psi Discharge
Fixed VI (3)


P-610
LUBE OIL PUMP
C/W GARDNER DENVER SSH SCREW

F-810A/B
OIL FILTERS
Manufacturer: DONALDSON
Model: HMK25
MAWP: 350psig @ 250°F
Part: P169984
Filter: P165569

F-820
CONICAL STRAINER
Manufacturer: ALBERTA STRAINER
Model: 3"-600#
Type: STAINLESS STEEL
40/40 MESH
150% OPEN AREA

MATERIAL LIST

ITEM	DESCRIPTION	MAKE	MODEL
TCV-2101	THERMOSTATIC CONTROL VALVE, 340psi, SET @ 180°F	AMOT	1½BHCT18001
DPSLL-2101	DIFFERENTIAL PRESSURE SWITCH, SET @ 25psi FALLING	CCS	604DJ2
DPISHH-2101	DIFFERENTIAL PRESSURE INDICATOR, 0-30psid, SET @ 15 psig Inc.	MIDWEST	120-AA-00-0(CA)
PSLL-2101	PRESSURE SWITCH LOW, SET @ 1psi Dec.	SOR	56AG-EF316 M4-C1A-NC
PSHH-2101	PRESSURE SWITCH HIGH, SET @ 285psi Inc.	CCS	6900GZE18
PI-2104	PRESSURE INDICATOR ¼" LBM x 4"FACE, 0-400psi/0-2800kPa	WIKA	SSLF
TI-2101	TEMPERATURE INDICATOR, 3" FACE, -40 TO 160°F	TREND	2½" STEM
TE-2101	TEMPERATURE ELEMENT COMES WITH 4' PYROLEAD	WIKA	6" STEM
TE-2102	TEMPERATURE ELEMENT COMES WITH 4' PYROLEAD	WIKA	6" STEM
MC-2101	MECHANICAL COUPLER, RATED @ 15,931 in.lb.torque	ARCUSAFLEX	ACT26NNF2115251
HV-2101	HYDRAULIC VALVE	CROSS	BA12AD5AEO

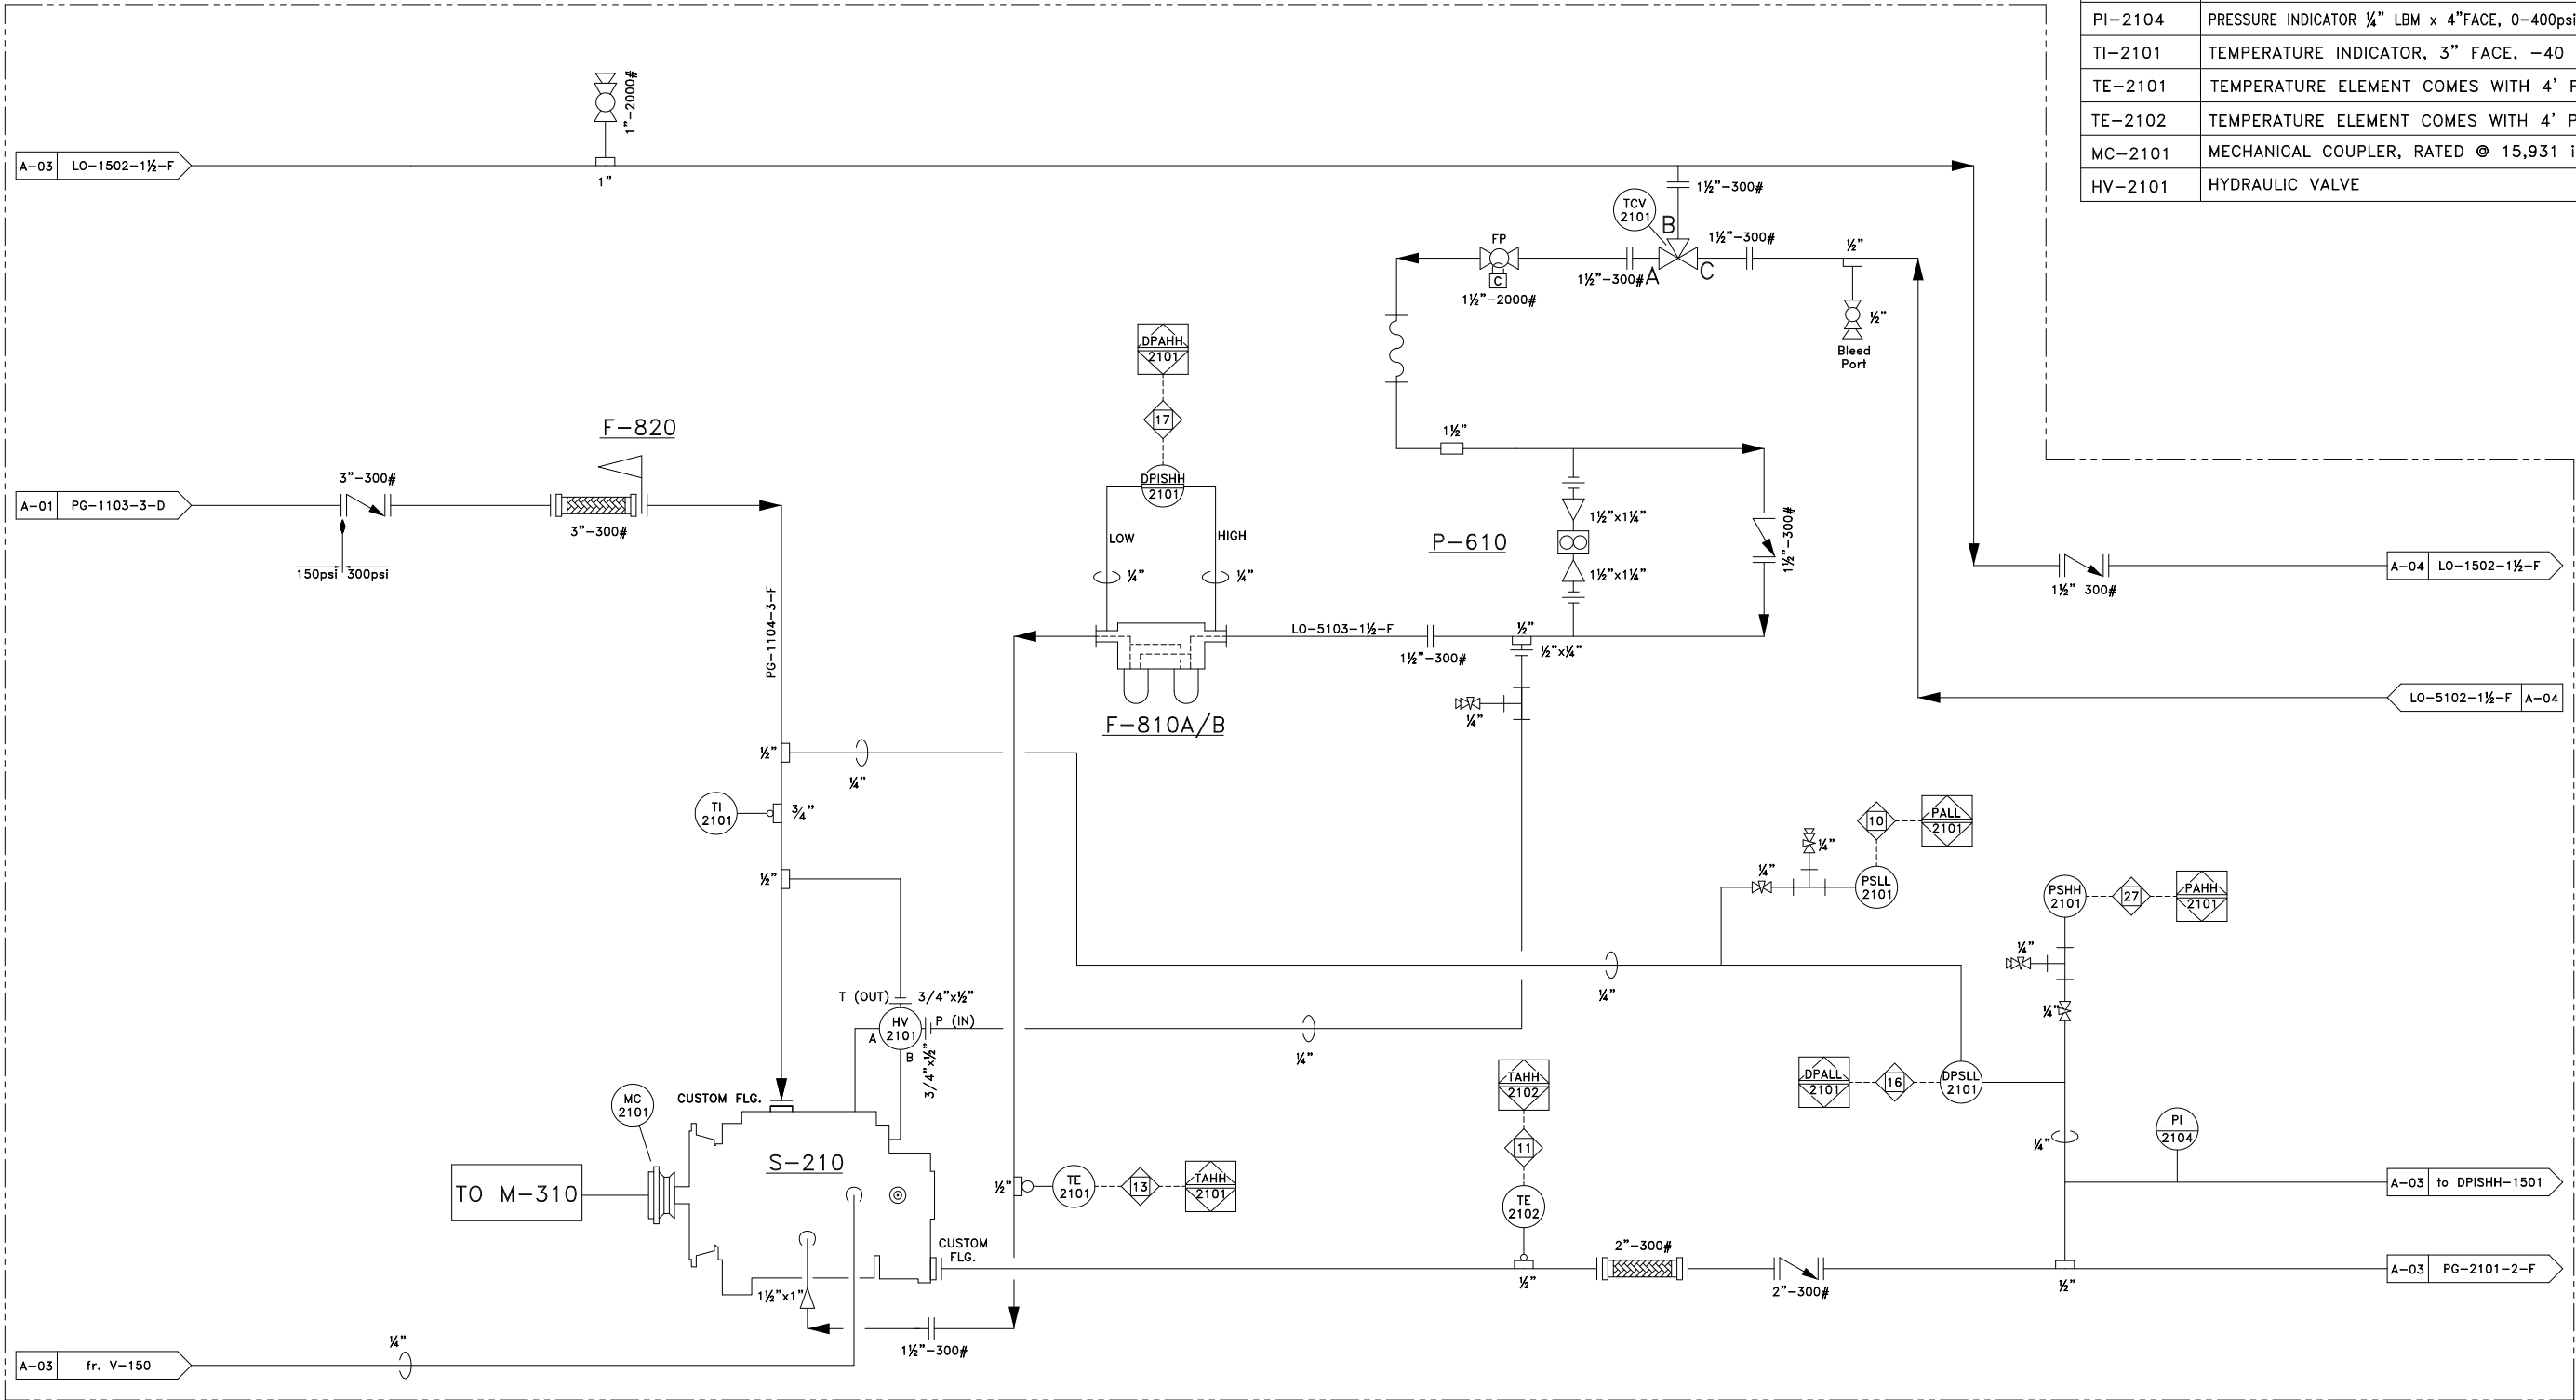

LINE TYPE	LEGEND
	PROCESS TUBING/ INSTRUMENT SUPPLY
	MAIN PROCESS GAS
	SECONDARY PROCESS
	UTILITY PROCESS
	PNEUMATIC SIGNAL
	HYDRAULIC SIGNAL
	ELECTRIC SIGNAL

2	AS BUILT	KMW	06-06-28	CAD	ENG
1	REVISED FOR SC-1619-C1	KMW	06-06-21	WST	SE
0	ISSUED FOR CONSTRUCTION	KMW	06-05-03	WST	SE
REV.	DESCRIPTION	BY	DATE	CHKD	APPD



5221-46th St. Stettler Alberta Box 1450, T0C 2L2
Phone: 403.742.5538 Fax: 403.742.5539

3500 SERIES COMPRESSOR
G.D. SSH w/ 3304 NA ENGINE
TRAILER MOUNTED, SOUR SERVICE

COMPANY: ENCANA				JOB NO.: 35396	
Drawn by: SLS	Checked by:	Approved by:	DATE: 05-06-29	SCALE: N.T.S.	DRAWING NO.: CDL-35396-A-02
					REV.: 2

V-150
OIL COALESCING SEPARATOR

Manufacturer: PENFABCO LTD.
Size: 20" x 50" S/S
Rated: 350psi @ 250°F
1/8" CA
4-12" FILTER ELEMENTS

V-160
FUEL GAS SCRUBBER


Manufacturer: ENERFLEX-STETTLER
Size: 4" x 36" S/S
Rated: 500psi @ 350°F
1/8" CA

F-830
FUEL GAS FILTER

Manufacturer: SPX AIR TREATMENT
Part: 3154826
Element: 3154827
Rated: 250psig @ 150°F

MATERIAL LIST

ITEM	DESCRIPTION	MAKE	MODEL
PSV-1501	PRESSURE SAFETY VALVE, 1"x1", SET @ 300psi	MERCER	E ORIFICE
PSV-1601	PRESSURE SAFETY VALVE, 1"x1" NPT, SET @ 100 psi	MERCER	E ORIFICE
PCV-1601	PRESSURE CONTROL VALVE, SPRING RANGE 70-150psi, 3/16" PORT	FISHER	627-488
PCV-1602	PRESSURE CONTROL VALVE, SPRING RANGE 0-35psi	FISHER	67CFR-362/TB
PCV-1603	PRESSURE CONTROL VALVE, SPRING RANGE 0-35psi	FISHER	67CFR-362/TB
PI-1601	PRESSURE INDICATOR ¼"BTMx2½"FACE, 0-200 psi/0-1400 KPA	WIKA	SSLF
PI-1602	PRESSURE INDICATOR ¼"BTMx2½"FACE, 0-60 psi/0-420 KPA	WIKA	SSLF
PI-1603	PRESSURE INDICATOR ¼"BTMx2½"FACE, 0-60 psi/0-420 KPA	WIKA	SSLF
DPISHH-1501	DIFFERENTIAL PRESSURE INDICATOR, 0-30psid, SET @ 20psi RISING	MID-WEST	120-AA-00-0(CA)
LG-1501	LEVEL GAUGE, c/w 330J VALVES	PENBERTHY	1RM-6STLNE
LSLL-1501	LEVEL SHUTDOWN LOW	MURPHY	L1200
FG-1501	FLOW SIGHT GLASS, 1/2" NPT	AC&R	SG-04
FG-1502	FLOW SIGHT GLASS, 1/2" NPT	AC&R	SG-04
FE-1601	FUEL GAS METER	ROOTS	8C175
LCV-1601	AUTO DUMP VALVE	WATSON MCDANIEL	WLD-1800
LCV-1602	AUTO DUMP VALVE	WATSON MCDANIEL	WLD-1800

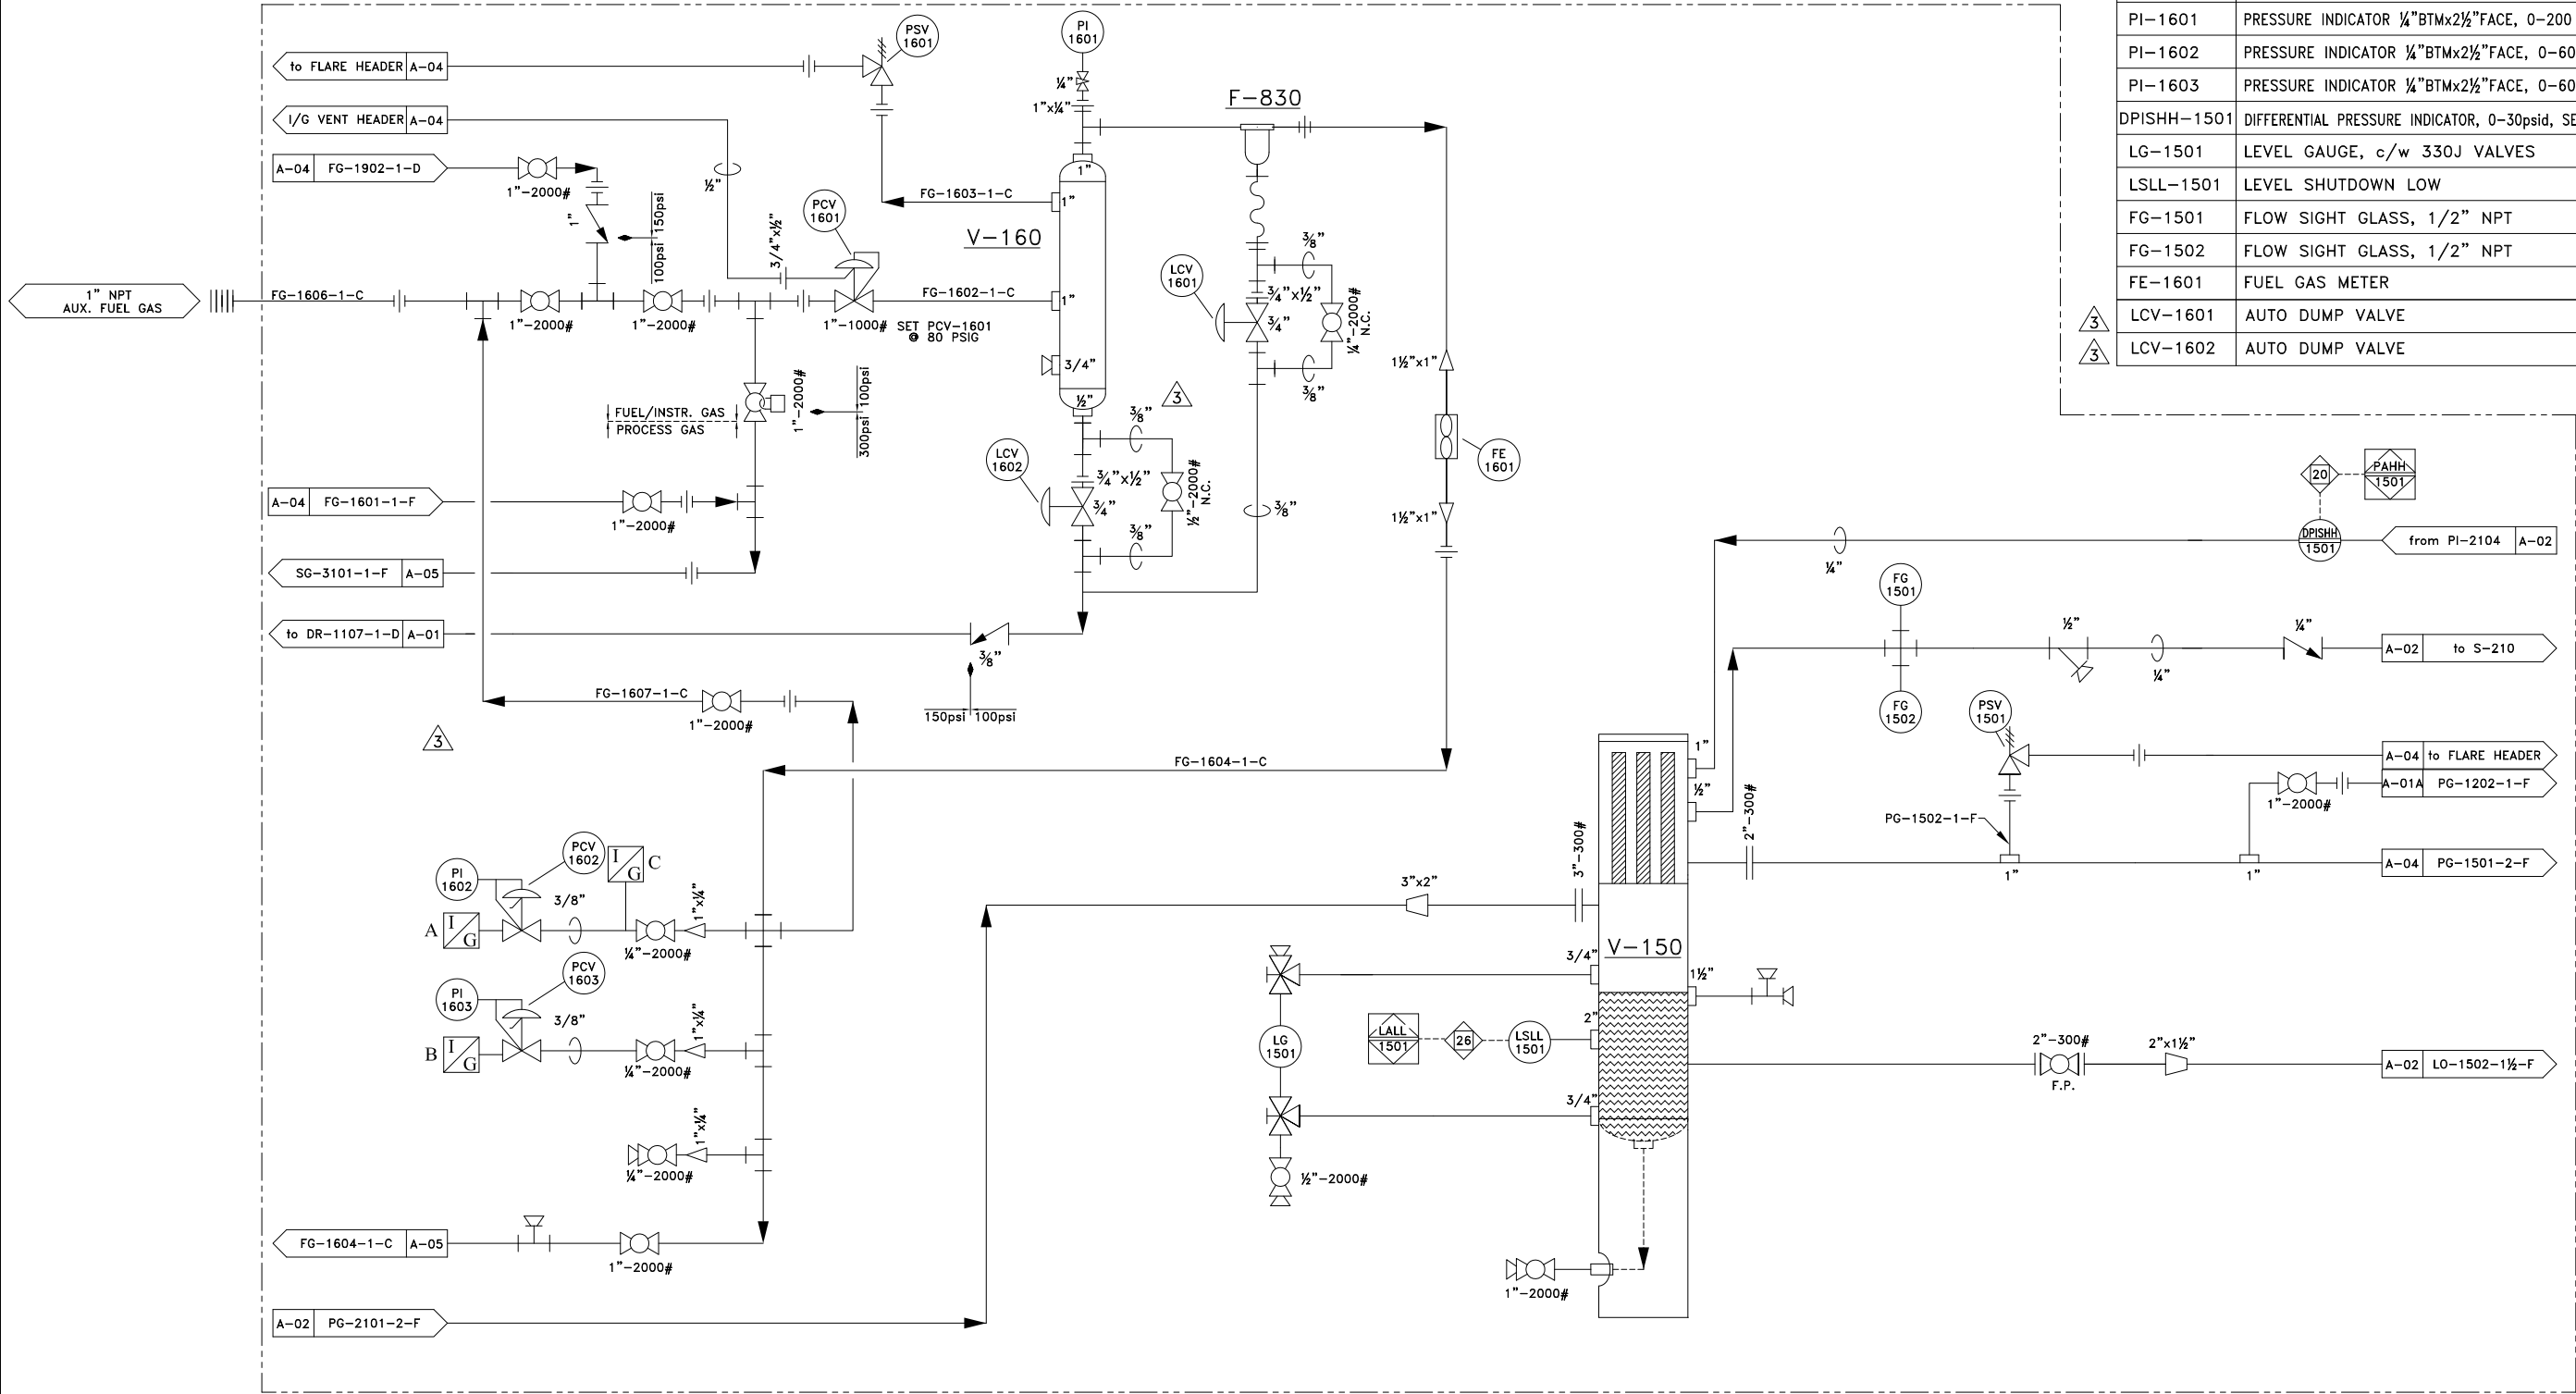

LINE TYPE	LEGEND
—	PROCESS TUBING/ INSTRUMENT SUPPLY
—	MAIN PROCESS GAS
—	SECONDARY PROCESS
—	UTILITY PROCESS
—	PNEUMATIC SIGNAL
—	HYDRAULIC SIGNAL
—	ELECTRIC SIGNAL

4	AS BUILT FOR SC-1735-C1	SLB	07-02-23		
3	REVISED FOR SC-1735-C1	SLB	07-02-22	WST	SE
2	AS BUILT	KMW	06-06-28	CAD	ENG
1	REVISED FOR SC-1619-C1	KMW	06-06-21	WST	SE
0	ISSUED FOR CONSTRUCTION	KMW	06-05-03	WST	SE
REV.	DESCRIPTION	BY	DATE	CHKD	APPD

Jiro
ENERFLEX

5221-46th St. Stettler Alberta Phone: 403.742.5538
Box 1450, T0C 2L2 Fax: 403.742.5539

3500 SERIES COMPRESSOR
G.D. SSH w/ 3304 NA ENGINE
TRAILER MOUNTED, SOUR SERVICE

COMPANY:				JOB NO.:			
ENCANA				35396			
Drawn by:	Checked by:	Approved by:	DATE:	SCALE:	DRAWING NO.:	REV.:	
SLS	WST	SE	05-06-29	N.T.S.	CDL-35396-A-03	4	

C-510
OIL/GAS AFTER COOLER


Manufacture: GLOBAL HEAT TRANSFER
Model: GHTJ 1600 (SPLIT)
Gas Rated: 370psi @ 250°F
Oil Rated: 350psi @ 250°F

V-190
FUEL GAS SCRUBBER

Manufacturer: IMPACT INDUSTRIAL SALES & SERVICES LTD.
Size: 6" x 43" S/S
MAWP: 350psi @ 250°F
1/8" CA

MATERIAL LIST

ITEM	DESCRIPTION	MAKE	MODEL
PCV-1102	PRESSURE CONTROL VALVE SET @ 5-20 psi, 3/8" PORT	FISHER	627-552
PCV-5101	BACK PRESSURE CONTROL VALVE, VITON	KIMRAY	230SGTBV
PCV-5102	PRESSURE RELIEF VALVE, 1" NPT, 1/2" PORT, RANGE 150-250psi	FISHER	630R-9S
PI-5101	PRESSURE INDICATOR 1/4" BLM x 2 1/2" FACE, 0-300psi/0-2100kPa	WIKA	SSLF
TI-5101	TEMPERATURE INDICATOR 3" FACE, -40 TO 160 °F	TREND	2 1/2" STEM
TC-5101	TEMPERATURE CONTROLLER	KIMRAY	HT-12
	LOUVERS c/w ACTUATORS	TRACTION	CS1537 1A/B
PSV-1901	PRESSURE SAFETY VALVE, 1"x1" NPT, SET @ 150 psi	MERCER	E ORIFICE
LC-1901	LEVEL CONTROLLER	MURPHY	L1200-NDVO
LCV-1901	LEVEL CONTROL VALVE, 1/2" PORT, FC	FISHER	D2 FLO PRO
LG-1901	LEVEL GAUGE, 5/8" REDLINE, c/w GAUGE VALVES	PENBERTHY	N7A
PCV-1901	PRESSURE CONTROL VALVE, SPRING RANGE 70-150psi, 3/16" PORT	FISHER	627 488
LSHH-1901	LEVEL SHUTDOWN HIGH	MURPHY	L1100
PI-1901	PRESSURE INDICATOR, 1/4" BTM x 2 1/2" FACE, 0-200psi/0-1400kPa	WIKA	SSLF
PSV-1902	PRESSURE SAFETY VALVE, 1"x1" NPT, SET @ 300 psi	MERCER	E ORIFICE

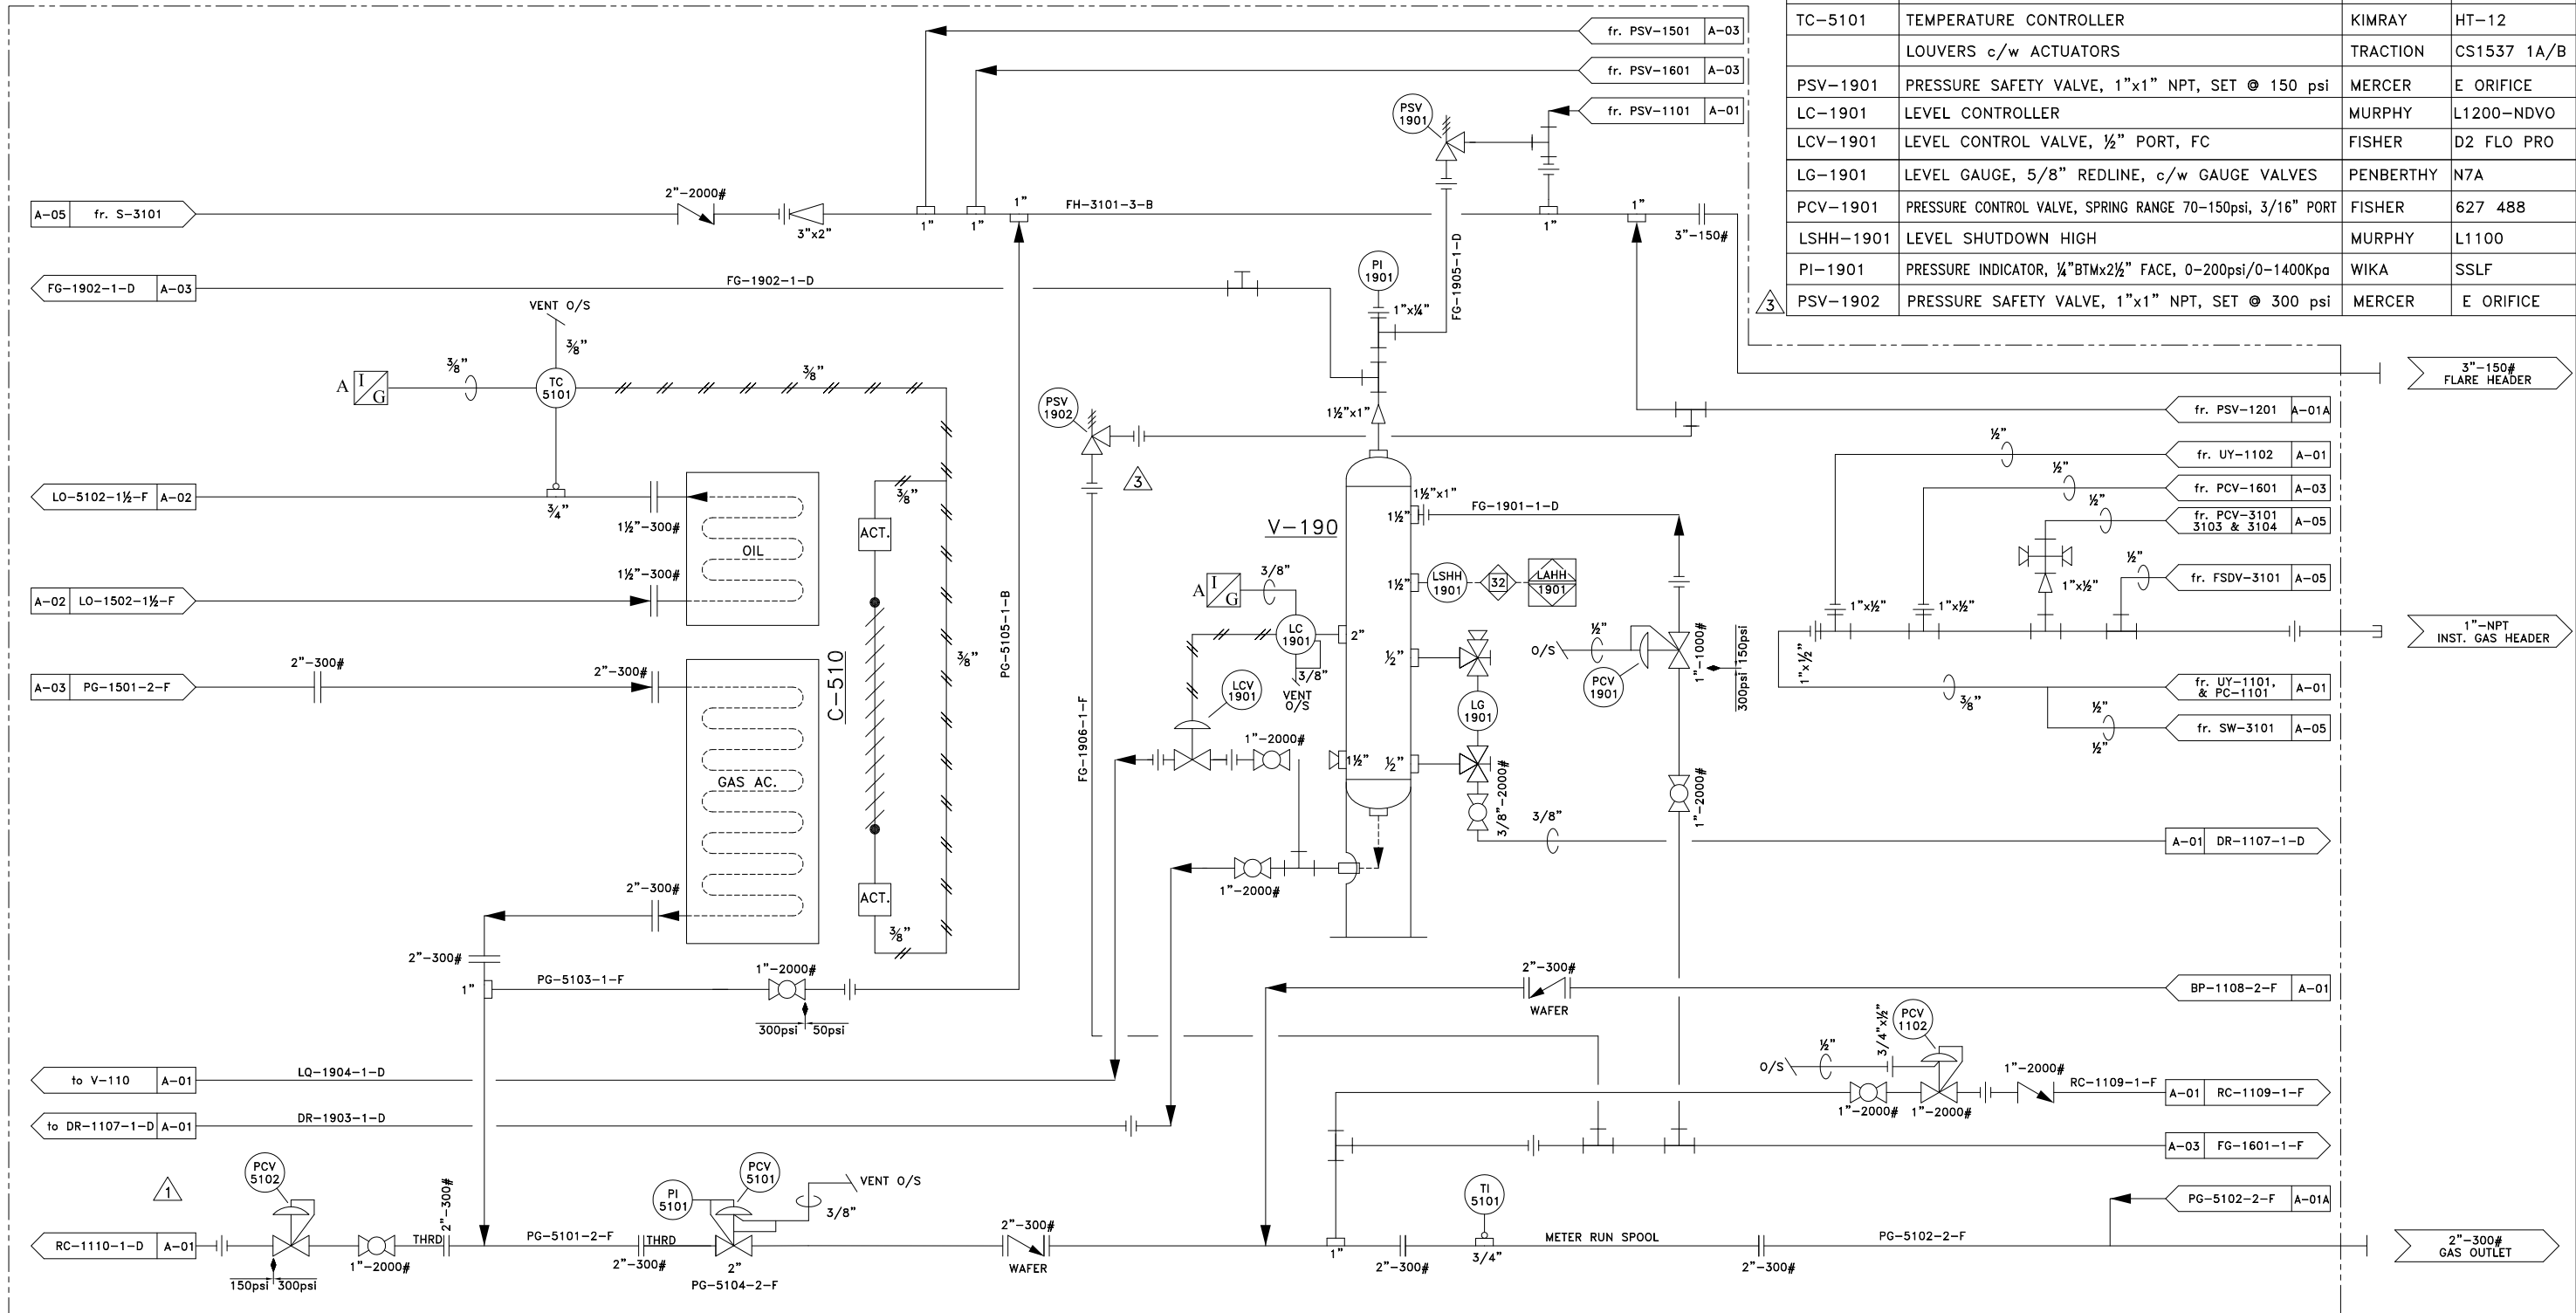

LINE TYPE	LEGEND	
PROCESS TUBING/ INSTRUMENT SUPPLY		
MAIN PROCESS GAS		PNEUMATIC SIGNAL
SECONDARY PROCESS		HYDRAULIC SIGNAL
UTILITY PROCESS		ELECTRIC SIGNAL

4	AS BUILT FOR SC-1735-C1	SLB	07-02-23		
3	REVISED FOR SC-1735-C1	SLB	07-02-22	WST	SE
2	AS BUILT	KMW	06-06-28	CAD	ENG
1	REVISED FOR SC-1619-C1	KMW	06-06-21	WST	SE
0	ISSUED FOR CONSTRUCTION	KMW	06-05-03	WST	SE
REV.	DESCRIPTION	BY	DATE	CHKD	APPD

Jiro
ENERFLEX

5221-46th St. Stettler Alberta Phone: 403.742.5538
Box 1450, T0C 2L2 Fax: 403.742.5539


3500 SERIES COMPRESSOR
G.D. SSH w/ 3304 NA ENGINE
TRAILER MOUNTED, SOUR SERVICE

COMPANY:				JOB NO.:			
ENCANA				35396			
Drawn by:	Checked by:	Approved by:	DATE:	SCALE:	DRAWING NO.:	REV.:	
SLS	WST	SE	05-06-29	N.T.S.	CDL-35396-A-04	4	

M-310
NATURAL GAS ENGINE
Manufacturer: CATERPILLAR
Model: G3304NA
95hp / 80hp USABLE
Naturally Aspirated 4 Cylinder

C-520
ENGINE WATER JACKET
Manufacturer: GLOBAL HEAT TRANSFER
Model: GLB 7400

T-710
ENGINE OIL DAY TANK
Manufacturer: ENERFLEX
Size: 20gal
Part: OS-37

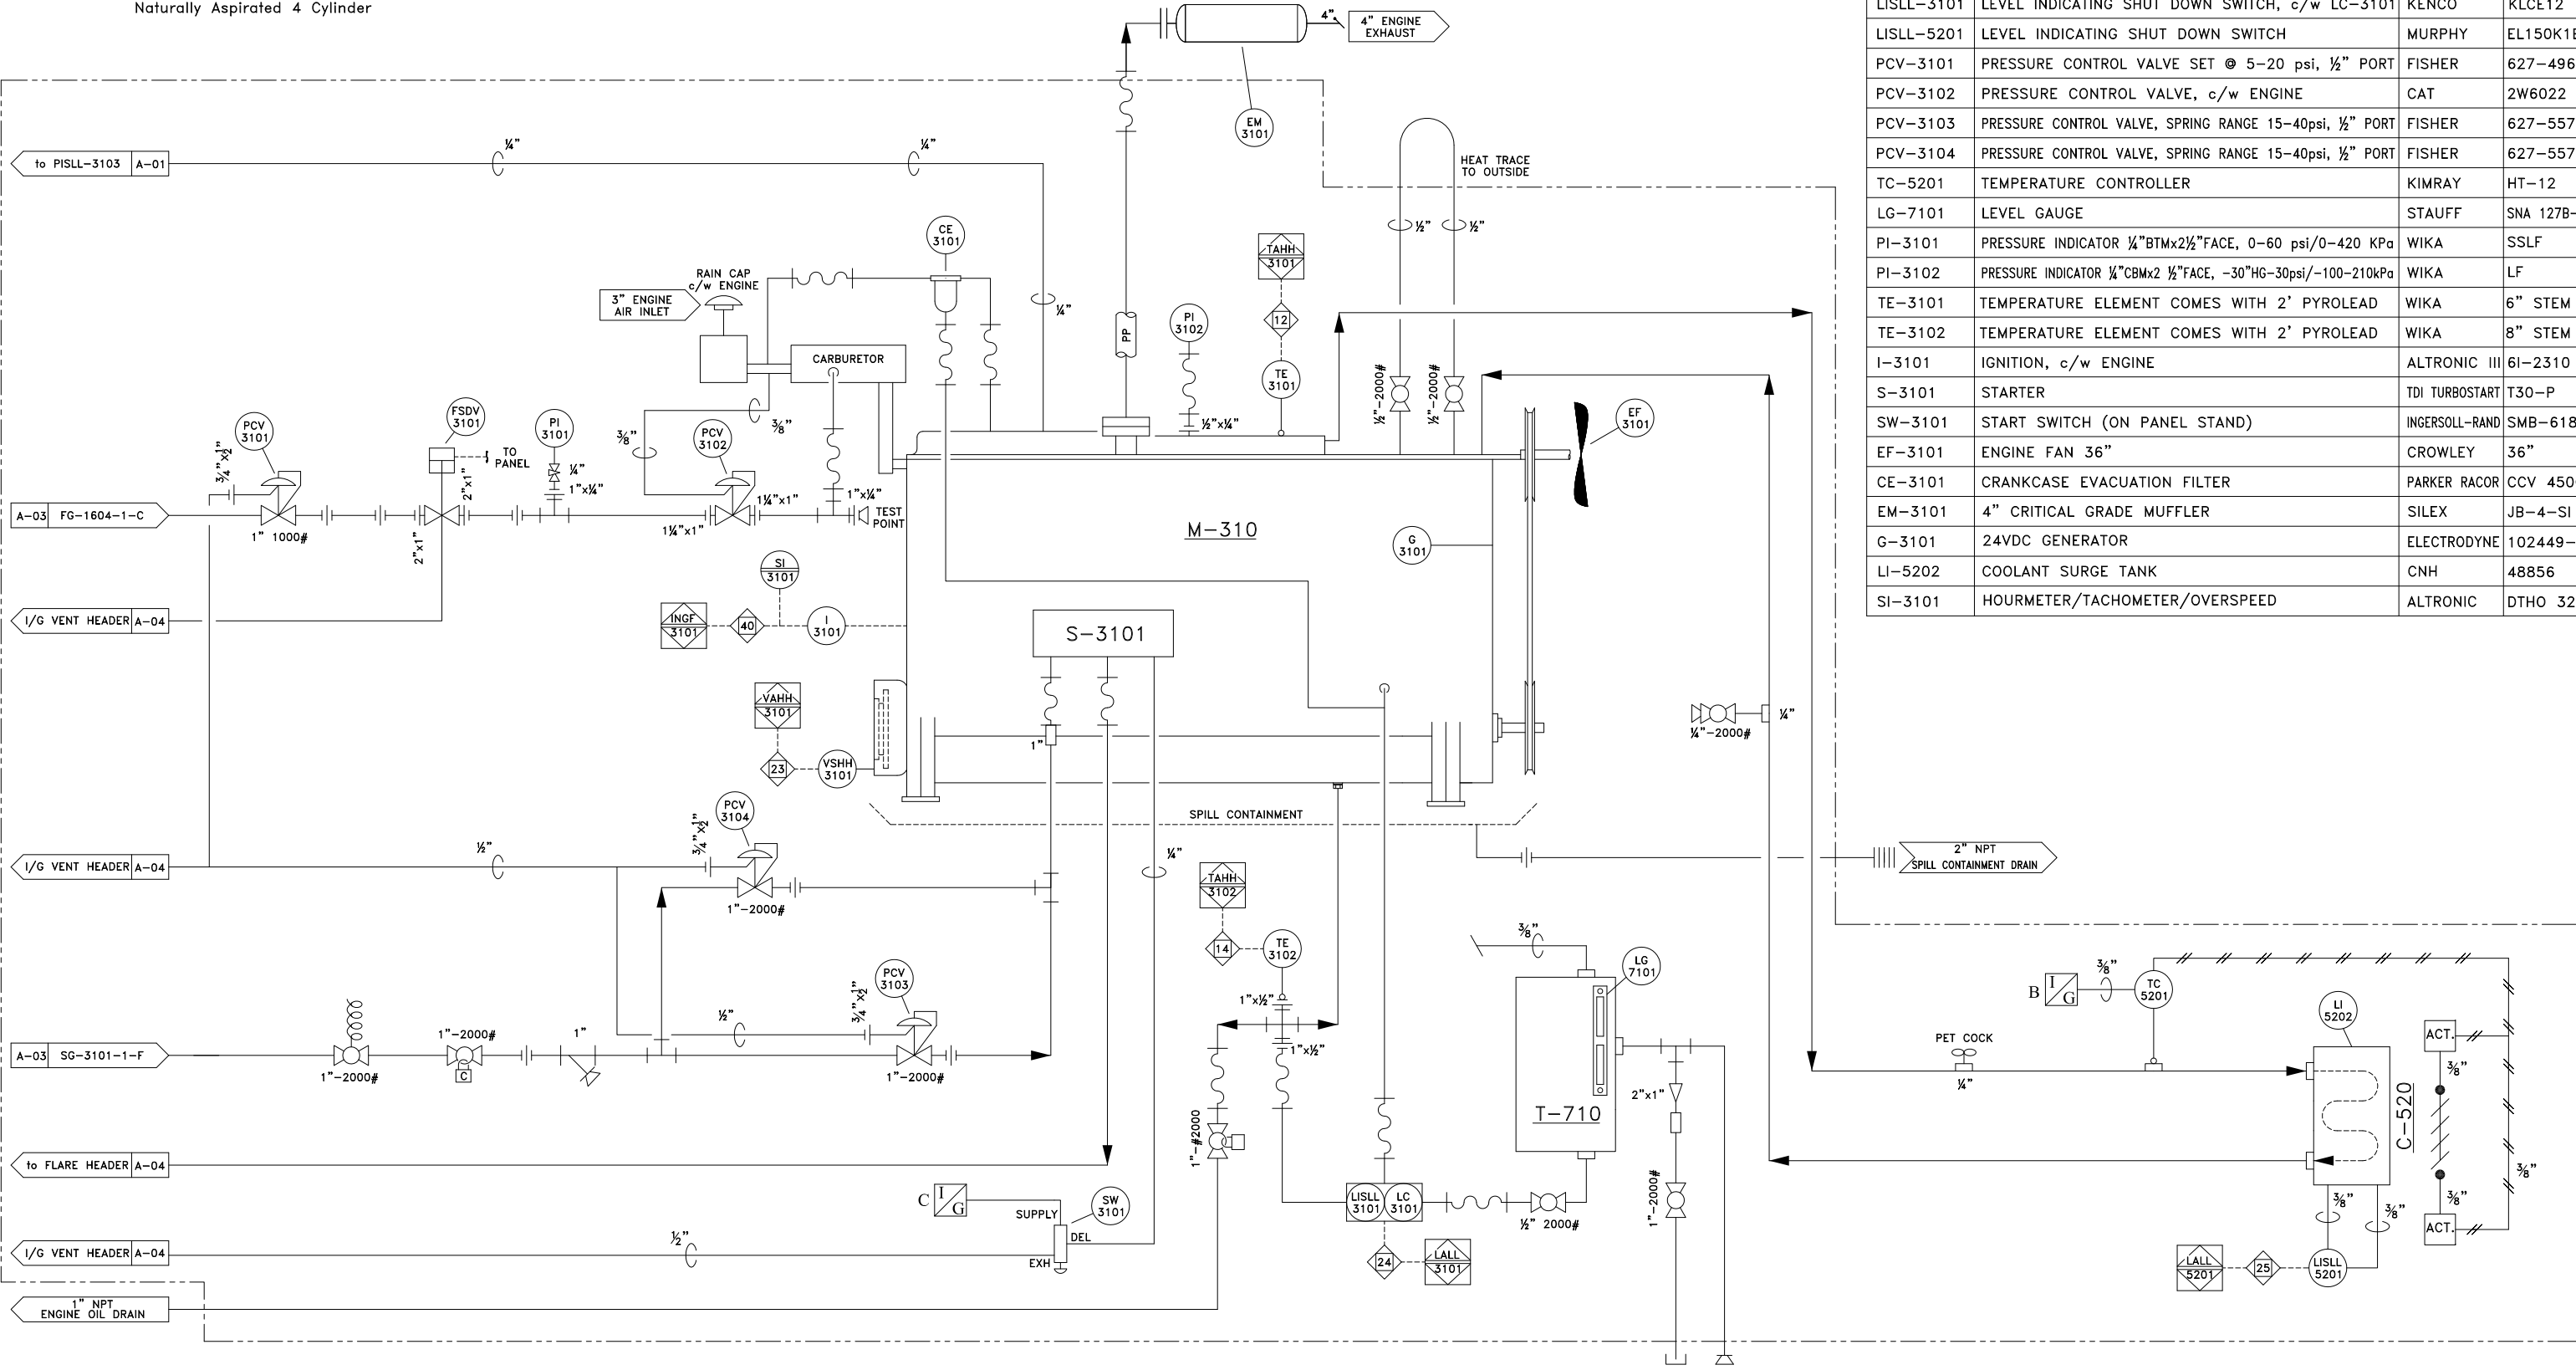

MATERIAL LIST

ITEM	DESCRIPTION	MAKE	MODEL
FSDV-3101	FUEL SHUT DOWN VALVE	MURPHY	M5081-C
VSHH-3101	VIBRATION SWITCH HIGH	MURPHY	VS-2E
LISLL-3101	LEVEL INDICATING SHUT DOWN SWITCH, c/w LC-3101	KENCO	KLCE12
LISLL-5201	LEVEL INDICATING SHUT DOWN SWITCH	MURPHY	EL150K1E
PCV-3101	PRESSURE CONTROL VALVE SET @ 5-20 psi, 1/2" PORT	FISHER	627-496
PCV-3102	PRESSURE CONTROL VALVE, c/w ENGINE	CAT	2W6022
PCV-3103	PRESSURE CONTROL VALVE, SPRING RANGE 15-40psi, 1/2" PORT	FISHER	627-557
PCV-3104	PRESSURE CONTROL VALVE, SPRING RANGE 15-40psi, 1/2" PORT	FISHER	627-557
TC-5201	TEMPERATURE CONTROLLER	KIMRAY	HT-12
LG-7101	LEVEL GAUGE	STAUFF	SNA 127B-ST-12
PI-3101	PRESSURE INDICATOR 1/4"BTMx2 1/2"FACE, 0-60 psi/0-420 kPa	WIKA	SSLF
PI-3102	PRESSURE INDICATOR 1/4"CBMx2 1/2"FACE, -30"HG-30psi/-100-210kPa	WIKA	LF
TE-3101	TEMPERATURE ELEMENT COMES WITH 2' PYROLEAD	WIKA	6" STEM
TE-3102	TEMPERATURE ELEMENT COMES WITH 2' PYROLEAD	WIKA	8" STEM
I-3101	IGNITION, c/w ENGINE	ALTRONIC III	6I-2310
S-3101	STARTER	TDI TURBOSTART	T30-P
SW-3101	START SWITCH (ON PANEL STAND)	INGERSOLL-RAND	SMB-618
EF-3101	ENGINE FAN 36"	CROWLEY	36"
CE-3101	CRANKCASE EVACUATION FILTER	PARKER RACOR	CCV 4500
EM-3101	4" CRITICAL GRADE MUFFLER	SILEX	JB-4-SI
G-3101	24VDC GENERATOR	ELECTRODYNE	102449-HZ24
LI-5202	COOLANT SURGE TANK	CNH	48856
SI-3101	HOURLMETER/TACHOMETER/OVERSPEED	ALTRONIC	DTHO 3201

LINE TYPE	LEGEND
	PROCESS TUBING/ INSTRUMENT SUPPLY
	MAIN PROCESS GAS
	SECONDARY PROCESS
	UTILITY PROCESS
	PNEUMATIC SIGNAL
	HYDRAULIC SIGNAL
	ELECTRIC SIGNAL


2	AS BUILT	KMW	06-06-28	CAD	ENG
1	REVISED FOR SC-1619-C1	KMW	06-06-21	WST	SE
0	ISSUED FOR CONSTRUCTION	KMW	06-05-03	WST	SE
REV.	DESCRIPTION	BY	DATE	CHKD	APPD

Jiro
ENERFLEX

5221-46th St. Stettler Alberta Phone: 403.742.5538
Box 1450, T0C 2L2 Fax: 403.742.5539

3500 SERIES COMPRESSOR
G.D. SSH w/ 3304 NA ENGINE
TRAILER MOUNTED, SOUR SERVICE

COMPANY: ENCANA				JOB NO.: 35396	
Drawn by: SLS	Checked by:	Approved by:	DATE: 05-06-29	SCALE: N.T.S.	DRAWING NO.: CDL-35396-A-05
					REV.: 2

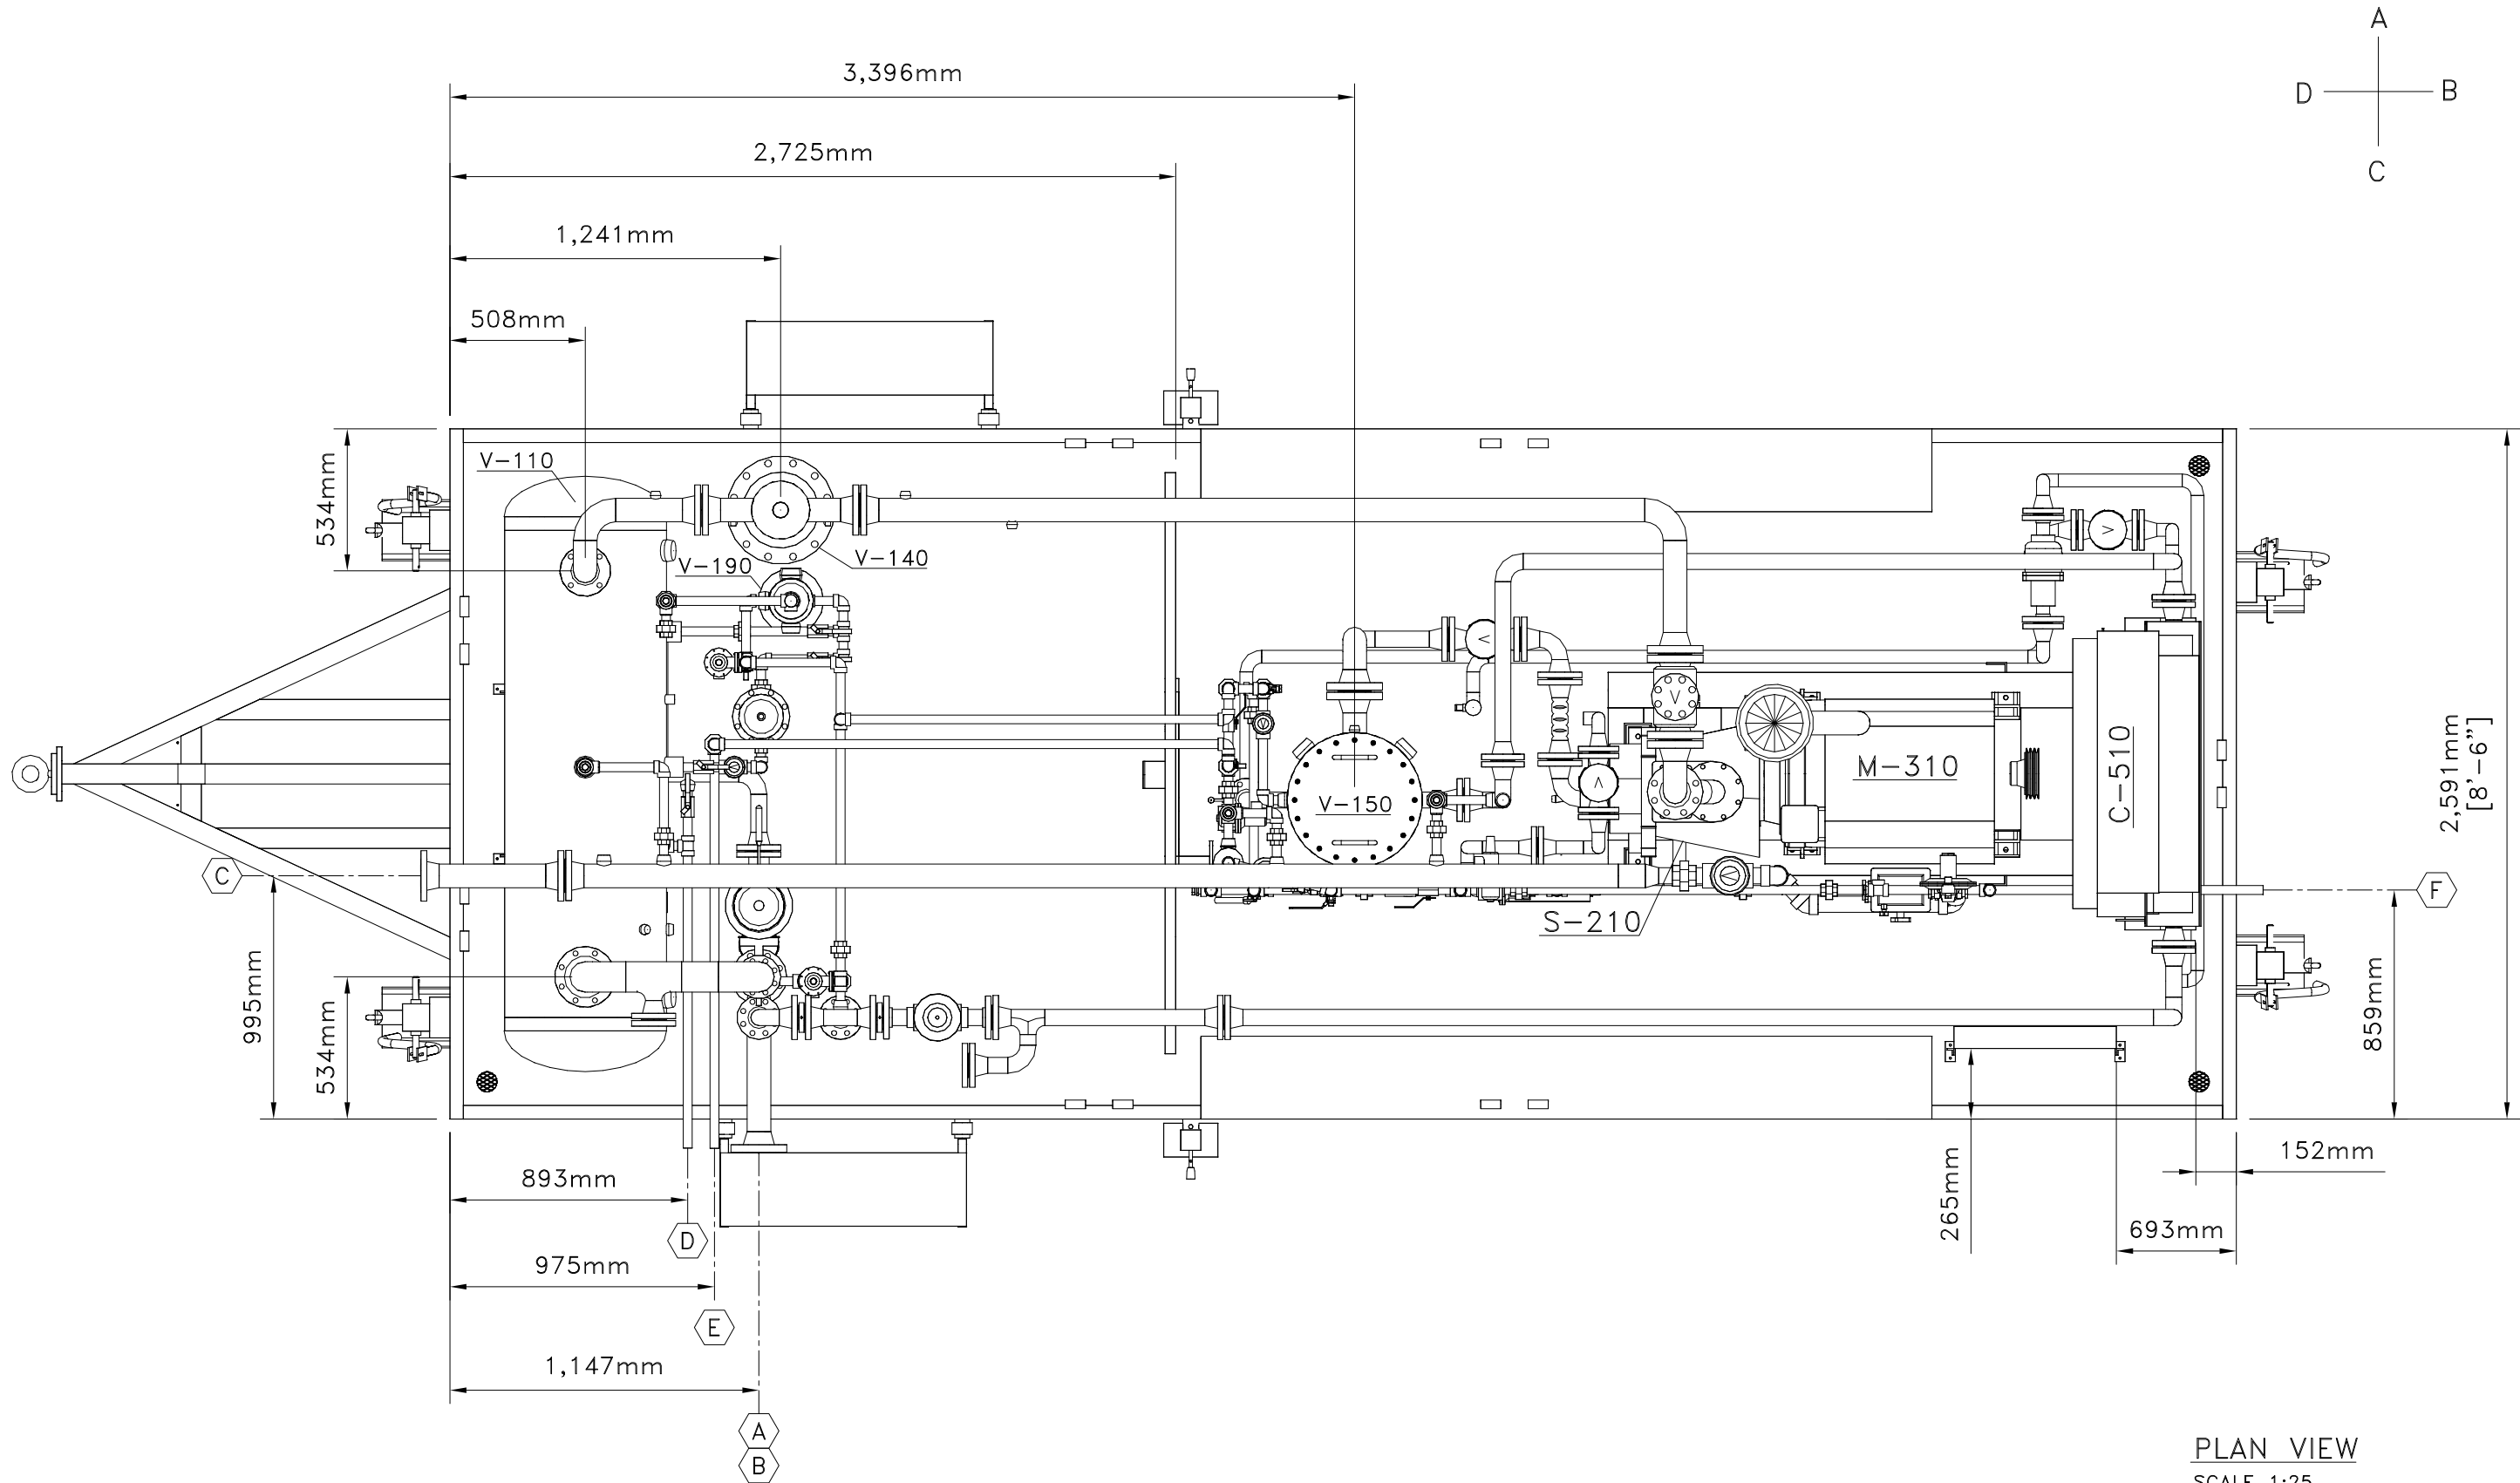

PLAN VIEW
SCALE 1:25

CUSTOMER CONNECTIONS				
ITEM	DESCRIPTION	SIZE	ELEVATION	PROJ.
A	GAS INLET	3"-300# RF	431mm FTOT	135mm
B	GAS DISCHARGE	2"-300# RF	95mm FTOT	150mm
C	FLARE HEADER	3"-150# RF	2,191mm FTOT	110mm
D	MANUAL DRAIN	1" NPT	118mm FTOT	110mm
E	AUX. FUEL GAS	1" NPT	263mm FTOT	95mm
F	INTR. VENT. HEADER	1" NPT	66mm FTOT	100mm

REV.	DESCRIPTION	BY	DATE	CHKD	APPD
1	AS BUILT	KMW	06-06-30	CAD	ENG
0	ISSUED FOR CONSTRUCTION	KMW	06-05-03	WST	SE




5221-46th St. Stettler Alberta Phone: 403.742.5538
Box 1450, T0C 2L2 Fax: 403.742.5539

3500 SERIES COMPRESSOR

GD SSH w/ 3304 NA ENGINE
TRAILER MOUNTED, SOUR SERVICE

Company: ENCANA				JOB NO.: 35396	
Drawn by: ASR	Checked by:	Approved by:	Date: 05-08-23	Scale: 1:25	Drawing NO.: CDL-35396-B-01
					Rev.: 1

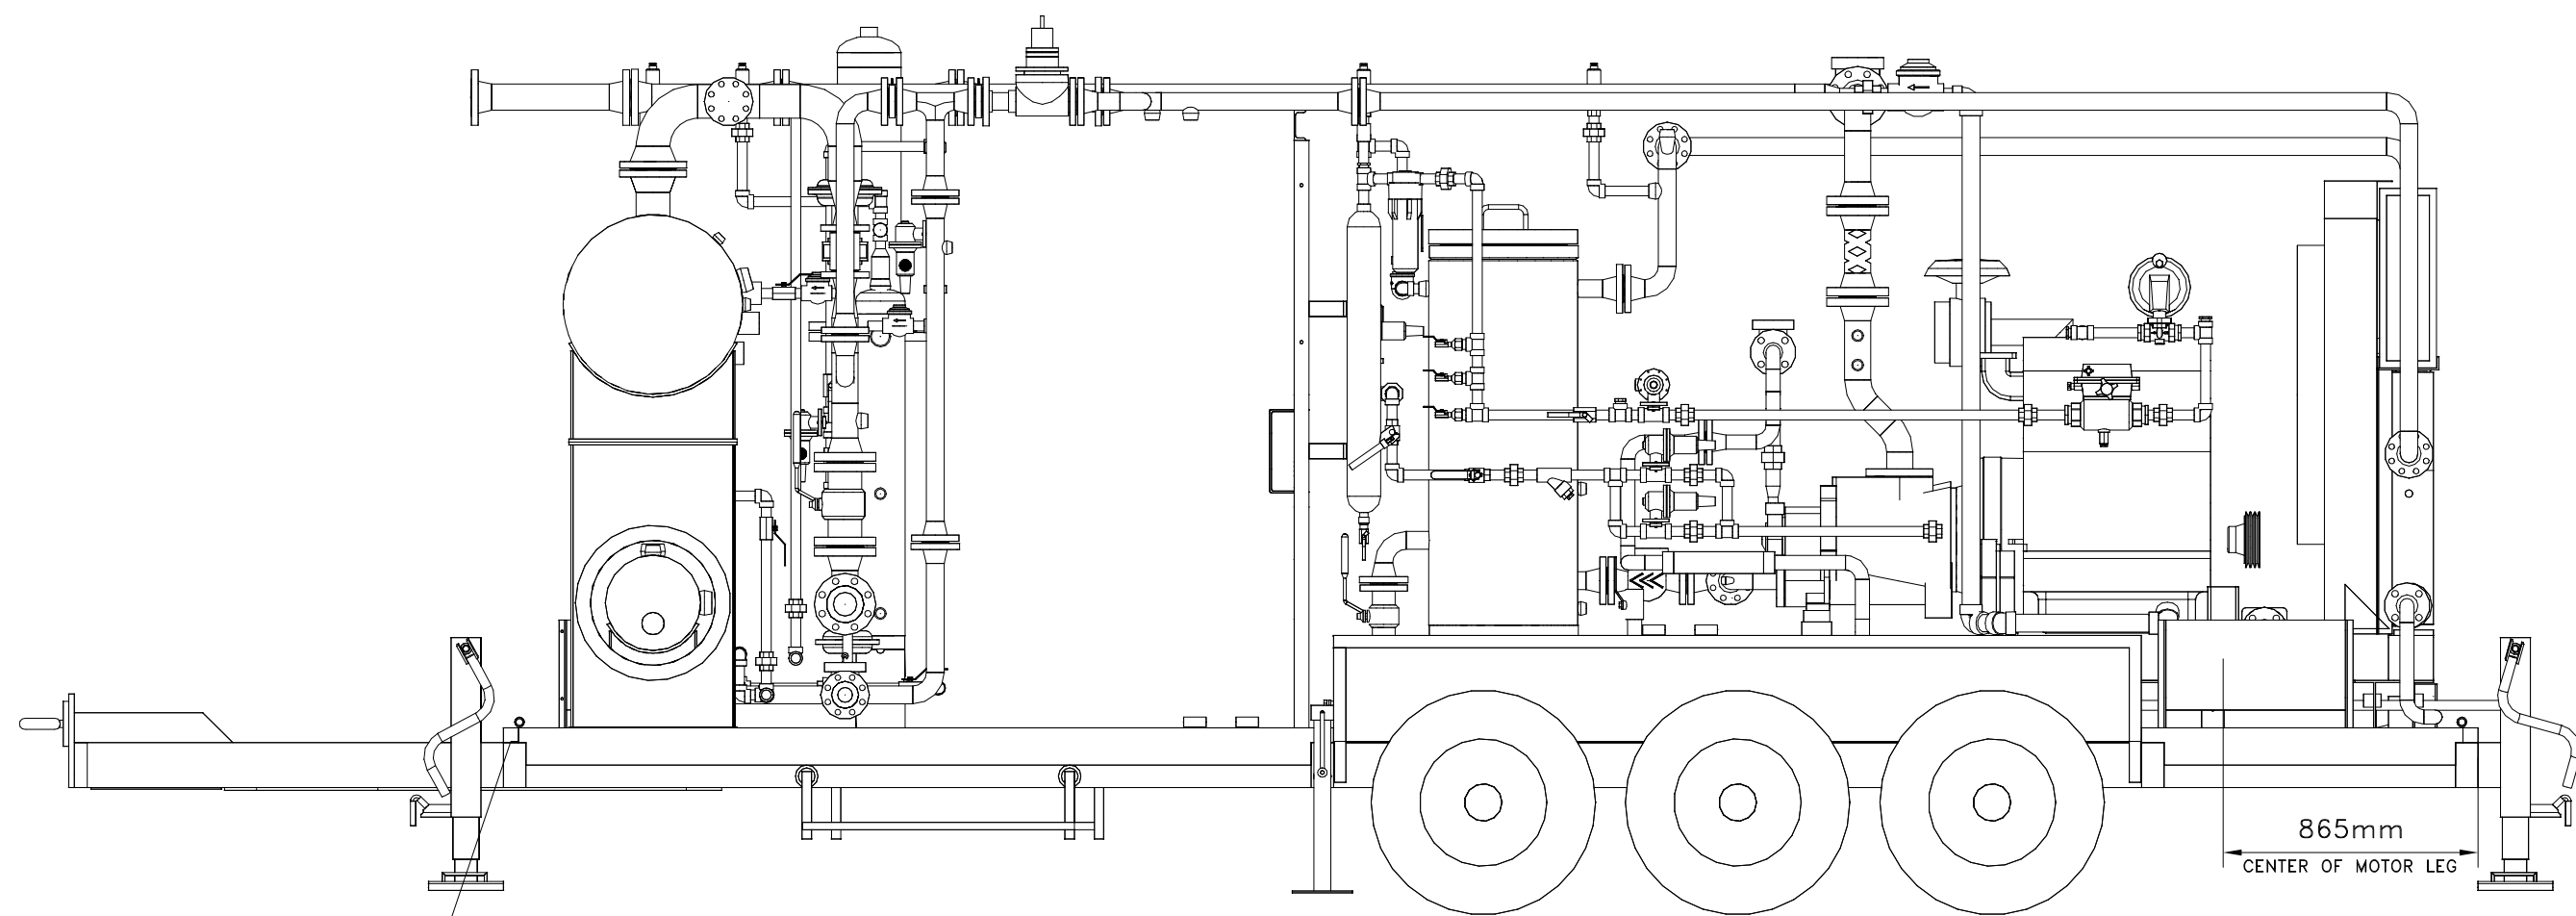

ELEVATION REFERENCE LINE
TOP OF CHECKER PLATE - 0mm

FRONT VIEW
SCALE 1:25



1	AS BUILT	KMW	06-06-30	CAD	ENG
0	ISSUED FOR CONSTRUCTION	KMW	06-05-03	WST	SE
REV.	DESCRIPTION	BY	DATE	CHKD	APPD



5221-46th St. Stettler Alberta Phone: 403.742.5538
Box 1450, T0C 2L2 Fax: 403.742.5539

3500 SERIES COMPRESSOR
GD SSH w/ 3304 NA ENGINE
TRAILER MOUNTED, SOUR SERVICE

Company: ENCANA				JOB NO.: 35396	
Drawn by: ASR	Checked by:	Approved by:	Date: 05-08-23	Scale: 1:25	Drawing NO.: CDL-35396-B-02
					Rev.: 1

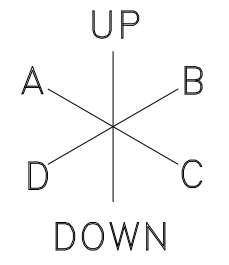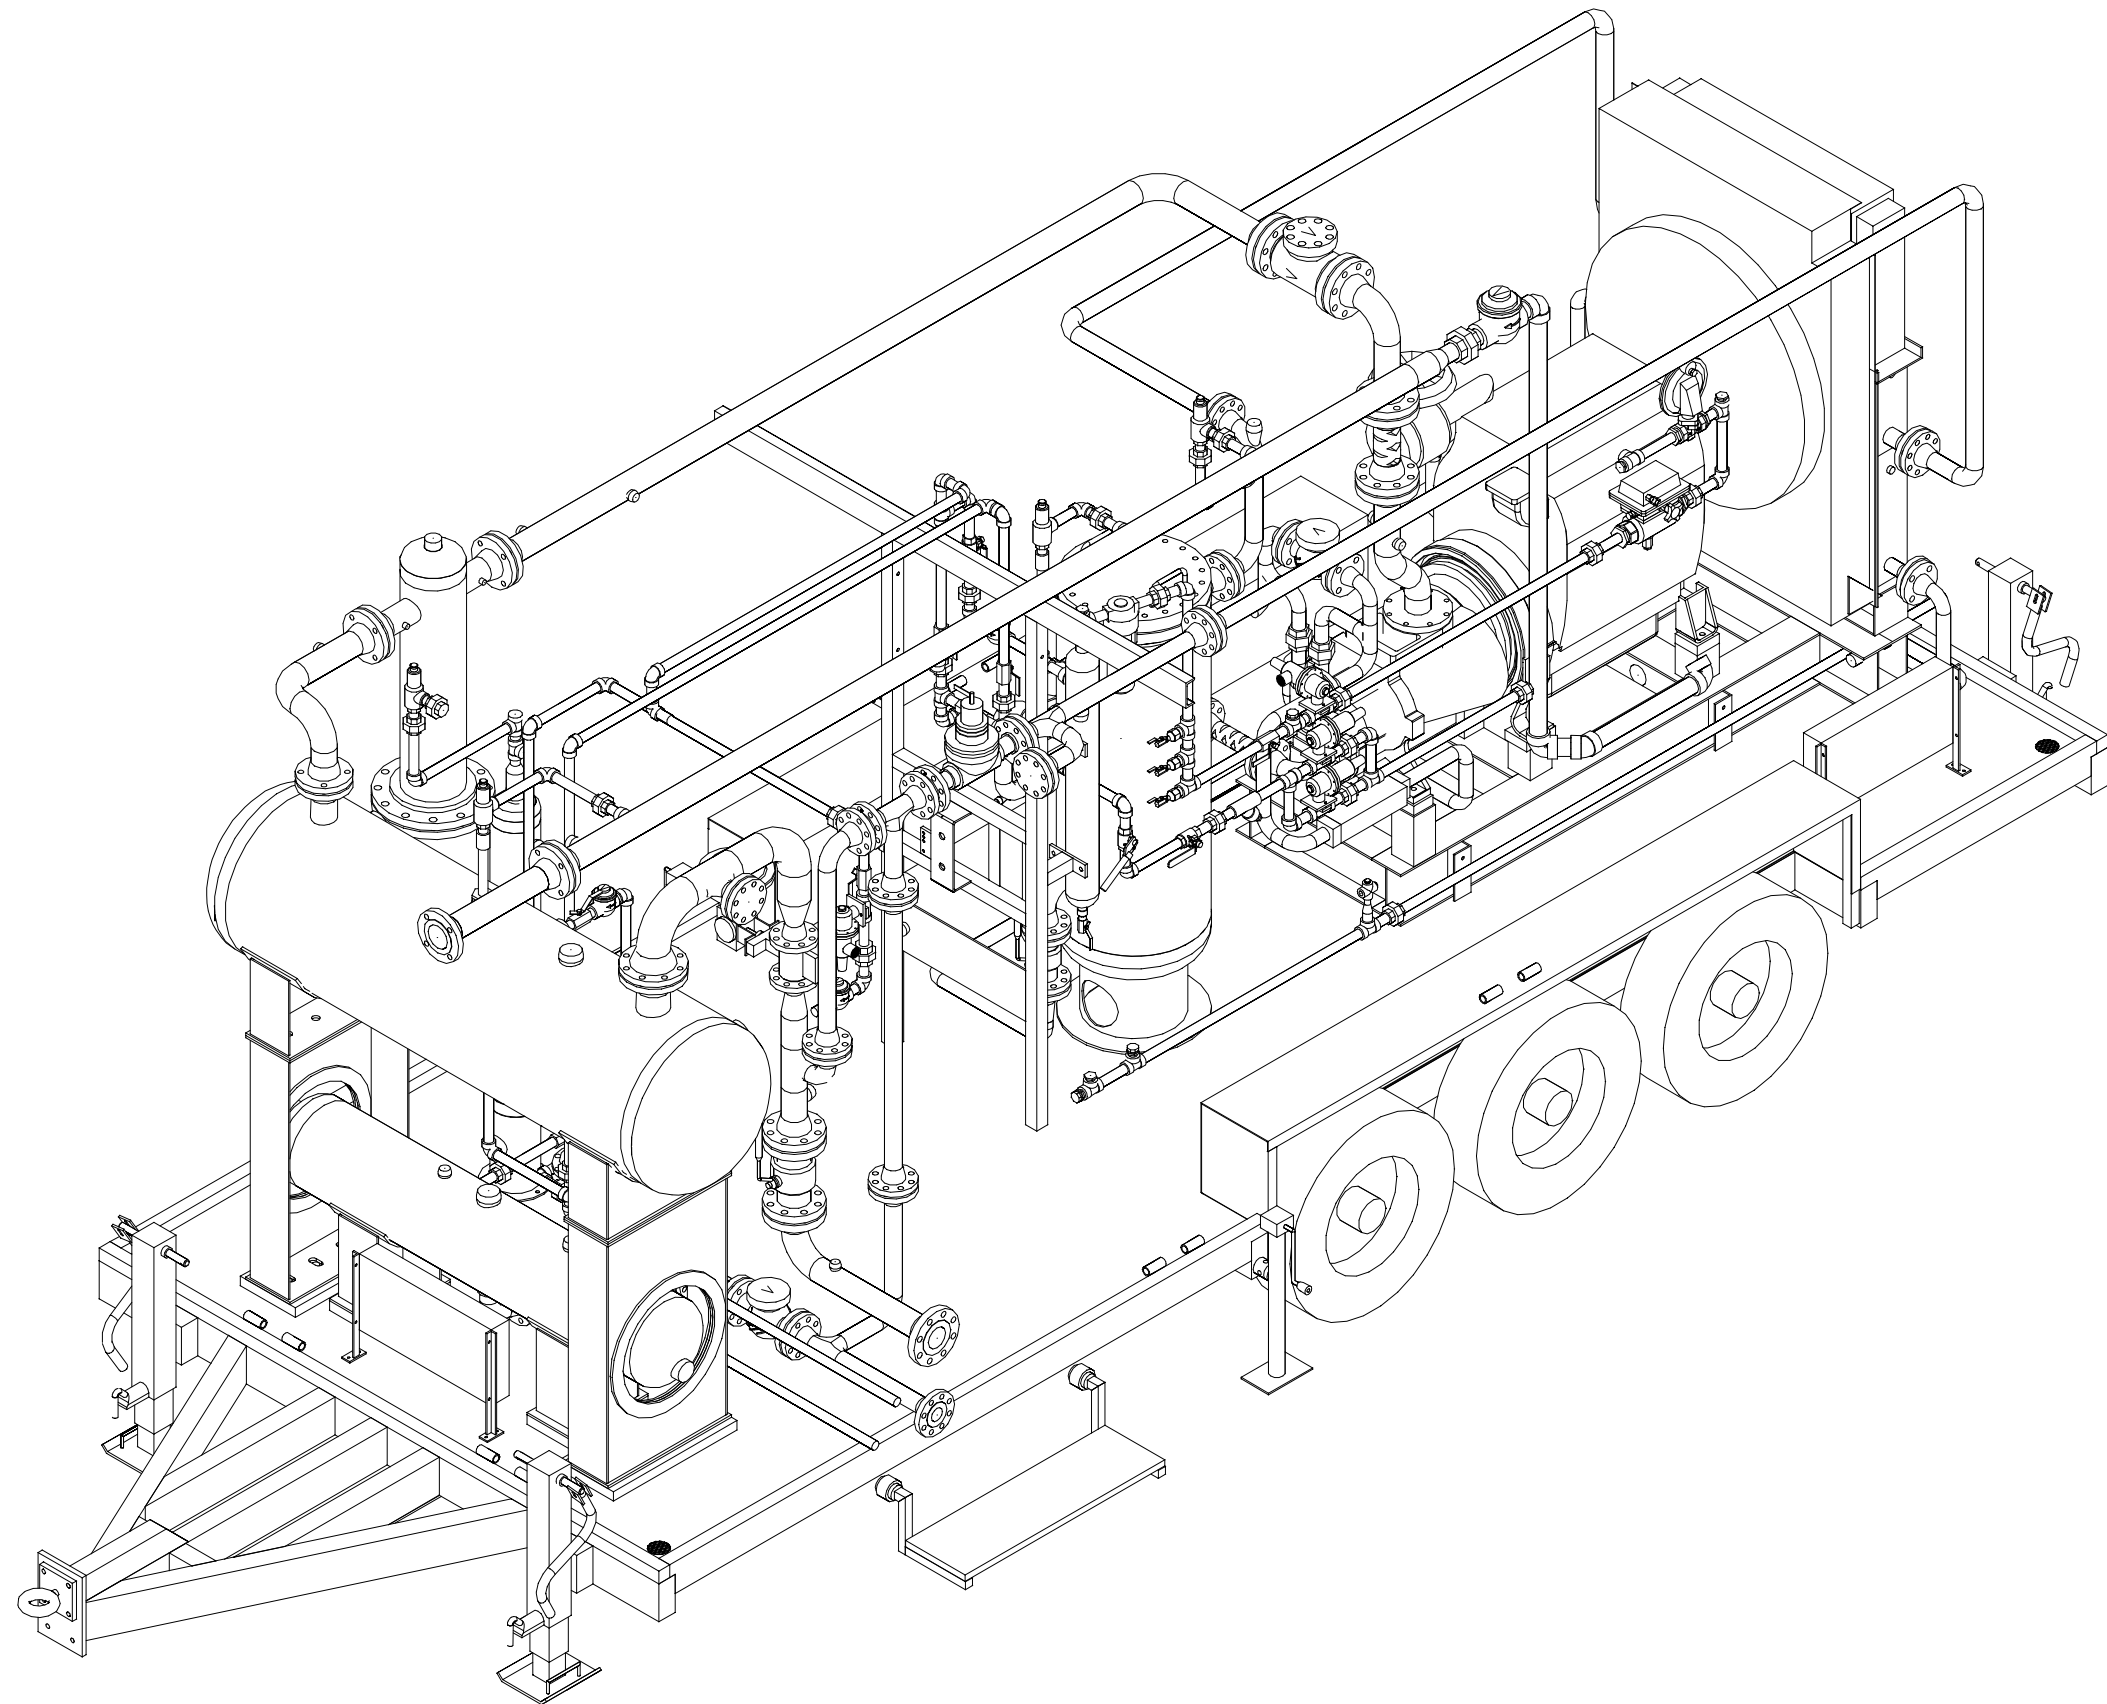

ISOMETRIC VIEW-C
SCALE 1:25



1	AS BUILT	KMW	06-06-30	CAD	ENG				
0	ISSUED FOR CONSTRUCTION	KMW	06-05-03	WST	SE				
REV.	DESCRIPTION	BY	DATE	CHKD	APPD				



5221-46th St. Stettler Alberta Phone: 403.742.5538
Box 1450, T0C 2L2 Fax: 403.742.5539

3500 SERIES COMPRESSOR
GD SSH w/ 3304 NA ENGINE
TRAILER MOUNTED, SOUR SERVICE

COMPANY: ENCANA					JOB NO.: 35396				
Drawn by: ASR	Checked by:	Approved by:	DATE: 05-08-23	SCALE: 1:25	DRAWING NO.: CDL-35396-B-03	REV.: 1			

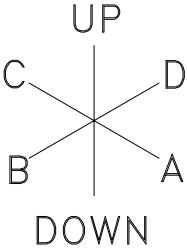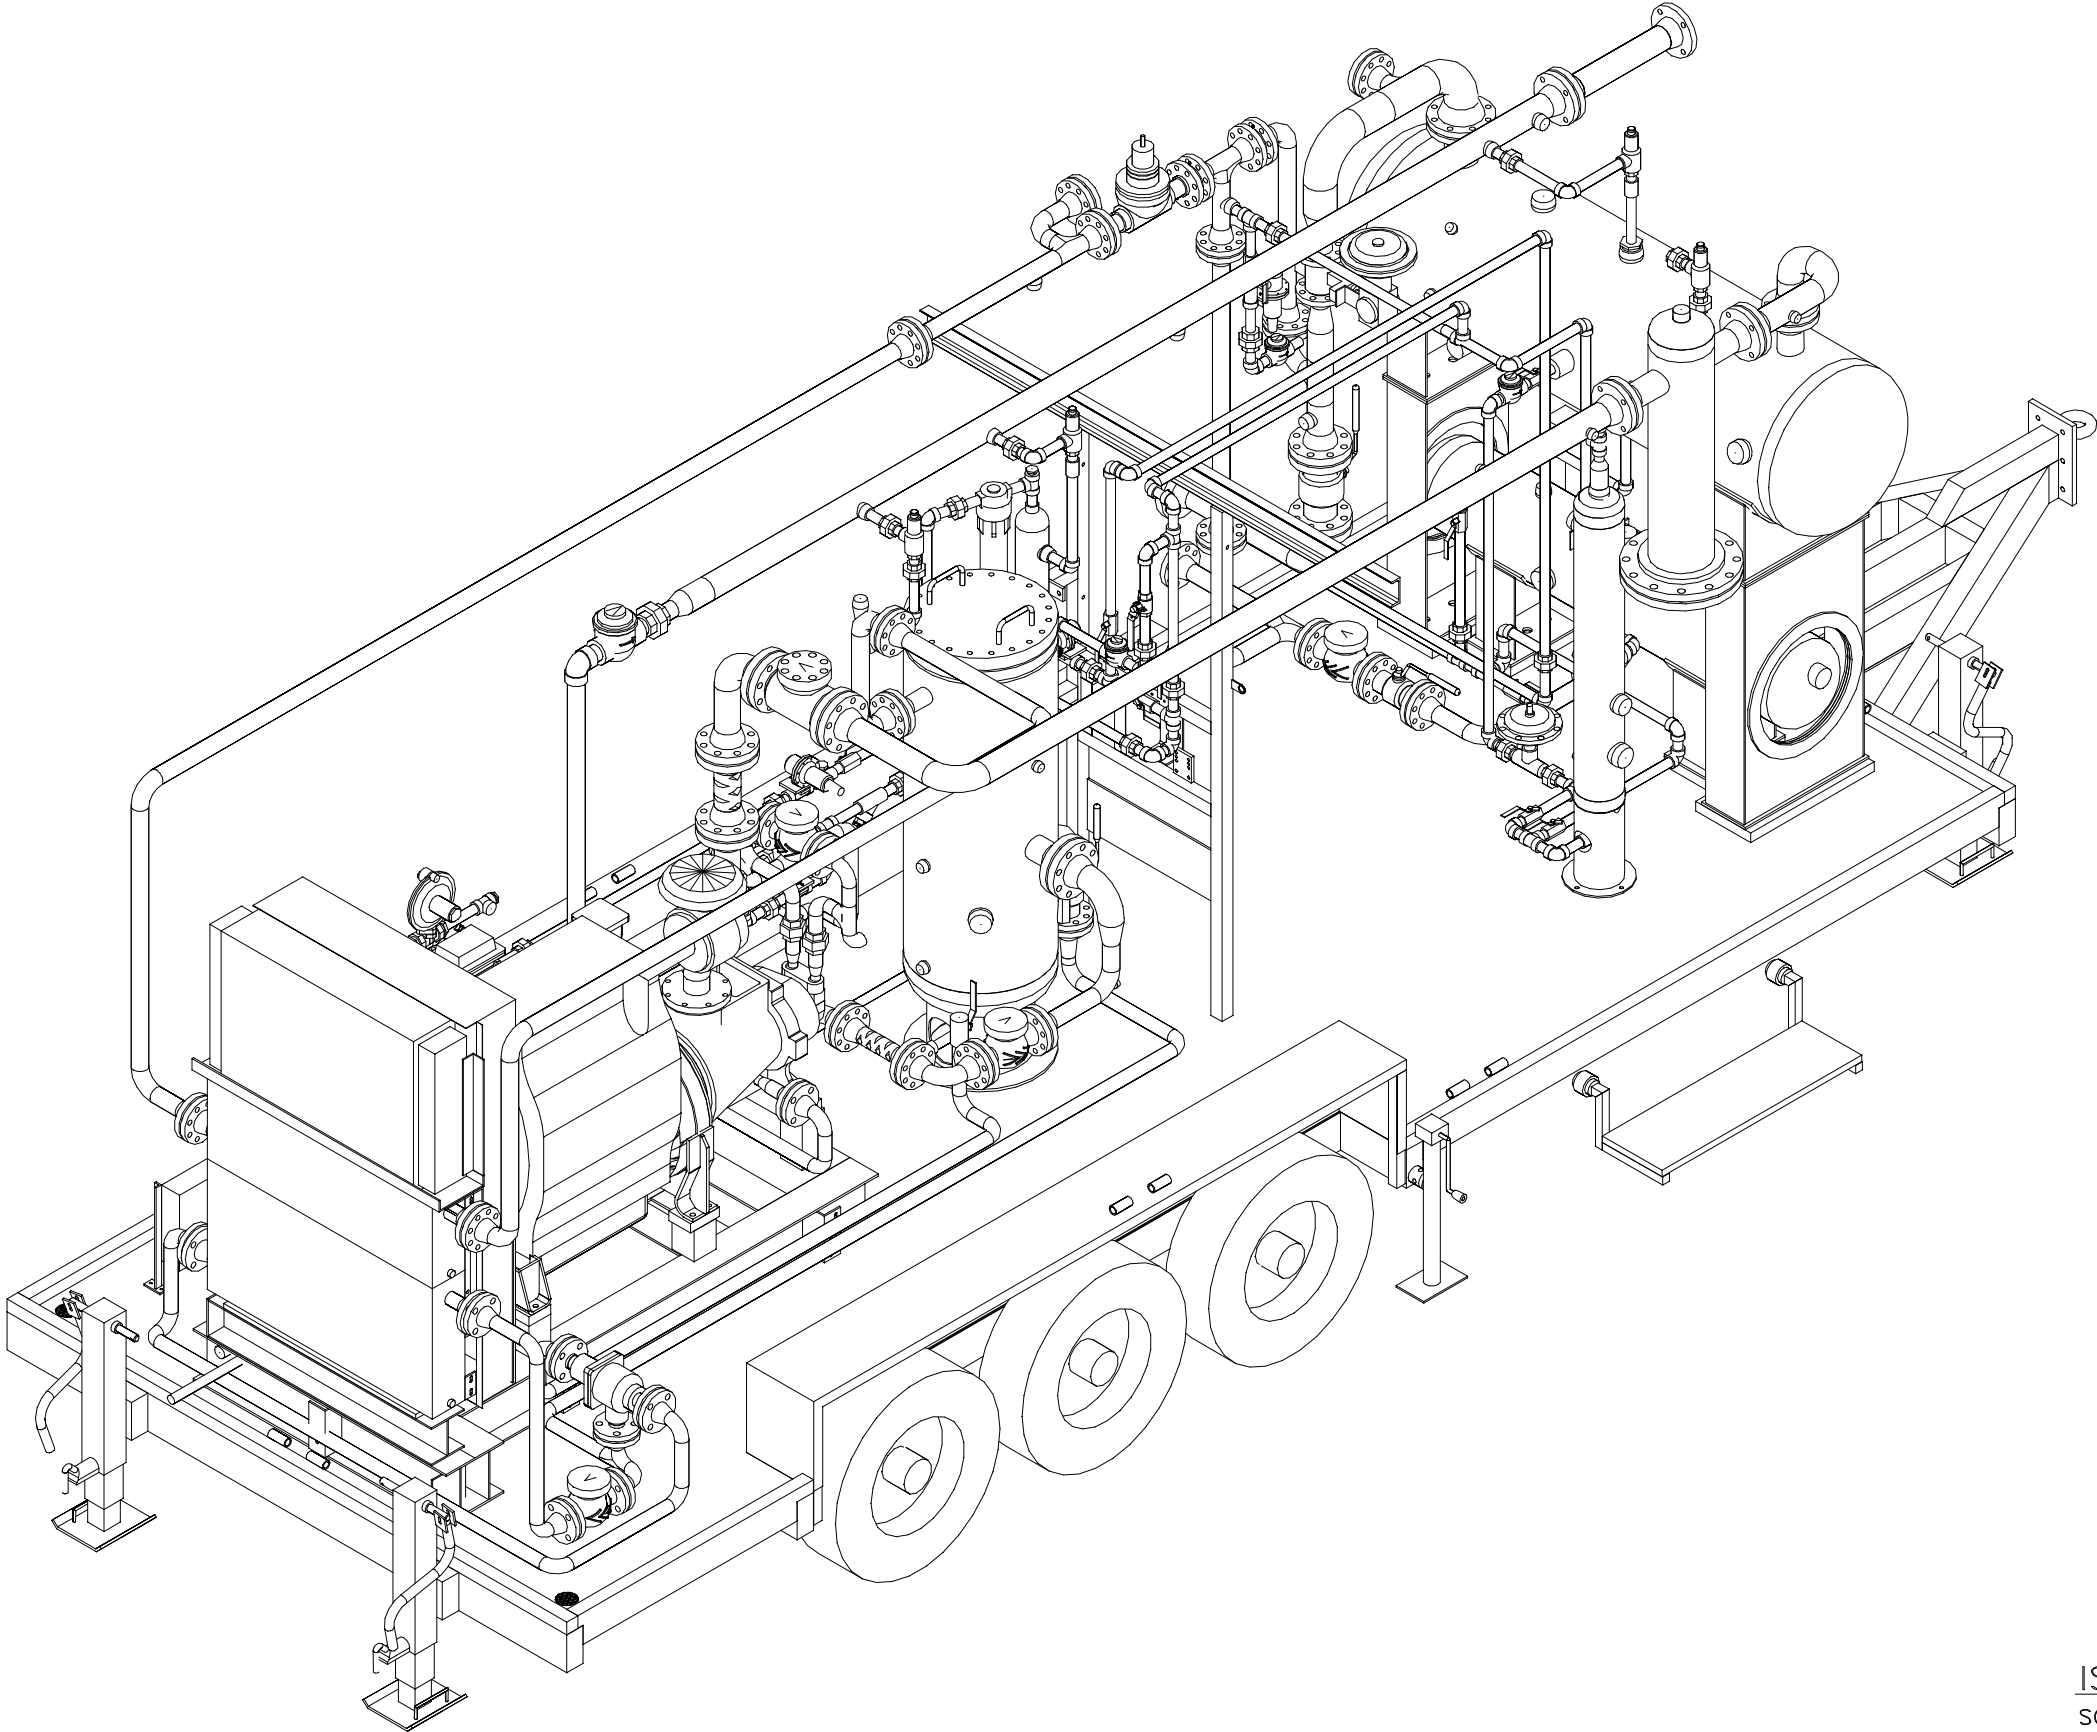

ISOMETRIC VIEW-A
SCALE 1:25

1	AS BUILT	KMW	06-06-30	CAD	ENG
0	ISSUED FOR CONSTRUCTION	KMW	06-05-03	WST	SE
REV.	DESCRIPTION	BY	DATE	CHKD	APPD



5221-46th St. Stettler Alberta Phone: 403.742.5538
Box 1450, T0C 2L2 Fax: 403.742.5539

3500 SERIES COMPRESSOR
GD SSH w/ 3304 NA ENGINE
TRAILER MOUNTED, SOUR SERVICE

COMPANY: ENCANA					JOB NO.: 35396	
Drawn by: ASR	Checked by:	Approved by:	DATE: 05-08-23	SCALE: 1:25	DRAWING NO.: CDL-35396-B-04	REV.: 1