


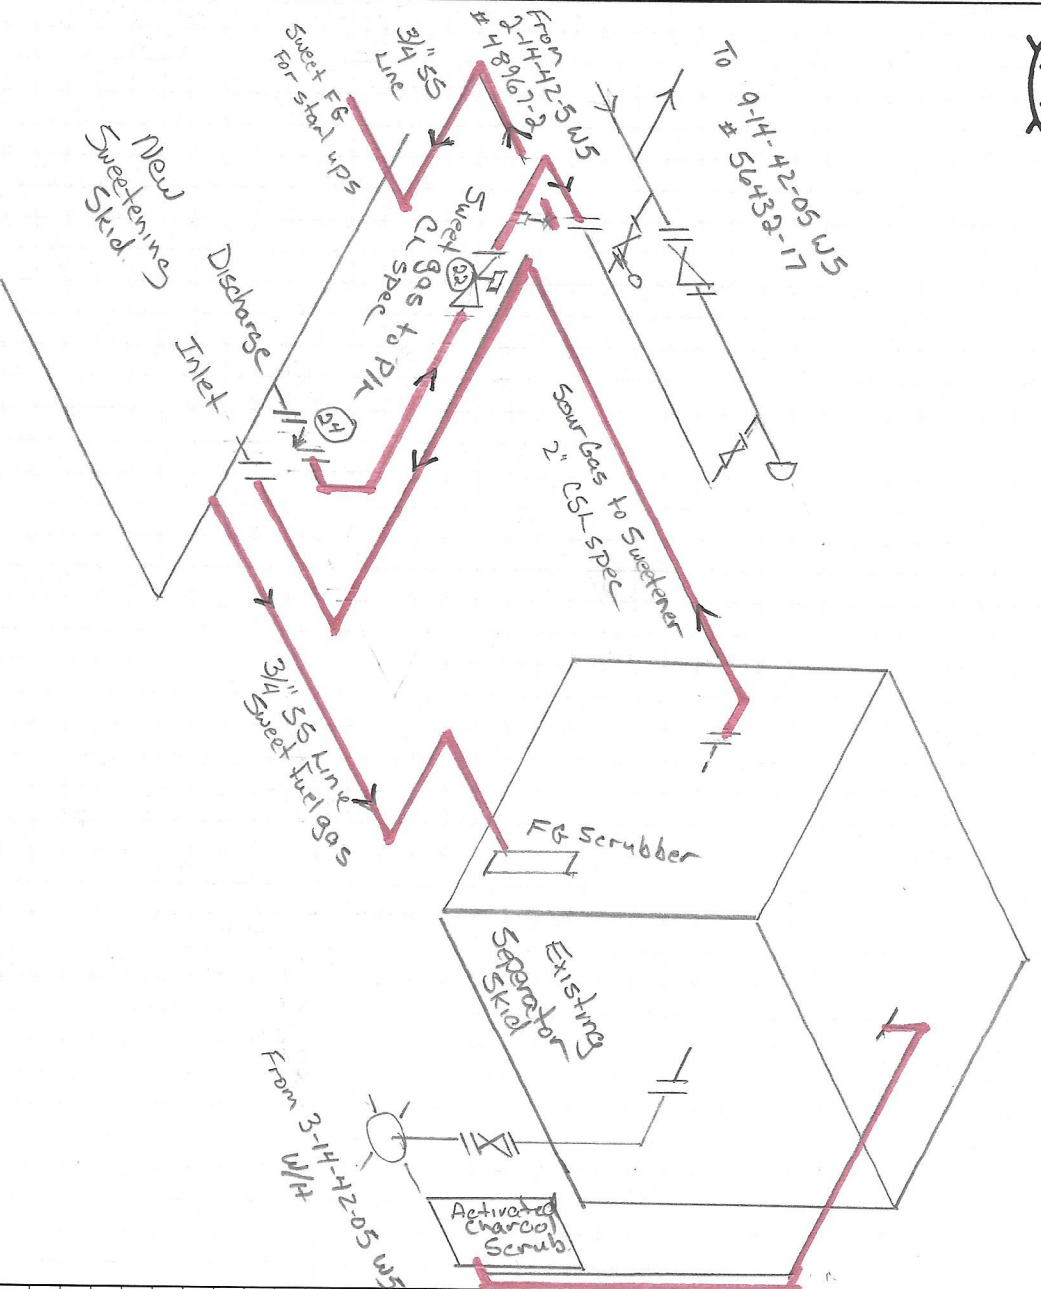

BILL OF MATERIAL

PIPE A-106B ☐ A-333 ☐ CSA ☐

ITEM QTY.	SIZE	SCH.	DESCRIPTION	HT #
1				
2				
3				
4				
5				

FLANGES A-105N ☐ A-350 LF2 ☐ CSA ☐

ITEM QTY.	SIZE	RATING	SCH.	DESCRIPTION	HT #
6					
7					
8					
9					
10					
11					

FITTINGS WPB ☐ WPL6 ☐ A-105N ☐ A-350 LF2 ☐ CSA ☐

ITEM QTY.	SIZE	SCH.	DESCRIPTION	HT #
12				
13				
14				
15				
16				
17				
18				
19				
20				
21				

VALVES

ITEM QTY.	SIZE	RATING	DESCRIPTION	TAG #
22	1"	900	ESD - Hydraulic actuated Fail closed.	
23				
24	1"	600	Check Valve	
25				
26				

MISCELLANEOUS

ITEM QTY.	DESCRIPTION
27	
28	
29	
30	
31	

PIPE CLASS: **CSL + CL**

DESIGN CODE: B31.3 ☒ CSA Z662 ☐

DESIGN PRESS: ☐

DESIGN TEMP: ☐

WELD PROCEDURE: ☐

WPW - ☐

EXTERNAL PRIME: ☐

TEST MED: ☐

EXTERNAL PAINT: ☐

RADIOGRAPHY: ☐

PMHT: ☐

INSUL: ☐

HYDRO TEST PRESS: ☐

TEST REPORT #:

ABSOLUTE REQ. #

3550.2

AQP #

2307

CLIENT: 13 Energy Canada Ltd

LOCATION: 3-14-42-05 WS

DESCRIPTION: Sweetening skid install

Red line Drwg.

WPW JOB #

DWG. NO.: