


THE CONTENTS OF THIS DRAWING ARE CONFIDENTIAL AND MAY NOT BE REPRODUCED WITHOUT WRITTEN PERMISSION

PROPERTY OF CAPE MANUFACTURING LTD.



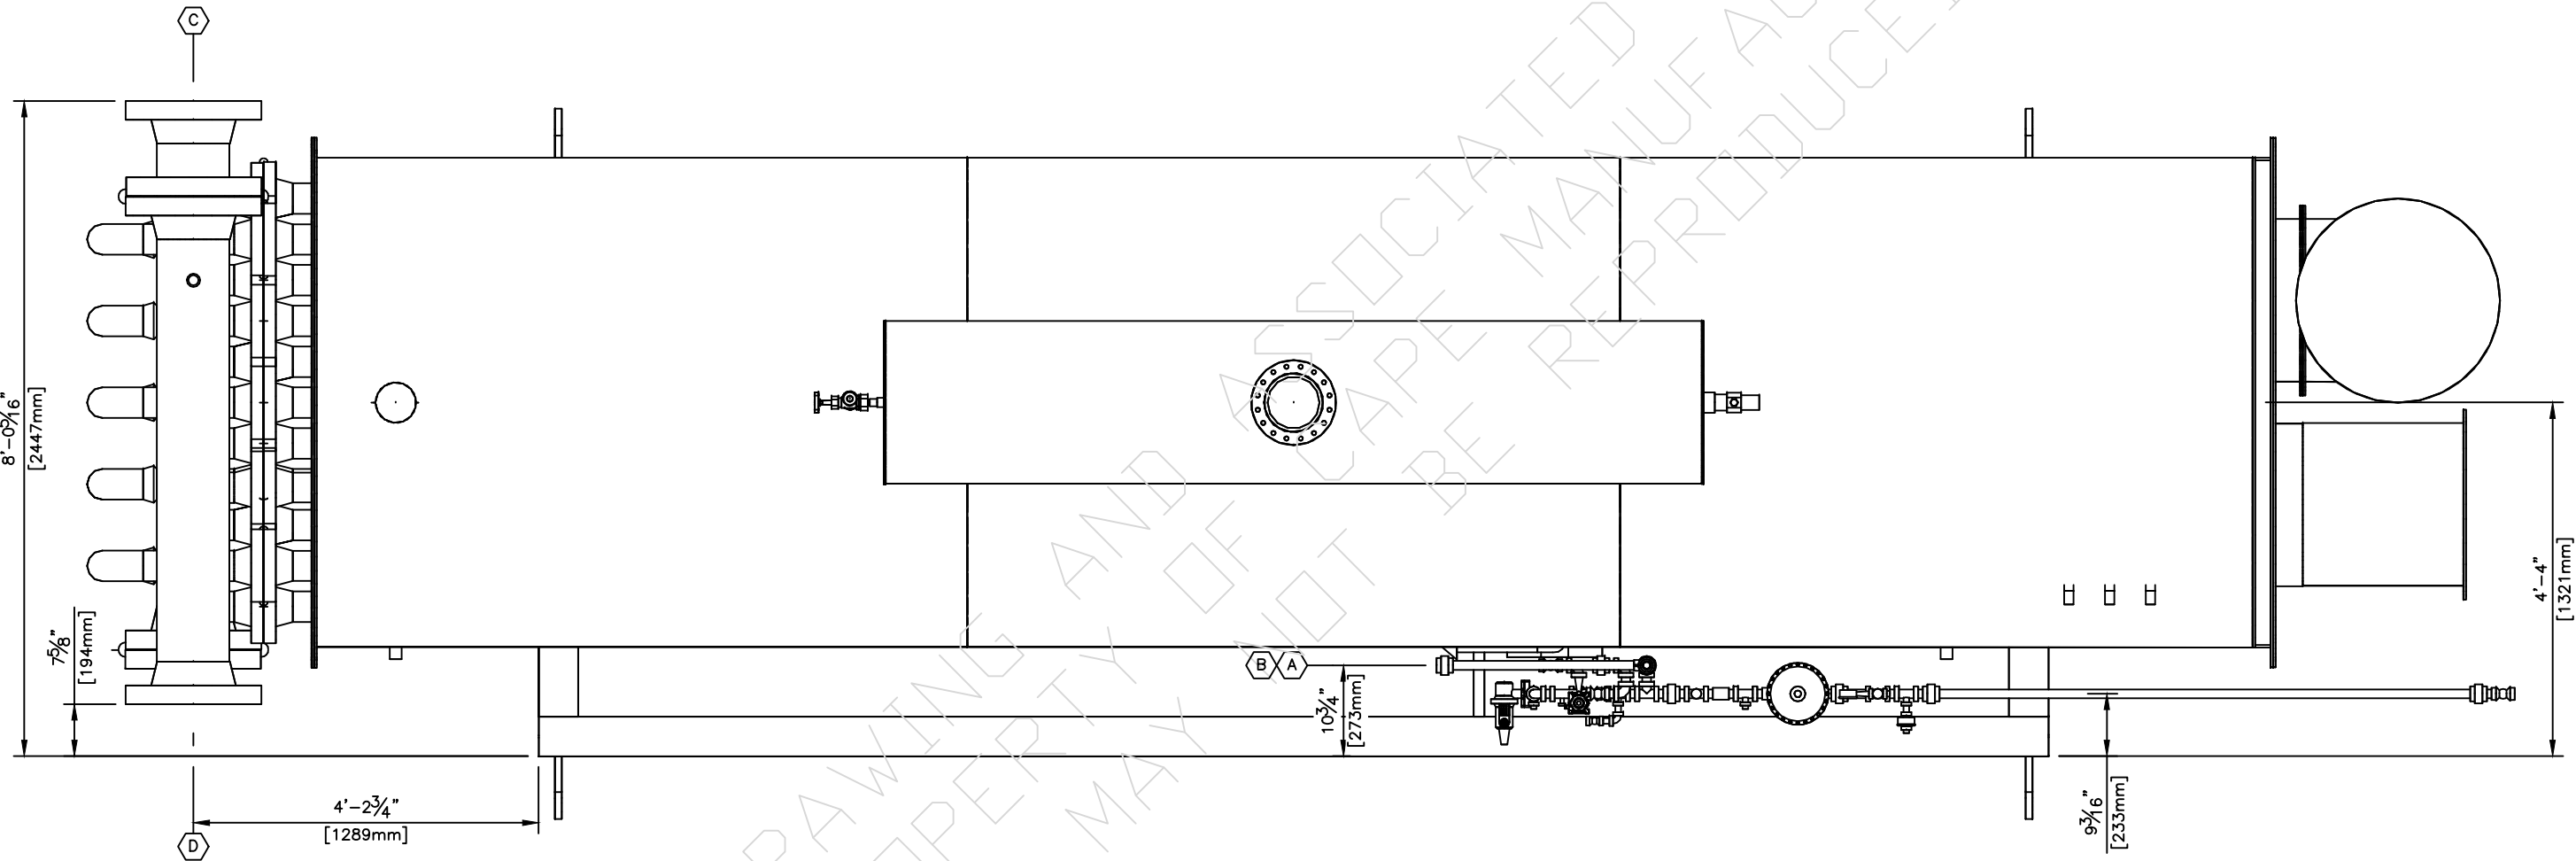

PLAN VIEW
SCALE: 1:25

SHIPPING DIMENSIONS

LENGTH: 33'-0" (10,058mm)
WIDTH: 8'-10" (2692mm)
HEIGHT: 11'-6" (3505mm)
APPROX. WEIGHT: 33,500LBS (15,195kgs)

TAG	TAG DESCRIPTION	CONNECTION SIZE	ELEVATION FBOS		PROJECTION	
A	INSTRUMENT AIR	1"-NPT 3000#	58 3/4"	1492mm	5 1/4"	133mm
B	FUEL GAS	1"-NPT 3000#	53"	1346mm	5 1/4"	133mm
C	PROCESS INLET	10"-600CL RFWN	46 5/8"	1184mm		
D	PROCESS OUTLET	10"-600CL RFWN	102 3/4"	2610mm		
PIPING MAY NOT BE EXACTLY AS SHOWN						

1	17-09-18	AS BUILT	KG	
0	17-06-05	ISSUED FOR CONSTRUCTION	KG	JB
NO.	DATE	REVISION	BY	APP
<div><div></div><div>CAPE MANUFACTURING LTD. PO BOX# 216 HALKIRK, AB T0C 1M0 TELEPHONE: (403) 884-2442</div><div></div></div>				
CLIENT: BIRCHILL CANADA LTD. PARTNERSHIP c/o: OEL PROJECTS LTD.				
LSD:	11-13-43-13 W5M	<div>72" OD LINE HEATER 72" OD x 24'-0" F/F, 2.5MMBTU 24 PASSES OF 4"-600CL RF</div>		
DATE:	17-04-12			
JOB NO.:	CML-170649			
SCALE:	SEE DWG.			
DRAWN BY:	KG			
CHECKED BY:	DH	DWG NO.:	CML-170649PLAN	
SHEET 1 OF 2				REV. 1