


10/05/2004

AS BUILT

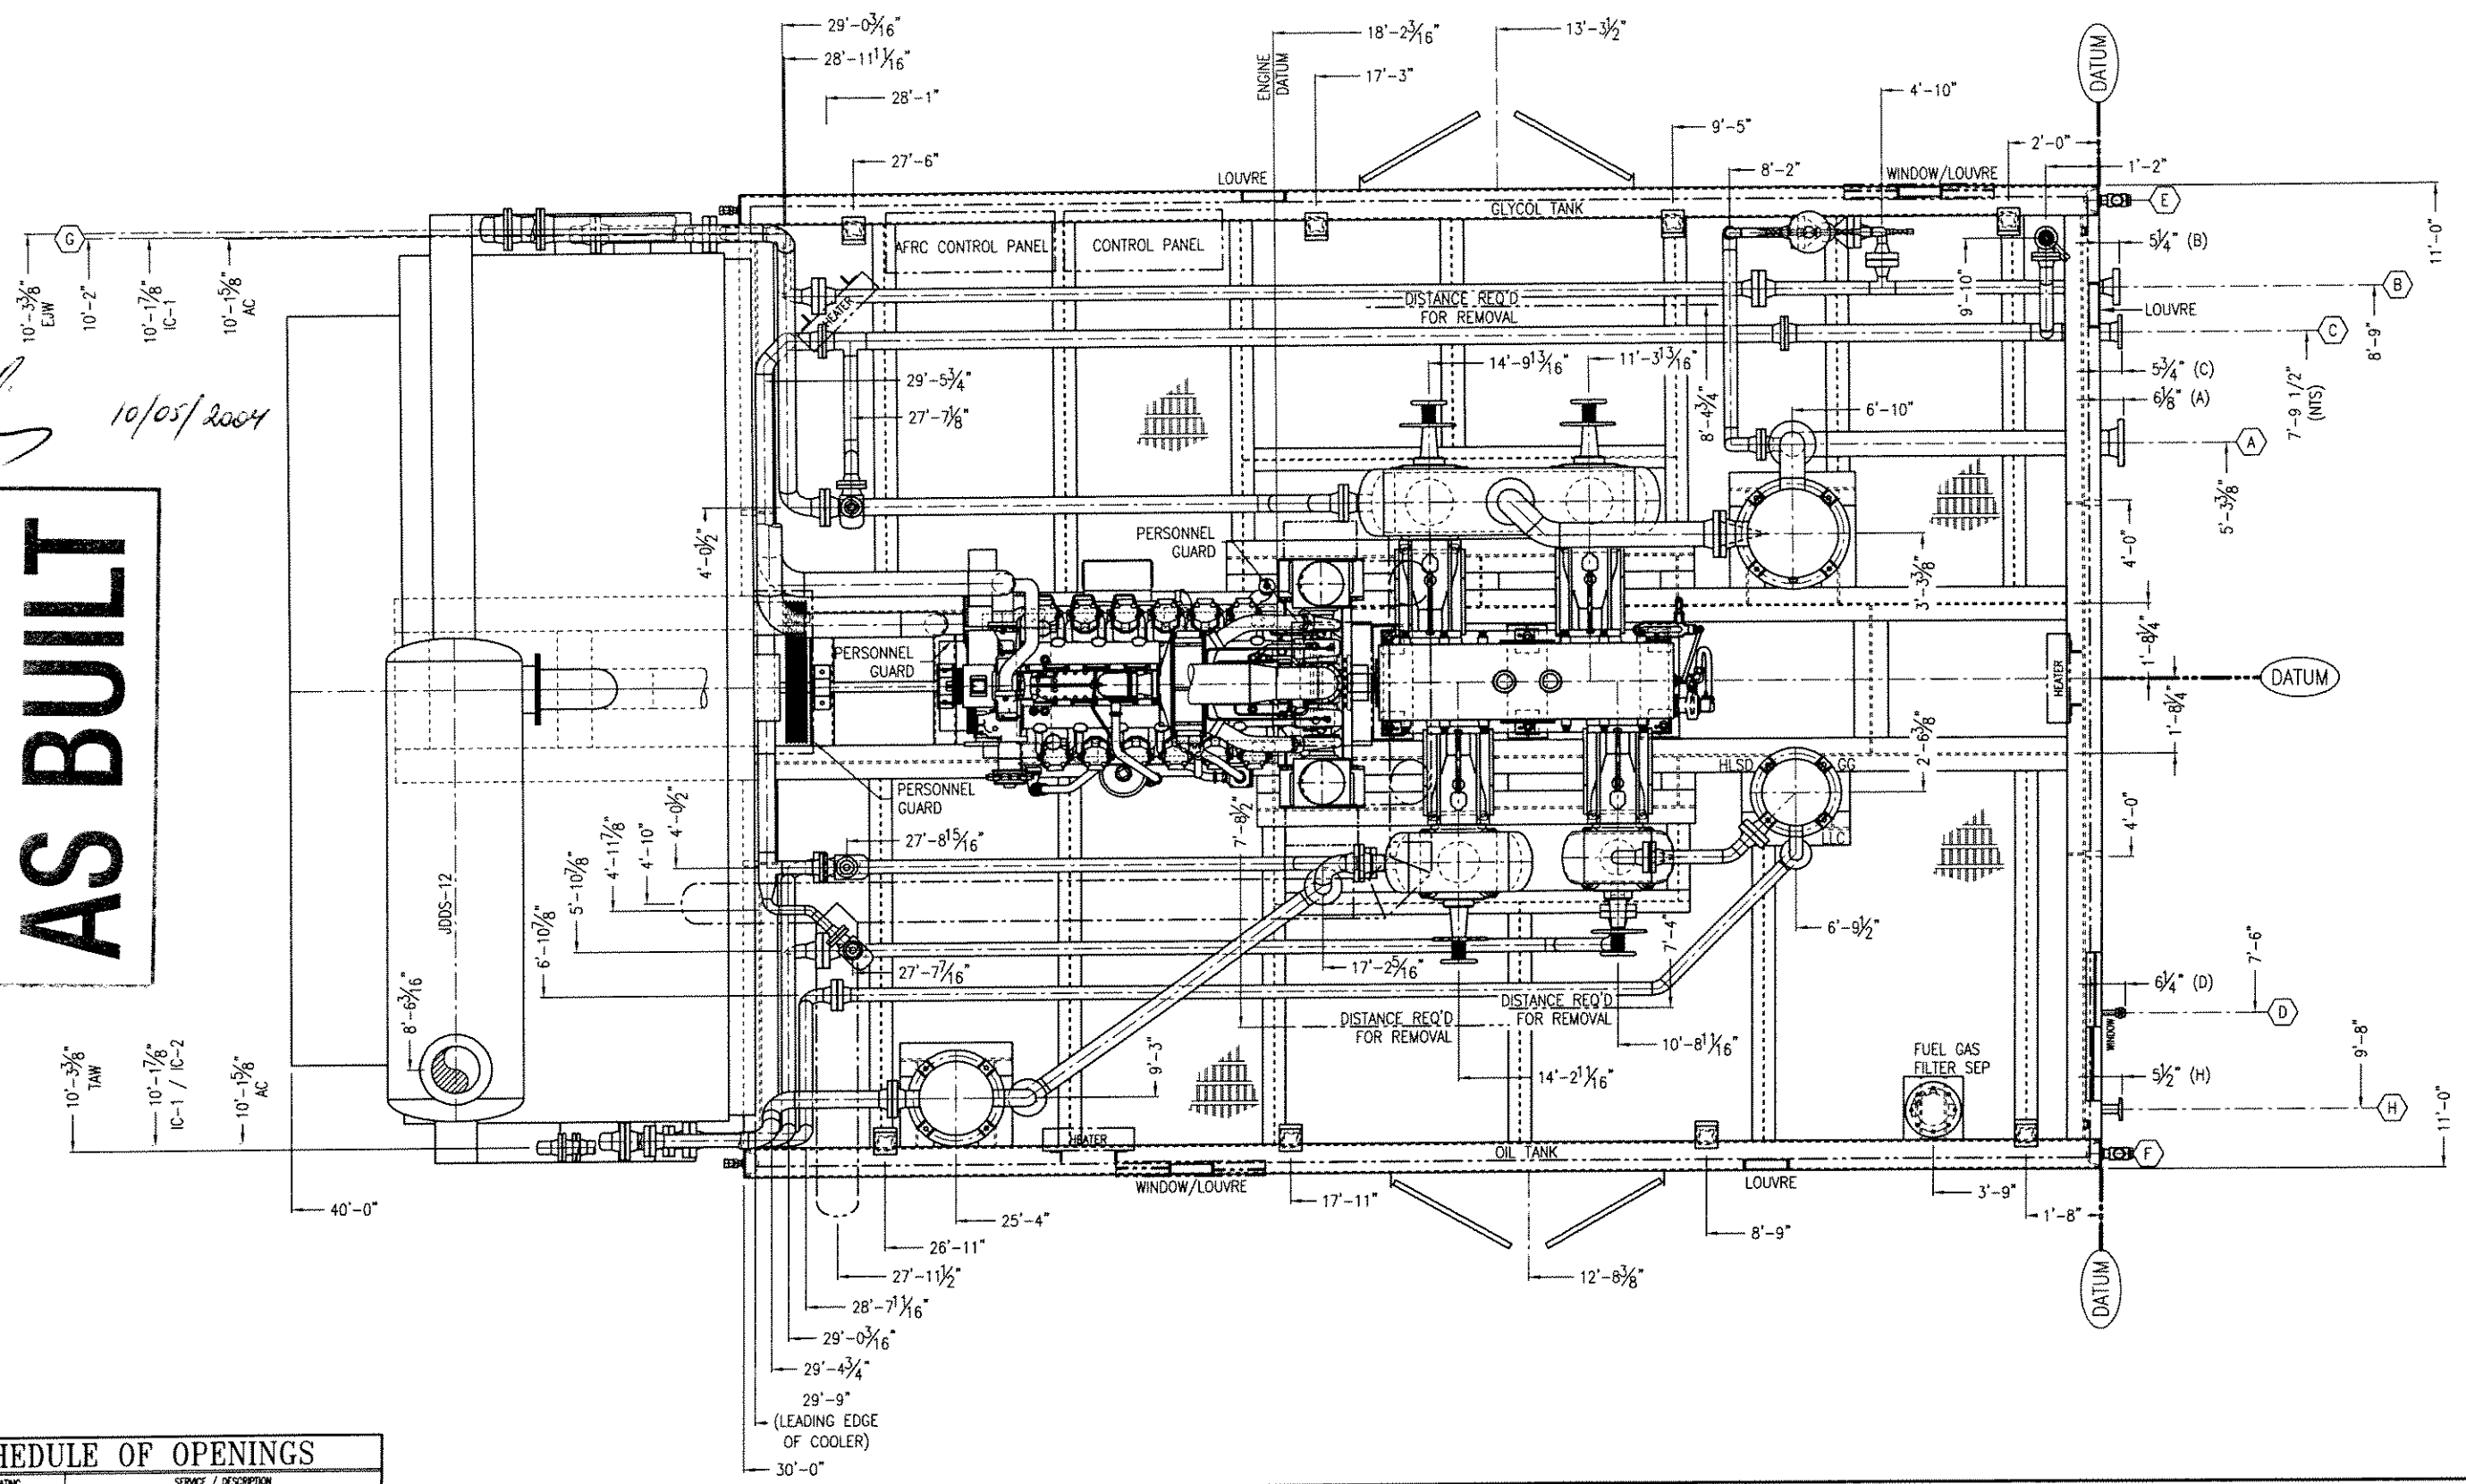

SCHEDULE OF OPENINGS		
TAG	SIZE & RATING	SERVICE / DESCRIPTION
A	6" - 300#RF	SUCTION INLET
B	3" - 900#RF	DISCHARGE OUTLET
C	4" - 150#RF	FLARE HEADER OUTLET
D	1" NPT	FUEL GAS DRAIN HEADER
E	2" NPT	GLYCOL TANK PUMPOUT
F	2" NPT	OIL TANK PUMPOUT
G	3" MITRED	ENGINE STARTER OUTLET
H	2" - 150#RF THRD	ENGINE FUEL / START GAS SUPPLY
J		
K		
L		
M		

TOTAL PACKAGE WEIGHT = APPROX 158,000 lbs
 TOTAL PACKAGE LENGTH = 40'-0"
 TOTAL PACKAGE WIDTH (incl. Eaves) = APPROX 22'-6"
 TOTAL PACKAGE HEIGHT = APPROX 17'-10"

THIS DRAWING IS SOLE PROPERTY OF BIDEILL EQUIPMENT INC. AND SHALL NOT BE REPRODUCED, COPIED, LENT, ALTERED NOR USED FOR ANY PURPOSE OTHER THAN WHICH IT IS FURNISHED EXCEPT WITH THE WRITTEN PERMISSION OF BIDEILL EQUIPMENT INC.

REV	DATE	BY	APPR	DESCRIPTION
D	04-05-10	BK	VK	AS BUILT
C	04-04-15	BK	VK	MODIFIED FUEL GAS PSV
B	04-04-13	JB	VK	ADDED FUEL GAS PSV
A	04-03-17	JB	VK	ISSUED FOR CONSTRUCTION
O	04-03-06	JB	VK	ISSUED FOR APPROVAL

DRAWN JB		GENERAL ASSEMBLY - PLAN VIEW FOR: CATERPILLAR G3512AFRC / ARIEL JGE-4 / AIR-X 132EF	
DATE 04-01-17			
SCALE 3/8" = 1'-0"		CHK'D	
		CUSTOMER: INNOVA ENERGY LTD c/o MILLENA CONSULTING PROJECT: ARMADA 16-19 W4M SHOP ORDER: 04-266 DWG NO: 04-266-2A REVISION: D	
6900 - 112th AVENUE S.E. CALGARY, AB T2C 4Z1		PHONE: (403) 235-5877 FAX: (403) 272-7749	