


THIS DRAWING IS THE PROPERTY OF VAN HAWK OILFIELD MFG. AND MAY NOT BE REPRODUCED WITH OUT THEIR WRITTEN CONSENT

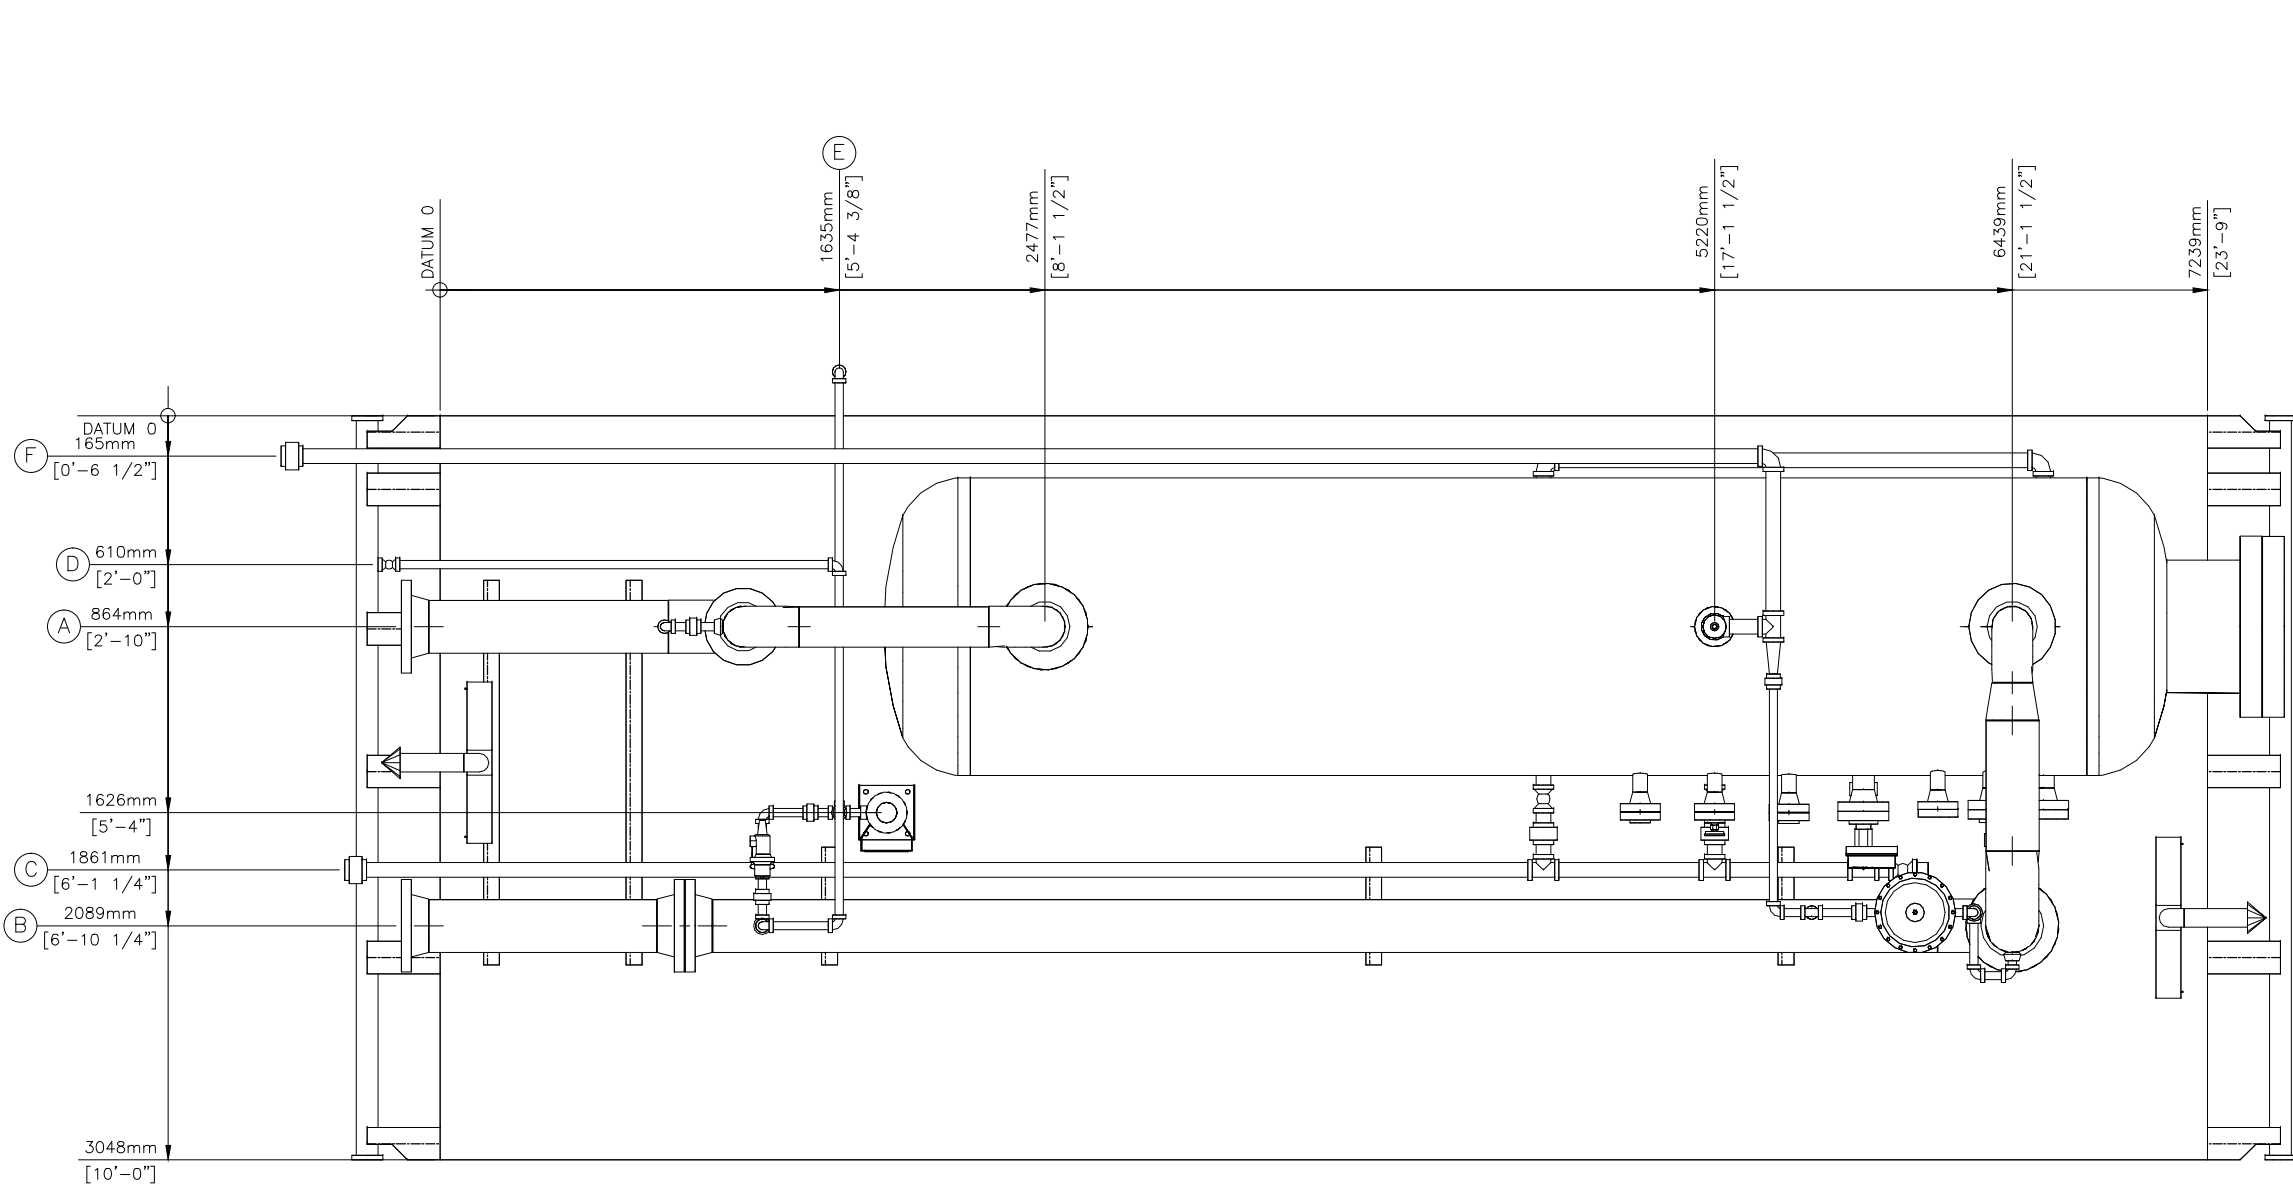

SHIPPING DIMENSIONS:
-10'-9"(3277mm) WIDE
-27'-2"(8280mm) LONG
-10'-4"(3149mm) HIGH

PLAN VIEW
SCALE 1:30

CUSTOMER CONNECTIONS				
ITEM	DESCRIPTION	SIZE	ELEVATION	PROJ.
A	EMULSION INLET	8"-300 CL RFWN	364 FTOS	159
B	GAS OUTLET	8"-300 CL RFWN	364 FTOS	159
C	LIQUID OUTLET	2"-NPT	284 FTOS	391
D	FUEL GAS INLET	1"-NPT	1041 FTOS	254
E	SCRUBBER PSV OUTLET	1"-NPT	775 FTOS	152
F	PSV OUTLET	2"-NPT	2172 FTOS	651
NOTE: -ALL DIMENSIONS ARE IN MILLIMETERS UNLESS SHOWN OTHERWISE -PIPING MAY BE NOT EXACTLY AS SHOWN				

22-09-08	0	AS BUILT SURPLUS PACKAGE	WST	AV	AV
DATE	REV	DESCRIPTION	DWN	CHKD	APPVD

CLIENT		
LSD.		
HORIZONTAL SEPARATOR (48" x 15'-0" S/S) DRESSED 2 PHASE		
GENERAL ARRANGEMENT		
DATE: 2022-09-08	VAN HAWK OILFIELD PROJECT# A#506687	
SCALE: SEE DWG	DRAWING NO. A#506687-B-01	REV. 0
DRAWN BY: WST	CHECKED BY: AV	APPROVED BY: AV
SHEET 1 of 3		