
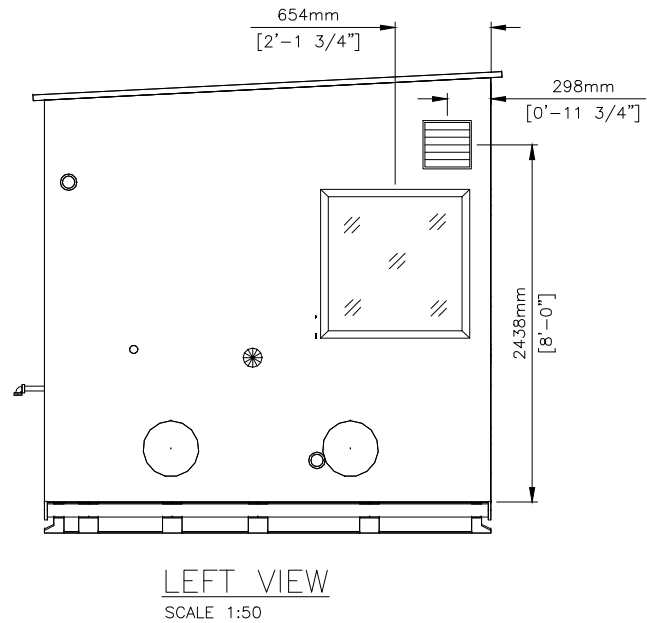
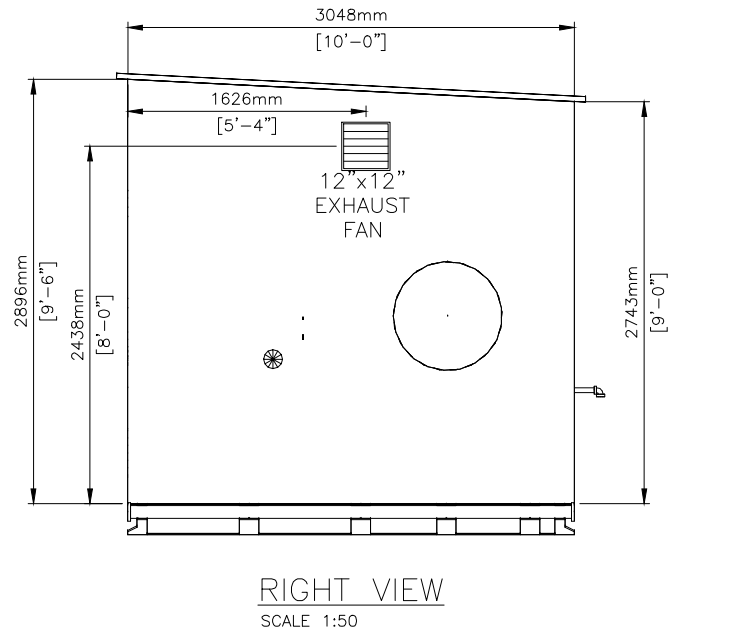
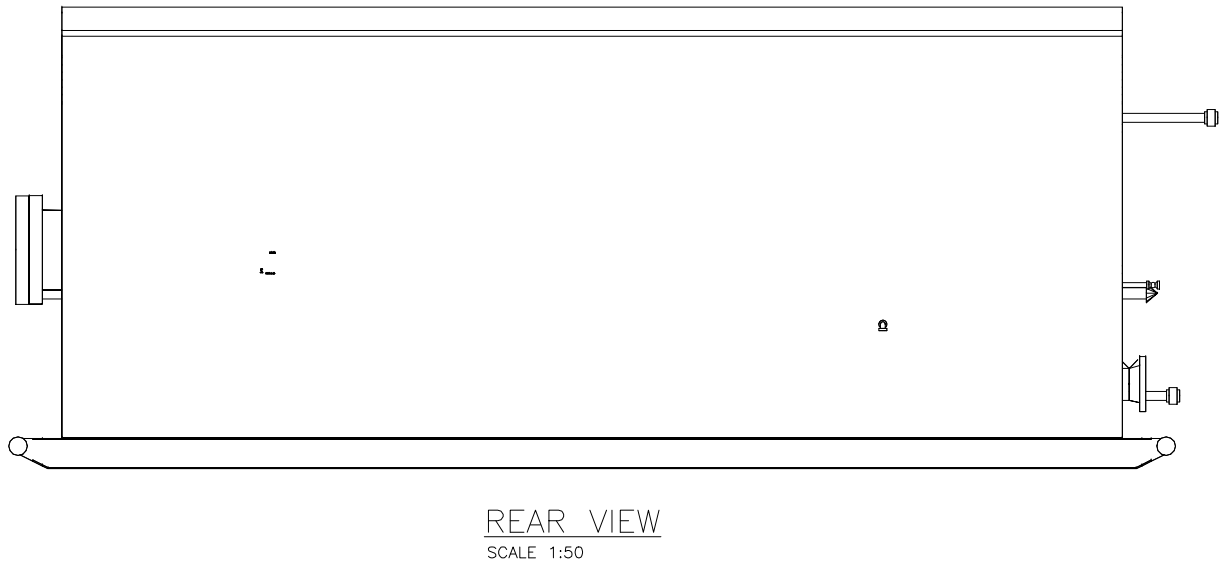


THIS DRAWING IS THE PROPERTY OF VAN HAWK OILFIELD MFG. AND MAY NOT BE REPRODUCED WITH OUT THEIR WRITTEN CONSENT

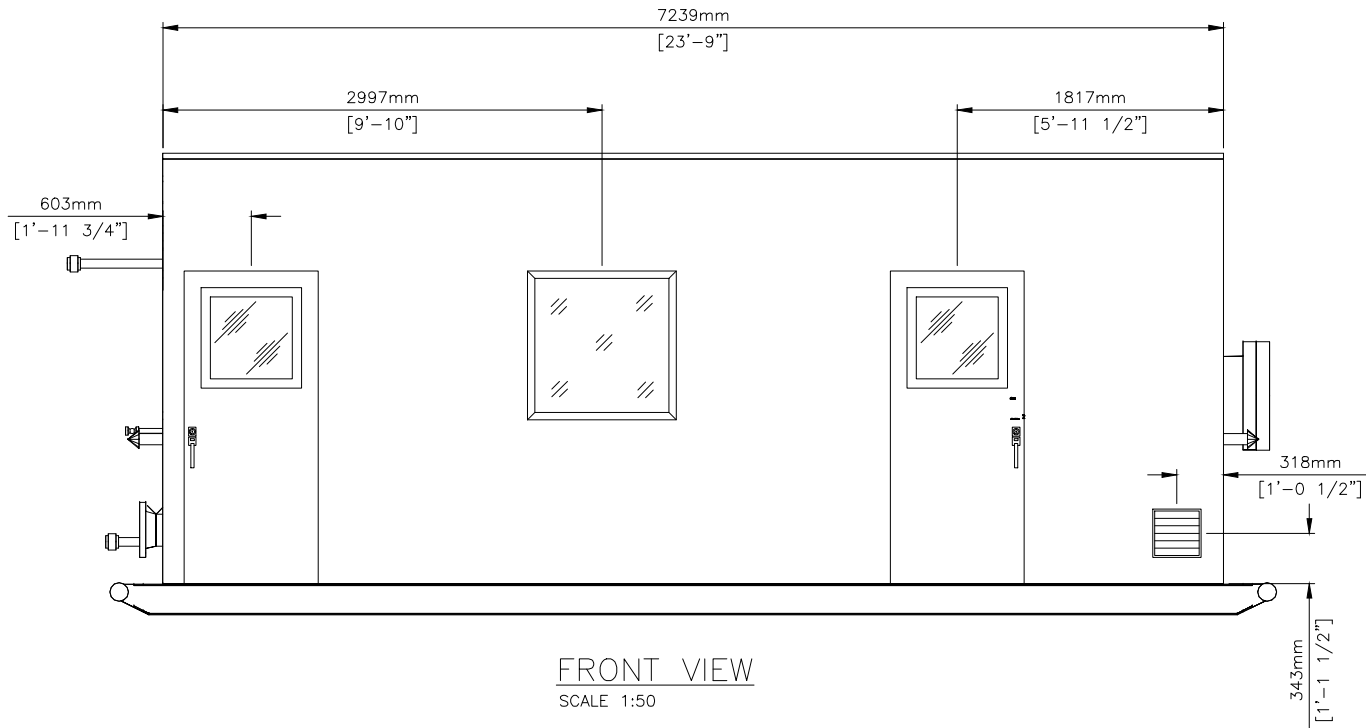

QTY	SKID, BUILDING & PAINT DESCRIPTION
	BUILDING 10'-0" WIDE x 23'-9", SHED STYLE BUILDING
	BUILDING PANELS FOAM PANEL
	EAVES 9'-6" x 9'-0"
	INTERIOR COLOR 26 GAUGE PANELS, GALVALUME
	EXTERIOR COLOR 26 GAUGE PANELS, GALVALUME
	INSULATION POLYURETHANE; R12
2	DOORS 3'x7", w/GPW WINDOW & DRIP CAP
2	PANIC BAR PANIC HARDWARE, RETAINER & CHECK CHAIN
1	WINDOW 36" x 36" SLIDING w/SCREEN
2	VENT 12" x 12" SLIDING VENTS w/SCREENS
	SKID 10'-0" WIDE x 26'-0" LONG
	MATERIAL W8x18 MAIN RAILS & W8x18 CROSS MEMBERS
	FLOOR 3/16" CHECKERPLATE
	OPTIONS 12" x 12" EXHAUST FAN
	UNDER SKID INSULATION NONE
	SKID COLOR CLOVERDALE RUSTEX PRIMER & CLOVERDALE RUSTOLEUM #906 WARM GREY
	PIPING COLOR CLOVERDALE RUSTEX PRIMER & CLOVERDALE RUSTOLEUM #906 WARM GREY

DATE	REV	DESCRIPTION	DWN	CHKD	APPRD
22-09-08	0	AS BUILT SURPLUS PACKAGE	WST	AV	AV

CLIENT	
LSD.	
HORIZONTAL SEPARATOR (48" x 15'-0" S/S) DRESSED 2 PHASE	
BUILDING LAYOUT	
DATE: 2022-09-08	VAN HAWK OILFIELD PROJECT#
SCALE: SEE DWG	A#506687
DRAWN BY: WST	DRAWING NO.
CHECKED BY: AV	A#506687-E-01
APPROVED BY: AV	SHEET 1 of 1