


THIS DRAWING IS THE PROPERTY OF VAN HAWK OILFIELD MFG. AND MAY NOT BE REPRODUCED WITH OUT THEIR WRITTEN CONSENT

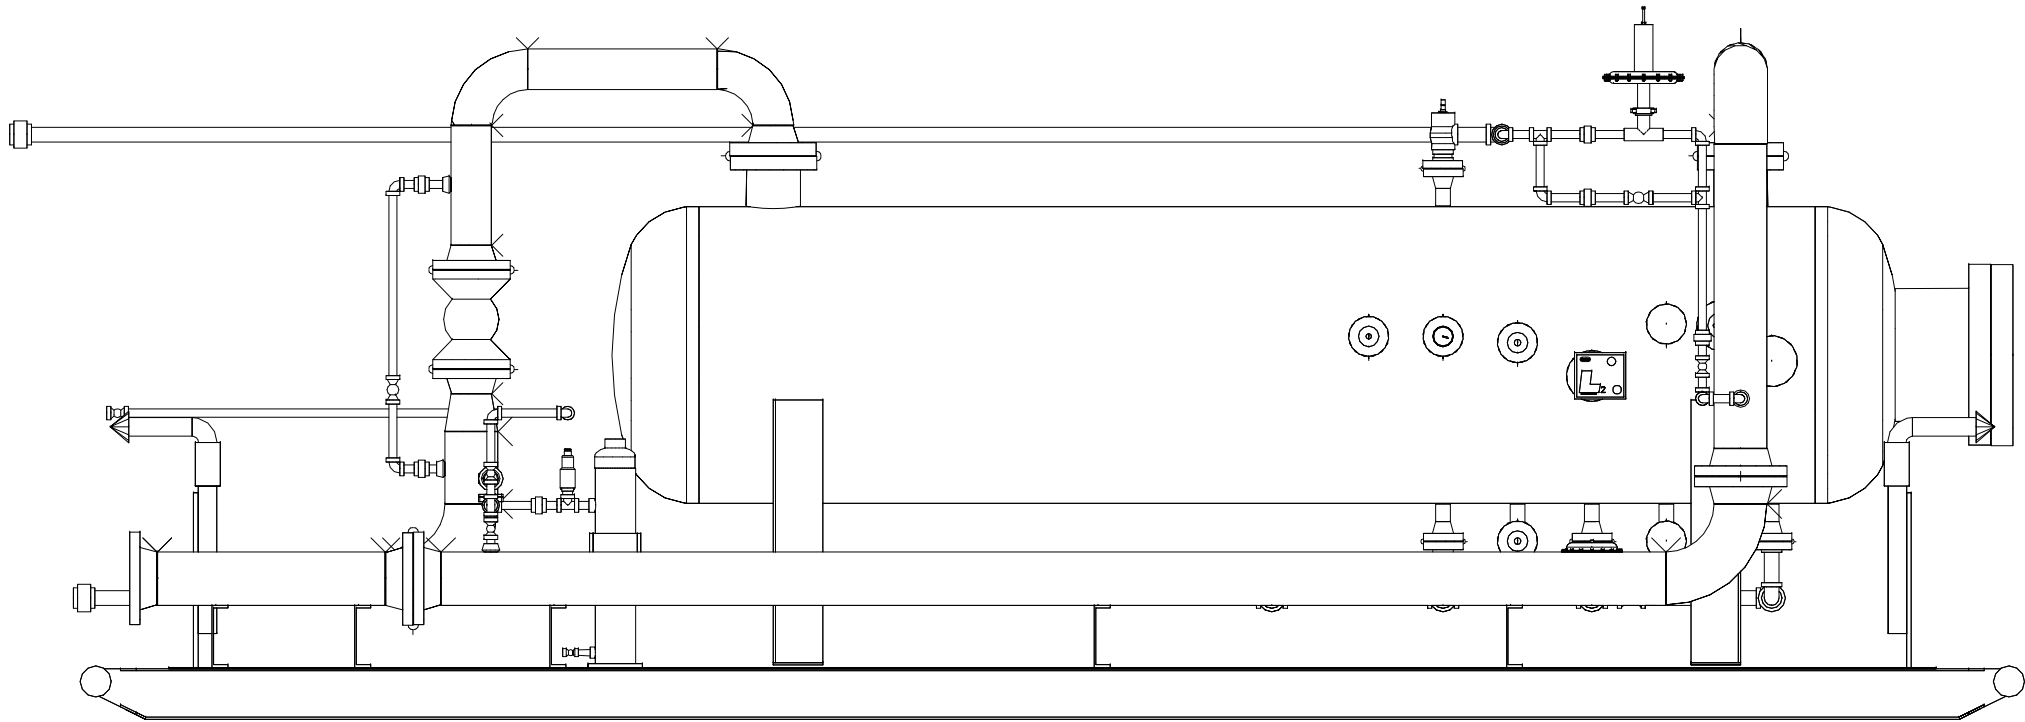

ELEVATION VIEW
SCALE 1:30

DATE	REV	DESCRIPTION	DWN	CHKD	APPVD
22-09-08	0	AS BUILT SURPLUS PACKAGE	WST	AV	AV

CLIENT		
LSD.		
HORIZONTAL SEPARATOR (48" x 15'-0" S/S) DRESSED 2 PHASE		
GENERAL ARRANGEMENT		
DATE: 2022-09-08	VAN HAWK OILFIELD PROJECT#	
SCALE: SEE DWG	A#506687	
DRAWN BY: WST	DRAWING NO.	REV.
CHECKED BY: AV	A#506687-B-02	0
APPROVED BY: AV	SHEET 2 of 3	