
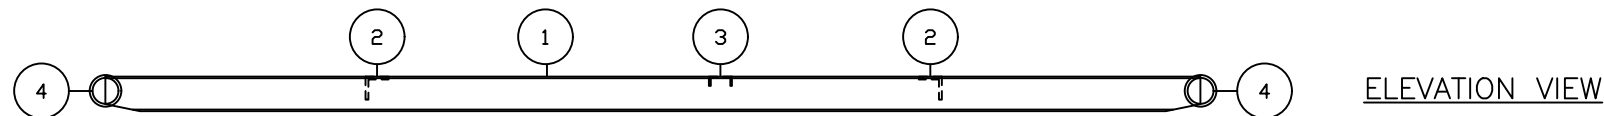
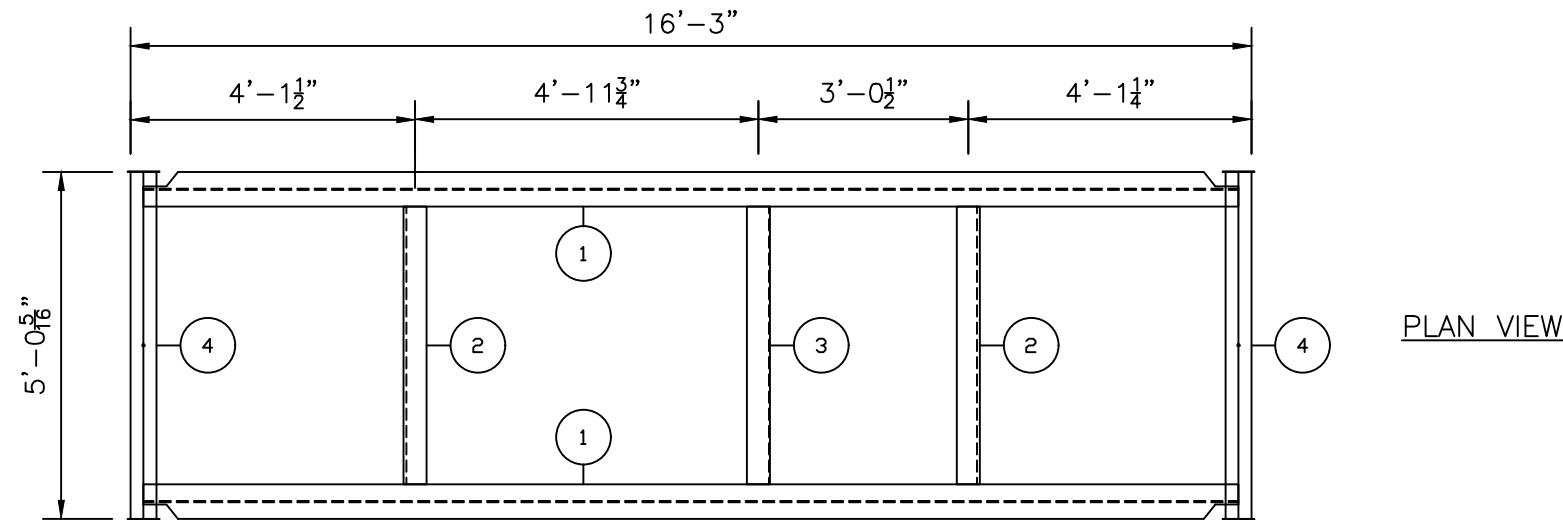
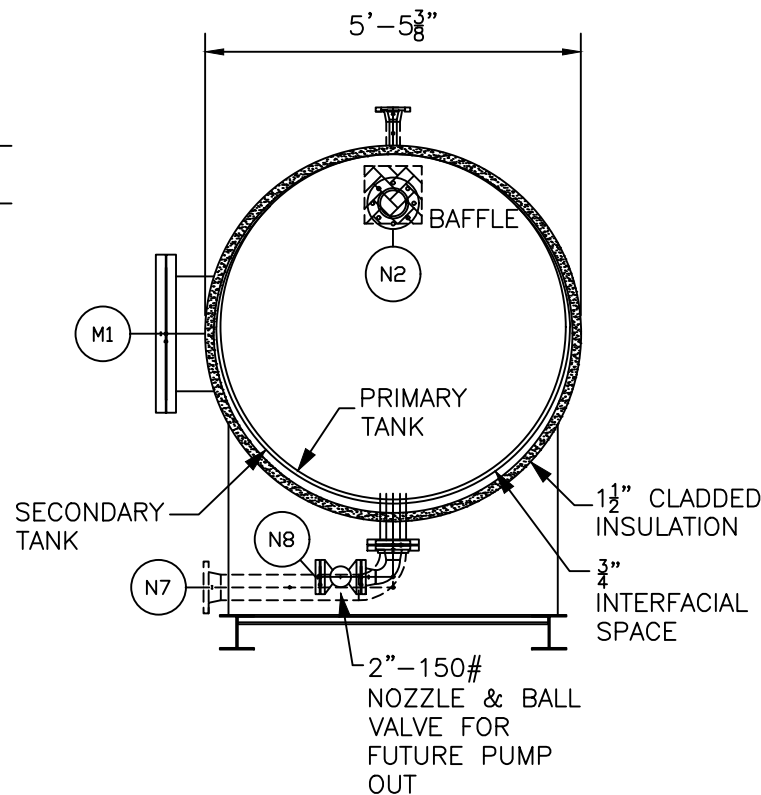


THIS DRAWING IS THE PROPERTY OF E & M OILFIELD SERVICES LTD. AND MAY NOT BE REPRODUCED WITHOUT THEIR WRITTEN CONSENT

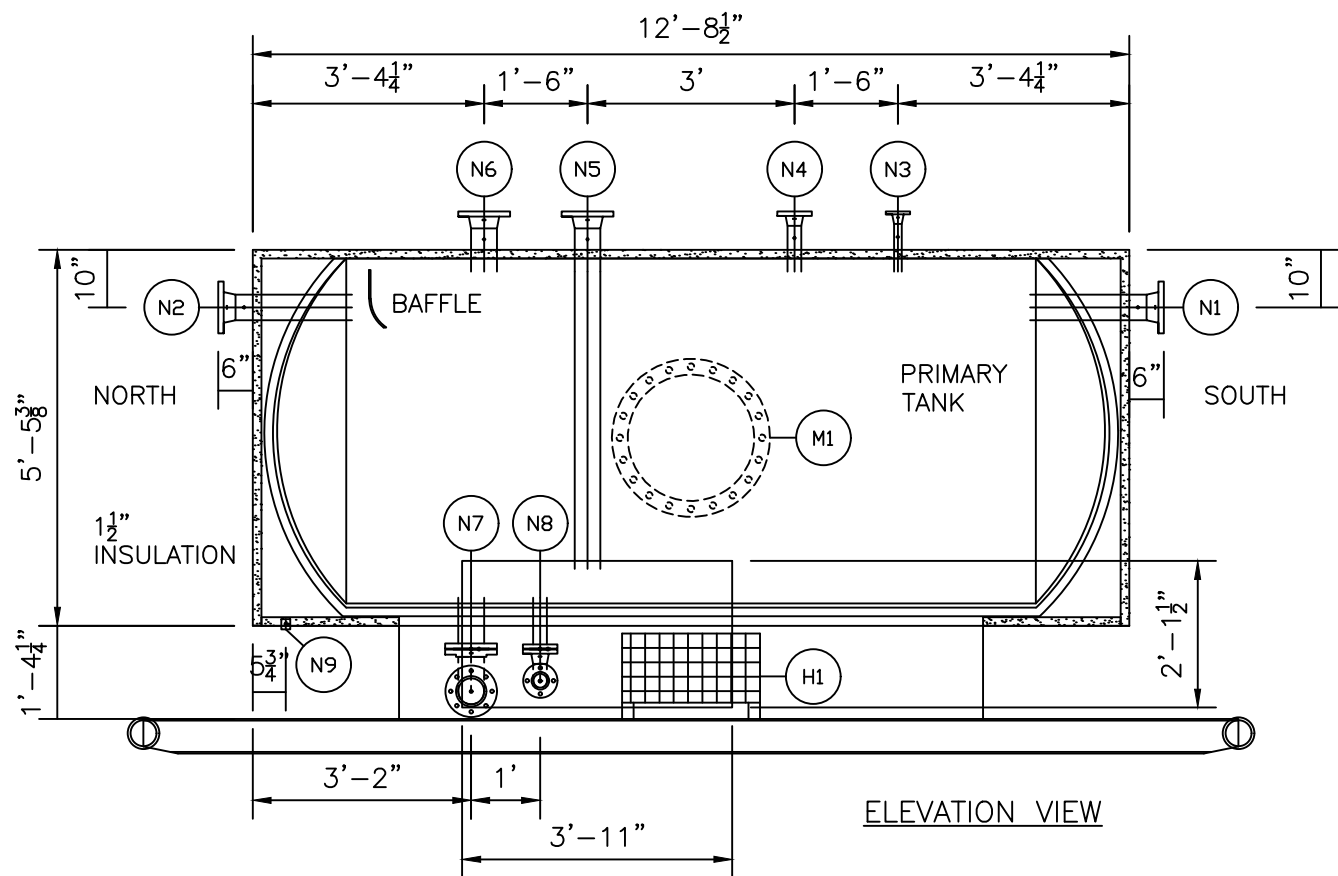

BILL OF MATERIAL

MARK	QTY	DESCRIPTION
1	2	W6x15 x 15'-10 1/2" LG.
2	2	ANGLE IRON 4" DIA x 4'-5 13/16" LG.
3	1	C4x5.4 x 4'-5 13/16" LG.
4	2	ROLLEND 4" PIPE x 5'-0 5/16" LG.
N1	1	INLET: 4"-150#
N2	1	OUTLET: 4"-150#
N3	1	PURGE GAS: 1"-150#
N4	1	SPARE: 2"-150#
N5	1	LEVEL GAUGE: 4"-150#
N6	1	SPARE: 4"-150#
N7	1	TRUCK OUT: 4"-150#
N8	1	PUMP OUT: 2"-150#
N9	1	DRAIN: 1" COLLAR
M1	1	MANWAY: 20" c/w COVER
H1	1	HEATER: 12'x24" CATADYNE

NOTE:

PRIMARY SHELL & CAPS 3/8" THK.
SECONDARY SHELL & CAPS 3/16" THK.
TANK: S/N#: KOTK-EG 175-10791
DIA: 5' ID, 10' S/S
WEIGHT: 6850 LBS

NO.	REVISION	BY	DATE
0	ISSUED FOR REVIEW AS-BUILT	JM	25-02-25
		EJ	EJ

E & M OILFIELD
SERVICES LTD.
Box 9019
SYLVAN LAKE, AB T4S 1S6
T> 403 887 4515
C> 403 588 4515
EMAIL: emoil@platinum.ca

	BY	DATE
DRAWN	JM	25-02-25
CHECKED	EJ	25-02-25
APPROVED	EJ	25-02-25
SCALE: 3/4"=1'-0"		

CUSTOMER:			FUELLED		
			DOUBLE WALLED FLARE KNOCK OUT		
			TANK: 42 BBL, ID 60" x 10' S/S		
			PLAN, ELEVATION VIEWS		
DWG NO.:			FUEL-0625-VIEWS		
			SH NO.:	1	REV NO. 0