
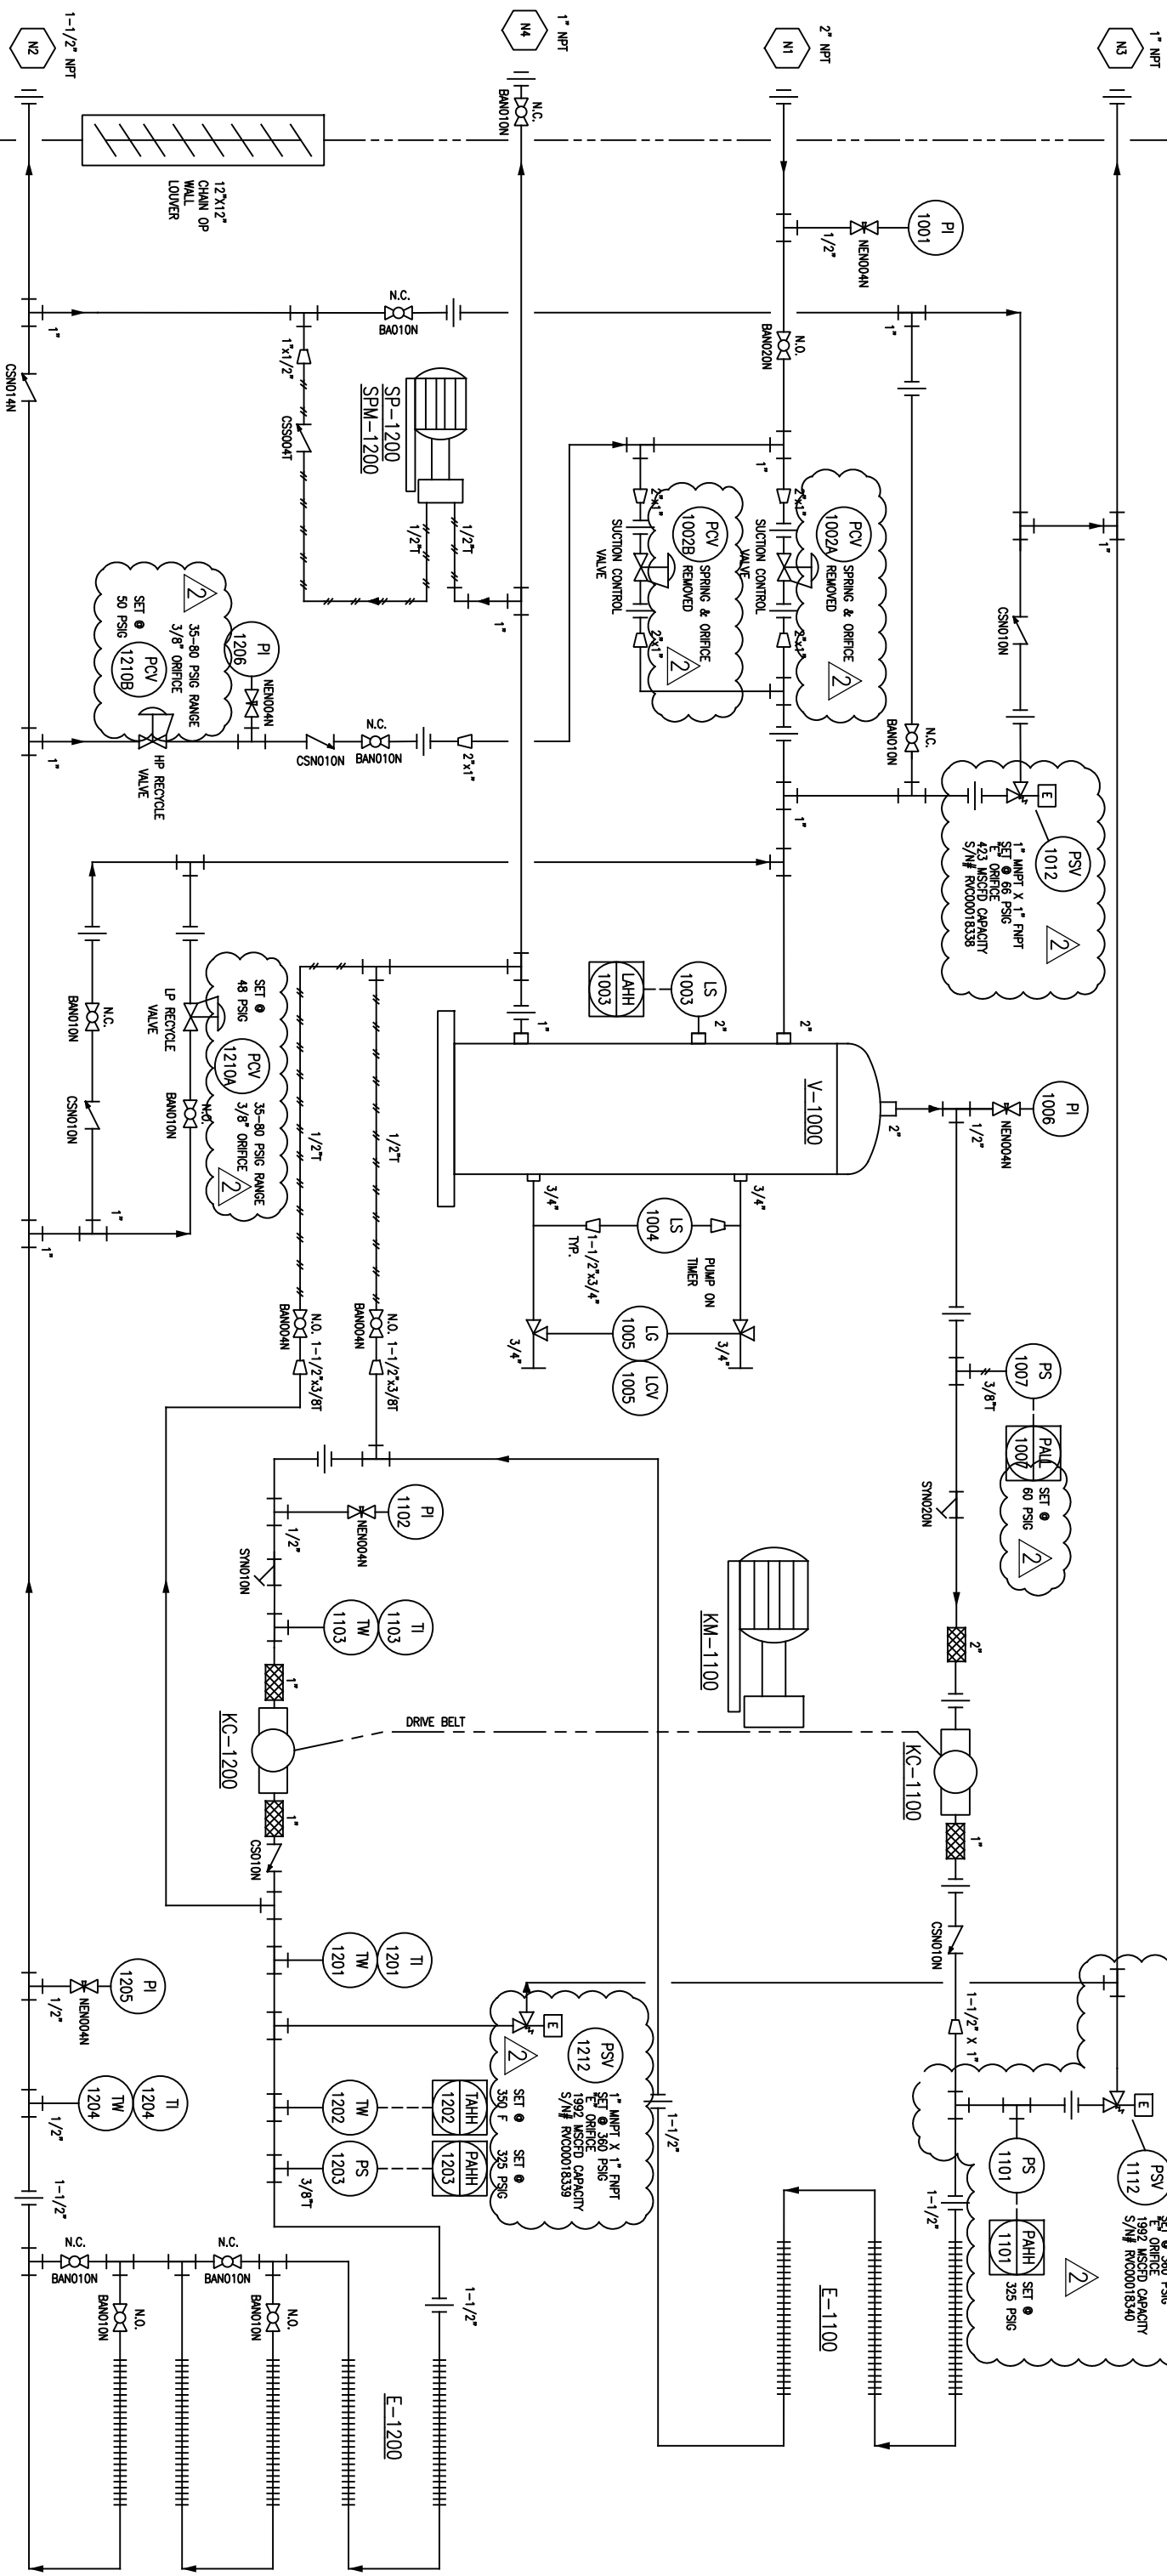


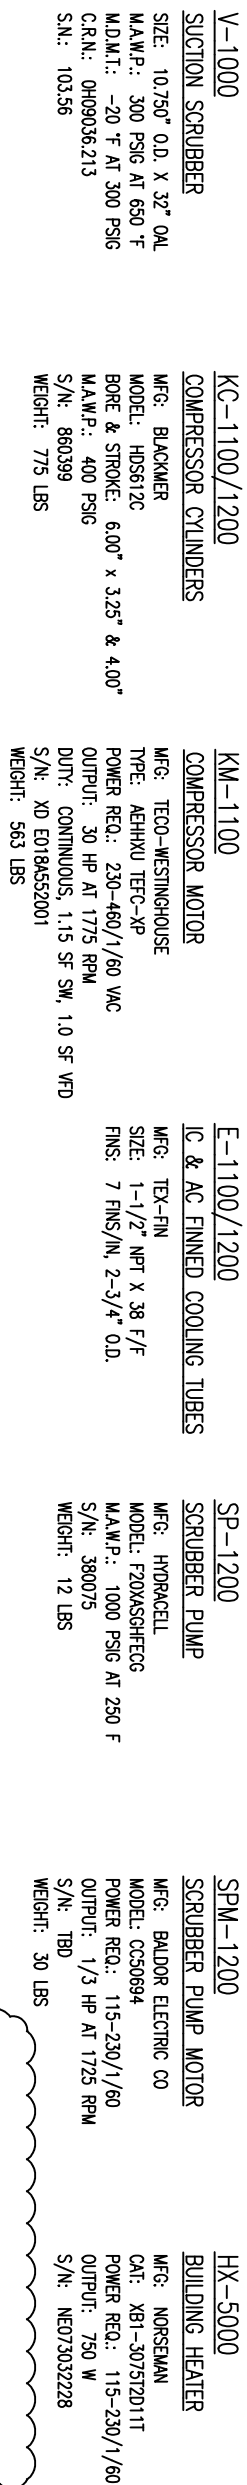

| CUSTOMER CONNECTIONS |                           |        |      |
|----------------------|---------------------------|--------|------|
| TAG                  | DESCRIPTION               | SIZE   | TYPE |
| N1                   | SUCTION                   | 2"     | NPT  |
| N2                   | DISCHARGE                 | 1-1/2" | NPT  |
| N3                   | HIGH PRESSURE VENT HEADER | 1"     | NPT  |
| N4                   | SCRUBBER DRAIN HEADER     | 1"     | NPT  |
| N5                   | -                         | -      | -    |
| N6                   | -                         | -      | -    |
| N7                   | -                         | -      | -    |

| REVISIONS |     |           |                                       |
|-----------|-----|-----------|---------------------------------------|
| NO.       | BY  | DATE      | DESCRIPTION                           |
| 1         | NB  | 24-JAN-23 | IFC: INTERSTAGE PRESSURE SWITCH & PSV |
| 0         | BB  | 14-MAR-18 | AS-BUILT FOR CUSTOMER                 |
| A         | ABW | 31-AUG-15 | FOR CONSTRUCTION                      |

|                      |           |                                   |                   |             |
|----------------------|-----------|-----------------------------------|-------------------|-------------|
| IRONLINE COMPRESSION |           |                                   |                   |             |
| DRAWN                | A.WILSON  | 30 HP ELECTRIC BLACKMER 612       |                   |             |
| DATE                 | 12-AUG-15 | PROCESS & INSTRUMENTATION DIAGRAM |                   |             |
| SCALE                | NTS       | Customer                          | DWG. NO.          | SHT. 1 OF 1 |
| CHK'D                | -         | IRONLINE                          |                   |             |
| APP'D                | -         | COMPRESSION                       | E30RB-112-PID-UID | REV 1       |