






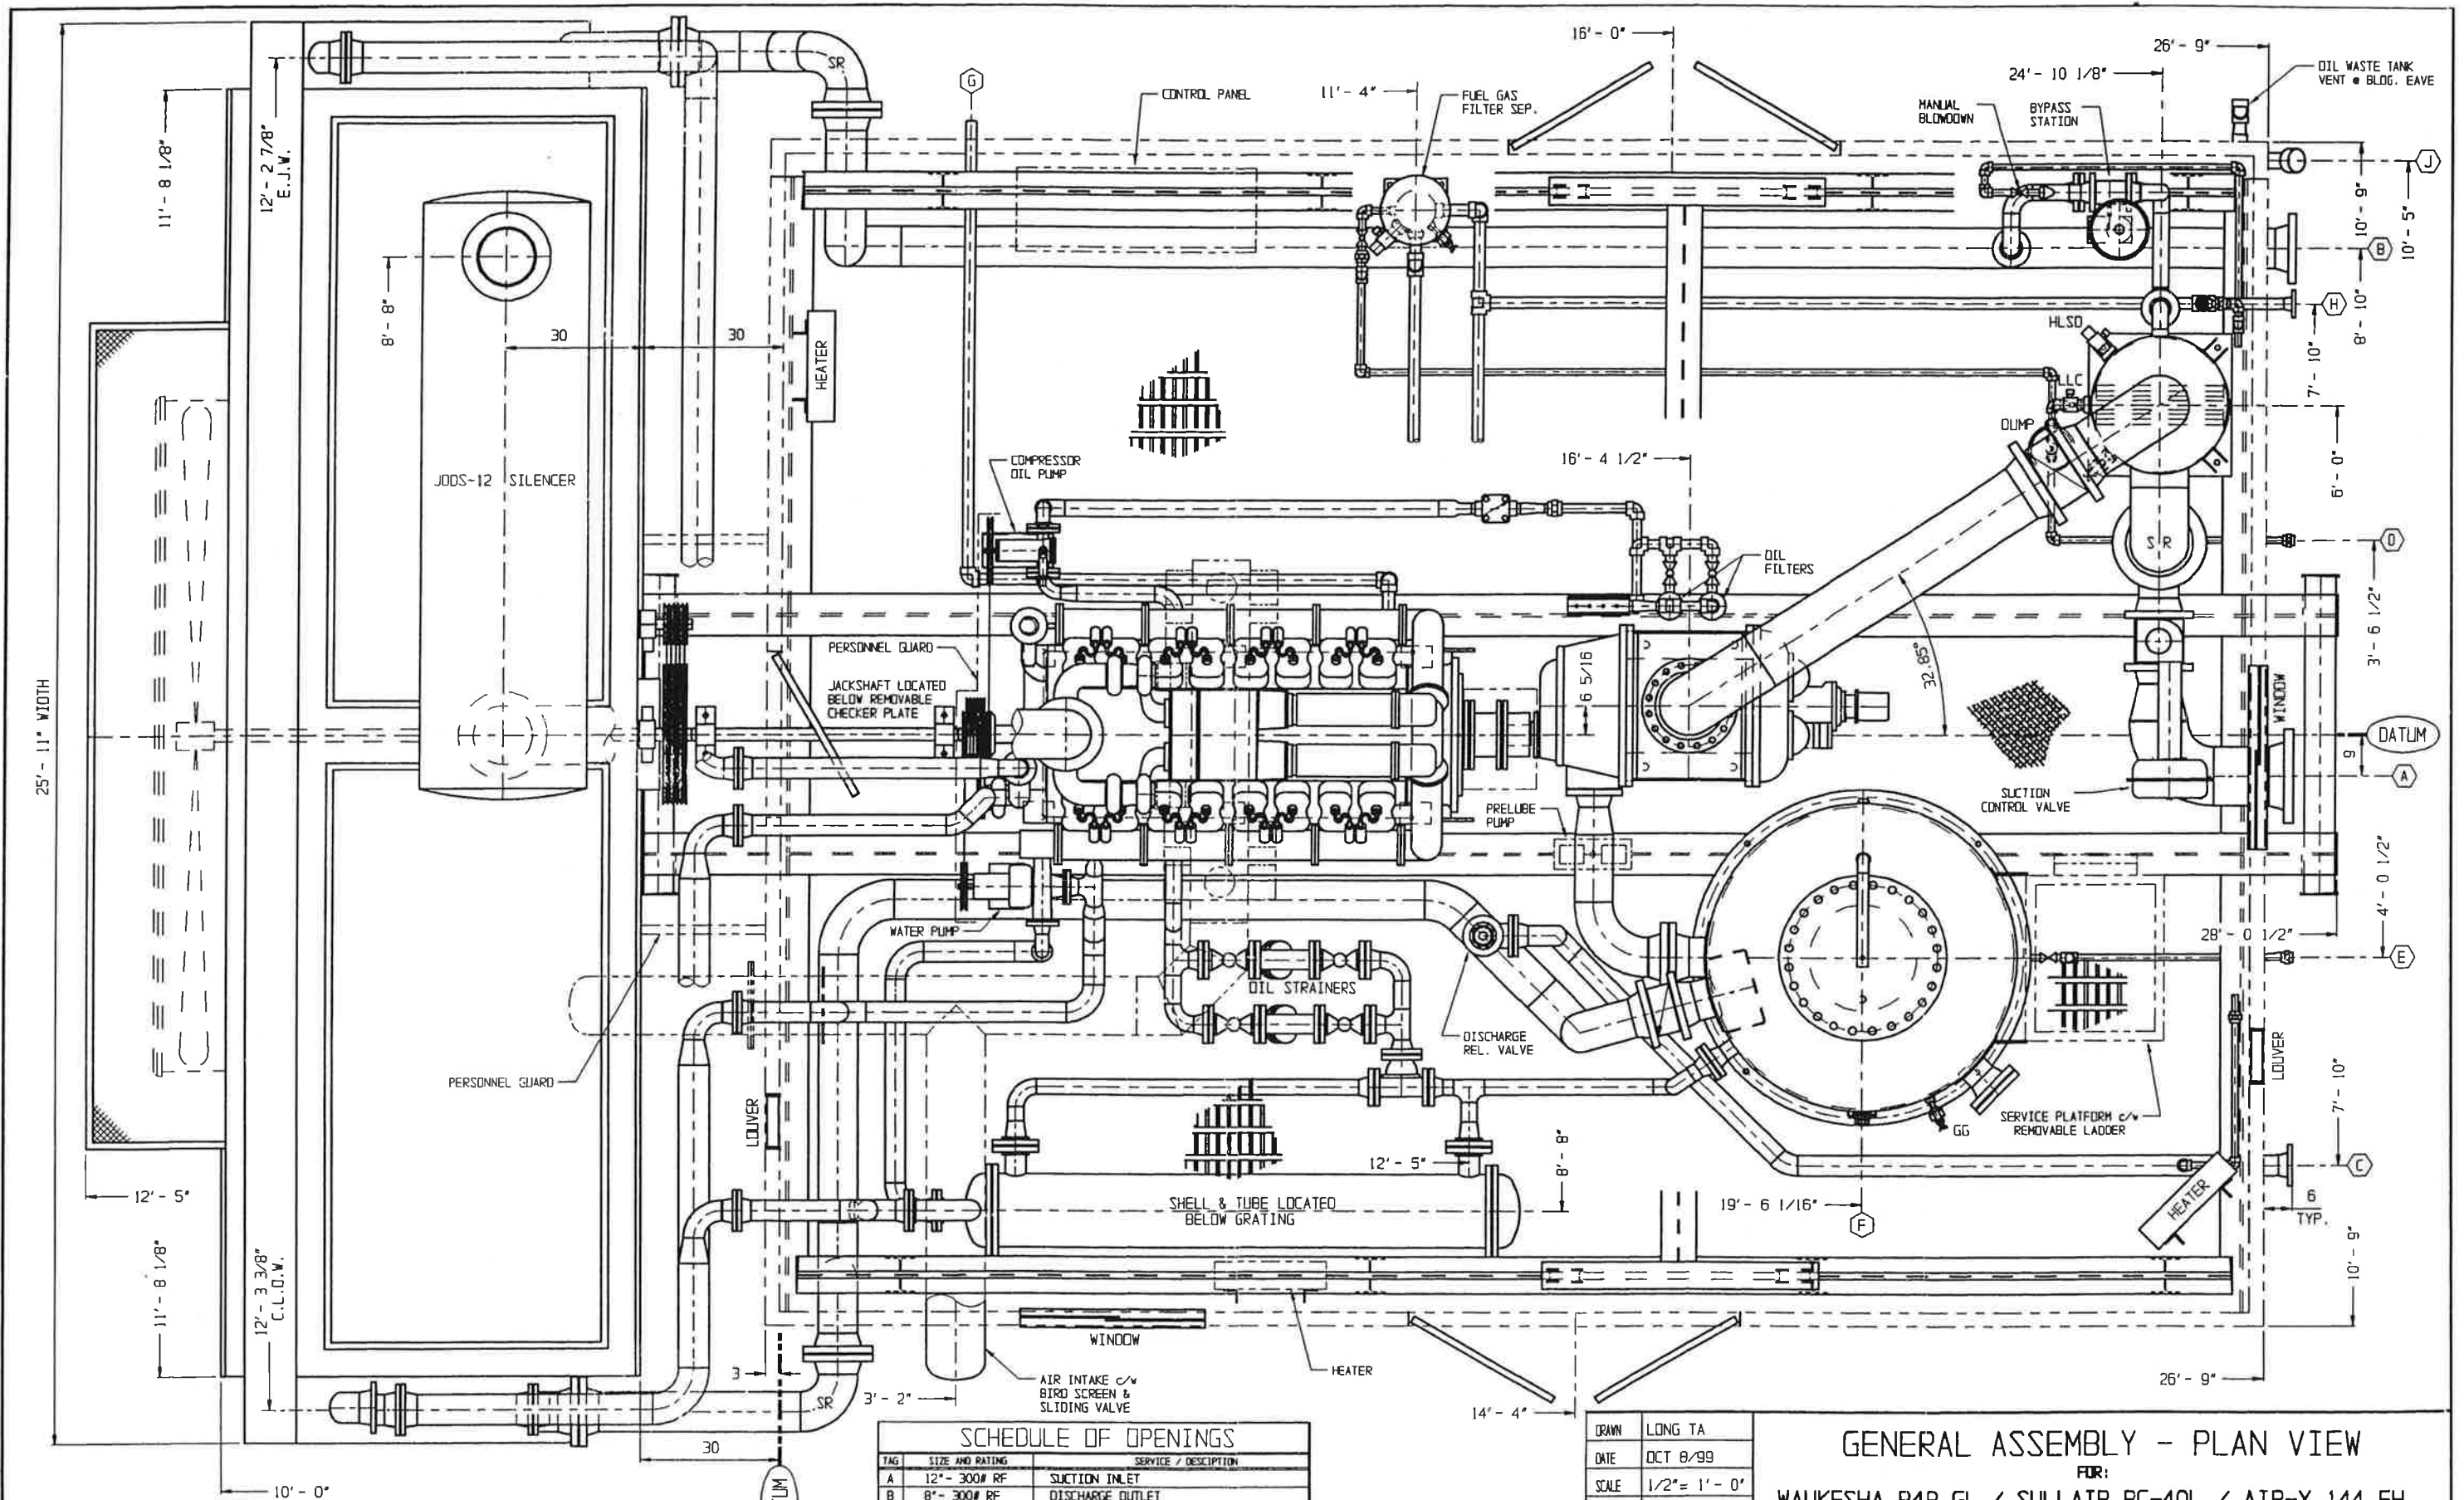

TOTAL PACKAGE WEIGHT = APPROX. 120,000 lbs (w/o COOLER)  
 TOTAL COOLER WEIGHT = APPROX. 25,000 lbs  
 TOTAL PACKAGE LENGTH = 30'- 6 1/2" (w/o COOLER)  
 TOTAL PACKAGE WIDTH (Incl. Eaves) = APPROX. 22'- 0"  
 TOTAL PACKAGE HEIGHT = APPROX. 19'- 7" (w/o COOLER)

DATUM = INSIDE EDGE OF BUILDING WALL

| SCHEDULE OF OPENINGS |                 |                                  |
|----------------------|-----------------|----------------------------------|
| TAG                  | SIZE AND RATING | SERVICE / DESCRIPTION            |
| A                    | 12" - 300# RF   | SUCTION INLET                    |
| B                    | 8" - 300# RF    | DISCHARGE OUTLET                 |
| C                    | 4" - 150# RF    | RELIEF VALVE FLARE HEADER OUTLET |
| D                    | 1" - NPT        | SCRUBBER DRAIN MANIFOLD          |
| E                    | 1" - NPT        | LUBE OIL SEPARATOR DRAIN         |
| F                    | 24" - 300# RF   | LUBE OIL SEP. FILTER ACCESS      |
| G                    | 2" MTR. PIPE    | ENGINE STARTER OUTLET            |
| H                    | 2" - 150# RF    | ENGINE FUEL GAS INLET            |
| J                    | 3" - CAMLOCK    | OIL TANK PUMP-OUT                |
| K                    |                 |                                  |
| L                    |                 |                                  |

| REV | DATE  | DESCRIPTION |
|-----|-------|-------------|
| A   | MAY17 | AS-BUILT    |

|       |                |
|-------|----------------|
| DRAWN | LONG TA        |
| DATE  | OCT 8/99       |
| SCALE | 1/2" = 1' - 0" |
| CHK'D |                |

**GENERAL ASSEMBLY - PLAN VIEW**

FOR:

**WAUKESHA P48 GL / SULLAIR PC-40L / AIR-X 144 EH**

**BIDELL EQUIPMENT**

**GAS COMPRESSION**

3236 - 50th AVENUE S.E.  
CALGARY, ALTA, T2B-3A3

PHONE: (403) 235-5877  
FAX: (403) 272-7749

CUSTOMER: BIDELL STOCK PACKAGE


PROJECT: BOOSTER COMPRESSOR

SHP ORDER: 6063

DWG.No: 6063-2A

REVISION: A



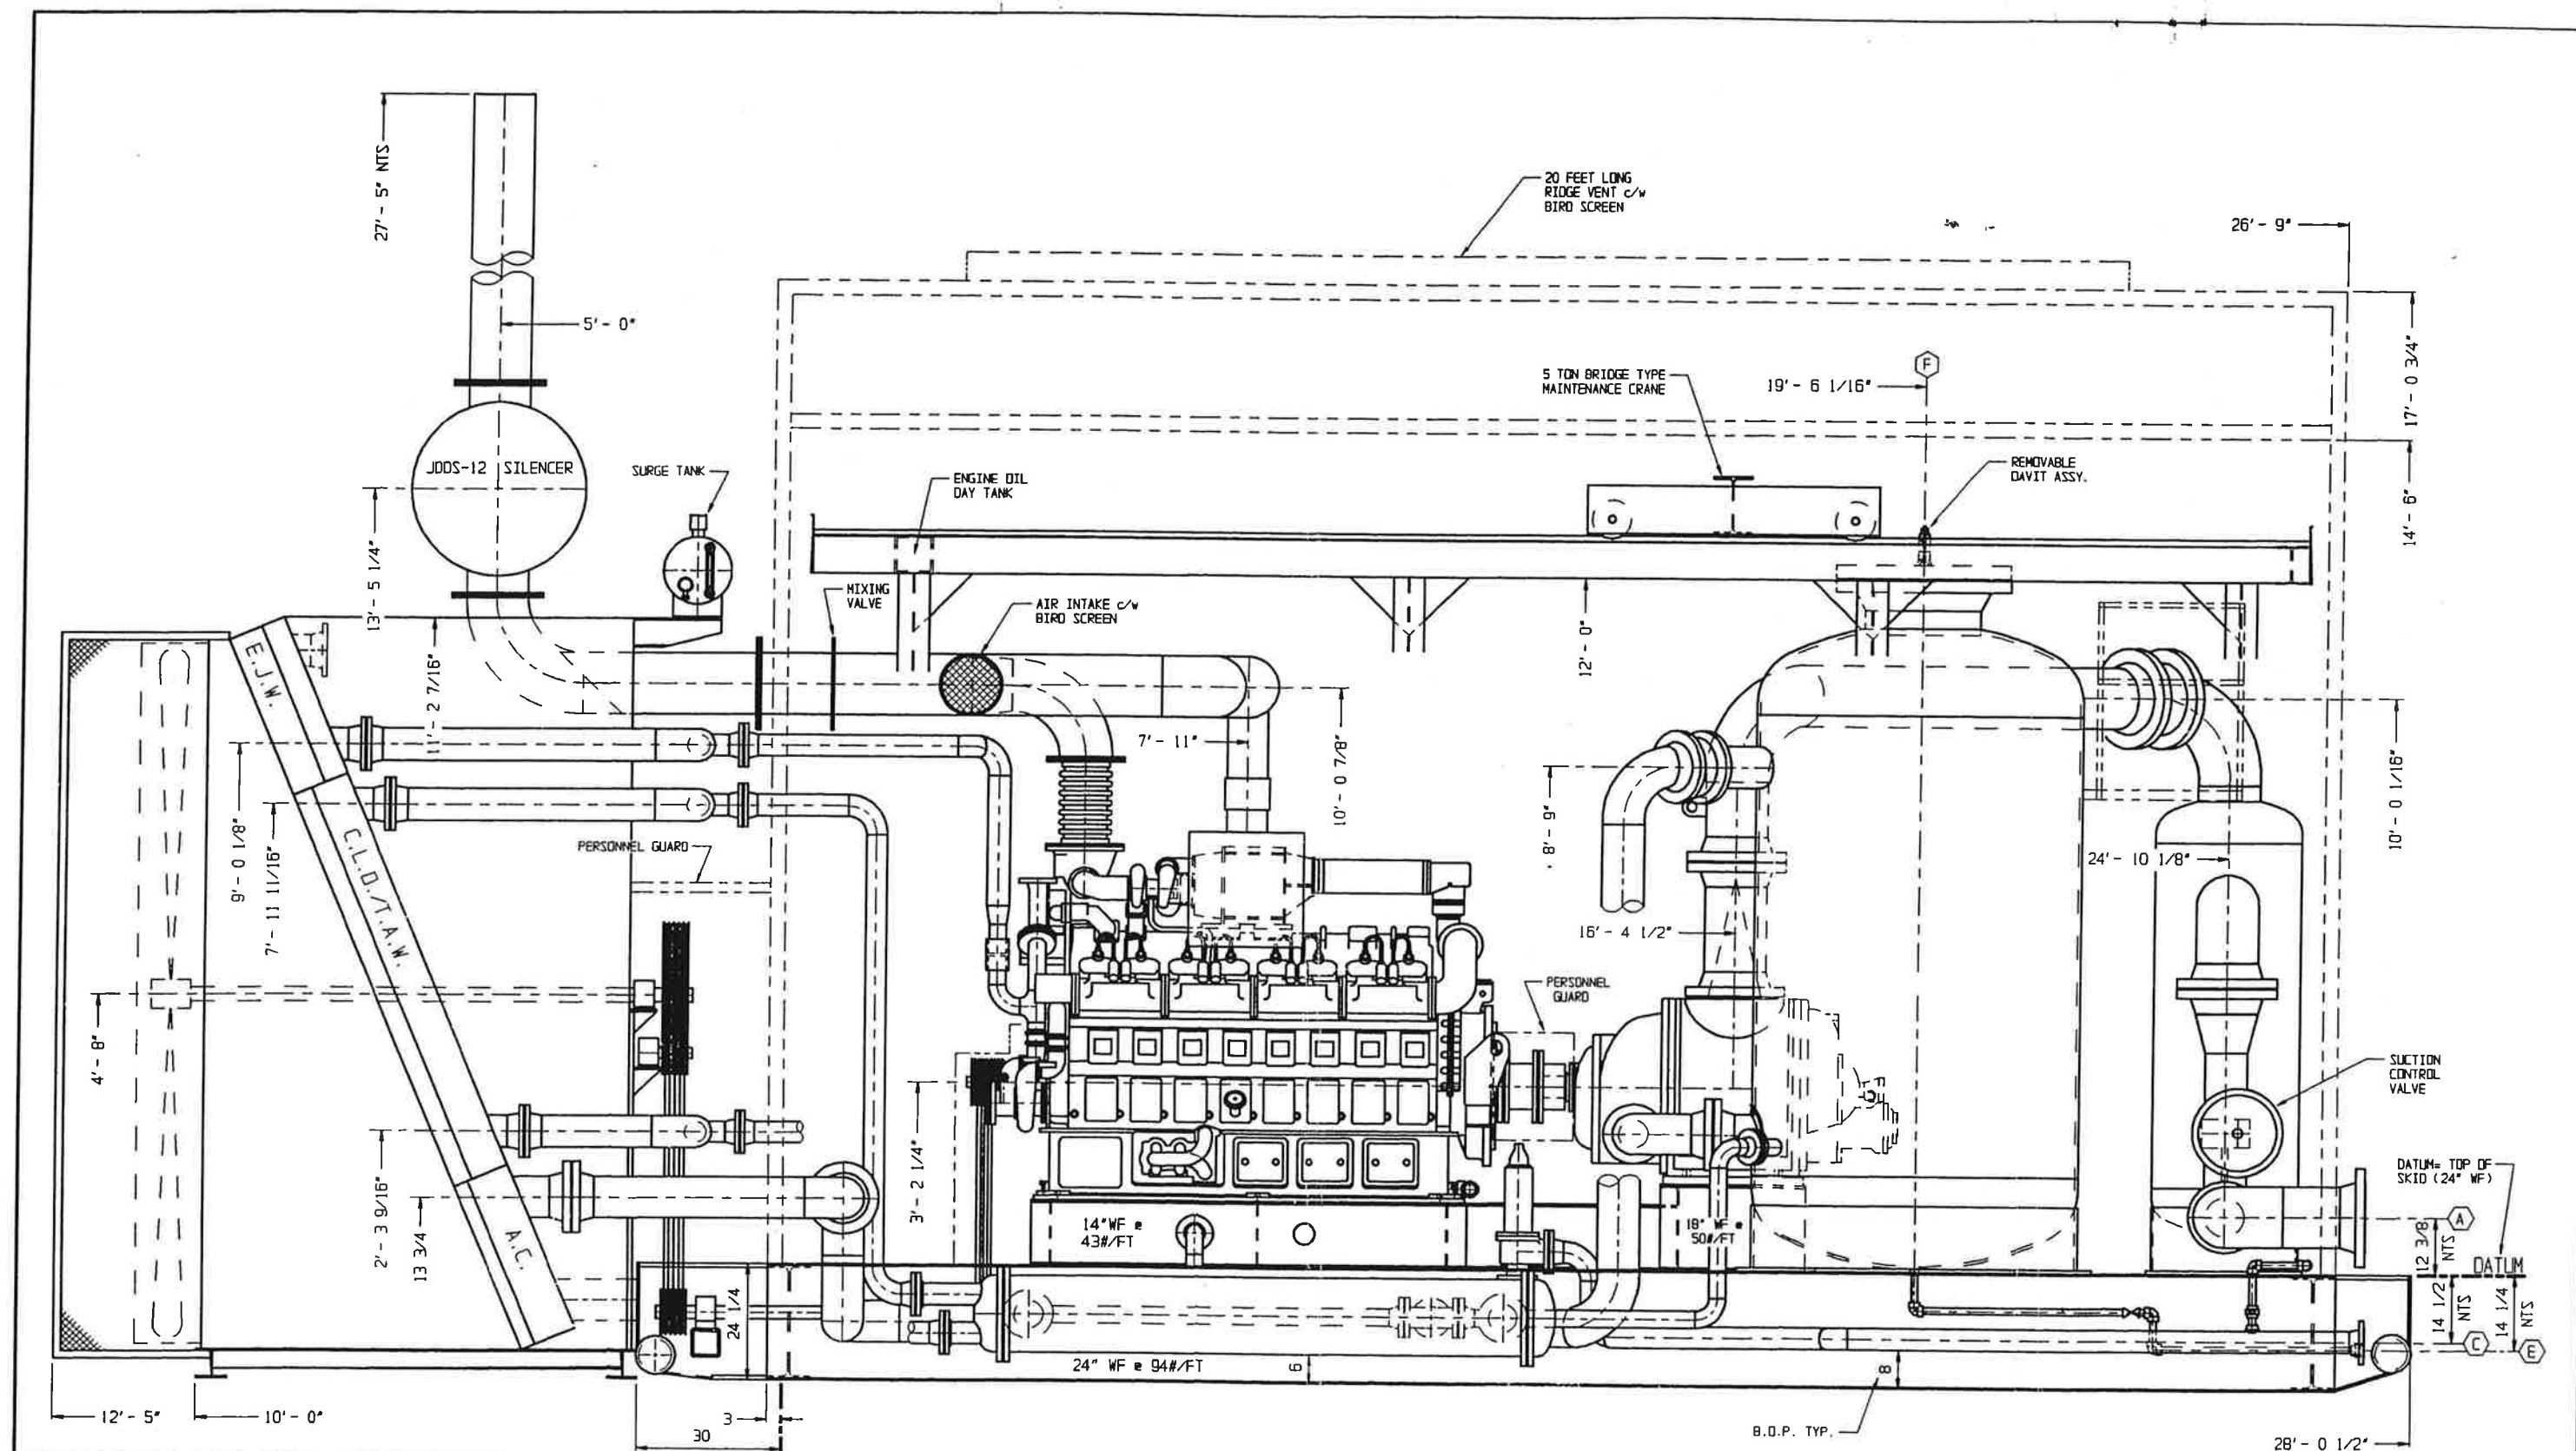


# SCHEDULE OF OPENINGS

| TAG | SIZE AND RATING | SERVICE / DESCRIPTION            |
|-----|-----------------|----------------------------------|
| A   | 12" - 300# RF   | SUCTION INLET                    |
| B   | 8" - 300# RF    | DISCHARGE OUTLET                 |
| C   | 4" - 150# RF    | RELIEF VALVE FLARE HEADER OUTLET |
| D   | 1" - NPT        | SCRUBBER DRAIN MANIFOLD          |
| E   | 1" - NPT        | LUBE OIL SEPARATOR DRAIN         |
| F   | 24" - 300# RF   | LUBE OIL SEP. FILTER ACCESS      |
| G   | 2" MITR. PIPE   | ENGINE STARTER OUTLET            |
| H   | 2" - 150# RF    | ENGINE FUEL GAS INLET            |
| J   | 3" - CAMLOCK    | OIL TANK PUMP-OUT                |
| K   |                 |                                  |
| L   |                 |                                  |
| M   |                 |                                  |

|                                                   |                |                                                                                                          |                      |
|---------------------------------------------------|----------------|----------------------------------------------------------------------------------------------------------|----------------------|
| OWN                                               | LONG TA        | <b>GENERAL ASSEMBLY - ELEVATION #1</b><br>FOR:<br><b>WAUKESHA P48 GL / SULLAIR PC-40L / AIR-X 144 EH</b> |                      |
| DATE                                              | OCT 8/99       |                                                                                                          |                      |
| SCALE                                             | 1/2" = 1' - 0" |                                                                                                          |                      |
| CHK'D                                             |                |                                                                                                          |                      |
|                                                   |                | <b>BIDELL EQUIPMENT</b><br><b>GAS COMPRESSION</b>                                                        |                      |
| 3236 - 50th AVENUE S.E.<br>CALGARY, ALTA, T2B-3A3 |                | PHONE: (403) 235-5877<br>FAX: (403) 272-7749                                                             |                      |
|                                                   |                | CUSTOMER:                                                                                                | BIDELL STOCK PACKAGE |
|                                                   |                | PROJECT:                                                                                                 | BOOSTER COMPRESSOR   |
|                                                   |                | SHP ORDER:                                                                                               | 6063                 |
|                                                   |                | DWG.No:                                                                                                  | 6063-2B              |
|                                                   |                | REVISION:                                                                                                | A                    |

|     |       |             |
|-----|-------|-------------|
| A   | MAY17 | AS-BUILT    |
| REV | DATE  | DESCRIPTION |

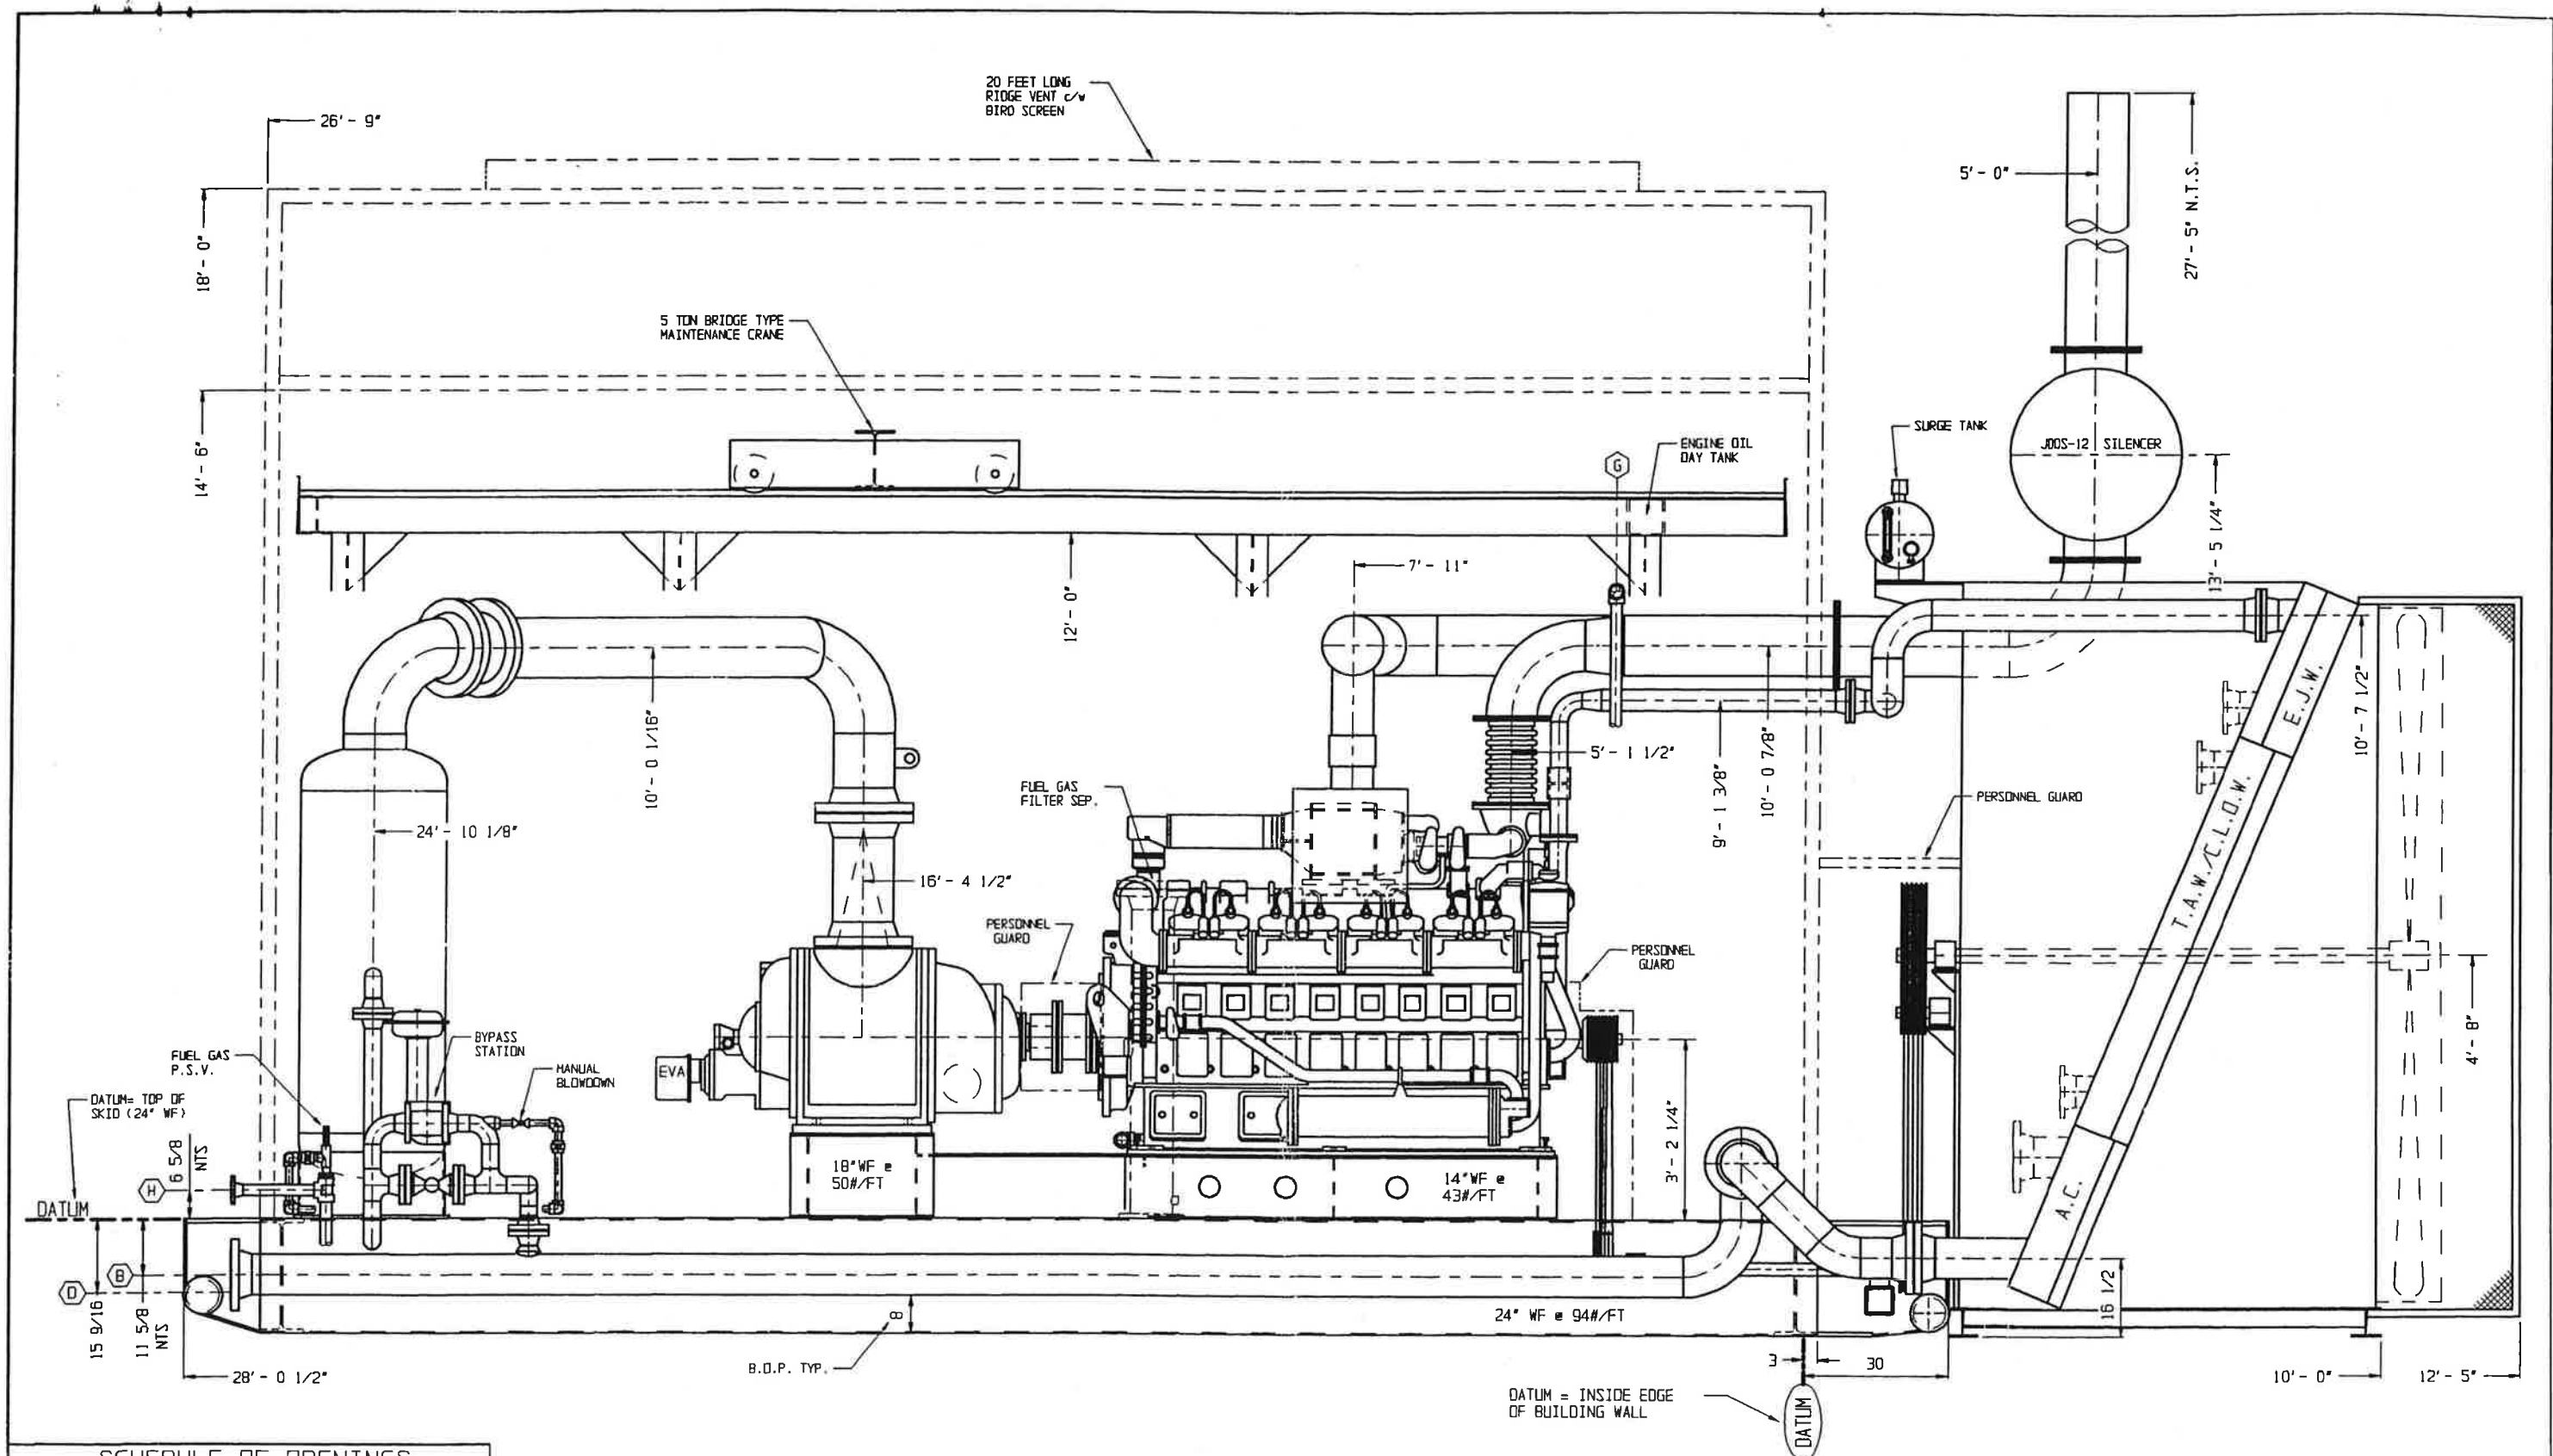

### SCHEDULE OF OPENINGS

| TAG | SIZE AND RATING | SERVICE / DESCRIPTION            |
|-----|-----------------|----------------------------------|
| A   | 12" - 300# RF   | SUCTION INLET                    |
| B   | 8" - 300# RF    | DISCHARGE OUTLET                 |
| C   | 4" - 150# RF    | RELIEF VALVE FLARE HEADER OUTLET |
| D   | 1" - NPT        | SCRUBBER DRAIN MANIFOLD          |
| E   | 1" - NPT        | LUBE OIL SEPARATOR DRAIN         |
| F   | 24" - 300# RF   | LUBE OIL SEP. FILTER ACCESS      |
| G   | 2" MTR. PIPE    | ENGINE STARTER OUTLET            |
| H   | 2" - 150# RF    | ENGINE FUEL GAS INLET            |
| J   | 3" - CAMLOCK    | OIL TANK PUMP-OUT                |
| K   |                 |                                  |
| L   |                 |                                  |
| M   |                 |                                  |

|       |                |
|-------|----------------|
| DRAWN | LONG TA        |
| DATE  | OCT 8/99       |
| SCALE | 1/2" = 1' - 0" |
| CHK'D |                |

**GENERAL ASSEMBLY - ELEVATION #2**  
 FOR:  
**WALUKESHA P48 GL / SULLAIR PC-40L / AIR-X 144 EH**

**BIDELL EQUIPMENT**  
**GAS COMPRESSION**

3236 - 50th AVENUE S.E.  
 CALGARY, ALTA, T2B-3A3  
 PHONE: (403) 235-5877  
 FAX: (403) 272-7749

|             |                      |
|-------------|----------------------|
| CUSTOMER:   | BIDELL STOCK PACKAGE |
| PROJECT:    | BOOSTER COMPRESSOR   |
| SHOP ORDER: | 6063                 |
| DWG.No:     | 6063-2C              |
| REVISION:   | A                    |

| REV | DATE  | DESCRIPTION |
|-----|-------|-------------|
| A   | MAY17 | AS-BUILT    |