

Technical drawing of a rectangular plate with the following dimensions and features:

- Overall Dimensions:** 120" (width) x 216" (height).
- Horizontal Dimensions (from left datum):**
 - 64 3/8" TYP. (center of first hole)
 - 150 5/8" TYP. (center of second hole)
 - 216" (total width)
- Vertical Dimensions (from bottom datum):**
 - 82 1/4" (center of first hole)
 - 109 3/4" (center of second hole)
 - 149 5/8" (center of third hole)
 - 216" (total height)
- Holes:**
 - Two holes with diameter $\varnothing 1 \frac{1}{4}"$ TYP. located at (64 3/8", 82 1/4") and (150 5/8", 109 3/4").
 - One hole with diameter $\varnothing 1 \frac{1}{4}"$ TYP. located at (150 5/8", 149 5/8").
- Features:**
 - A fillet with a radius of 1/4" TYP. ALL AROUND DATUM 0" at the bottom-left corner.
 - A feature labeled 'A' with a dimension of 149 5/8" TYP. located at the bottom-right corner.
- Datums:**
 - DATUM 0" is the bottom-left corner.
 - DATUM 0" is also indicated at the top-left corner.

SECRET

AS BUILT

SECTION A-A
SCALE: 1:18

- | STRUCTURAL DESIGN DATA | |
|------------------------|---|
| SURFACE PREP.: | SSPC-SP7 BRUSH BLAST |
| PAINT: | (2) SHOP COATS CLOVERDALE SERIES 835 DTM
POLYURETHANE ENAMEL - WARM GREY |
| APPROX. WEIGHT | 3700 LBS |
| INSULATION: | -
- |

ISSUED FOR
CONSTRUCTION

SIGNED: _____

DATE: _____

W.O. 62-90-

 S_1O_2

ALL DIMENSIONS IN INCHES





P.O. BOX 6280, INNISFAIR, AB T4G 1S9
PH: (403) 227-4100 FAX: (403) 227-4102

THIS DRAWING IS PROPERTY OF NWP INDUSTRIES INC.
AND MAY NOT BE REPRODUCED WITHOUT PERMISSION.
THIS DRAWING MUST BE RETURNED UPON REQUEST.

PERPETUAL ENERGY
HORIZONTAL SEPARATOR PACKAGE
36" OD x 10' S/S, 1440 PSI
SWEET SERVICE
SKID ASSEMBLY

DWN: JHK	CHK: GH	APP: DF
DATE: 2012.01.12	DATE: 2012.01.20	DATE: 2012.01.20
SCALE: 1:36	DWG: 08246-3	REV: 2
SHEET: 1 OF 4		

ITEM	PART #	DESCRIPTION	MTR #	LENGTH	QTY.
1	-	SEE PIPE SUPPORT CUT LIST			1
2	UBO1.375	U-BOLT, 1" x 3/8" c/w 4 NUTS FIG 137			7
3	UBO2.375	U-BOLT 2" x 3/8" c/w 4 NUTS FIG. 137			22
4	UBO3.375	U-BOLT 3" x 3/8" c/w 4 NUTS FIG. 137			1
5	UBO6.625	U-BOLT 6" x 5/8" c/w 4 NUTS FIG. 137			7

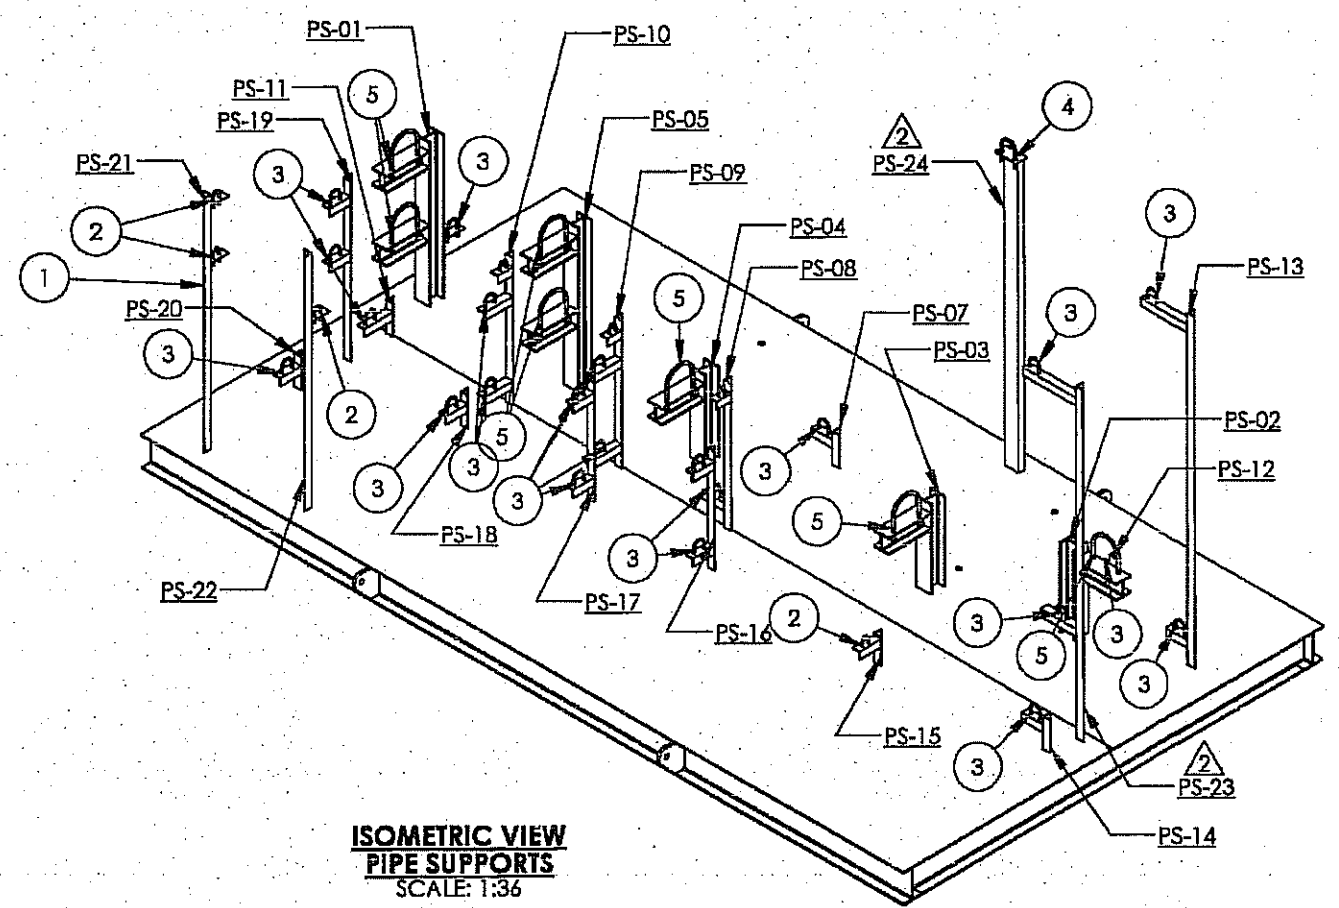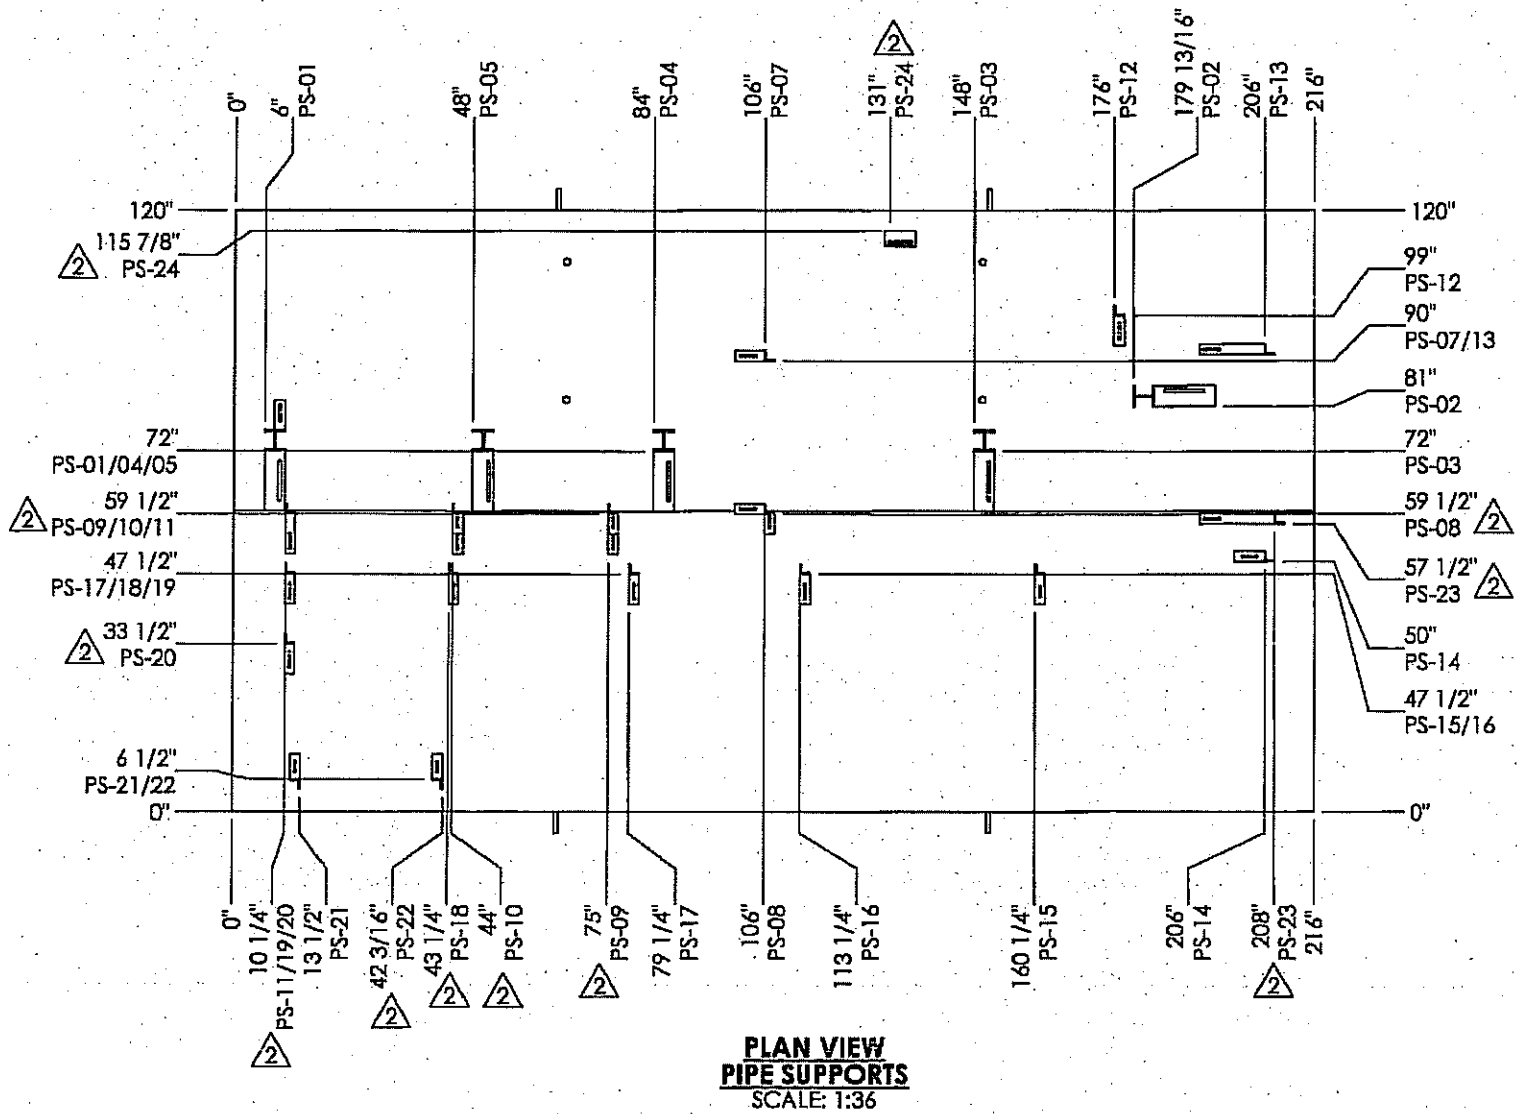

ISOMETRIC VIEW
PIPE SUPPORTS
SCALE: 1:36

AS BUILT

ORIGINAL

--	--	
