




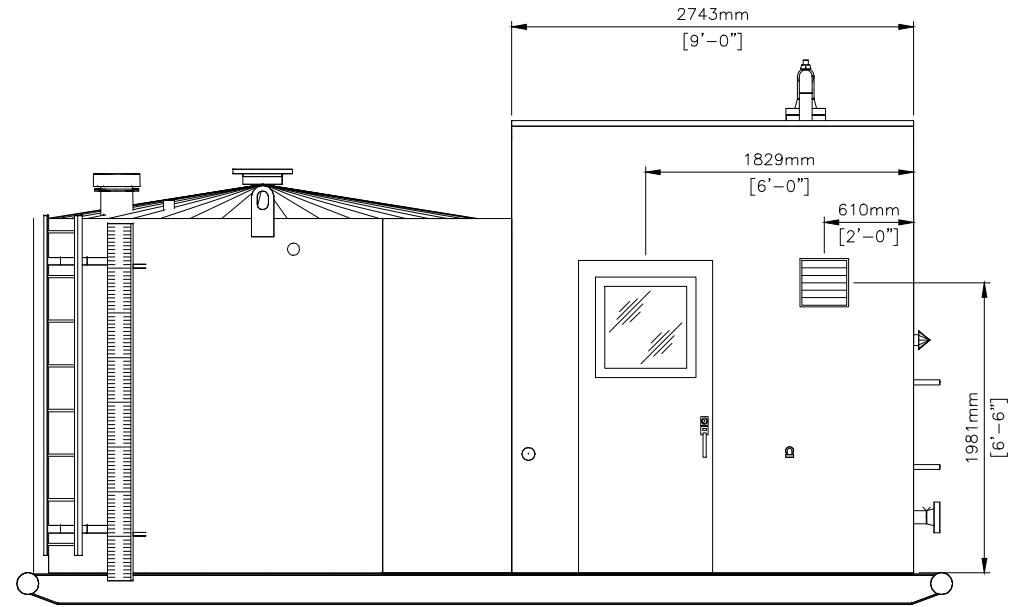


FRONT VIEW
SCALE 1:50

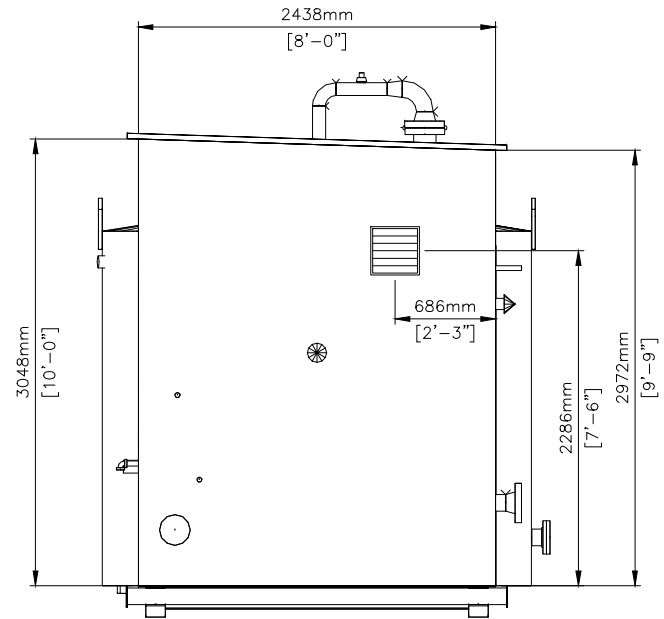

RIGHT VIEW
SCALE 1:50

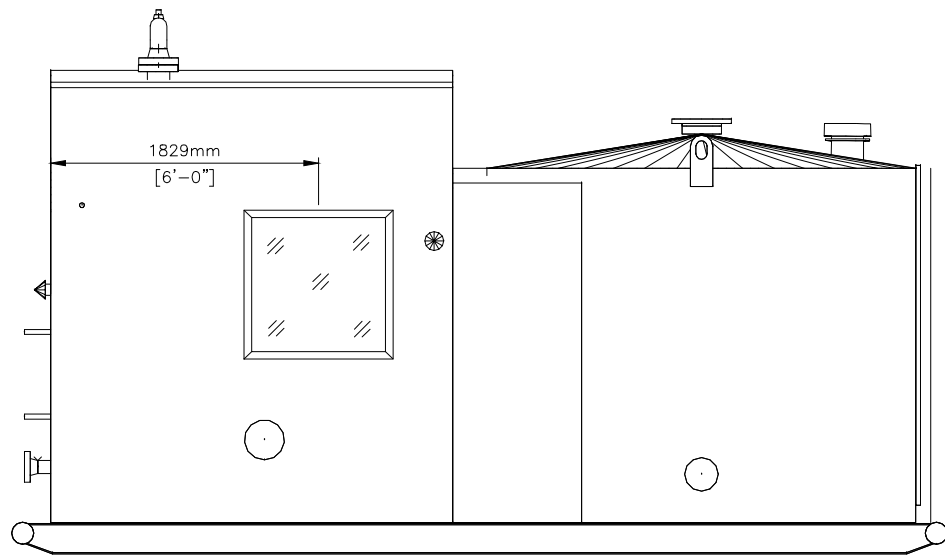

BACK VIEW
SCALE 1:50

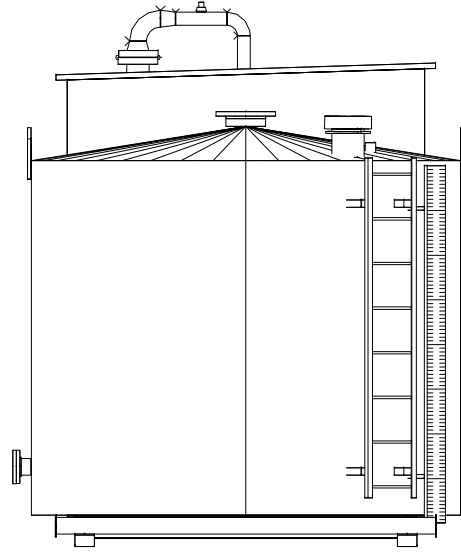

LEFT VIEW
SCALE 1:50

QTY	SKID, BUILDING & PAINT DESCRIPTION	
	BUILDING	8'-0" WIDE x 9'-0"
	BUILDING PANELS	FOAM PANEL
	EAVES	10'-0" x 9'-9"
	INTERIOR COLOR	28 GAUGE GALVALUM METAL PANELS
	EXTERIOR COLOR	28 GAUGE METAL PANELS, TAN IN COLOR
	INSULATION	POLYURETHANE; R12
1	DOORS	3'x7', w/GPW WINDOW & DRIP CAP
1	PANIC BAR	PANIC HARDWARE, RETAINER & CHECK CHAIN
1	WINDOW	36" x 36" SLIDING w/SCREEN
2	VENT	12" x 12" SLIDING VENTS w/SCREENS
	SKID	8'-0" WIDE x 20'-5 1/2" LONG
	MATERIAL	8" WF MAIN RAILS & 6" CROSS MEMBERS
	FLOOR	3/16" CHECKERPLATE
	OPTIONS	NONE
	UNDER SKID INSULATION	NONE
	SKID COLOR	CLOVERDALE RUSTEX PRIMER & CLOVERDALE RUSTOLEUM #906 WARM GREY ON INTERIOR PIPING
	PIPING COLOR	CLOVERDALE RUSTEX PRIMER & CLOVERDALE RUSTOLEUM #906 WARM GREY ON INTERIOR PIPING

DATE	REV	DESCRIPTION	DWN	CHKD	APPVD
19-09-27	0	AS BUILT	WST	AV	AV

CLIENT VAN HAWK		
LSD. 3 PHASE SEPARATOR (24" x 7'-6") DRESSED 3 PHASE		
BUILDING LAYOUT		
DATE:	2019-09-27	VAN HAWK PROJECT#
SCALE:	SEE DWG	A523236 (4-1149)
DRAWN BY:	WST	DRAWING NO.
CHECKED BY:	AV	A523236-E-01
APPROVED BY:	AV	SHEET 1 of 1