
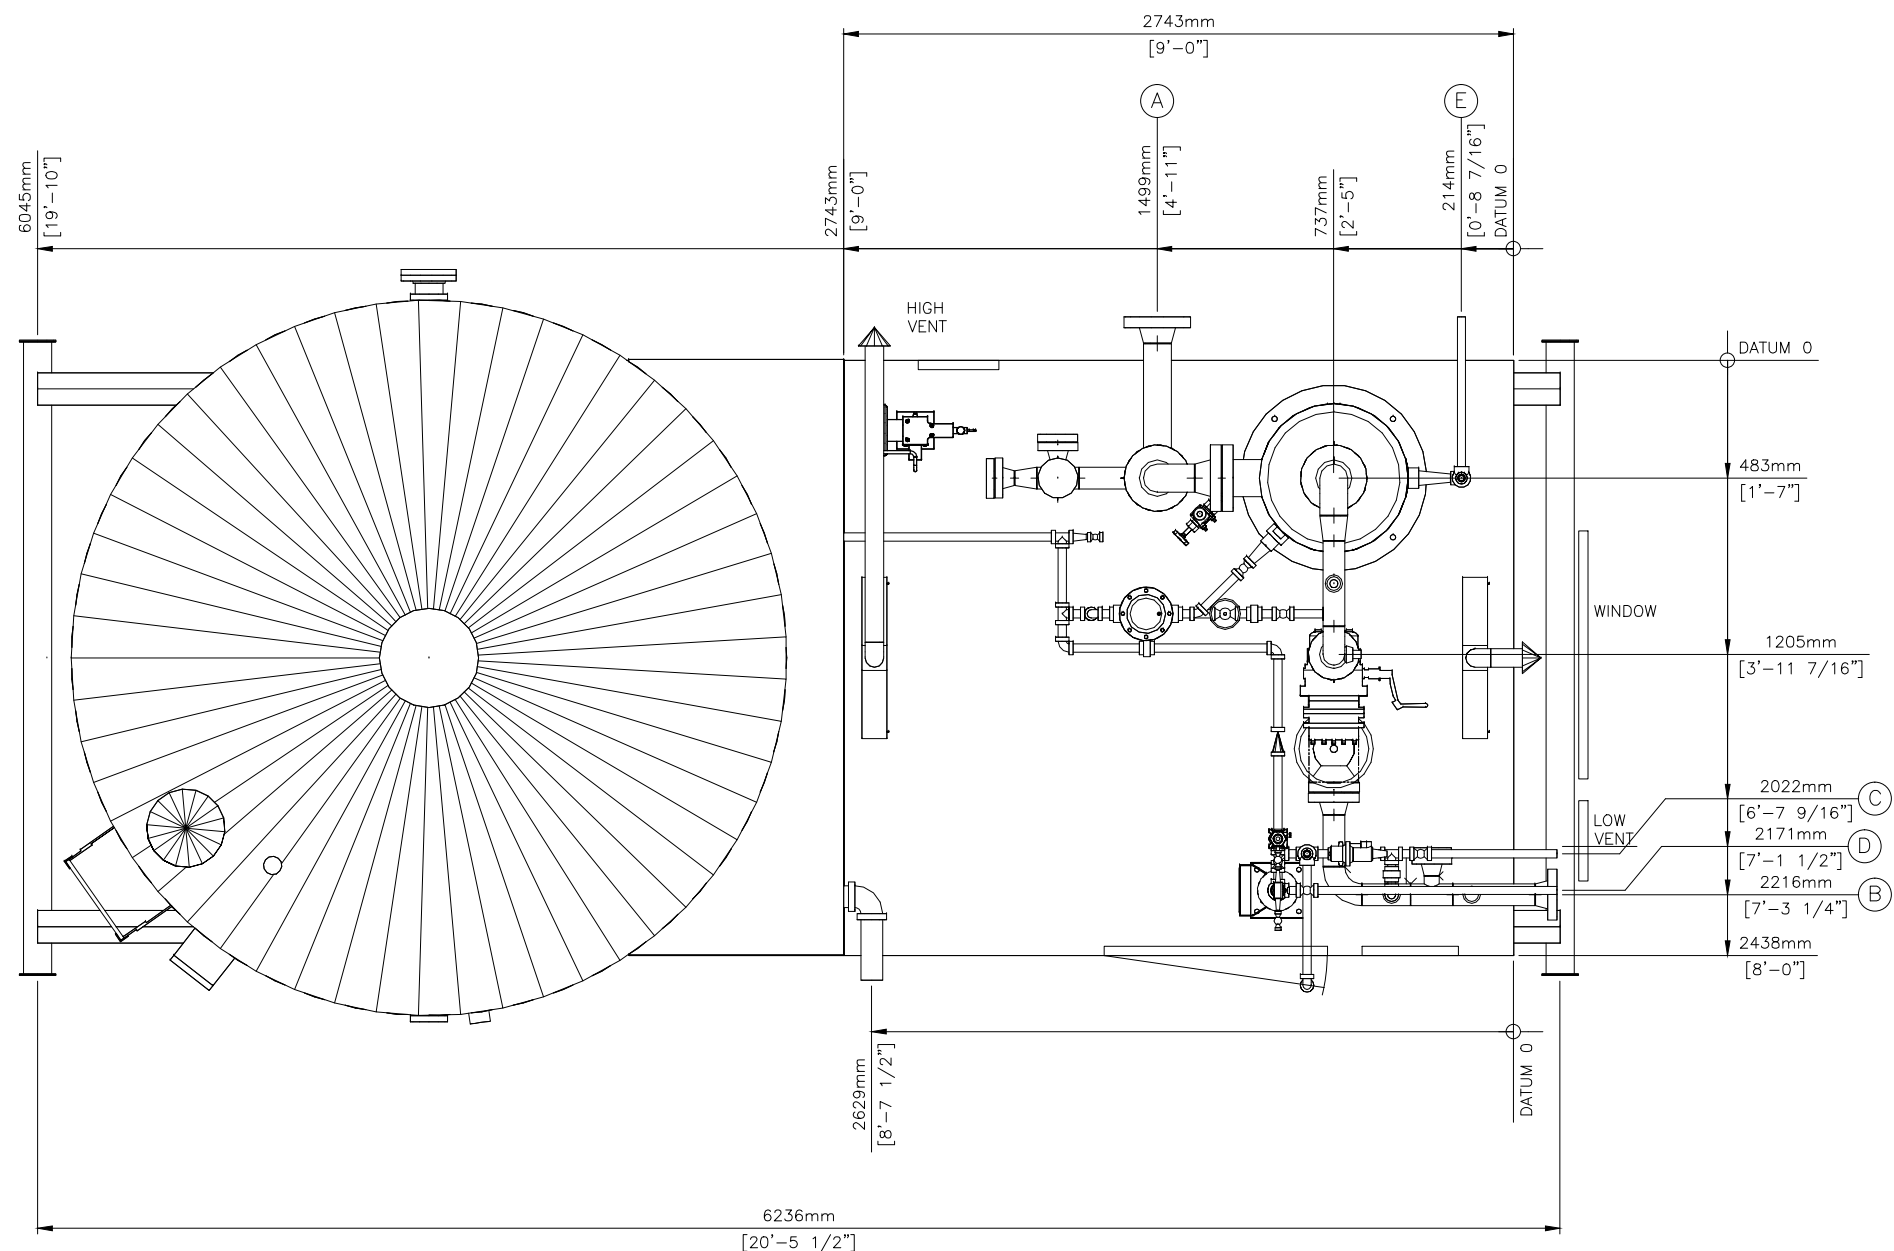


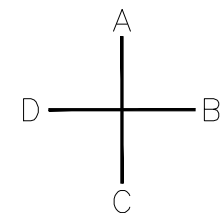

SHIPPING DIMENSIONS:
-10'-2"(3099mm) WIDE
-21'-0"(6401mm) LONG
-11'-9"(3353mm) HIGH
-APPROX 18,000LBS.

CUSTOMER CONNECTIONS

ITEM	DESCRIPTION	SIZE	ELEVATION	PROJ.
A	INLET	4"-600 CL RFWN	571 FTOS	165
B	OUTLET	3"-600 CL RFWN	375 FTOS	70
C	FUEL GAS INLET	1"-NPT	725 FTOS	152
D	FUEL GAS OUTLET	1"-NPT	1302 FTOS	152
E	PSV	1"-NPT	2168 FTOS	152
F	METHANOL INLET	3/8"-TUBING	SHOP FIT	SHOP FIT
G	METHANIL OUTLET	3/8" TUBING	SHOP FIT	SHOP FIT

NOTE: -ALL DIMENSIONS ARE IN MILLIMETERS UNLESS SHOWN OTHERWISE
-PIPING MAY BE NOT EXACTLY AS SHOWN

PLAN VIEW

SCALE

DATE	REV	DESCRIPTION	DWN	CHKD	APPRVD
19-09-27	0	AS BUILT	WST	AV	AV

CLIENT		VAN HAWK	
LSD.		3 PHASE SEPARATOR (24" x 7'-6") DRESSED 3 PHASE	
GENERAL ARRANGEMENT			
DATE:	2019-09-27	VAN HAWK PROJECT#	A523236 (4-1149)
SCALE:	SEE DWG	DRAWING NO.	
DRAWN BY:	WST	CHECKED BY:	AV
CHECKED BY:	AV	APPROVED BY:	AV
DATE	19-09-27	SHEET	1 of 3