

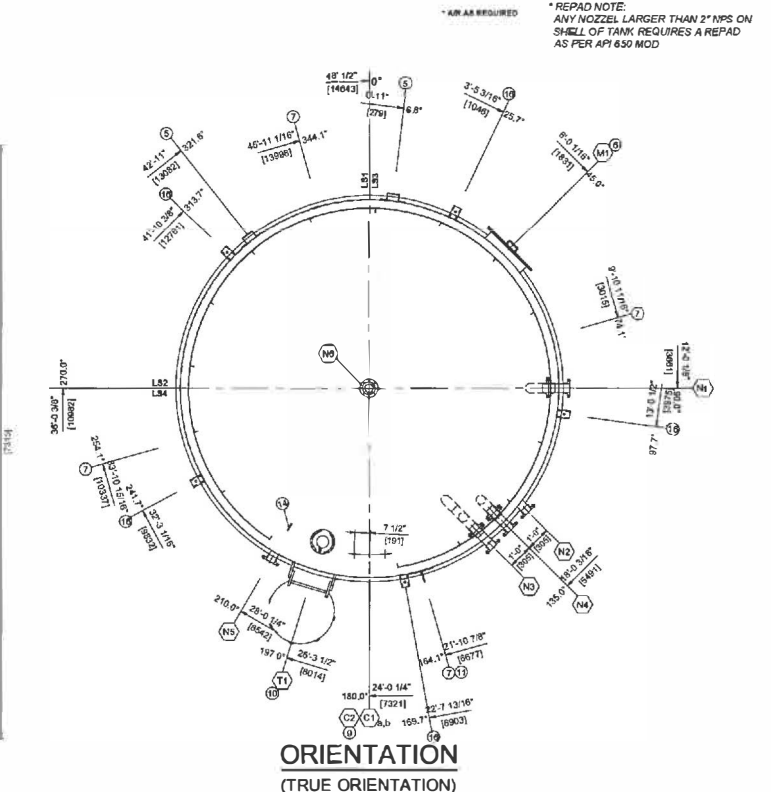
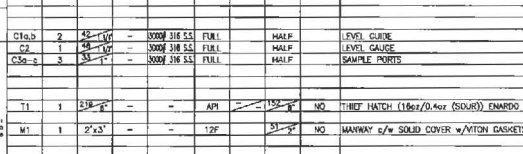
GENERAL NOTES			
DESIGN		PAINTING AND INSULATION	
DESIGN CODE API SPEC. 12P, TWELFTH EDITION, OCT 2004, 650 MOD	ADDITIONAL CODES 402/eq in	INTERNAL FINISH SSPC-SP15-BLAST, DOLYCHIM 253.0	12-15MESH C/W HOLIDAY TESTING
DESIGN PRESSURE 1667/eq in	DESIGN VACUUM NONE	COORDINATION ALLOWANCE NONE	
ISOGRAPHY SPOT X-RAY AS PER 650 MOD	JOINT EFFICIENCY NONE	CAPACITY 755 BAR (110 COM) NOMINAL	
IMPACT TESTING NONE	AIRTEST PRESSURE 2402	OVERALL WIDTH 19-27 3/8" (4759)	
MINIMUM DESIGN METAL TEMPERATURE -29°C (-20°F)	WEIGHT 500R	EXTERNAL FINISH SANDBLAST SSPC-SP10 COAT COAT DURETHANE DTM INSULATE w/ 1 1/2" URETHANE	
OVERALL HEIGHT 27'-0" 1/4" TOL +/- 0" (8235)	DELIVERY 18,000 lbs	FOAM C/W BLACK UV COATING	

NOZZLE SCHEDULE

MATERIAL LIST

MK#	QTY	DESCRIPTION	MATERIAL	WT
1	1	FLOOR PLATE - 15'-7 3/8" x 1/4" THK	SA36	-
2	4	SHELL PLATE - 6'-0" x 3/16" THK	SA36	-
3	1	CONICAL ROOF PLATE - 15'-5 1/2" x 1/4" THK	SA36	-
4	1	MANNAY 2'x3' c/w SOLID COVER w/ VITON GASKETS	SA36	-
5	4	HAULING PADS	SA36	-
6	1	PESC NAMEPLATE c/w BRACKET	SA36	-

CPLG	CLPG	NOZZLE	NOZZLE	MANWAY	NOZZLE
------	------	--------	--------	--------	--------

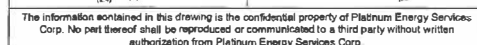
[illegible]

* REPAD NOTE:
ANY NOZZEL LARGER THAN 2" NPS ON
SHELL OF TANK REQUIRES A REPAD
AS PER API 650 MOD

☒ APPROVED FOR CONSTRUCTION
☐ ISSUE FOR CONSTRUCTION AS NOTED
☐ REVISE AND RESUBMIT FOR APPROVAL

DATE May 22/14
SIGNATURE [Signature]

SHELL JOINT - VERTICAL	SHELL JOINT - HORIZONTAL
------------------------	--------------------------



- 1 ALL FLANGE RATINGS TO BE ANSI B16.5 LATEST EDITION
- 2 FLANGE AND BOLT HUBS TO ATTACH TO CENTER LINES (UNO)
- 3 INSIDE EDGES OF NOZZLE NECKS, INSPECTION OPENINGS AND MANWAYS (IF INTERNALLY COATED) SHALL BE ROUNDED TO A RADIUS OF 1/8" MIN OR ONE HALF THE WALL THICKNESS, IF THE PIPE WALL IS LESS THAN 1/4"
- 4 ALL DIMENSIONS ARE IMPERIAL DIMENSIONS IN () ARE METRIC FOR REFERENCE ONLY
- 5 ALL NOZZLE PROJECTIONS ARE MEASURED AT NOZZLE CENTERLINE
- 6 ALL ROOF NOZZLES TO BE 3/4" O.D.

COMPANY	JOB NO	QTY
	21592	1
SCALE NTS	DRAWING NO	REV
	21592-TX-01	E

602 Mitchell St. NE
Box 1449
Redcliff, Alberta
T9J 2P0

Tank Manufacturing Facility
Phone (403) 848-2657
Fax (403) 848-2659