


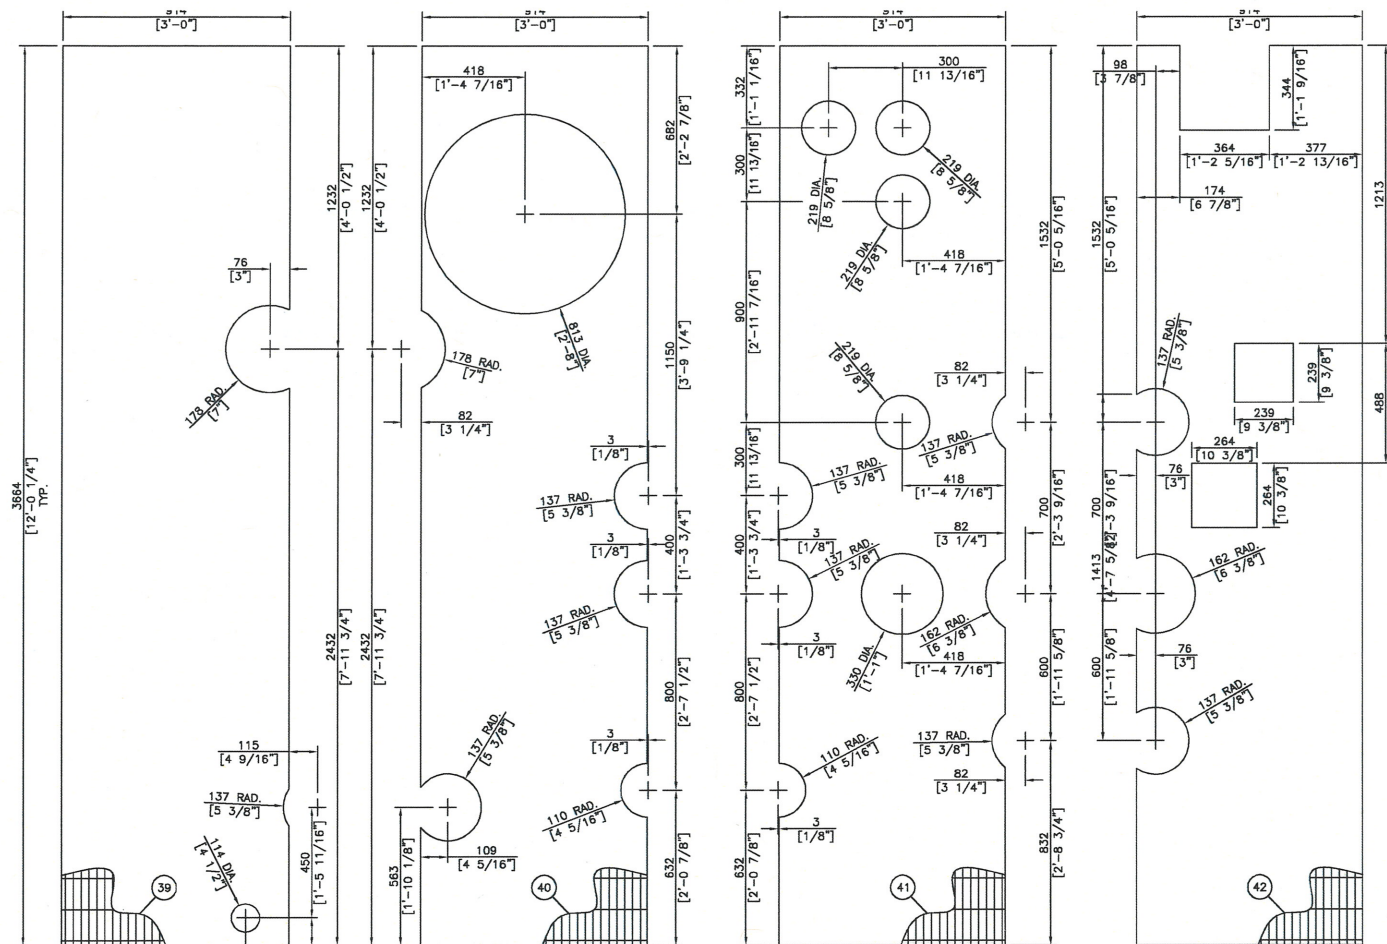


MK#39 DETAIL
(1 REQ'D)


MK#40 DETAIL
(1 REQ'D)

MK#41 DETAIL
(1 REQ'D)


MK#42 DETAIL
(1 REQ'D)

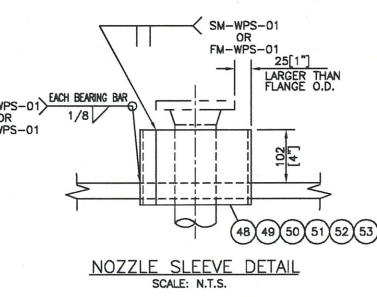


NOZZLE SLEEVE DETAIL
SCALE: N.T.S.

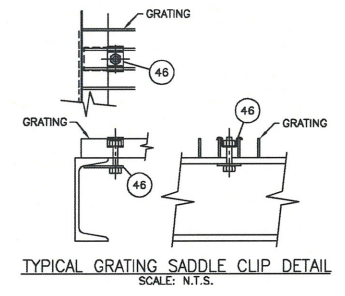


TYPICAL GRATING SADDLE CLIP DETAIL
SCALE: N.T.S.

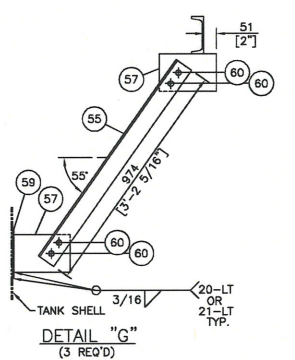


DETAIL "G"
(3 REQ'D)

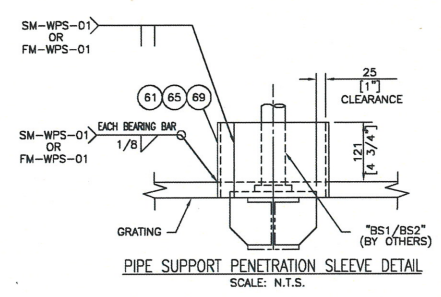


PIPE SUPPORT PENETRATION SLEEVE DETAIL
SCALE: N.T.S.

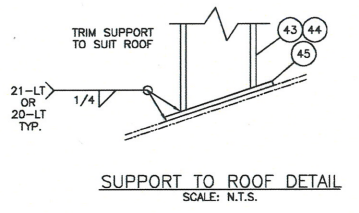


SUPPORT TO ROOF DETAIL
SCALE: N.T.S.

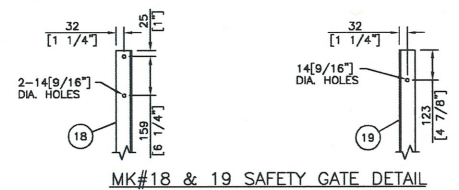


MK#18 & 19 SAFETY GATE DETAIL

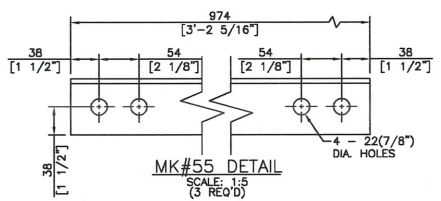

MK#55 DETAIL
SCALE: 1:5
(3 REQ'D)

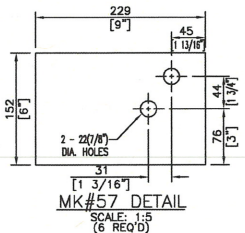

MK#57 DETAIL
SCALE: 1:5
(6 REQ'D)

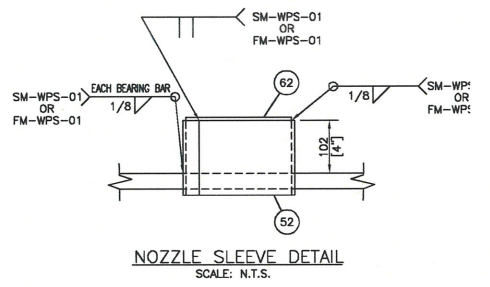

NOZZLE SLEEVE DETAIL
SCALE: N.T.S.

MATERIAL LIST

MATERIAL REQUIREMENTS						
MK	QTY	PART NO.	DESCRIPTION	CUT LENGTH	MATERIAL	WT
50	1		FLATBAR 1/4" x 6" (ROLLED AS SHOWN)	3'-4 1/16"	G40.21-44W	17
51	1		PIPE 12" SCH STD SMLS PBE	6"	SA-106-B	25
52	5		PIPE 10" SCH STD SMLS PBE	6"	SA-106-B	101
53	5		PIPE 8" SCH STD SMLS PBE	6"	SA-106-B	71
54	1		DOUBLE BAR SAFETY GATE (DG 27L) LEFT HAND FINISH COLOR - SAFETY YELLOW	-	INTREPID INDUSTRIES	10
55	3		ANGLE 3" x 3" x 1/4"	3'-2 5/16"	G40.21-44W	47
56	2		PLATE 1/2" THK. x 9 13/16"	1'-0"	G40.21-44W	33
57	6		PLATE 3/8" THK. x 6" x 9" LG.	-	G40.21-44W	36
58	1		BEAM W4 x 13# (COPE BOTH ENDS)	1'-7 5/8"	G40.21-44W	21
59	3		REPAD 3/16" THK. x 3" x 8" LG.	-	G40.21-38W F.G.P.	4
60	12		BOLT 3/4" DIA. x 2" LG. C/W NUT & WASHER	-	SA-325	6
61	1		FLATBAR 1/4" x 6"	3'-5 3/8"	G40.21-44W	18
62	1		PLATE 3/16" THK. x 10" DIA.	-	G40.21-44W	3
63	1		PLATE 1/2" THK. x 11 13/16"	11 13/16"	G40.21-44W	20
64	2		PLATE 1/4" THK. x 5 3/4"	3 13/16"	G40.21-44W	3
65	1		FLATBAR 1/4" x 6"	3'-0 9/16"	G40.21-44W	31
66	1		PLATE 1/2" THK. x 6 7/8"	6 7/8"	G40.21-44W	6
67	2		PLATE 1/4" THK. x 3 5/16"	3 13/16"	G40.21-44W	2
68	1		BEAM W4 x 13# (COPE ONE SIDE)	2'-2 13/16"	G40.21-44W	29
69	1		FLATBAR 1/4" x 6"	3'-4 1/2"	G40.21-44W	17
70	1		PLATE 1/2" THK. x 7 7/8"	7 7/8"	G40.21-44W	6
71	2		PLATE 1/4" THK. x 3 13/16"	3 13/16"	G40.21-44W	2
72	1		BEAM W4 x 13#	10 1/4"	G40.21-44W	11
73	1		ANGLE 2 1/2" x 2 1/2" x 1/4"	3'-10 3/16"	G40.21-44W	16
74	1		ANGLE 2 1/2" x 2 1/2" x 1/4"	4'-5 11/16"	G40.21-44W	18
75	1		PIPE 4" SCH STD SMLS PBE	6"	SA-106-B	5
76	5		CHANNEL C4 x 5.4# (COPE ONE END)	2'-3 13/16"	G40.21-44W	63
77						
78						
79						
80						
81						
82						
SUBTOTAL SH1						3303
SUBTOTAL SH2						601
x 1.06						
TOTAL (lbs.)						4138

- NOTES:
- ALL DIMENSIONS ARE IN S.I. AND IMPERIAL UNITS. DIMENSIONS IN BRACKETS ARE IMPERIAL HARD CONVERSIONS FOR SHOP REFERENCE ONLY.
 - BLAST & PAINT AS PER DETAILS ON G.A. SH2.
 - TAG PLATFORM WITH APPROPRIATE TANK TAG NO. 002-T-08-1118.
 - GRIND ALL SHARP EDGES SMOOTH.
 - SEE SH1.1 FOR MATERIAL LIST.



NO.	DATE (d/m/y)	REVISIONS	BY	APPD
06/03/14	AS-BUILT, NO CHANGE		WT	JK
08/10/13	UPDATED GRATING LAYOUT FOR MK#39 & 40; ADDED MK#75 & 76; REVISED QTY OF MK#62; REVISED LENGTH OF MK#11 ON SH1		JS	JK
27/09/13	REMOVED MK#62 FROM MATERIAL LIST; ADDED MK#73 & 74		JS	JK
16/09/13	ISSUED FOR CONSTRUCTION		JS	JK

THIS DRAWING IS THE PROPERTY OF FOREMOST UNIVERSAL LP AND IS TO BE USED ONLY IN CONJUNCTION WITH PERFORMANCE OF WORK BY FOREMOST UNIVERSAL LP. REPRODUCTION OR USE OF IN WHOLE OR IN PART FOR ANY OTHER PURPOSE IS EXPRESSLY FORBIDDEN.

FOREMOST

CLIENT		DEVON CANADA C/O WORLEYPARSONS LIQUID EXTRACTION PLANT, LSD: 11-2-39-08 WSM P.O.# 4100001170	
DWG TITLE		SLOP OIL TANK, TAG# 002-T-08-1118 ROOF PLATFORM DETAILS	
NO. REQ'D	1	WO. NO.	028978
SCALE	1:15	DWG NO.	T-028978-D111
DATE (d/m/y)	26/08/13	OWN BY	J. SHORT
		CHKD TWA	06/03/14
		APPD JK	06/03/14
SHEET NO. REV. NO.		2 of 2	