


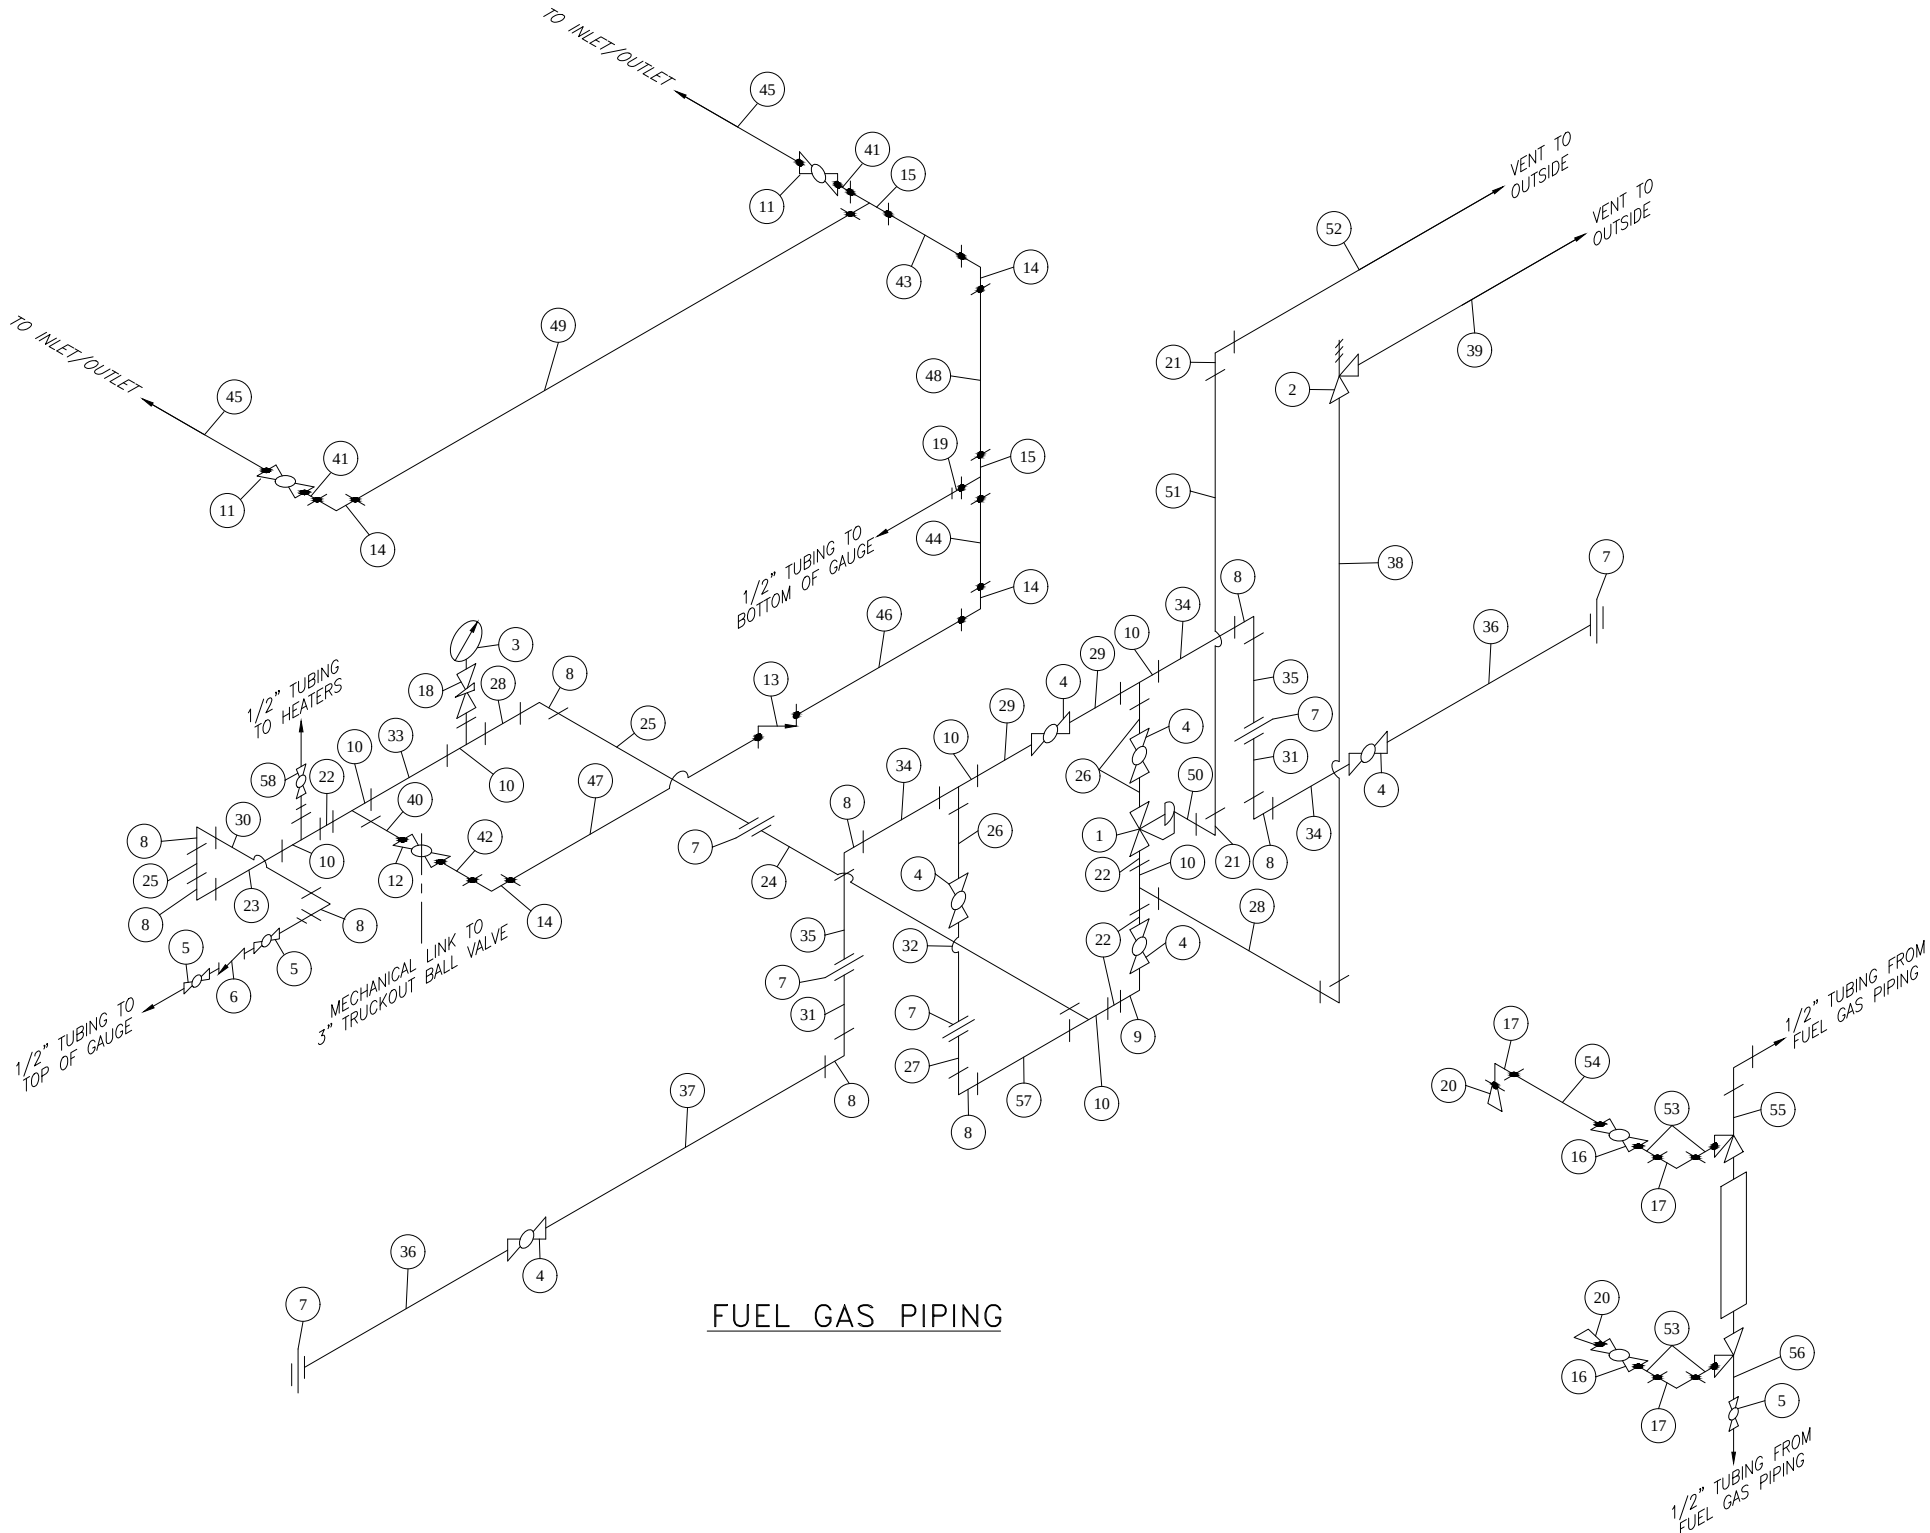

BILL OF MATERIALS

ITEM	REQ'D	PART	DESCRIPTION	MATERIAL	WEIGHT
1	1	-	1" FISHER 627 REGULATOR c/w 3/32" ORIFICE	SA-105-N	-
2	1	-	1" CONSOLIDATED 19096 SWEET RELIEF VALVE	-	-
3	1	-	4 1/2" LIQ. FILLED, 0-100 PSI PRESSURE INDICATOR	-	-
4	6	-	1" x 3000# OMB W-TB800 THRD BALL VALVE	SA-105-N	-
5	3	-	1/2" x 3000# NUTRON T3-F05S30A2 THRD BALL VALVE	SA-105-N	-
6	1	-	1/2" x 1500# DSI 6321-E16-18 THRD CHECK VALVE	SA-105-N	-
7	6	-	1" x 3000# THRD UNION	SA-105-N	-
8	9	-	1" x 90° THRD ELBOW	SA-105-N	-
9	1	-	1" x 90° STREET ELBOW	SA-105-N	-
10	7	-	1" x 3000# THRD TEE	SA-105-N	-
11	2	-	1" x 2500# WORCHESTER SW BALL VALVE NACE LK/HDL	SA-105-N	-
12	1	-	1" x 2500# WORCHESTER SW BALL VALVE NACE	SA-105-N	-
13	1	-	1" CLASS 800 OMB 865N SW CHECK VALVE NACE	SA-105-N	-
14	4	-	1" x 90° SW ELBOW	SA-105-N	-
15	2	-	1" x 3000# SW TEE	SA-105-N	-
16	2	-	3/4" x 3000# WORCHESTER SW BALL VALVE NACE	SA-105-N	-
17	3	-	3/4" x 90° SW ELBOW	SA-105-N	-
18	1	-	3/4" MNPT x 1/2" FNPT SS NEEDLE VALVE	SA-105-N	-
19	1	-	1 1/2" x 1/2" BUSHING, FLAT BACK (MACHINE FIT 1" SW)	SA-105-N	-
20	2	-	2" x 3/4" RED CONC SCH XH (CUT 2" OFF ONE END)	SA-234-WPB	-
21	2	-	3/4" x 90° THRD ELBOW	SA-105-N	-
22	4	-	1" x 2" LG NIPPLE SCH XH	SA-106-B	-
23	1	-	1" x 2 1/2" LG NIPPLE SCH XH	SA-106-B	-
24	1	-	1" x 3" LG NIPPLE SCH XH	SA-106-B	-
25	2	-	1" x 4" LG NIPPLE SCH XH	SA-106-B	-
26	3	-	1" x 4" LG NIPPLE SCH 160	SA-106-B	-
27	1	-	1" x 4 1/2" LG NIPPLE SCH XH	SA-106-B	-
28	2	-	1" x 5 1/2" LG NIPPLE SCH XH	SA-106-B	-
29	2	-	1" x 6 1/2" LG NIPPLE SCH 160	SA-106-B	-
30	1	-	1" x 7" LG NIPPLE SCH XH	SA-106-B	-
31	2	-	1" x 8" LG NIPPLE SCH 160	SA-106-B	-
32	1	-	1" x 10" LG NIPPLE SCH XH	SA-106-B	-
33	1	-	1" x 12" LG NIPPLE SCH XH	SA-106-B	-
34	3	-	1" x 12" LG NIPPLE SCH 160	SA-106-B	-
35	2	-	1" x 12 1/2" LG NIPPLE SCH 160	SA-106-B	-
36	2	-	1" x 32" LG NIPPLE SCH 160	SA-106-B	-
37	1	-	1" x 45" LG NIPPLE SCH 160	SA-106-B	-
38	1	-	1" x 75" LG NIPPLE XH	SA-106-B	-
39	1	-	1" NIPPLE XH CUT TO SUIT	SA-106-B	-
40	1	-	1" PIPE SCH XH x 5" LG TOE	SA-106-B	-
41	2	-	1" PIPE SCH XH x 2" LG	SA-106-B	-
42	1	-	1" PIPE SCH XH x 5" LG	SA-106-B	-
43	1	-	1" PIPE SCH XH x 11 1/2" LG	SA-106-B	-
44	1	-	1" PIPE SCH XH x 12" LG	SA-106-B	-
45	2	-	1" PIPE SCH XH x 19 1/2" LG	SA-106-B	-
46	1	-	1" PIPE SCH XH x 26" LG	SA-106-B	-
47	1	-	1" PIPE SCH XH x 39" LG	SA-106-B	-
48	1	-	1" PIPE SCH XH x 68" LG	SA-106-B	-
49	1	-	1" PIPE SCH XH x 139 1/2" LG	SA-106-B	-
50	1	-	3/4" x 3 1/2" LG NIPPLE SCH XH	SA-106-B	-
51	1	-	3/4" x 72" LG NIPPLE SCH XH	SA-106-B	-
52	1	-	3/4" NIPPLE SCH XH CUT TO SUIT	SA-106-B	-
53	4	-	3/4" PIPE SCH XH x 2" LG	SA-106-B	-
54	1	-	3/4" PIPE SCH XH x 43" LG	SA-106-B	-
55	1	-	1/2" x 9 3/4" LG NIPPLE SCH XH	SA-106-B	-
56	1	-	1/2" x 2" LG NIPPLE SCH XH	SA-106-B	-
57	1	-	1" x 11 1/2" LG NIPPLE SCH XH	SA-106-B	-
58	1	-	1/2" x 3000# NUTRON THRD BALL VALVE	SA-105-N	-

LEVEL GAUGE DETAIL

REV. NO.	DATE	REVISION	BY	APP'D
0	06/20/03	ISSUED FOR FABRICATION	DSG	
	07/25/03	AS BUILT DRAWING	JMB	

BILTON
Welding & Manufacturing Ltd.

This drawing is property of BILTON WELDING & MANUFACTURING LTD., and is lent to the recipient for their confidential use only. In consideration of the loan of this drawing, the recipient promises and agrees that it shall not be used in any way detrimental to the interests of BILTON WELDING & MANUFACTURING LTD., that it shall be returned upon request, and that it shall not be reproduced, copied, lent, or otherwise disposed of, directly or indirectly, without the written consent of BILTON WELDING & MANUFACTURING LTD.

BOX 6106
5815 37 Street
INNISFAIL, AB
CANADA
403-227-7799
1-888-227-4923
FAX 227-7796

BP CANADA ENERGY
60 BBL ABOVE GROUND SINGLE WALL FLARE KNOCKOUT DRUM
FUEL GAS PIPING

DATE: 06/20/03
SCALE: N.T.S.
DRAWN BY: DSG
PURCHASE ORDER:
LOCATION: 10-07 COMPRESSOR
APP'D BY:

SHEET: 5 OF 5
JOB NO.:
A662
DRAWING NO.:
A662-5
CRN: N/A

SIZE
D
REV.
1